
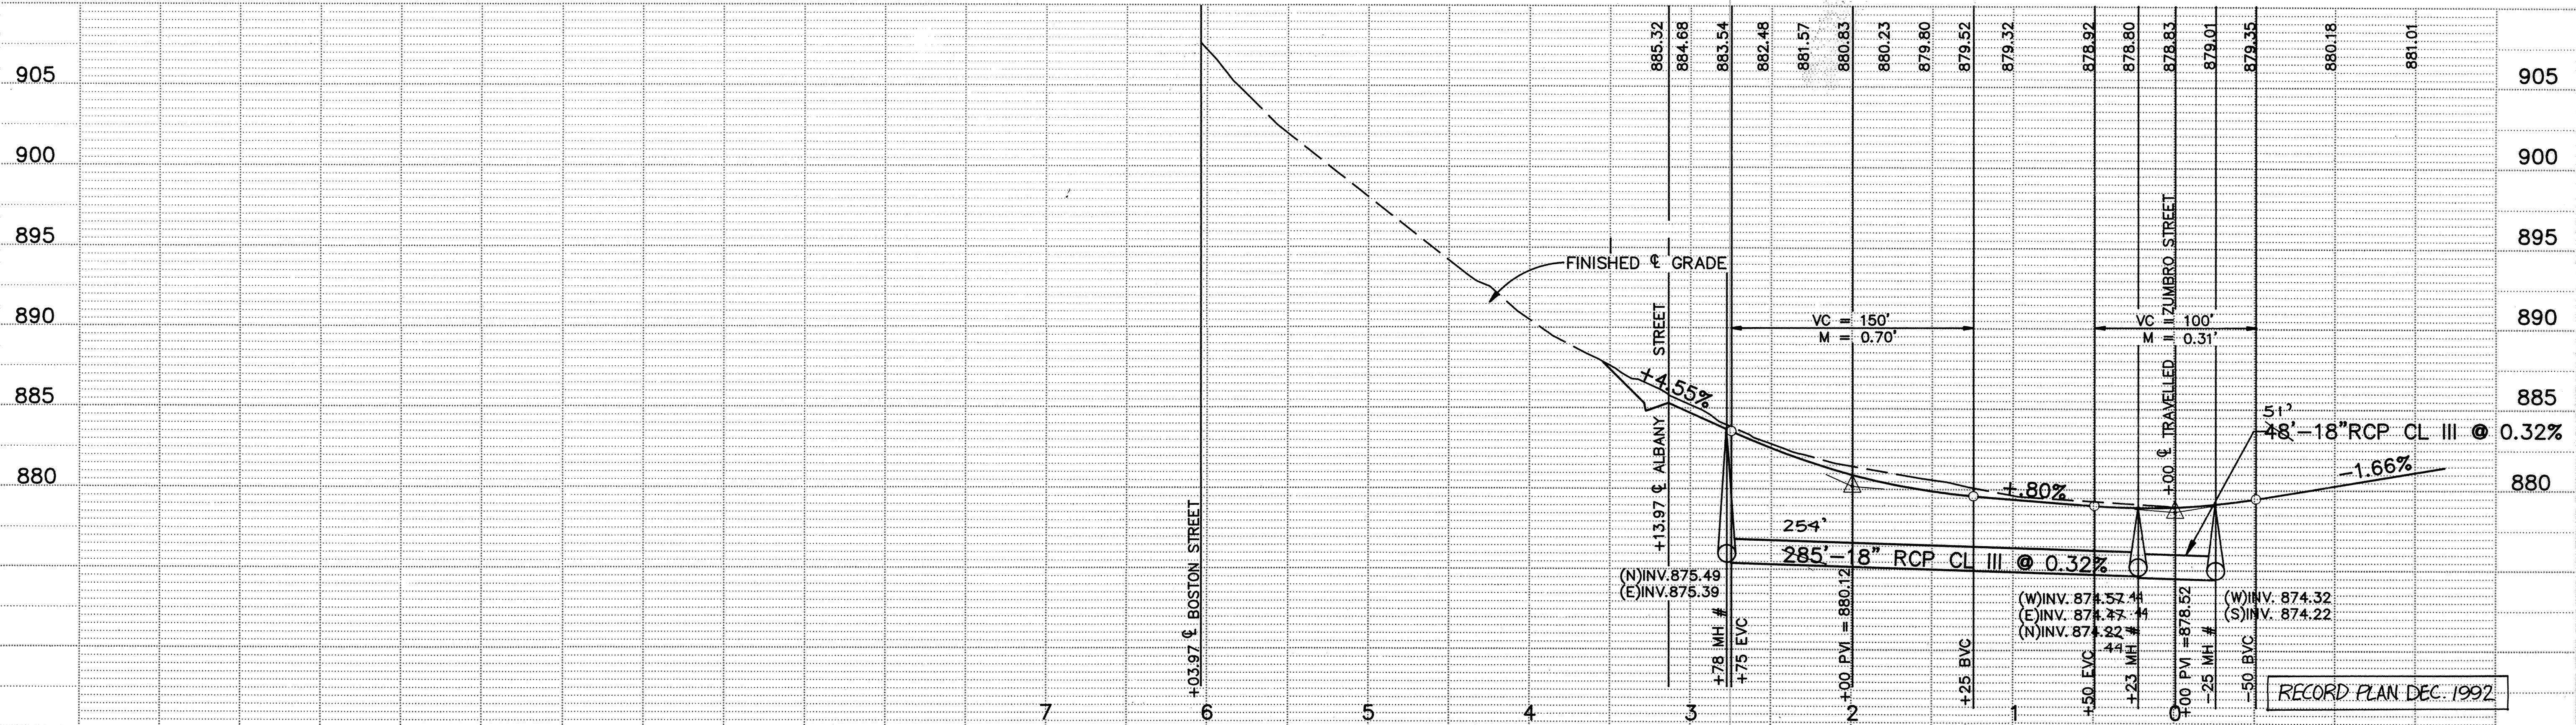


TOP PRODUCTS • NEW HADE, MINNESOTA
RENDER BY PART NUMBER 6532
POSITION OF PART NUMBER 6532
SHEET PRODUCTS • NEW HADE, MINNESOTA
RENDER BY PART NUMBER 6532
POSITION OF PART NUMBER 6532
SHEET PRODUCTS • NEW HADE, MINNESOTA
RENDER BY PART NUMBER 6532
POSITION OF PART NUMBER 6532

188TH AVENUE

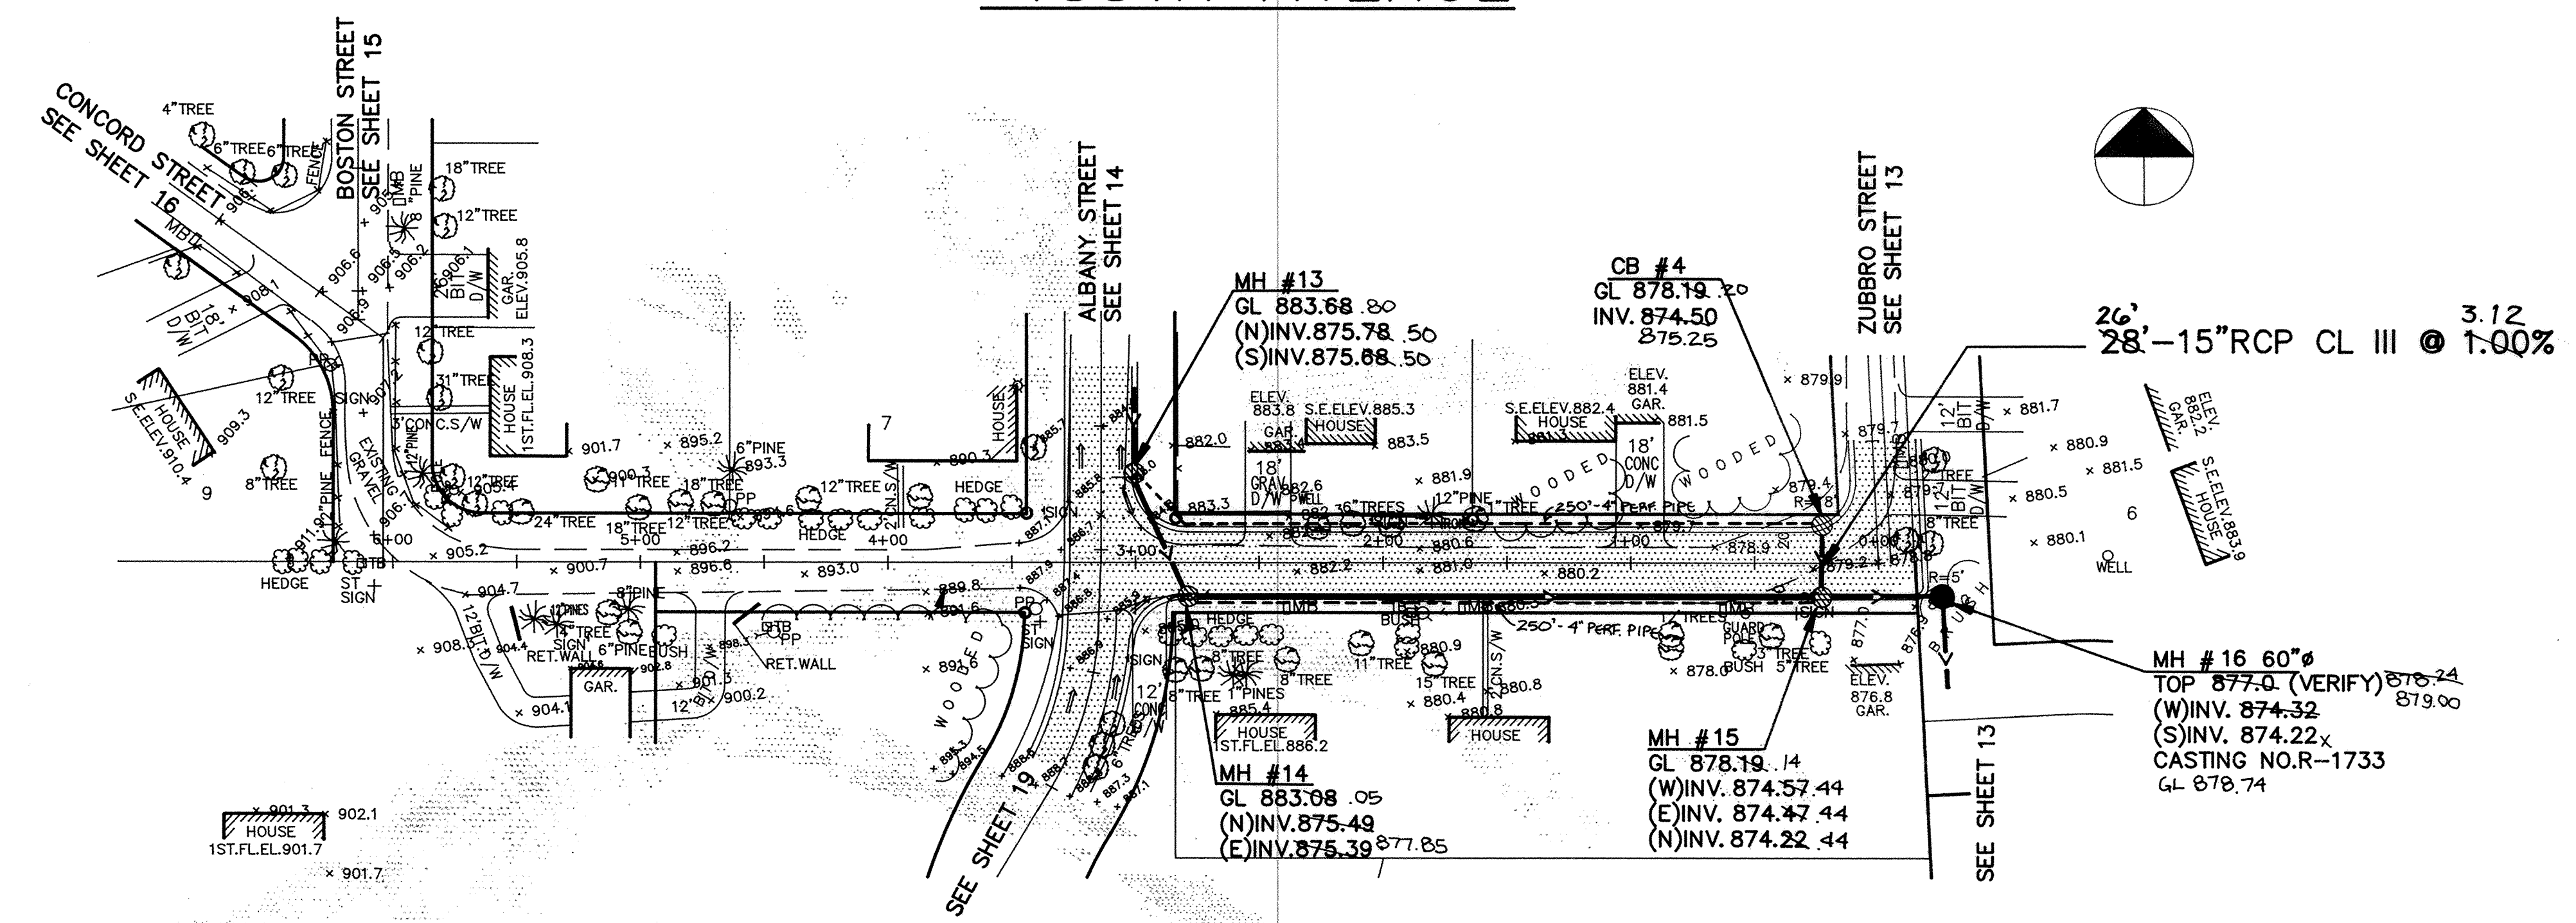

I HEREBY CERTIFY THAT THIS PLAN, SPECIFICATION, OR REPORT WAS PREPARED BY ME OR UNDER MY DIRECT SUPERVISION AND THAT I AM A DULY REGISTERED PROFESSIONAL ENGINEER UNDER THE LAWS OF THE STATE OF MINNESOTA.

Erny J. Maier

DATE 2/6/92 REG. NO. 15314

MSA CONSULTING ENGINEERS
Maier Stewart & Associates Inc.
9800 SHELARD PARKWAY (612) 546-0432 MINNEAPOLIS, MINNESOTA 55441
1959 SLOAN PLACE (612) 774-6021 ST. PAUL, MINNESOTA 55117

REVISIONS	DATE	DESCRIPTION

DESIGNED	
CHECKED	
DRAWN	
GRAPHIC SCALE	
0 HORIZ. 50	
0 VERT. 5	

CITY OF ELK RIVER
STREET AND STORM SEWER
188TH AVENUE

DATE DEC, 1991 SHEET 18 OF 23 SHEETS PROJECT NO. 230-116