
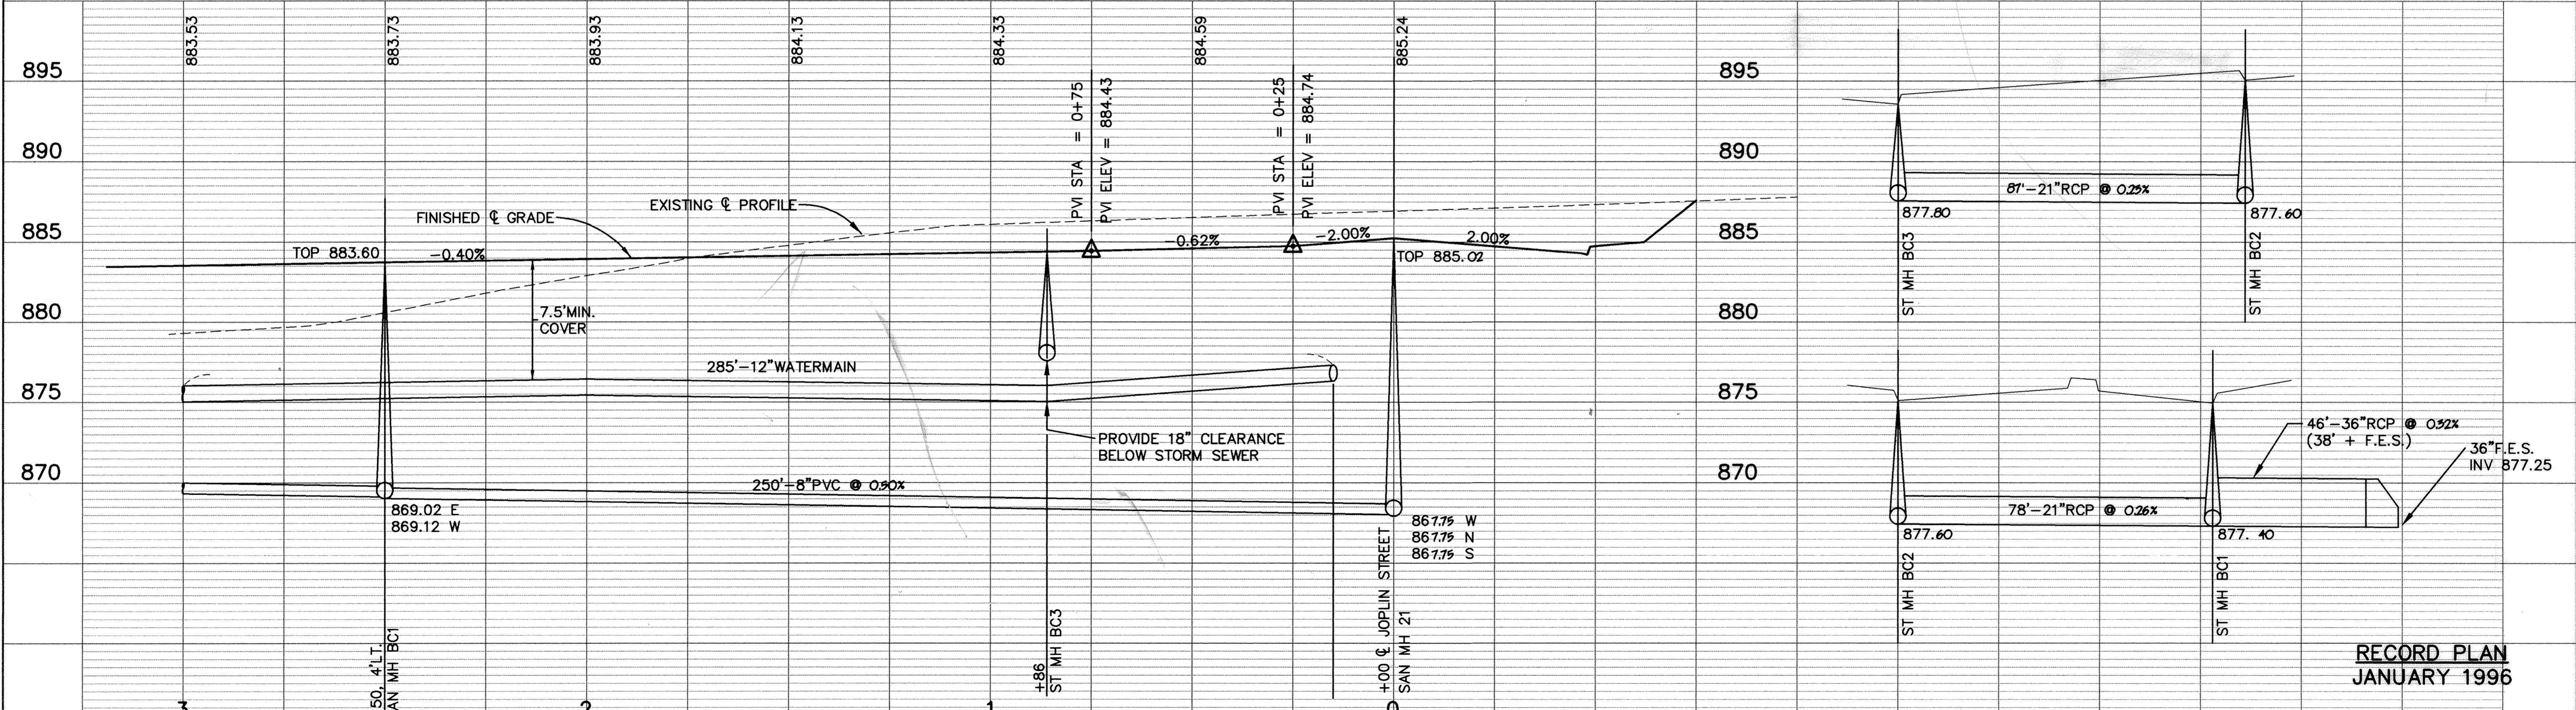


BUSINESS CENTER DRIVE

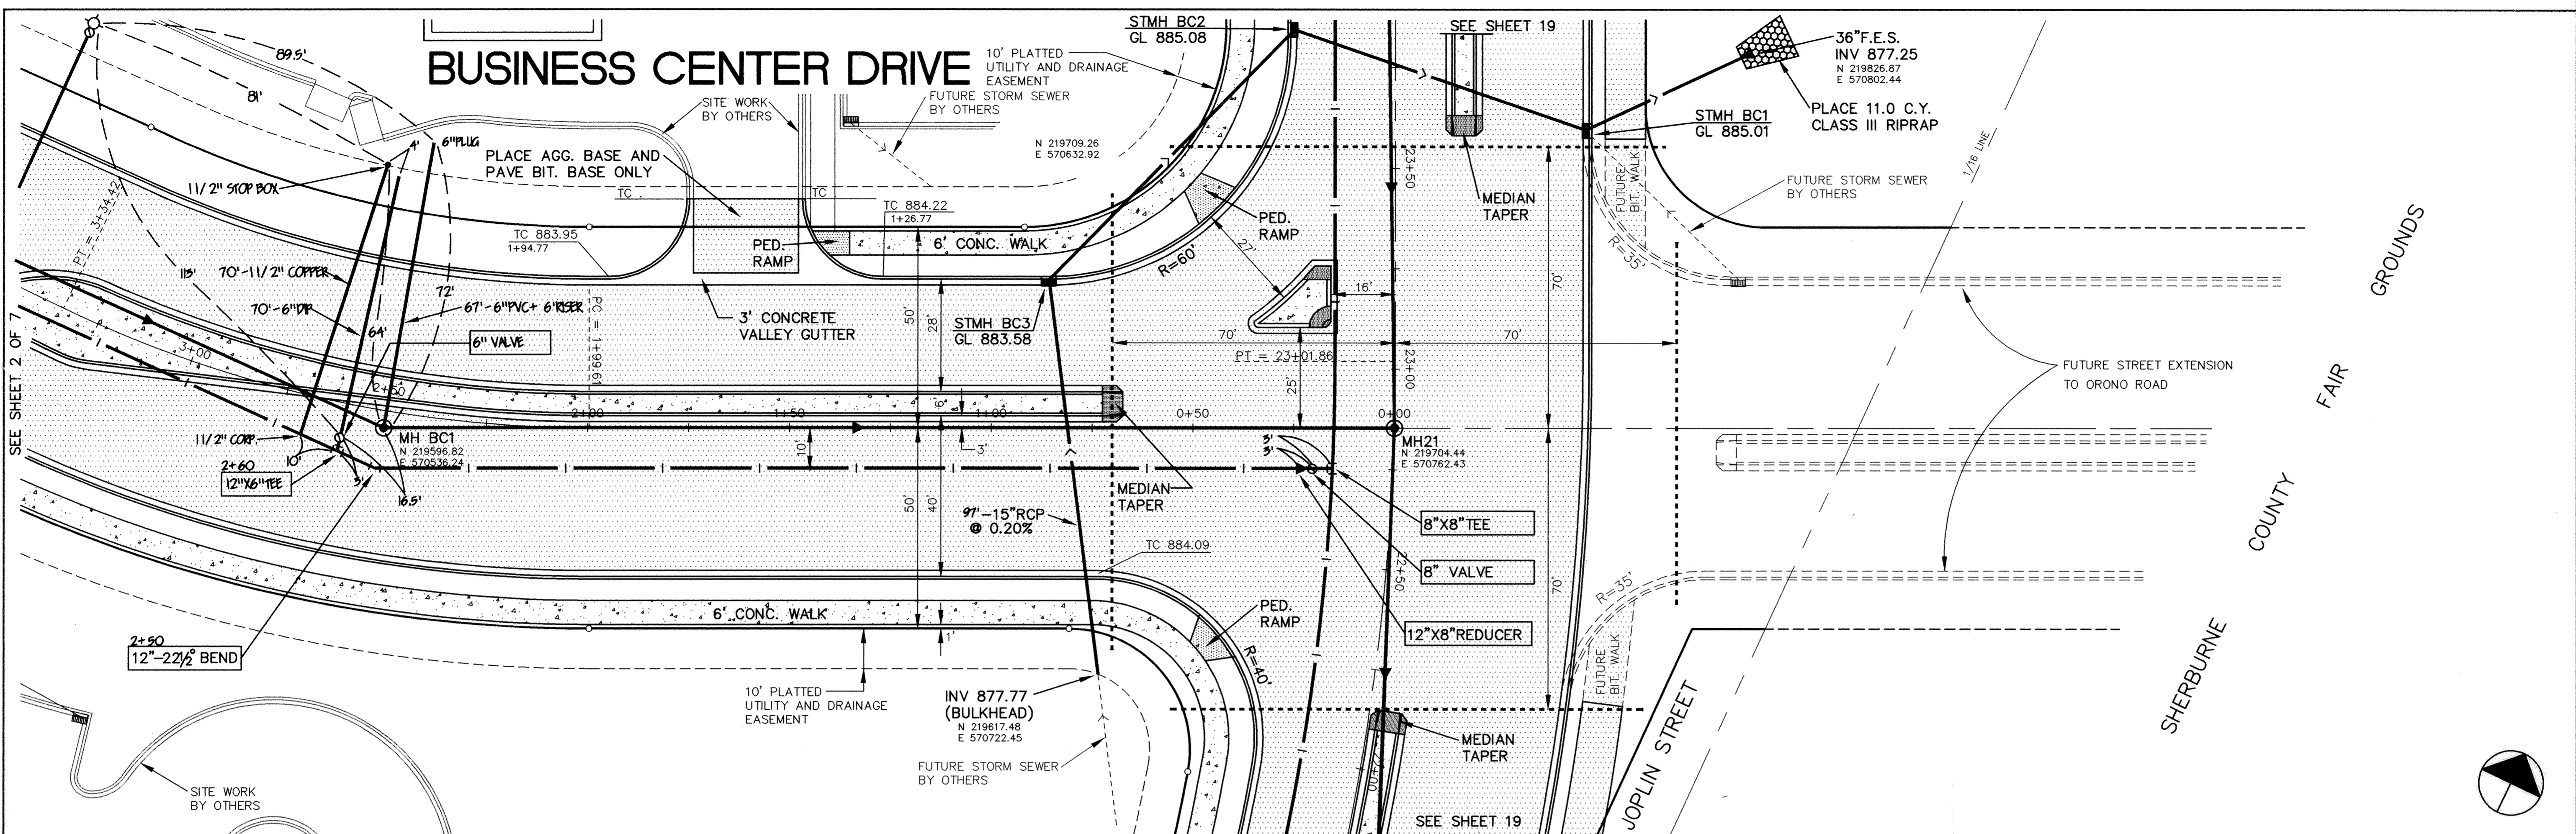

RECORD PLAN
JANUARY 1996

CITY MARCH 1996

I HEREBY CERTIFY THAT THIS PLAN, SPECIFICATION, OR REPORT WAS PREPARED BY ME OR UNDER MY DIRECT SUPERVISION AND THAT I AM A DULY REGISTERED PROFESSIONAL ENGINEER UNDER THE LAWS OF THE STATE OF MINNESOTA.
DATE: 1/18/95 REG. NO. 23170



1326 ENERGY PARK DRIVE
ST. PAUL, MINNESOTA 55108
(612) 644-4389
5075 WAYZATA BLVD. SUITE #225
MINNEAPOLIS, MINNESOTA 55416
(612) 546-0432

DATE	DESCRIPTION

DESIGNED _____
CHECKED _____
DRAWN _____
GRAPHIC SCALE
0 20
0 5
VERT.

CITY OF ELK RIVER
COUNTRY CROSSINGS BUSINESS CENTER
STREET AND UTILITY CONSTRUCTION
BUSINESS CENTER DRIVE
CHANGE ORDER NO. 2
DATE APRIL 1995 SHEET 1 OF 7 SHEETS PROJECT NO. 230-259
0+00 TO 3+00