
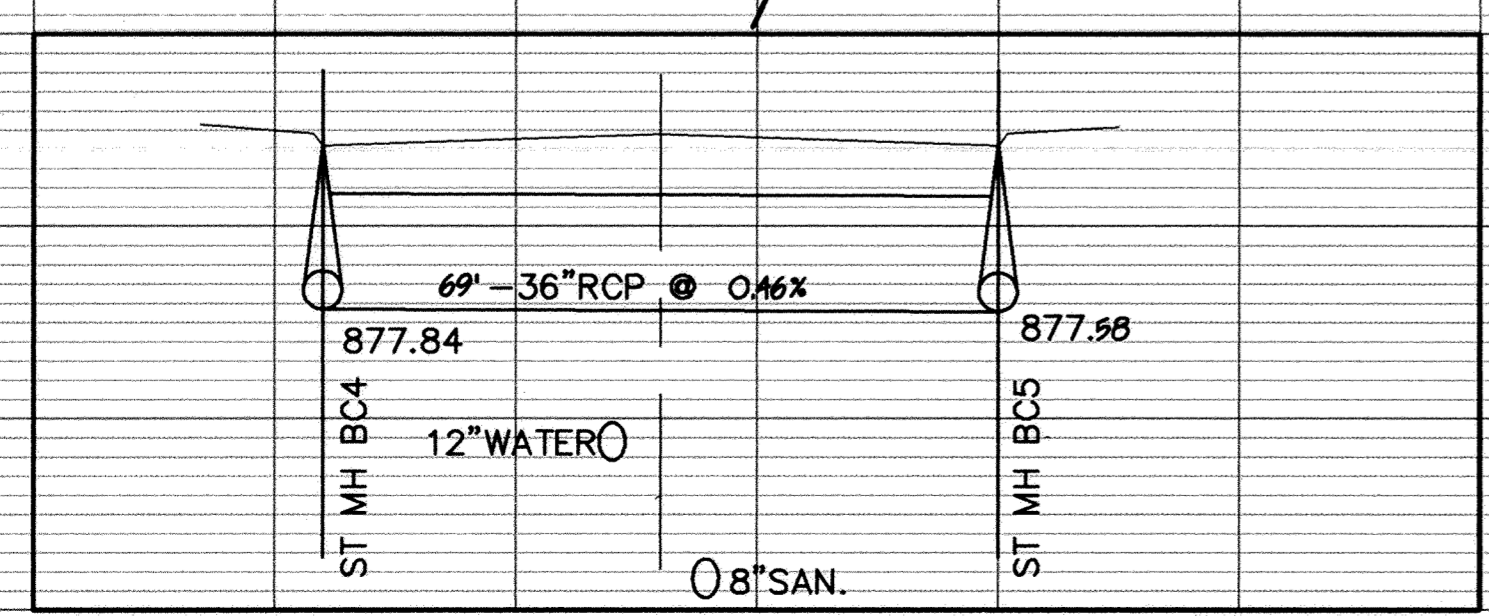
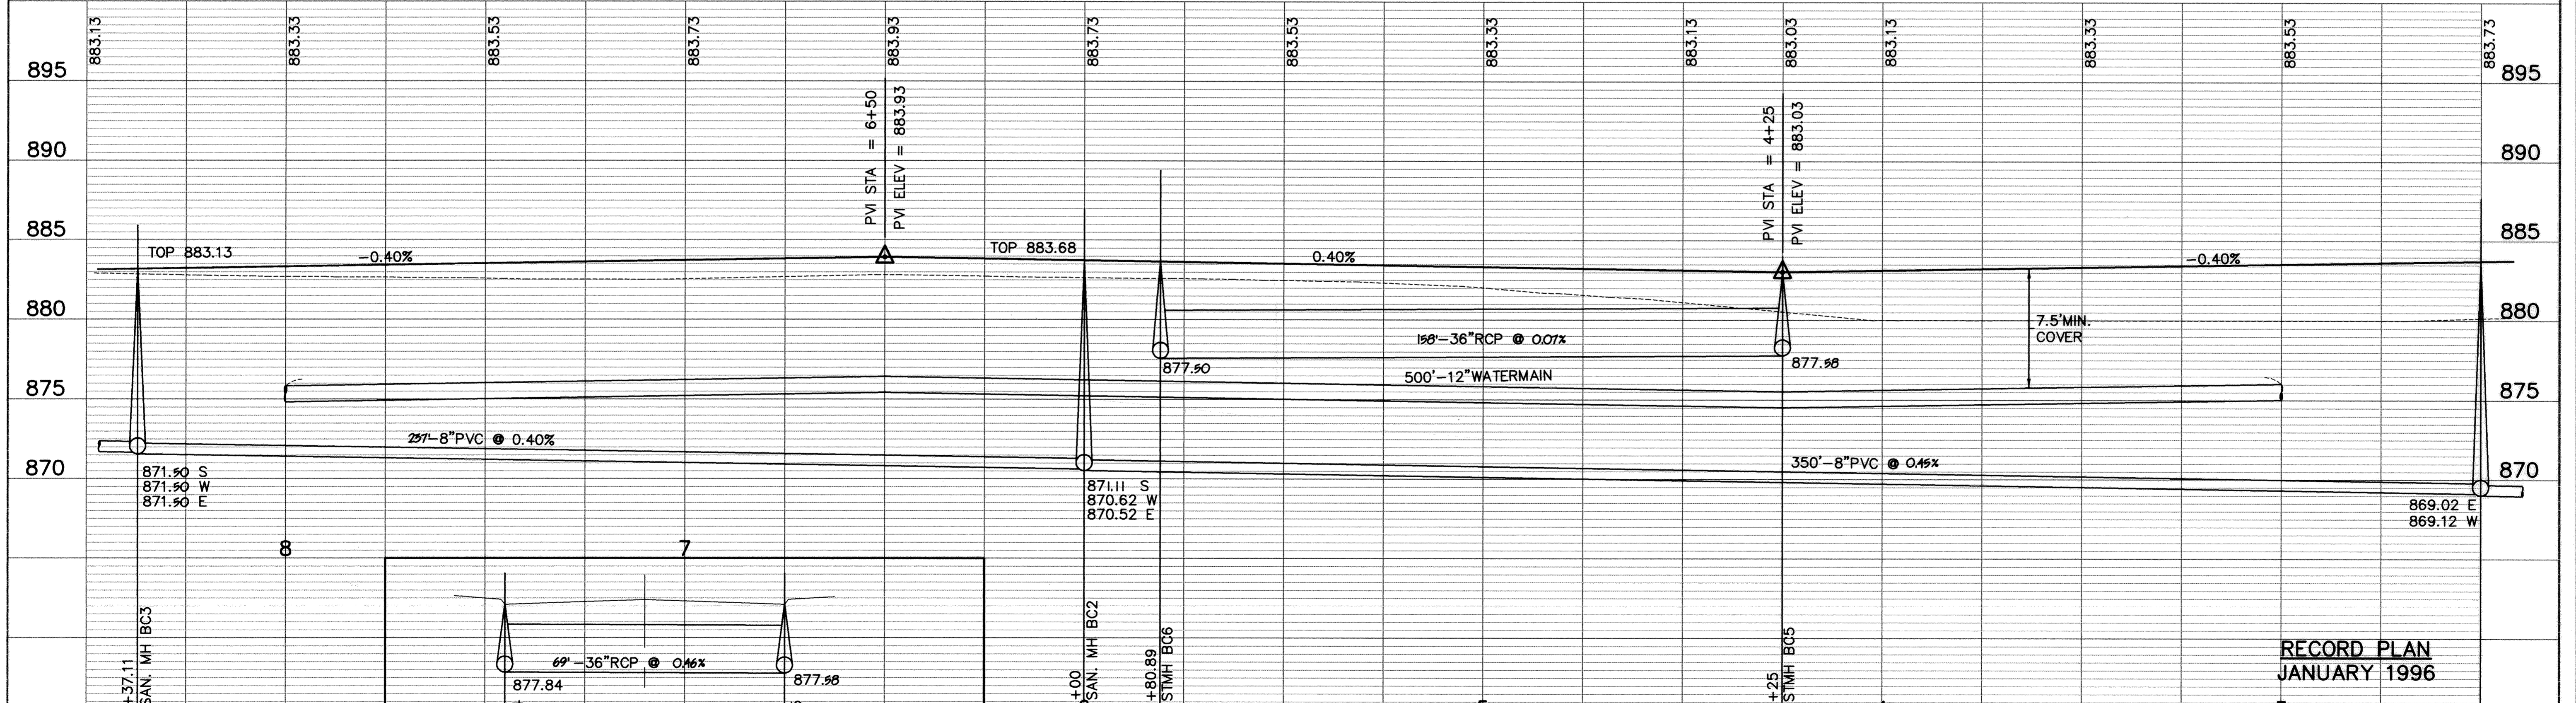


BUSINESS CENTER DRIVE

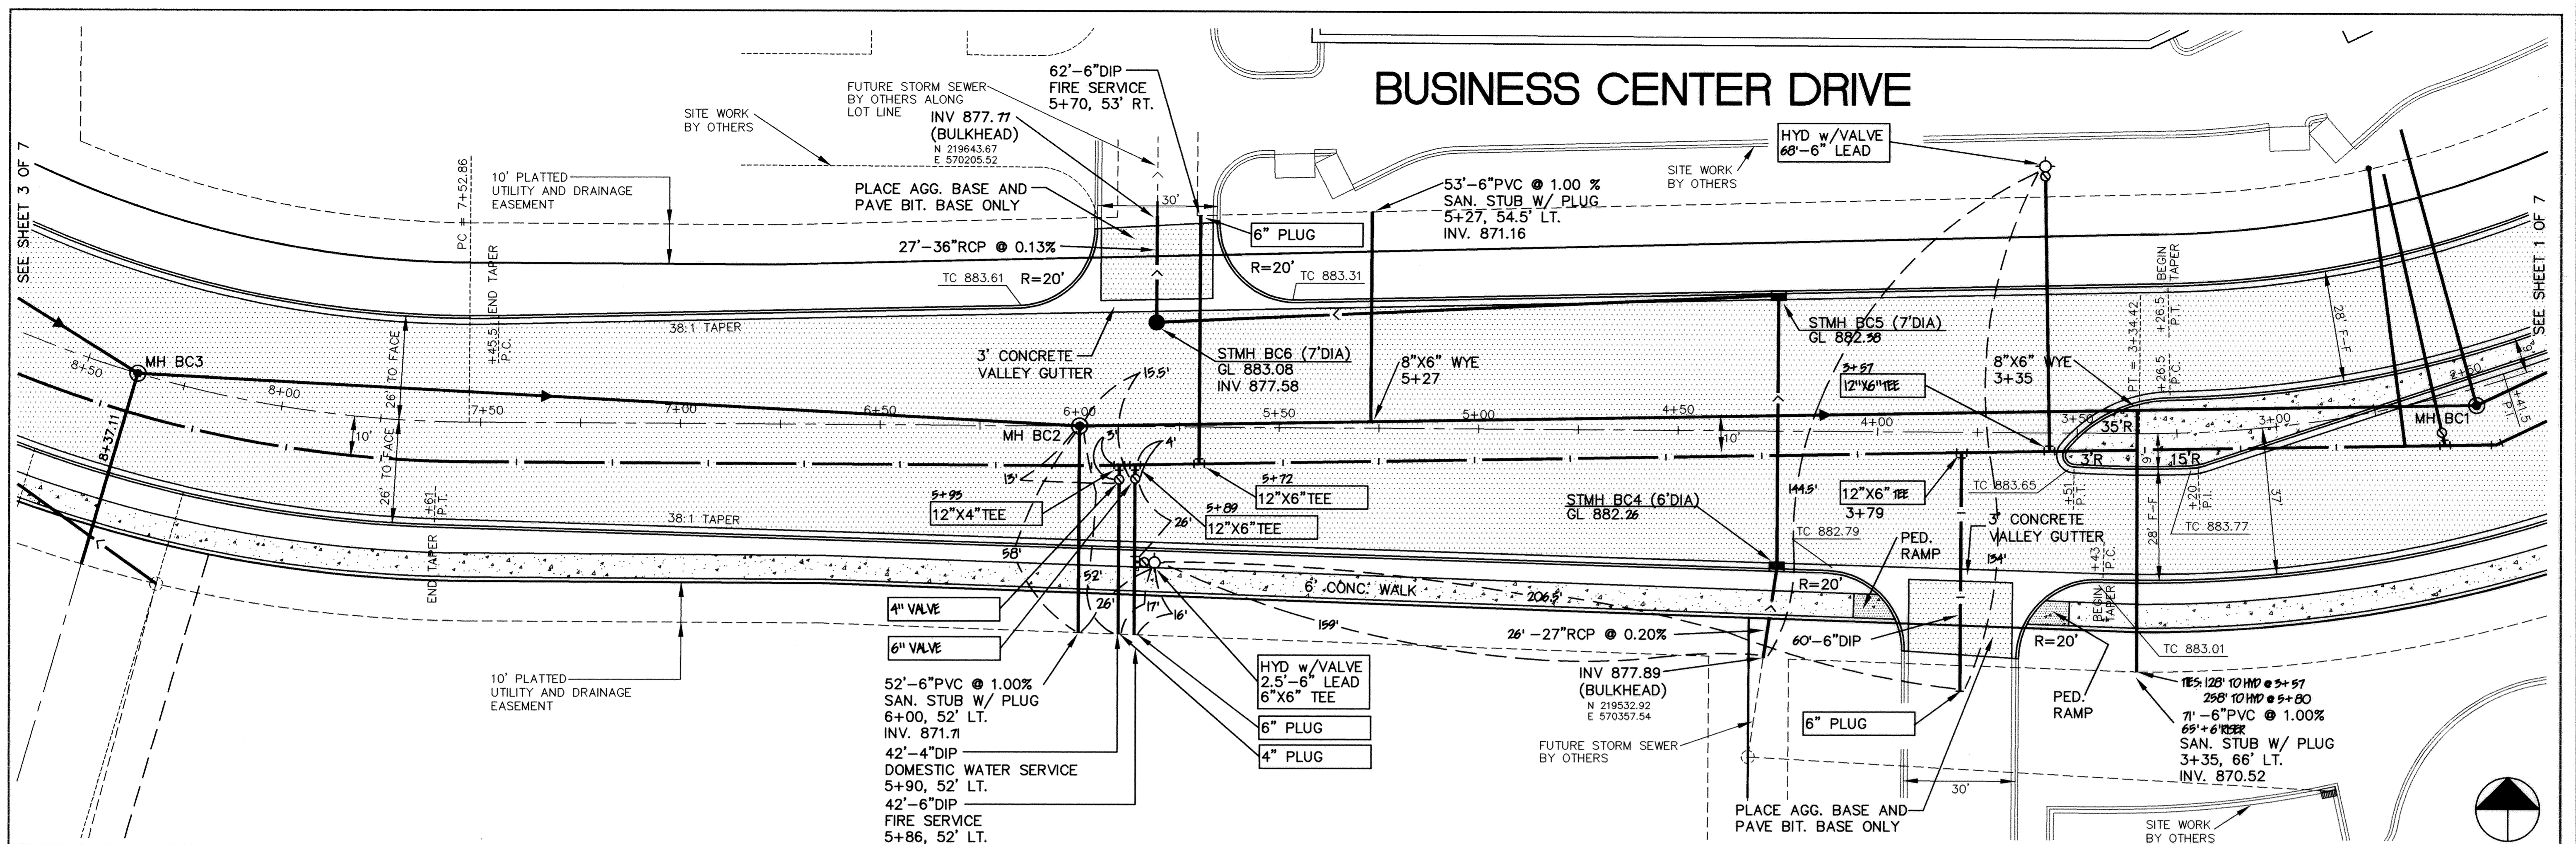

RECORD PLAN
JANUARY 1996

I HEREBY CERTIFY THAT THIS PLAN, SPECIFICATION, OR REPORT WAS PREPARED BY ME OR UNDER MY DIRECT SUPERVISION AND THAT I AM A DULY REGISTERED PROFESSIONAL ENGINEER UNDER THE LAWS OF THE STATE OF MINNESOTA.

Edward J. Stutz
 DATE 4/18/95 REG. NO. 23170



1326 ENERGY PARK DRIVE
 ST. PAUL, MINNESOTA 55108
 (612) 644-4389

5075 WAYZATA BLVD. SUITE #225
 MINNEAPOLIS, MINNESOTA 55416
 (612) 546-0432

REVISIONS	DATE	DESCRIPTION

DESIGNED	CHECKED	DRAWN
GRAPHIC SCALE	0	20
0	5	VERT.
CHANGE ORDER NO. 2	DATE APRIL 1995	SHEET 2 OF 7 SHEETS
PROJECT NO. 230-259		3+00 TO 8+00

SAICO PRODUCTS • NEW HOPK, MINNESOTA
 REVISION BY PART NUMBER 6582