



SEE SHEET 6 OF 63

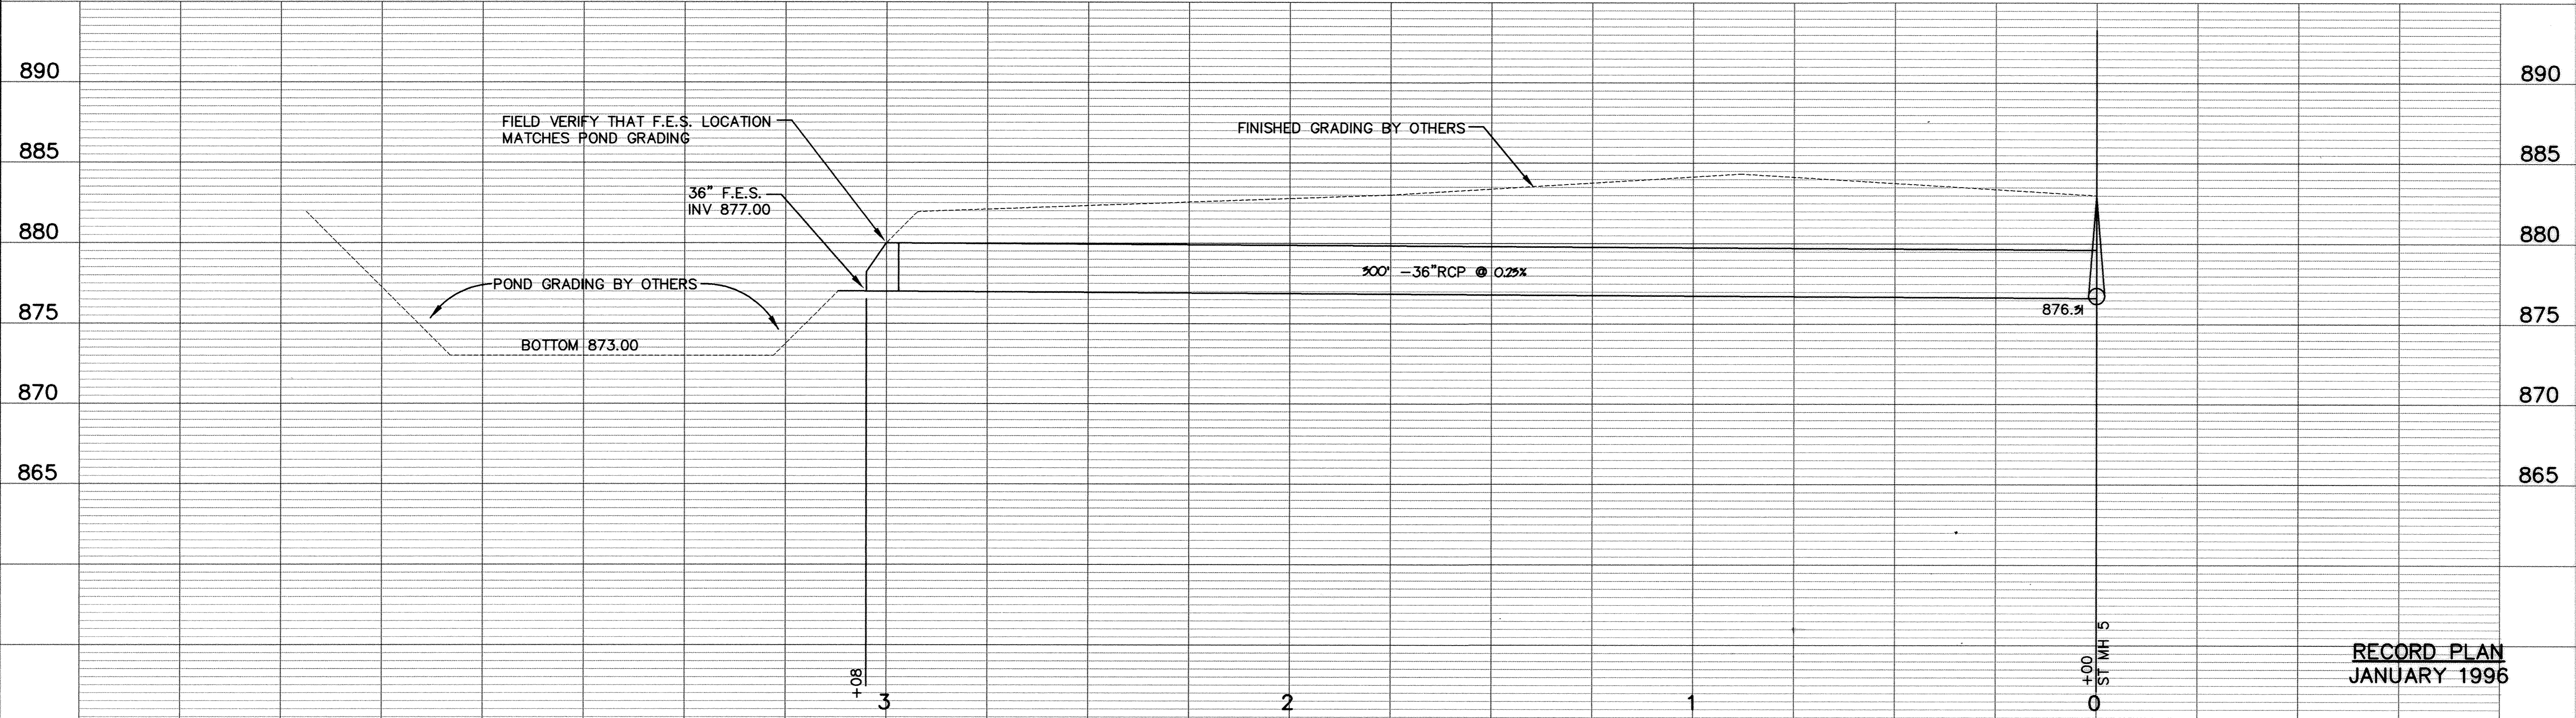

RECORD PLAN
JANUARY 1996

I HEREBY CERTIFY THAT THIS PLAN, SPECIFICATION, OR REPORT WAS PREPARED BY ME OR UNDER MY DIRECT SUPERVISION AND THAT I AM A DULY REGISTERED PROFESSIONAL ENGINEER UNDER THE LAWS OF THE STATE OF MINNESOTA.

Greg Stoltz
DATE 4/18/95 REG. NO. 23170

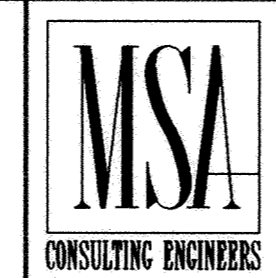

1326 ENERGY PARK DRIVE
ST. PAUL, MINNESOTA 55108
(612) 644-4389

5075 WAYZATA BLVD. SUITE #225
MINNEAPOLIS, MINNESOTA 55416
(612) 546-0432

REVISIONS	DATE	DESCRIPTION

DESIGNED _____
CHECKED _____
DRAWN _____

GRAPHIC SCALE
0 20
0 VERT. 5

CITY OF ELK RIVER
WESTERN AREA II
STORM SEWER 183RD AVE.
FROM 67+75 SOUTH TO POND

CHANGE ORDER NO. 2

DATE APRIL 1995 SHEET 6 OF 7 SHEETS PROJECT NO. 230-259