
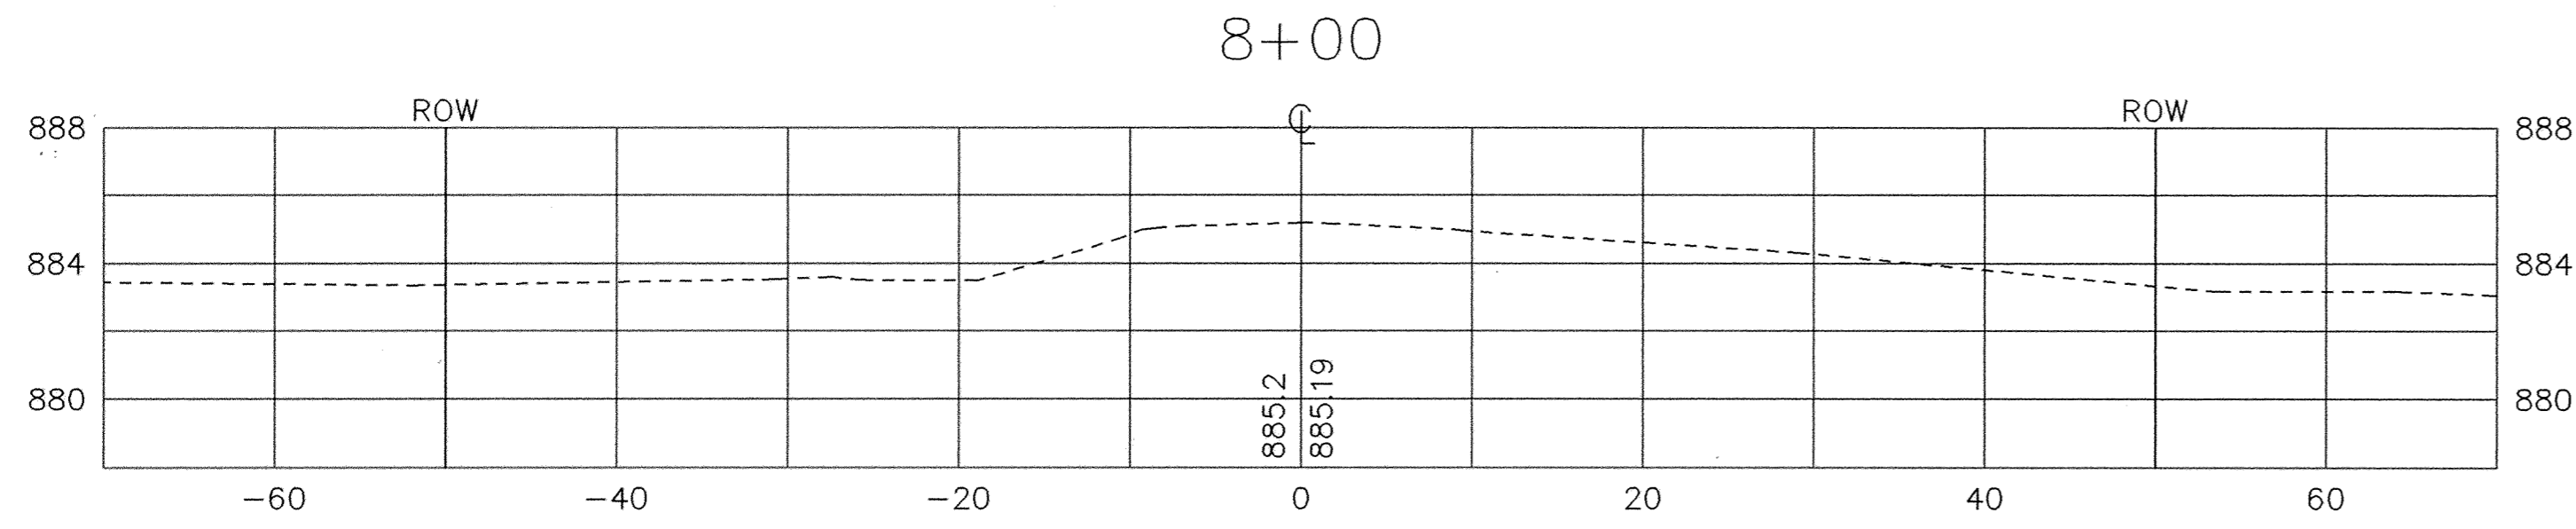
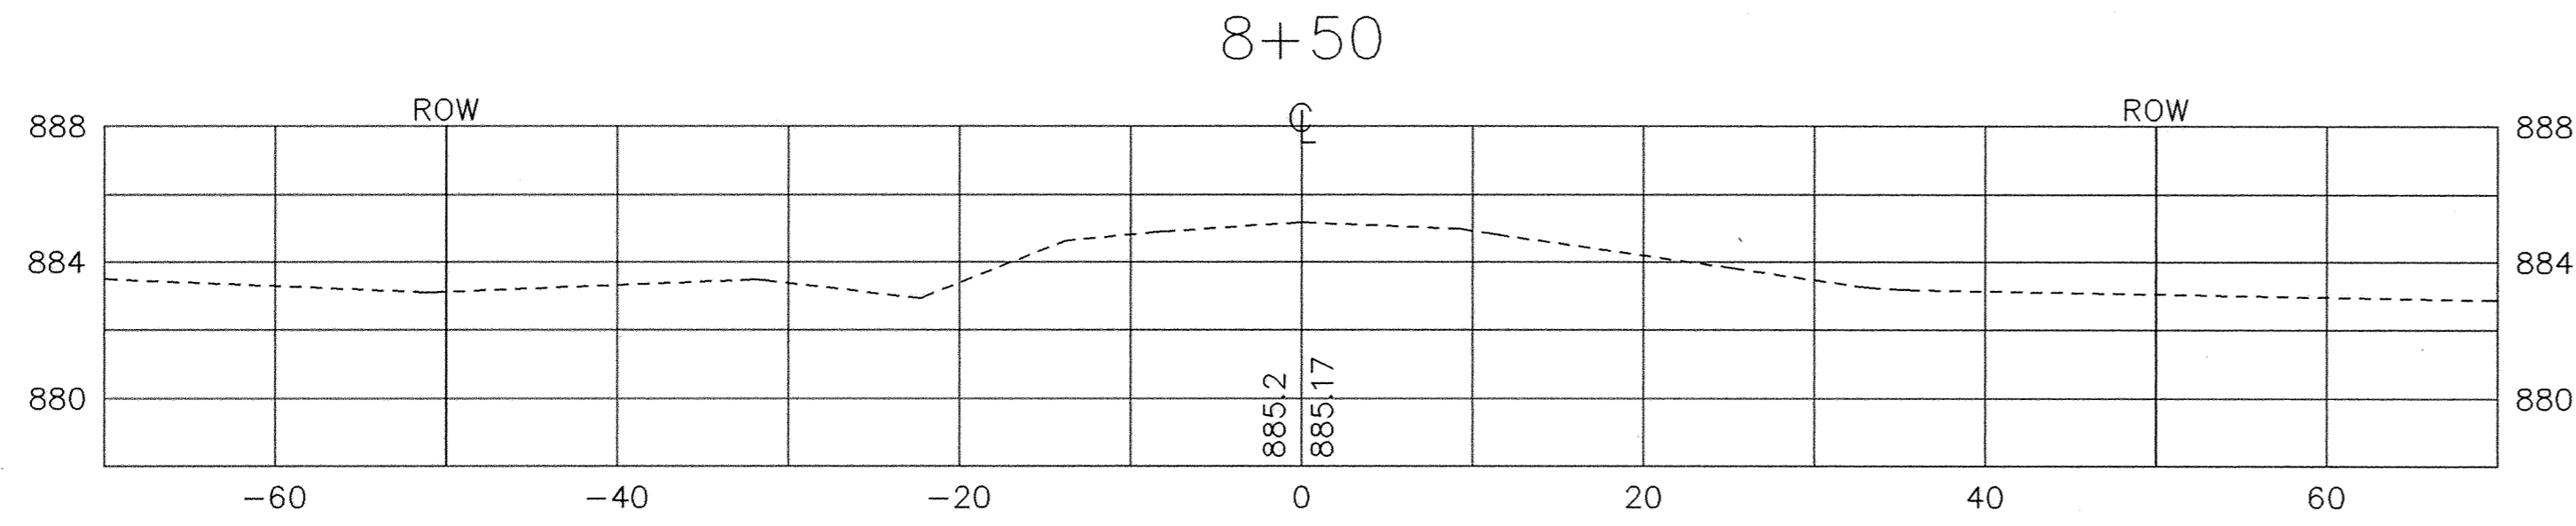
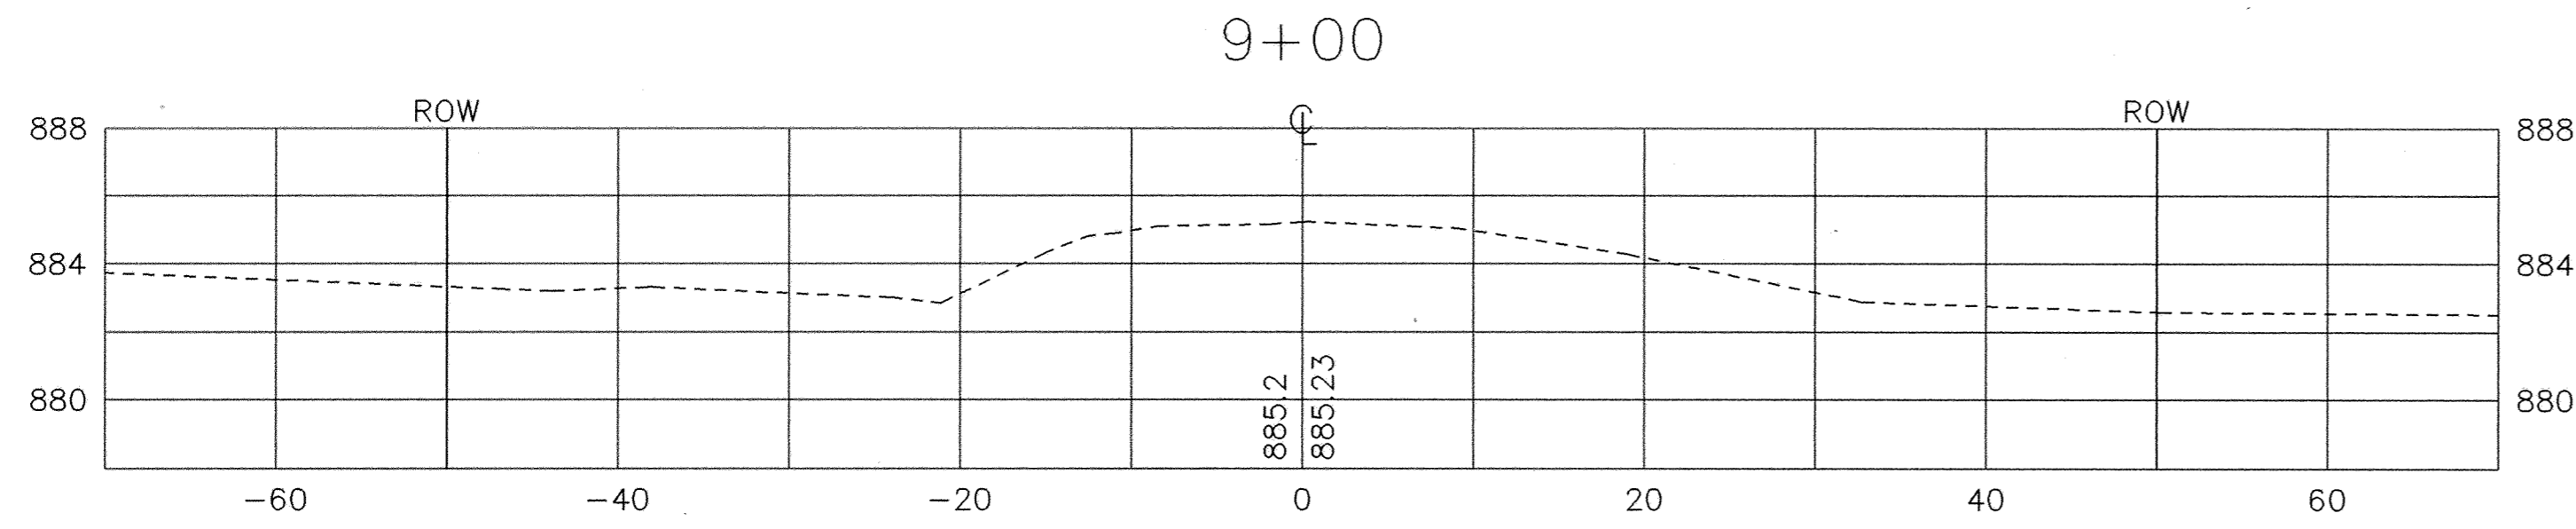
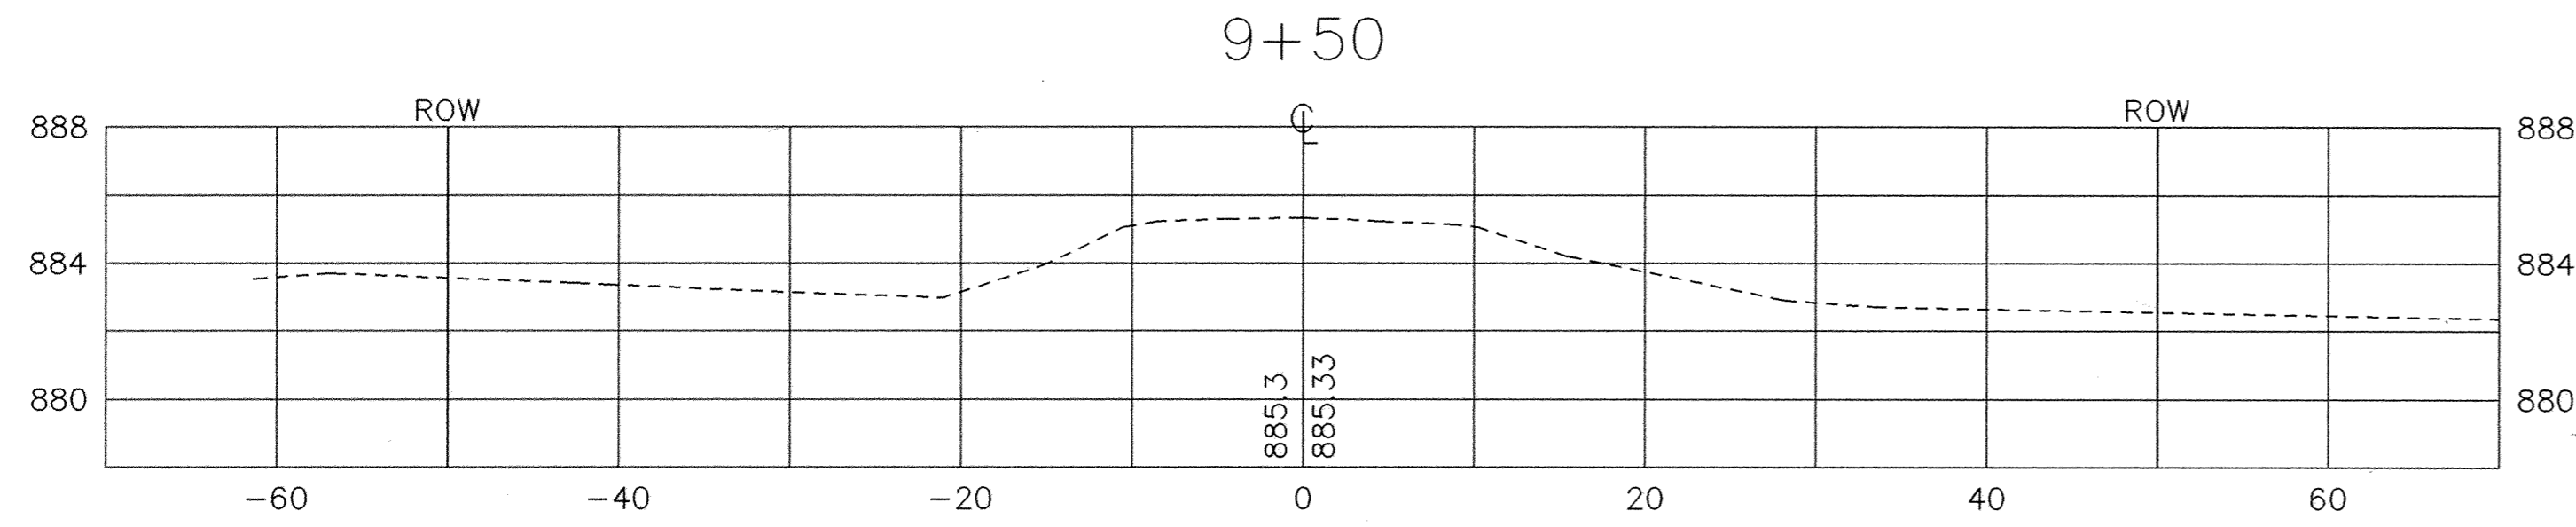


SAATCHI ENGINEERS • NEW HOPE, MINNESOTA  
REQUEST BY PART NUMBER 8282  
SAATCHI ENGINEERS • NEW HOPE, MINNESOTA  
REQUEST BY PART NUMBER 8282  
SAATCHI ENGINEERS • NEW HOPE, MINNESOTA  
REQUEST BY PART NUMBER 8282  
SAATCHI ENGINEERS • NEW HOPE, MINNESOTA  
REQUEST BY PART NUMBER 8282

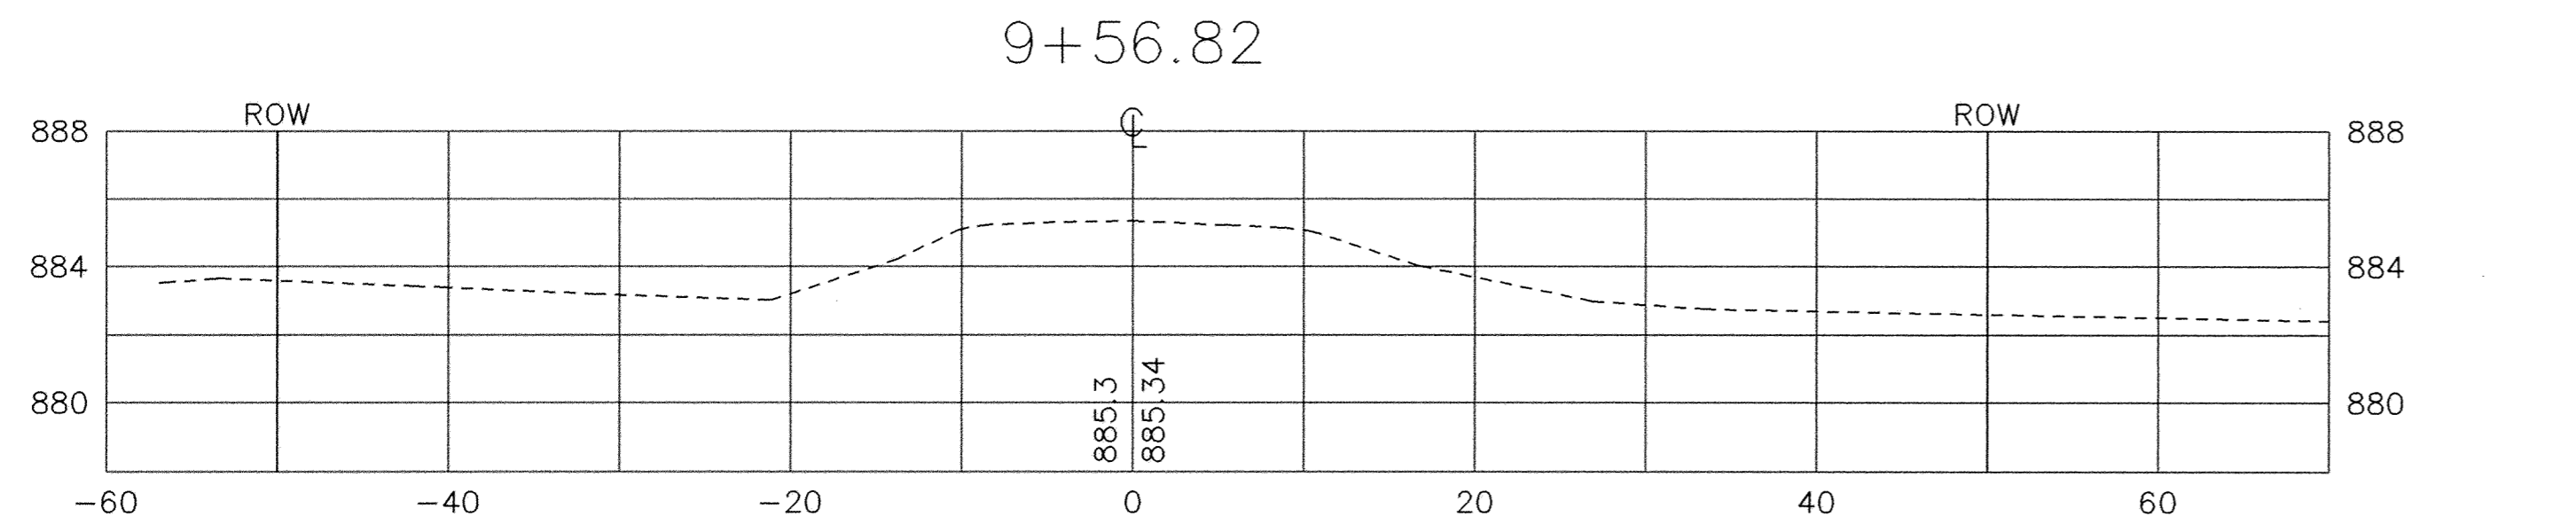

RECORD PLAN  
JANUARY 1996

CITY OF ELK RIVER  
WESTERN AREA PHASE II  
CROSS SECTIONS  
CENEX DRIVEWAY

STA 8+00 TO STA 9+56.82

DATE MAY 1995 SHEET 6 OF 6 SHEETS PROJECT NO. 230-259

REVISIONS	DATE	DESCRIPTION	DESIGNED	CHECKED	DRAWN

GRAPHIC SCALE  
 0 10  
 0 VERT. 5

I HEREBY CERTIFY THAT THIS PLAN, SPECIFICATION, OR REPORT WAS PREPARED BY ME OR UNDER MY DIRECT SUPERVISION AND THAT I AM A DULY REGISTERED PROFESSIONAL ENGINEER UNDER THE LAWS OF THE STATE OF MINNESOTA.  
*Gregory Manna*  
 DATE 5/12/95 REG. NO. 15316



1326 ENERGY PARK DRIVE  
ST. PAUL, MINNESOTA 55108  
(612) 644-4389  
  
5075 WAYZATA BLVD. SUITE #225  
MINNEAPOLIS, MINNESOTA 55416  
(612) 546-0432