


INTERSECTION REALIGNMENT AT T.H. 10

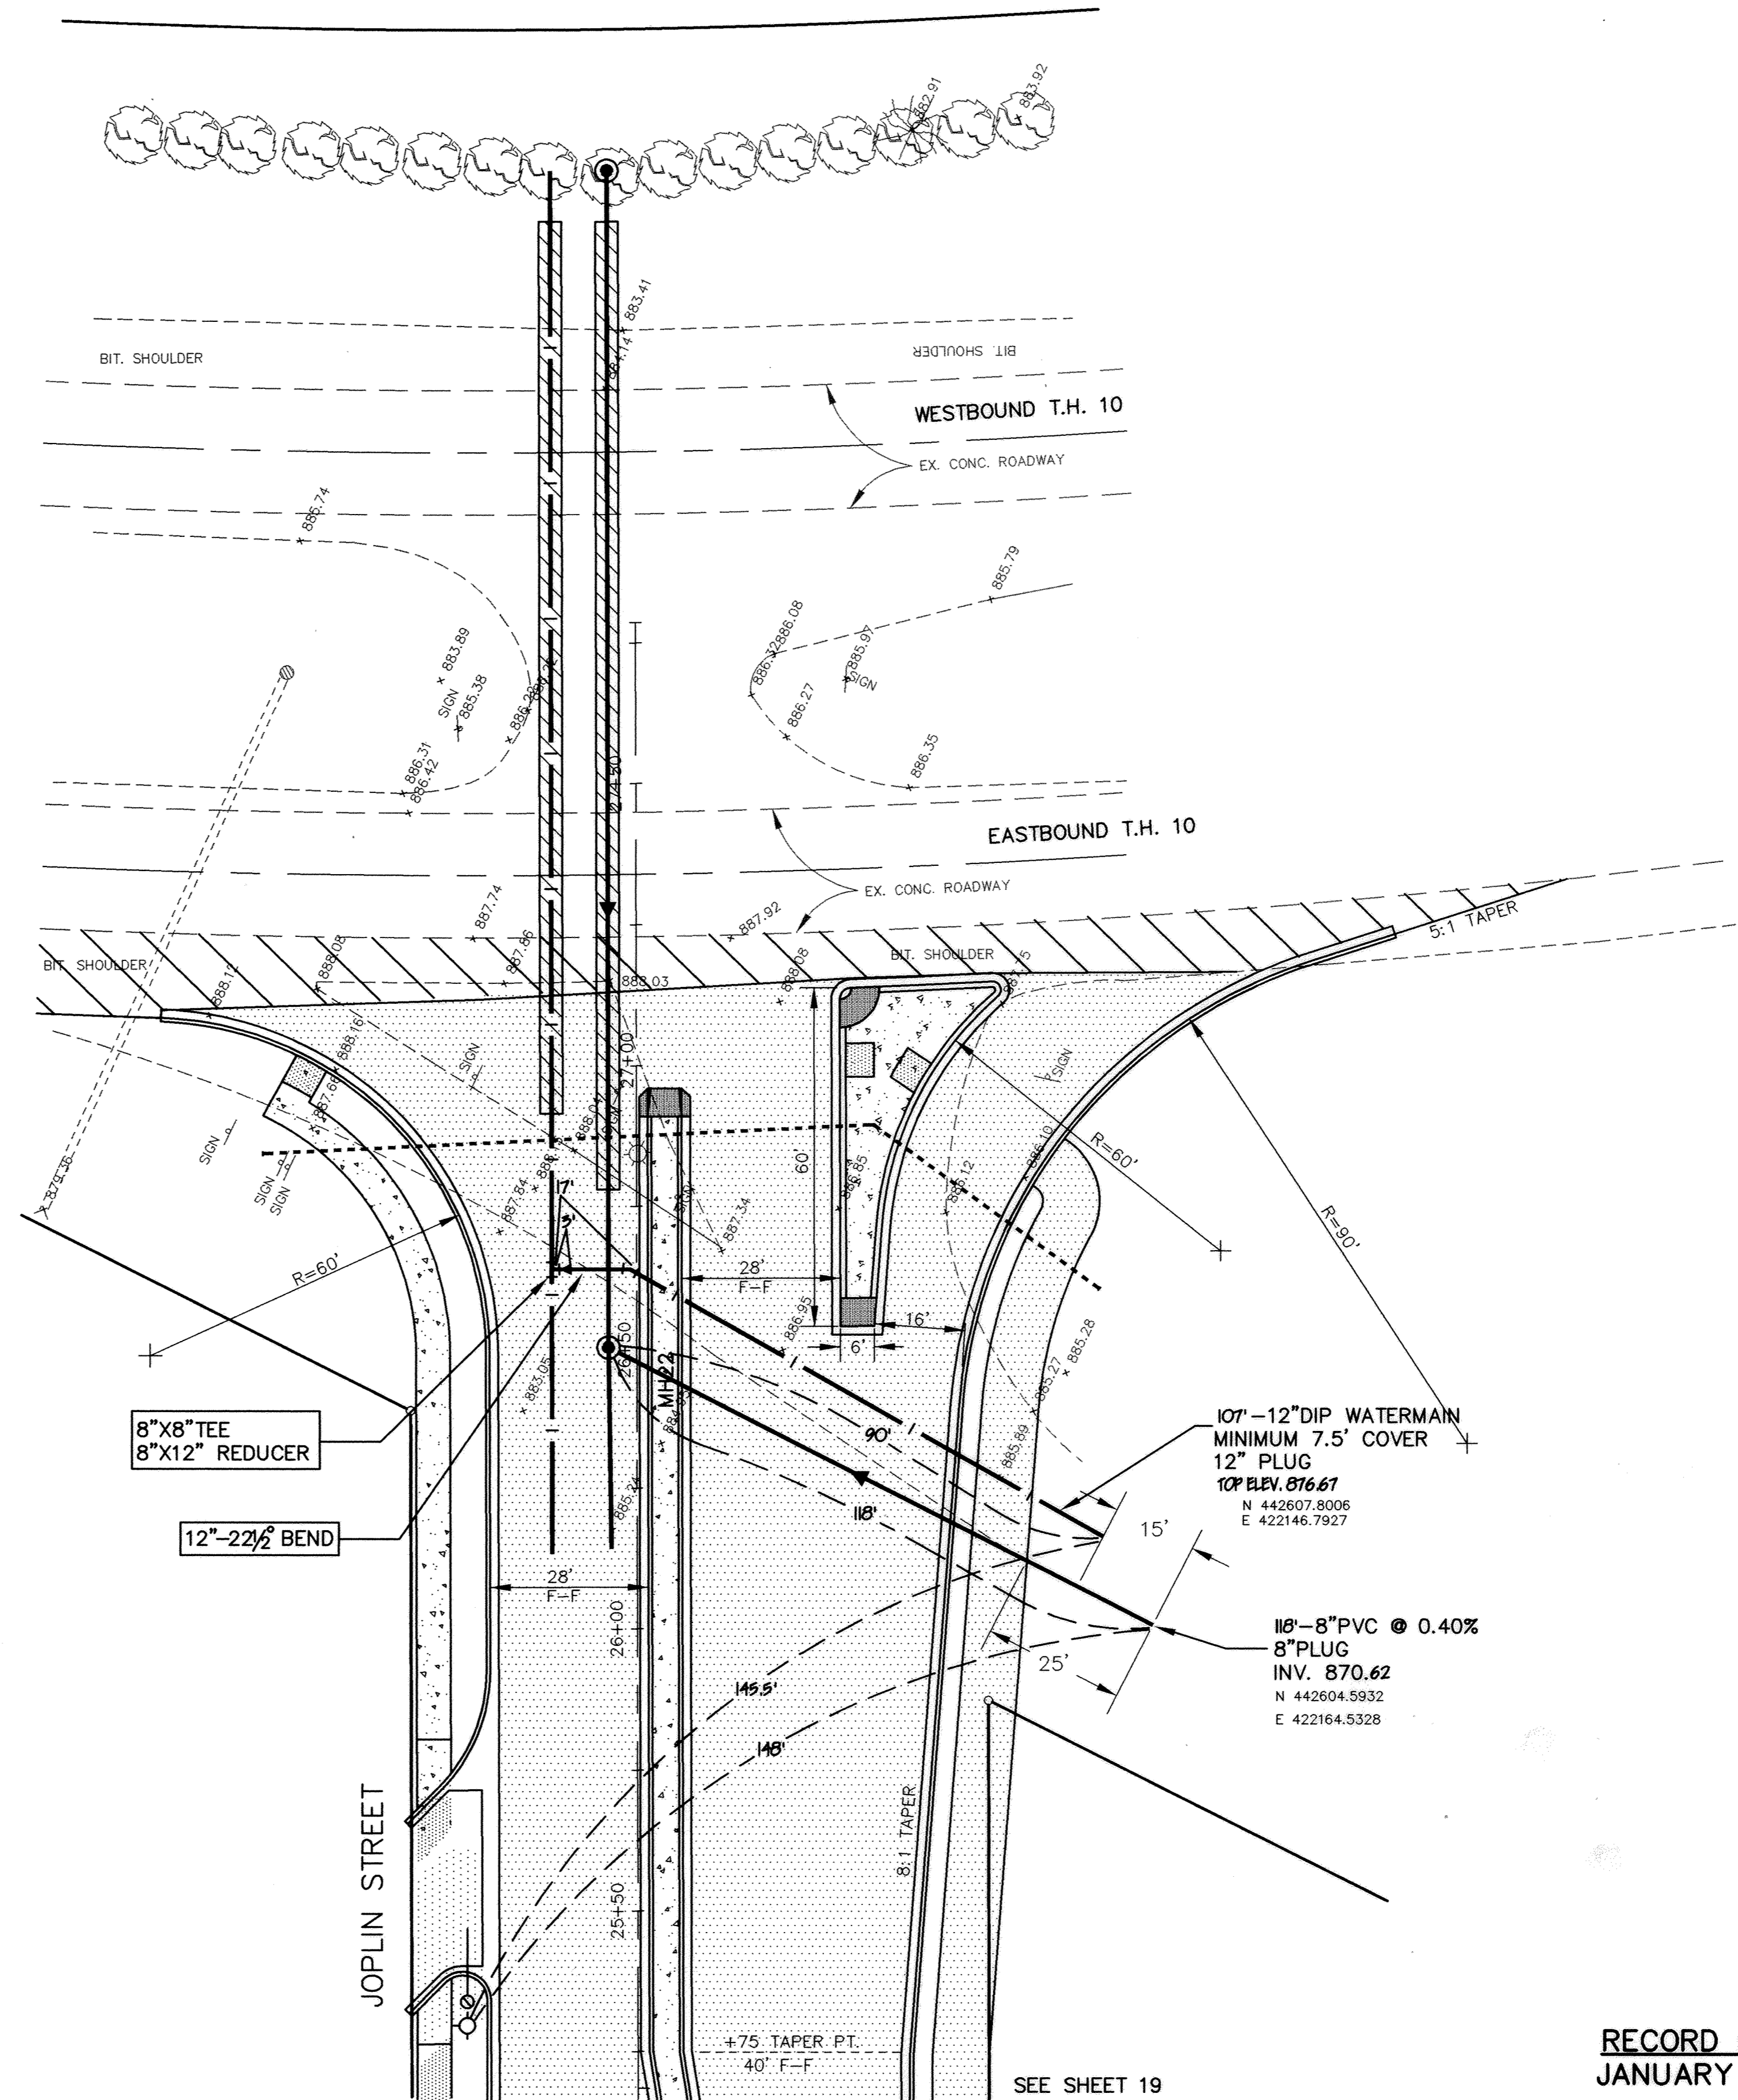

RECORD PLAN
JANUARY 1996

CITY OF ELK RIVER
FREE RIGHT TURN LANE AT T.H. 10

CHANGE ORDER NO. 2
DATE APRIL 1995 SHEET 7 OF 7 SHEETS PROJECT NO. 230-223

I HEREBY CERTIFY THAT THIS PLAN, SPECIFICATION, OR REPORT WAS PREPARED BY ME OR UNDER MY DIRECT SUPERVISION AND THAT I AM A DULY REGISTERED PROFESSIONAL ENGINEER UNDER THE LAWS OF THE STATE OF MINNESOTA.
Greg S. Stuber
DATE 4/16/95 REG. NO. 23170



1326 ENERGY PARK DRIVE
ST. PAUL, MINNESOTA 55108
(612) 644-4389
9800 SHELARD PARKWAY
MINNEAPOLIS, MINNESOTA 55441
(612) 546-0432

DATE	DESCRIPTION	DESIGNED
4-3-95	CHANGE ORDER NO. 2	CHECKED
		DRAWN

GRAPHIC SCALE
0 20
0 5
VERT.

DRAWING NUMBER

DRAWING NUMBER

DRAWING NUMBER

DRAWING NUMBER
WESTEC20.95