


SACO PRODUCTS • NEW HOPE, MINNESOTA  
REORDER BY PART NUMBER 8582  
SACO PRODUCTS • NEW HOPE, MINNESOTA  
REORDER BY PART NUMBER 8582  
SACO PRODUCTS • NEW HOPE, MINNESOTA  
REORDER BY PART NUMBER 8582  
SACO PRODUCTS • NEW HOPE, MINNESOTA  
REORDER BY PART NUMBER 8582

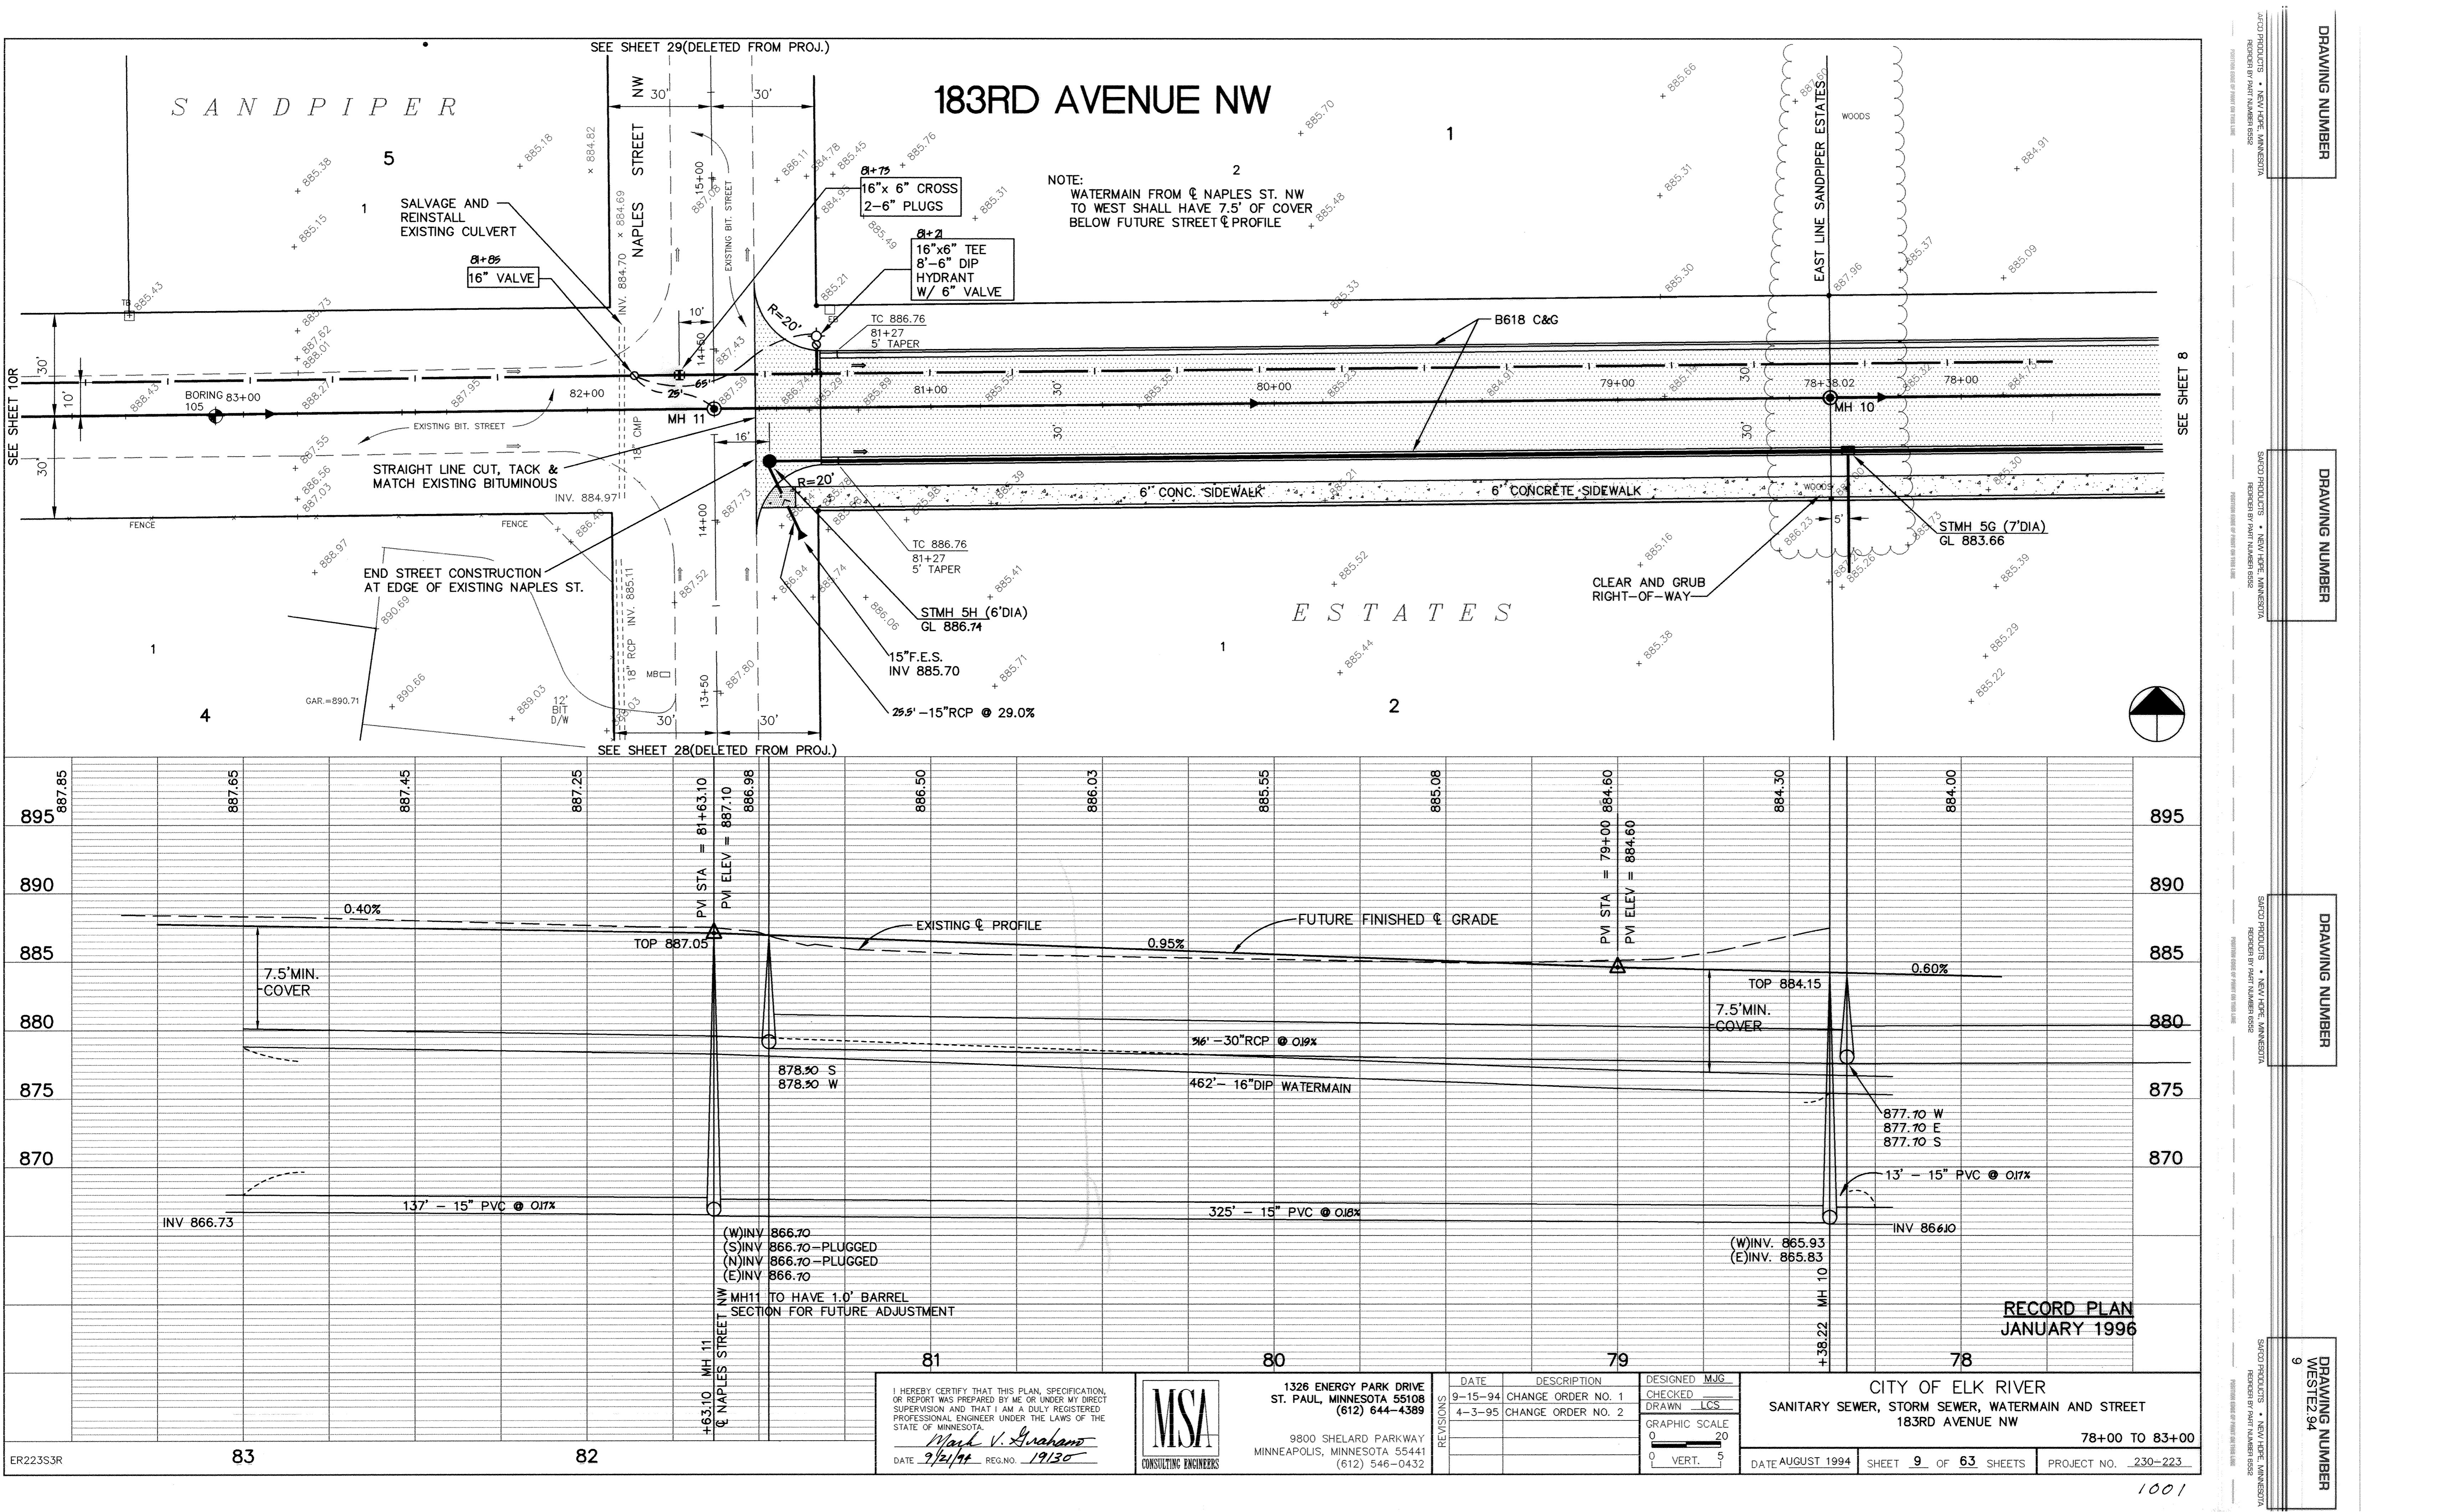


SEE SHEET 10R


SEE SHEET 29(DELETED FROM PROJ.)

SEE SHEET 28(DELETED FROM PROJ.)

SEE SHEET 8

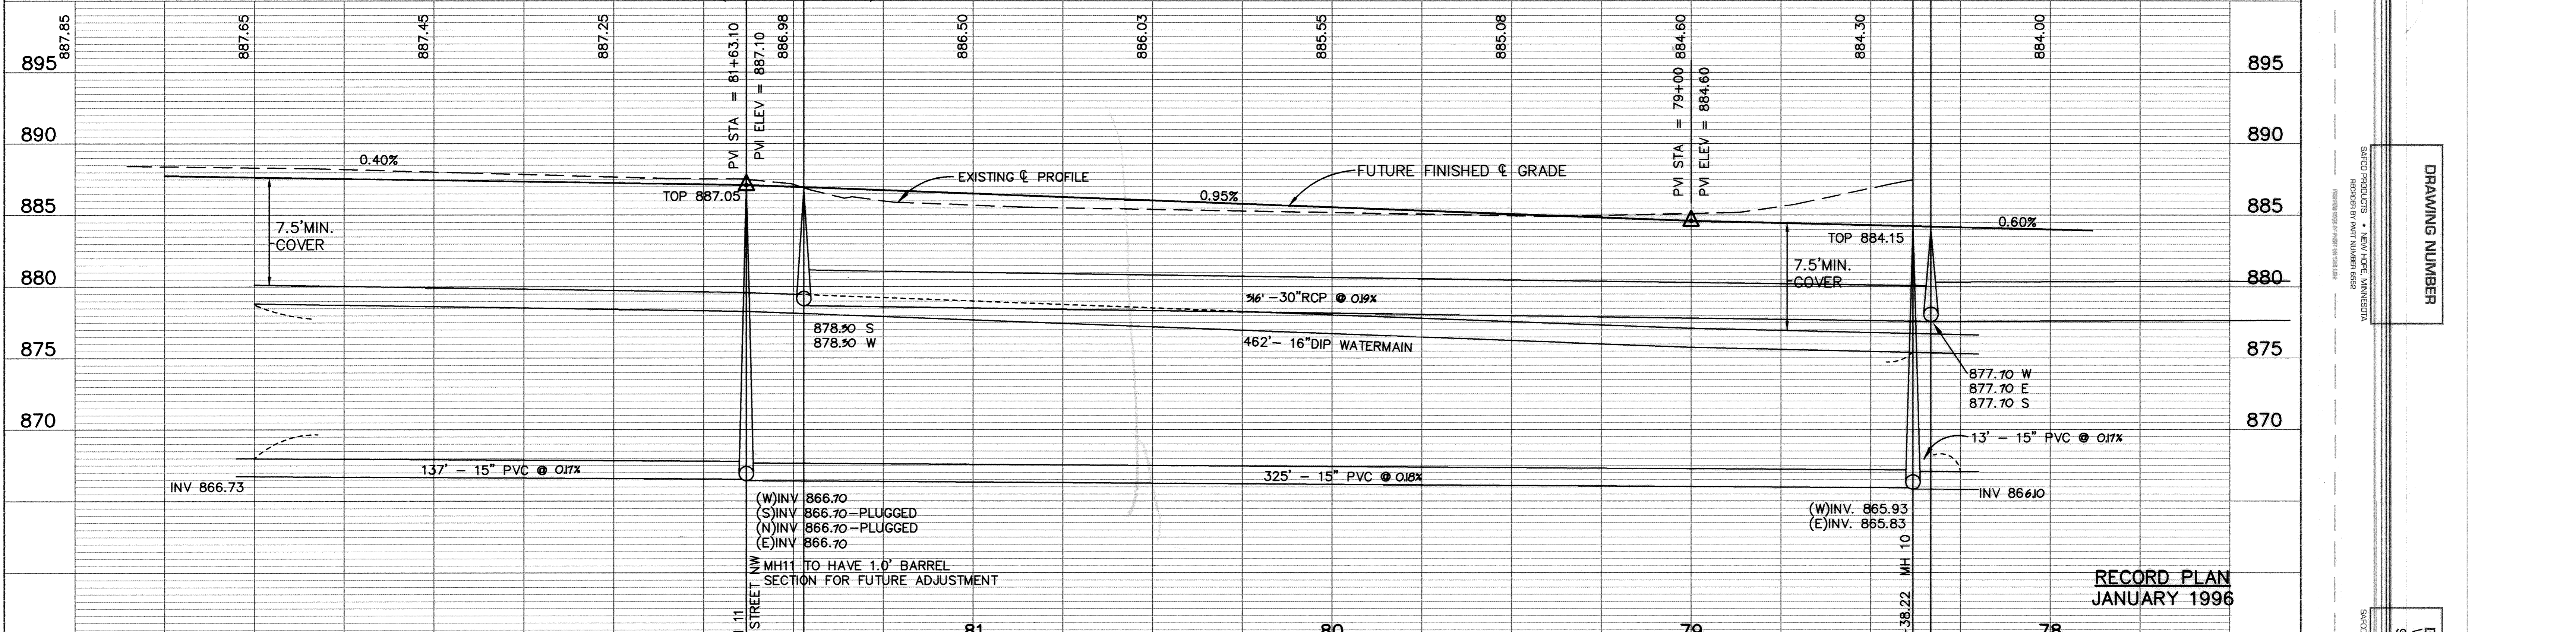

I HEREBY CERTIFY THAT THIS PLAN, SPECIFICATION, OR REPORT WAS PREPARED BY ME OR UNDER MY DIRECT SUPERVISION AND THAT I AM A DULY REGISTERED PROFESSIONAL ENGINEER UNDER THE LAWS OF THE STATE OF MINNESOTA.  
*Mark V. Grubard*  
DATE 9/21/94 REG. NO. 19130

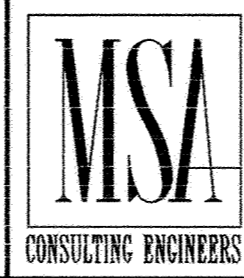

1326 ENERGY PARK DRIVE  
ST. PAUL, MINNESOTA 55108  
(612) 644-4389  
9800 SHELARD PARKWAY  
MINNEAPOLIS, MINNESOTA 55441  
(612) 546-0432

REVISIONS	DATE	DESCRIPTION
	9-15-94	CHANGE ORDER NO. 1
	4-3-95	CHANGE ORDER NO. 2

DESIGNED M.J.G.  
CHECKED \_\_\_\_\_  
DRAWN LCS  
GRAPHIC SCALE  
0 20  
0 5  
VERT.

CITY OF ELK RIVER  
SANITARY SEWER, STORM SEWER, WATERMAIN AND STREET  
183RD AVENUE NW  
78+00 TO 83+00  
DATE AUGUST 1994 SHEET 9 OF 63 SHEETS PROJECT NO. 230-223

RECORD PLAN  
JANUARY 1996