

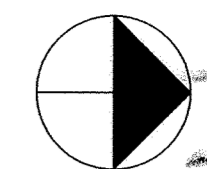


SAICO PRODUCTS • NEW HOPK, MINNESOTA
REVISION BY PART NUMBER 6528
SAICO PRODUCTS • NEW HOPK, MINNESOTA
REVISION BY PART NUMBER 6528
SAICO PRODUCTS • NEW HOPK, MINNESOTA
REVISION BY PART NUMBER 6528
SAICO PRODUCTS • NEW HOPK, MINNESOTA
REVISION BY PART NUMBER 6528

JOPLIN STREET

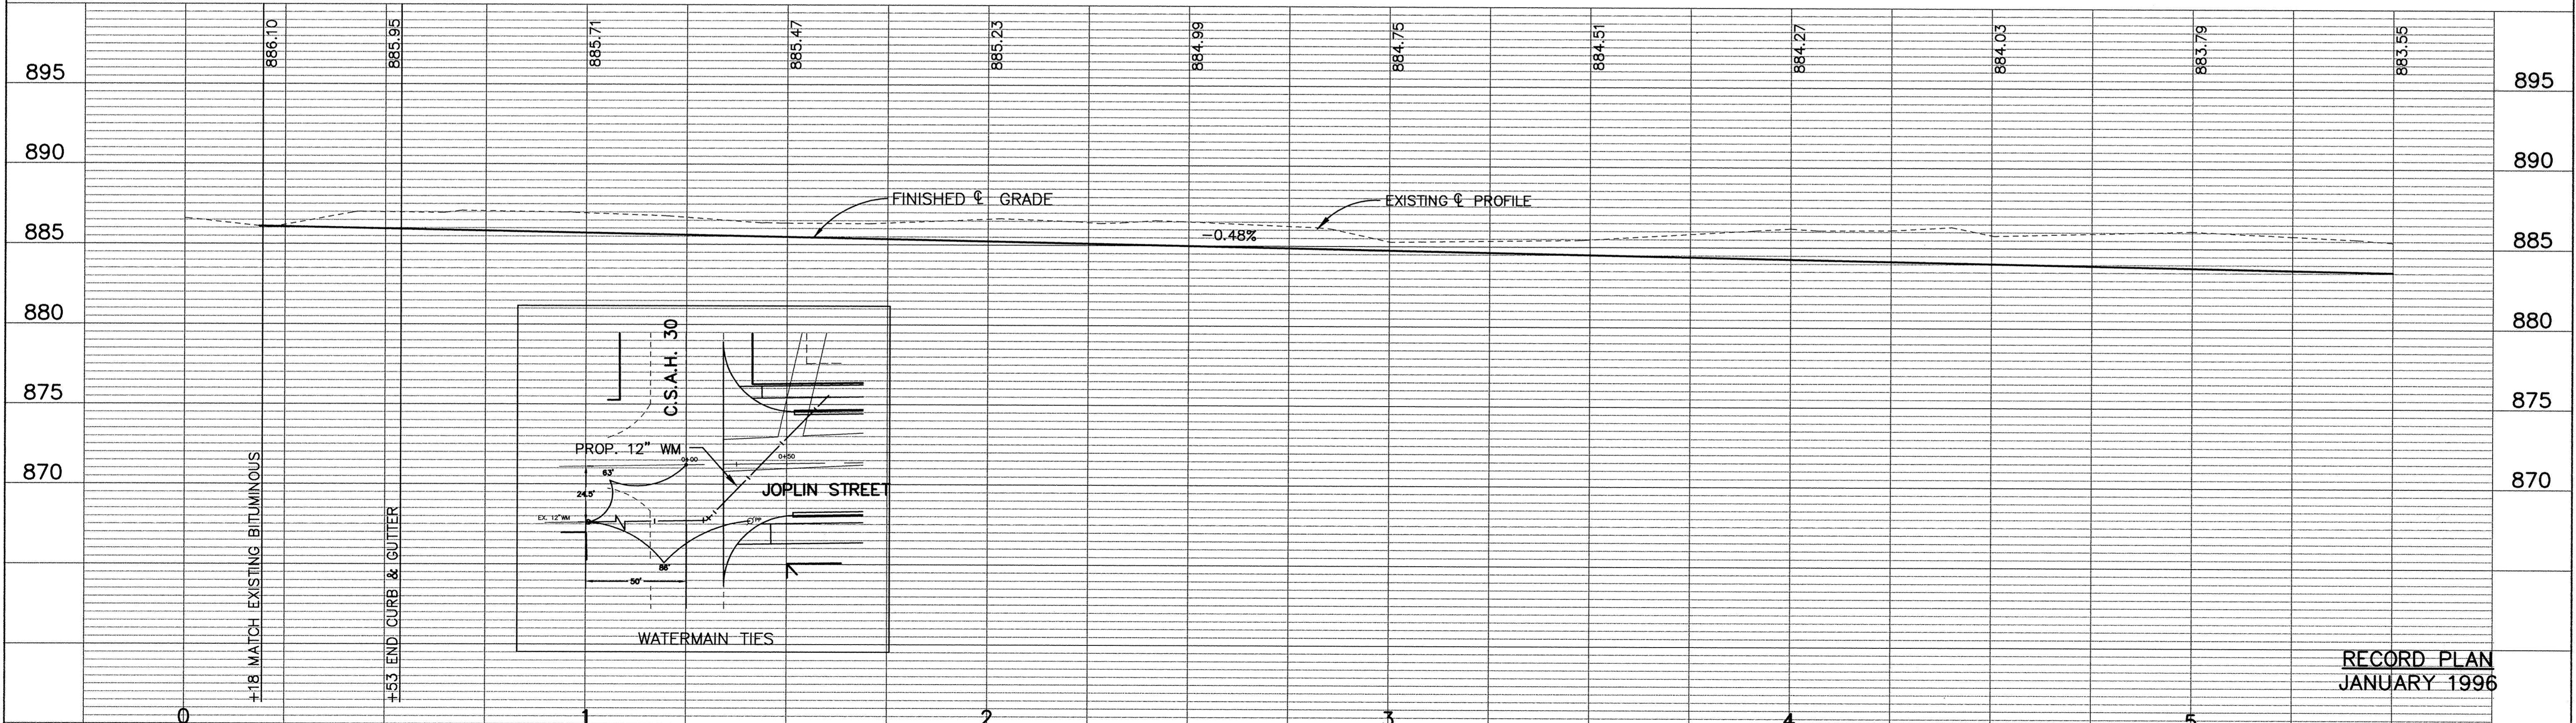

182ND AVENUE

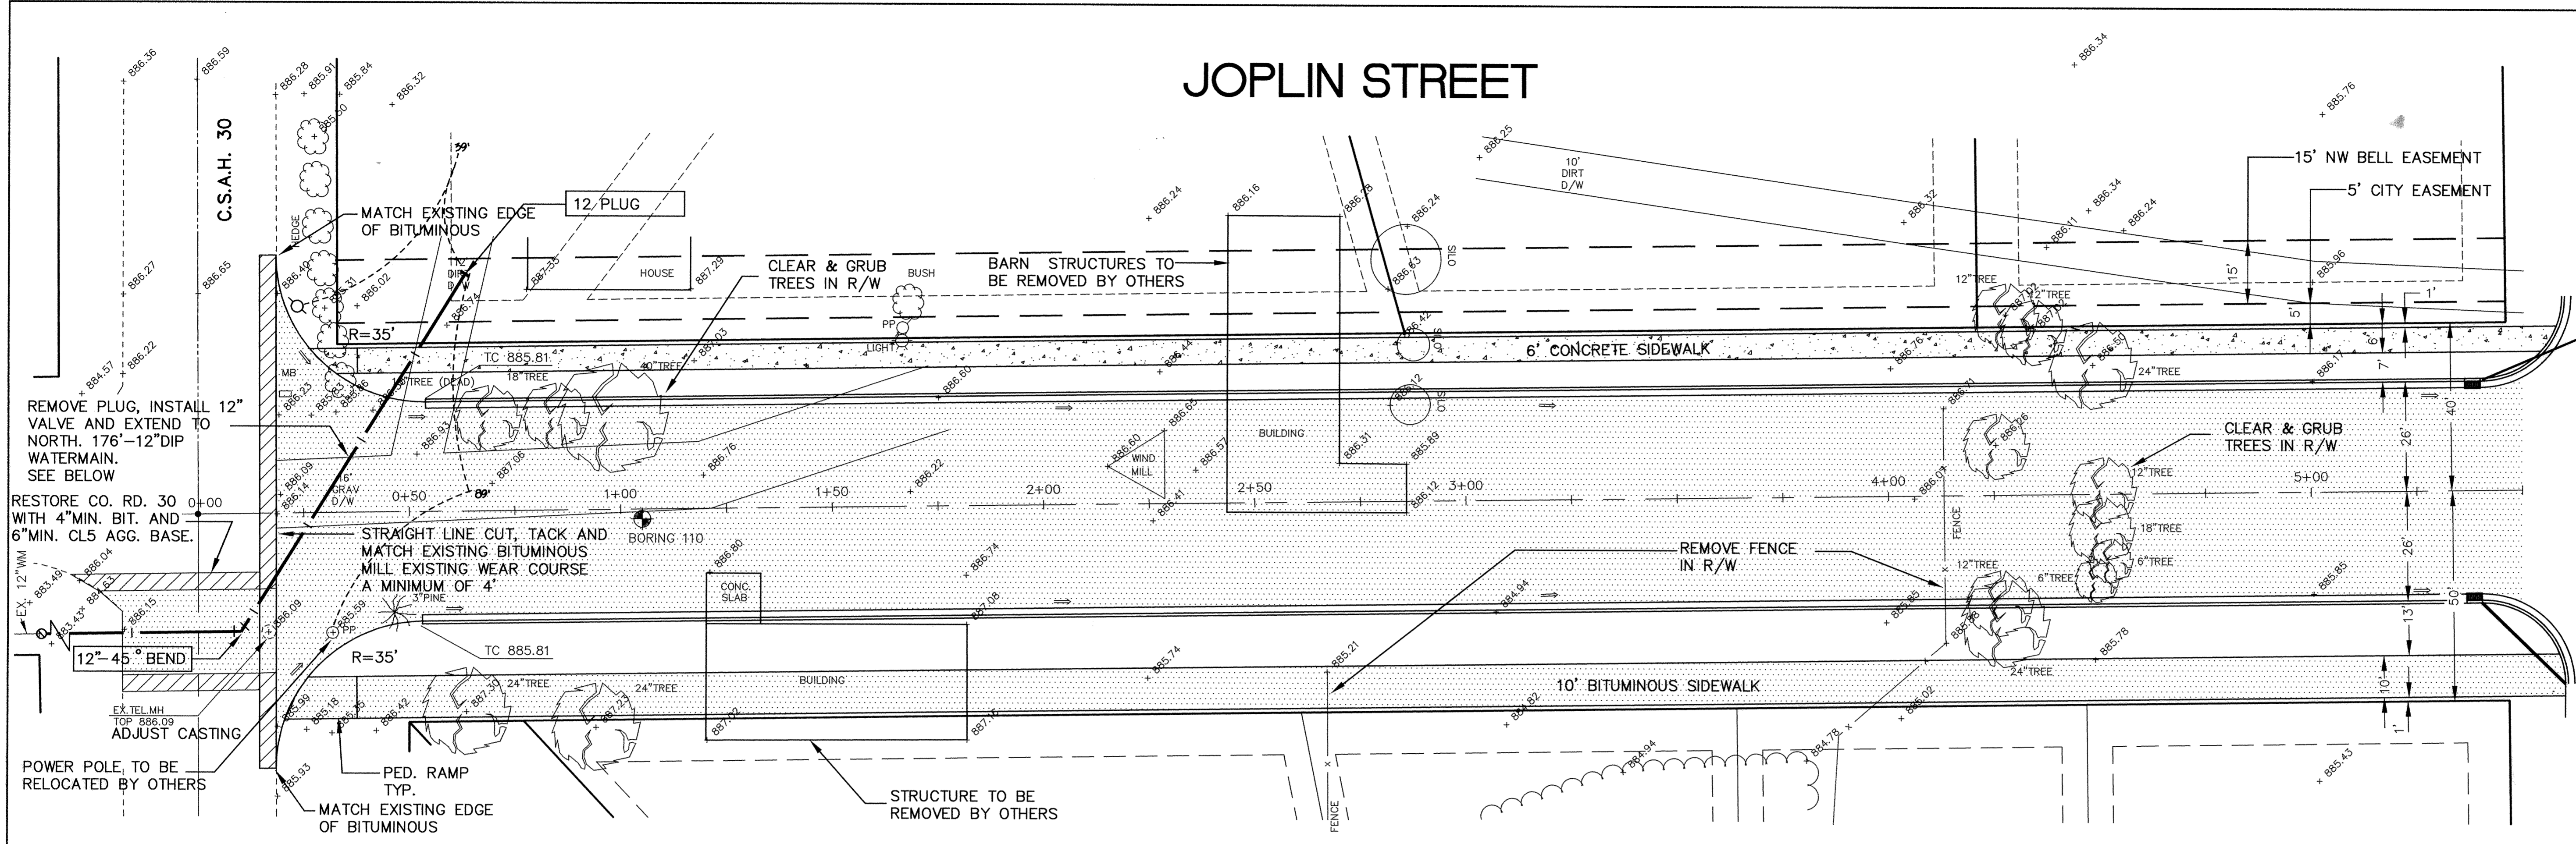

RECORD PLAN
JANUARY 1996

I HEREBY CERTIFY THAT THIS PLAN, SPECIFICATION, OR REPORT WAS PREPARED BY ME OR UNDER MY DIRECT SUPERVISION AND THAT I AM A DULY REGISTERED PROFESSIONAL ENGINEER UNDER THE LAWS OF THE STATE OF MINNESOTA.

Mark V. Graham
DATE 9/21/94 REG. NO. 19130



1326 ENERGY PARK DRIVE
ST. PAUL, MINNESOTA 55108
(612) 644-4389

9800 SHELDAR PARKWAY
MINNEAPOLIS, MINNESOTA 55441
(612) 546-0432

REVISIONS	DATE	DESCRIPTION
	9-15-94	ADDED N.W. BELL EASE.

DESIGNED LCS
CHECKED LCS
DRAWN LCS

GRAPHIC SCALE
0 20
VERT. 5

CITY OF ELK RIVER
STREET
JOPLIN STREET

0+00 TO 5+50

DATE AUG. 1994 SHEET 15R OF 63 SHEETS PROJECT NO. 230-223