


# T.H. 10 JACK-BORING AT JOPLIN STREET

SEE SHEET 19


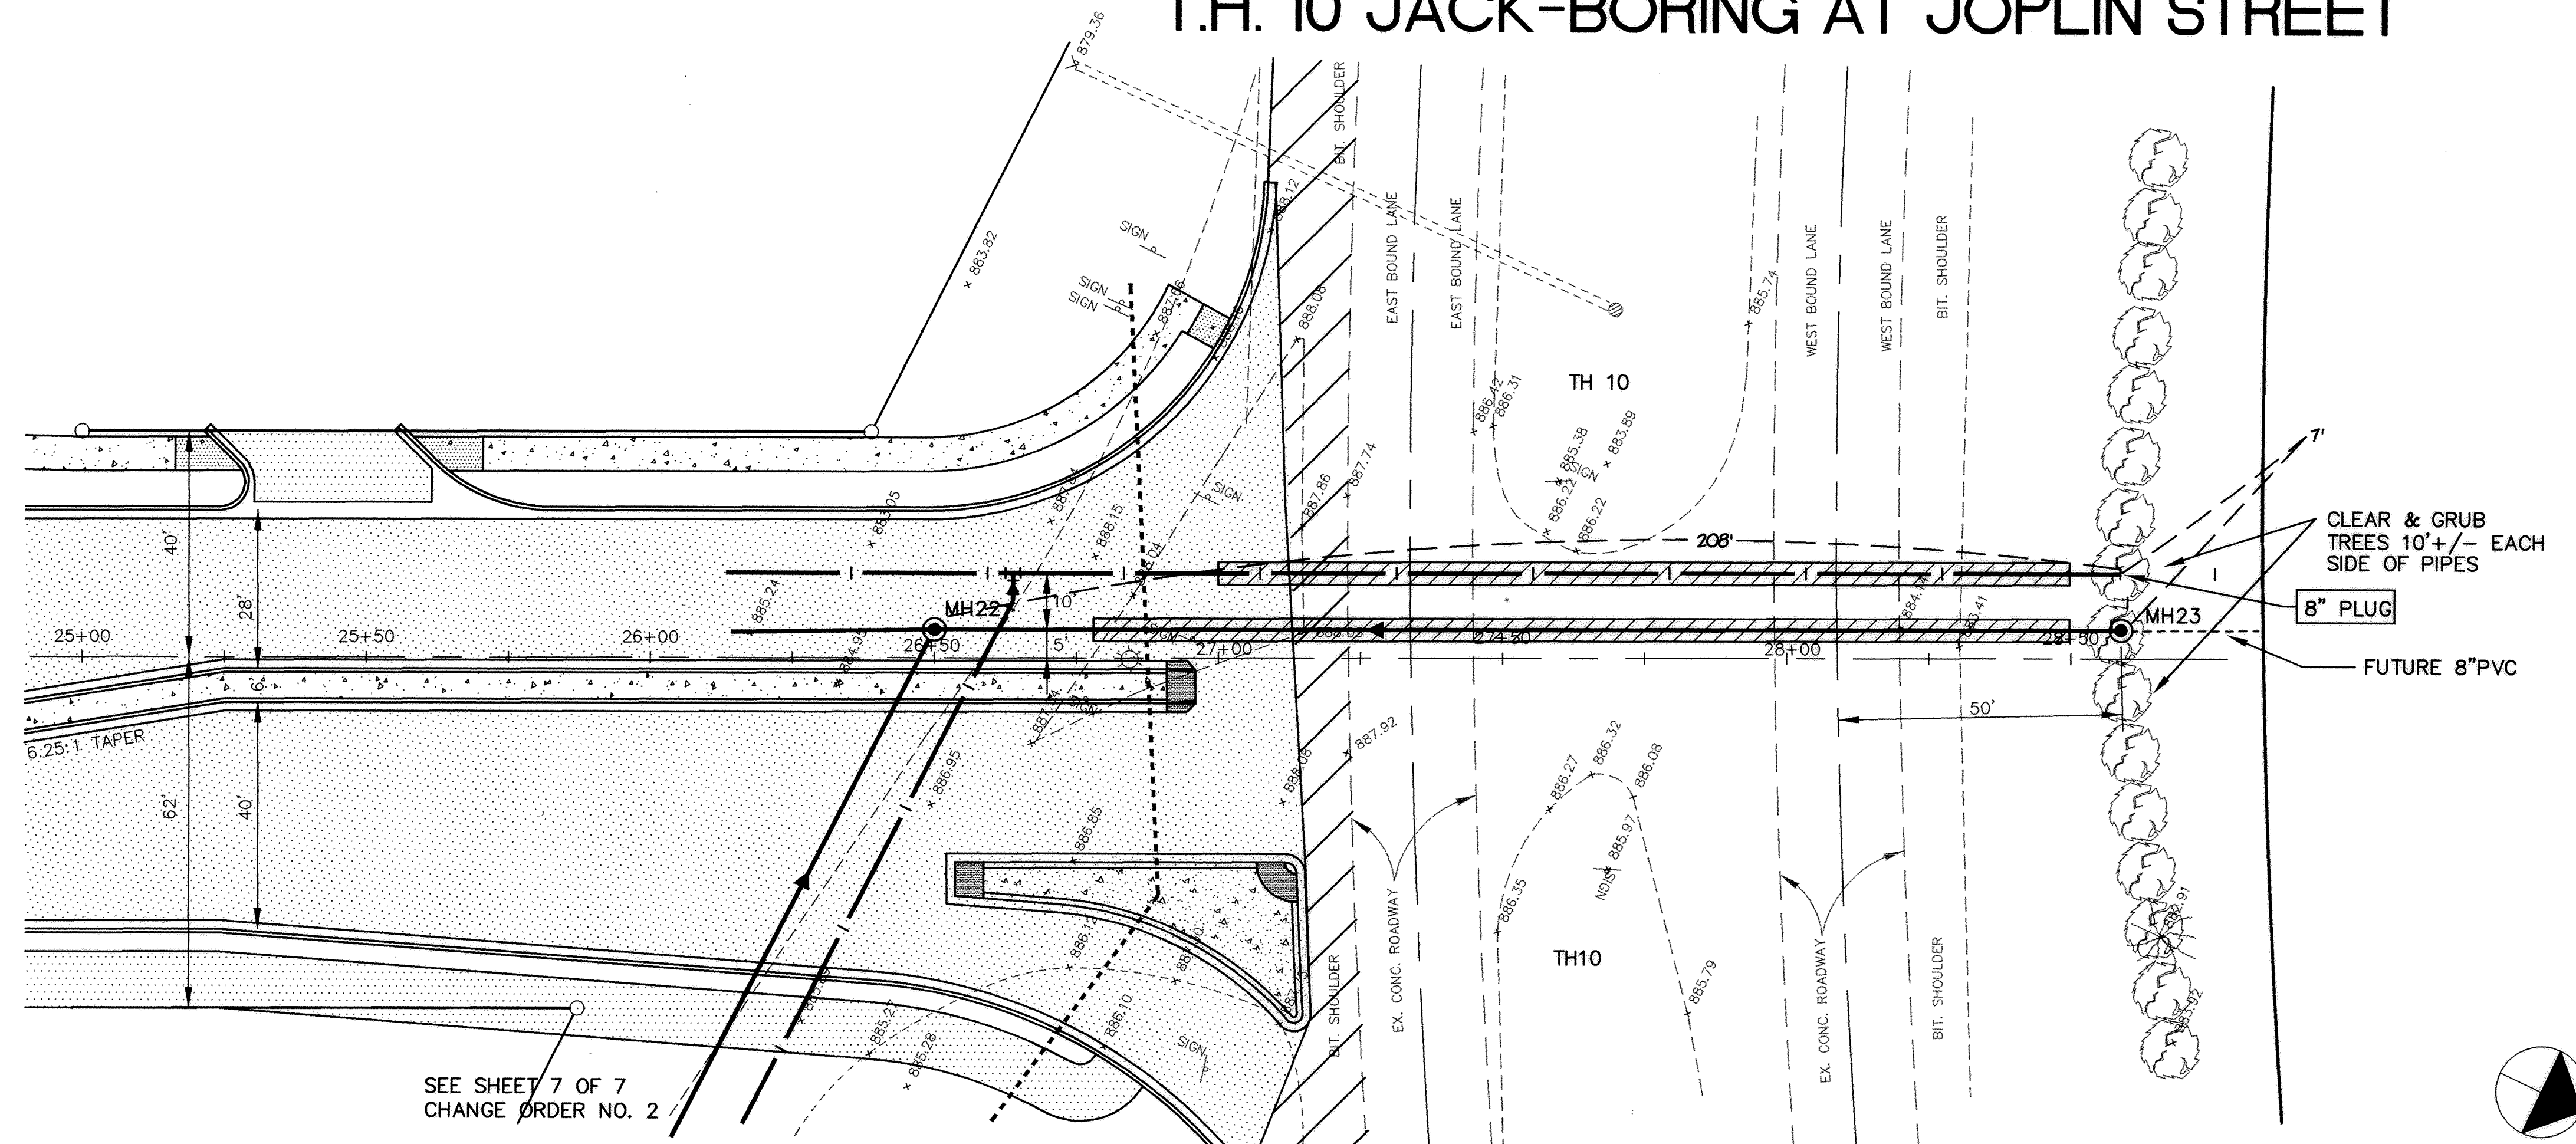


SEE SHEET 7 OF 7  
CHANGE ORDER NO. 2

CLEAR & GRUB  
TREES 10'+/- EACH  
SIDE OF PIPES


8" PLUG

FUTURE 8" PVC

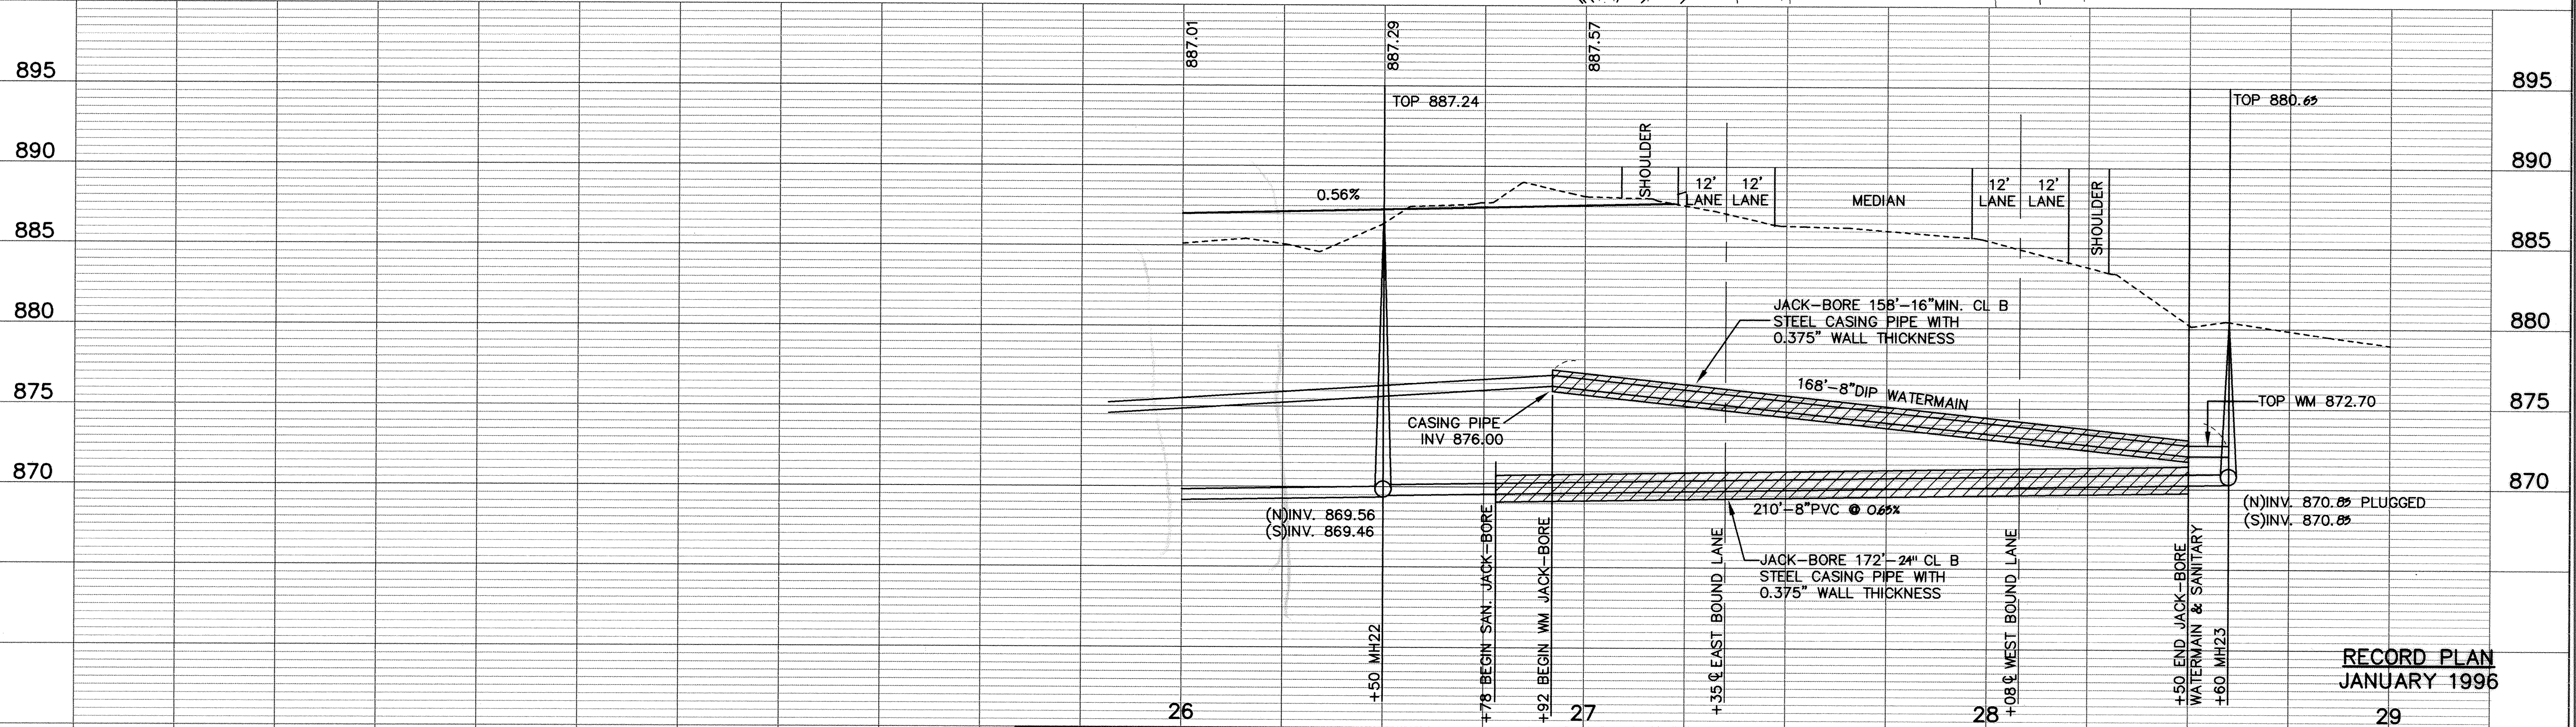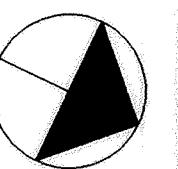

RECORD PLAN  
JANUARY 1996

I HEREBY CERTIFY THAT THIS PLAN, SPECIFICATION,  
OR REPORT WAS PREPARED BY ME OR UNDER MY DIRECT  
SUPERVISION AND THAT I AM A DULY REGISTERED  
PROFESSIONAL ENGINEER UNDER THE LAWS OF THE  
STATE OF MINNESOTA.  
*Mark J. Abraham*  
DATE 9/21/94 REG. NO. 19130

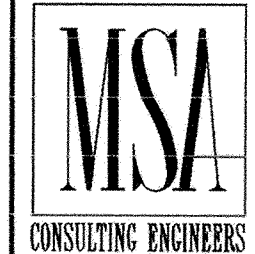

1326 ENERGY PARK DRIVE  
ST. PAUL, MINNESOTA 55108  
(612) 644-4389  
9800 SHELARD PARKWAY  
MINNEAPOLIS, MINNESOTA 55441  
(612) 546-0432

DATE	DESCRIPTION	DESIGNED
4-3-95	CHANGE ORDER NO. 3	CHECKED
		DRAWN
		GRAPHIC SCALE
		0 20
		0 5
		VERT.

CITY OF ELK RIVER		
SANITARY SEWER AND WATERMAIN JACKING		
T.H. 10 JACK-BORING AT JOPLIN STREET		
26+50 TO 28+60		
DATE AUG. 1994	SHEET 20 OF 63 SHEETS	PROJECT NO. 230-223