

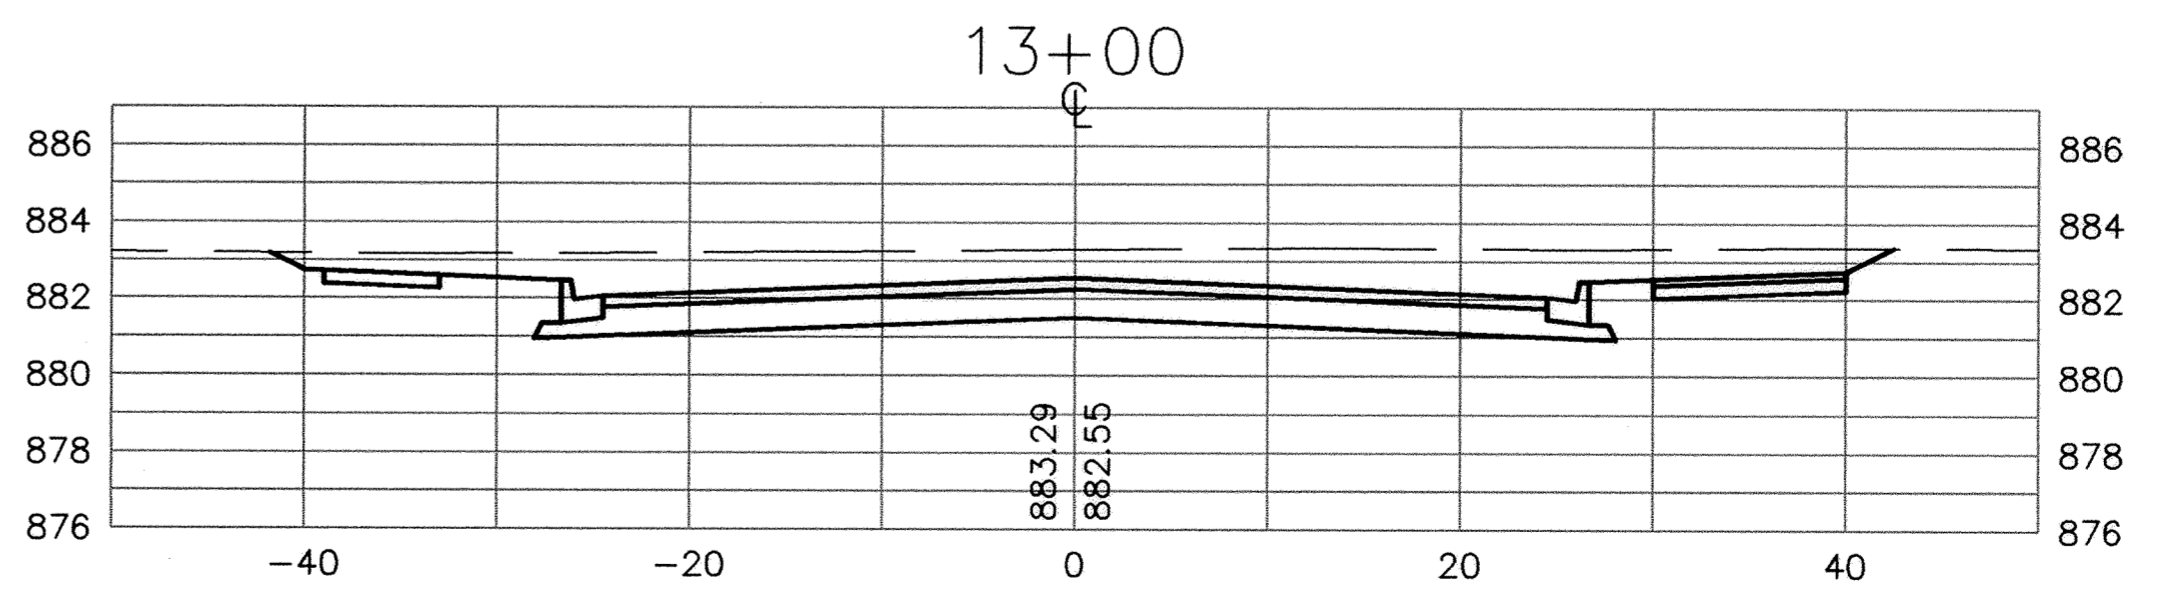
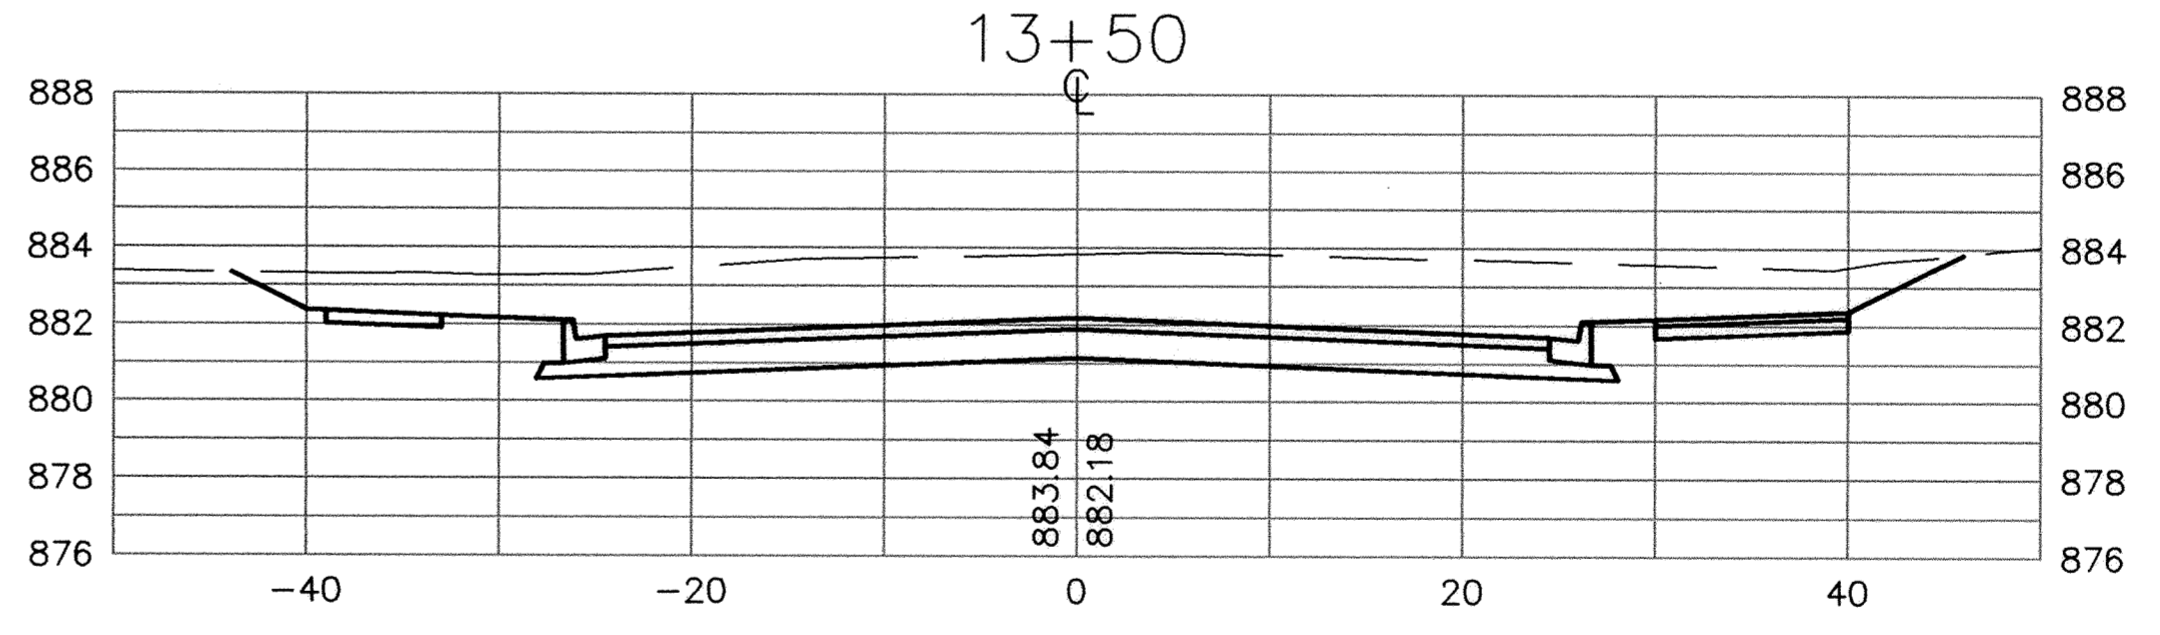
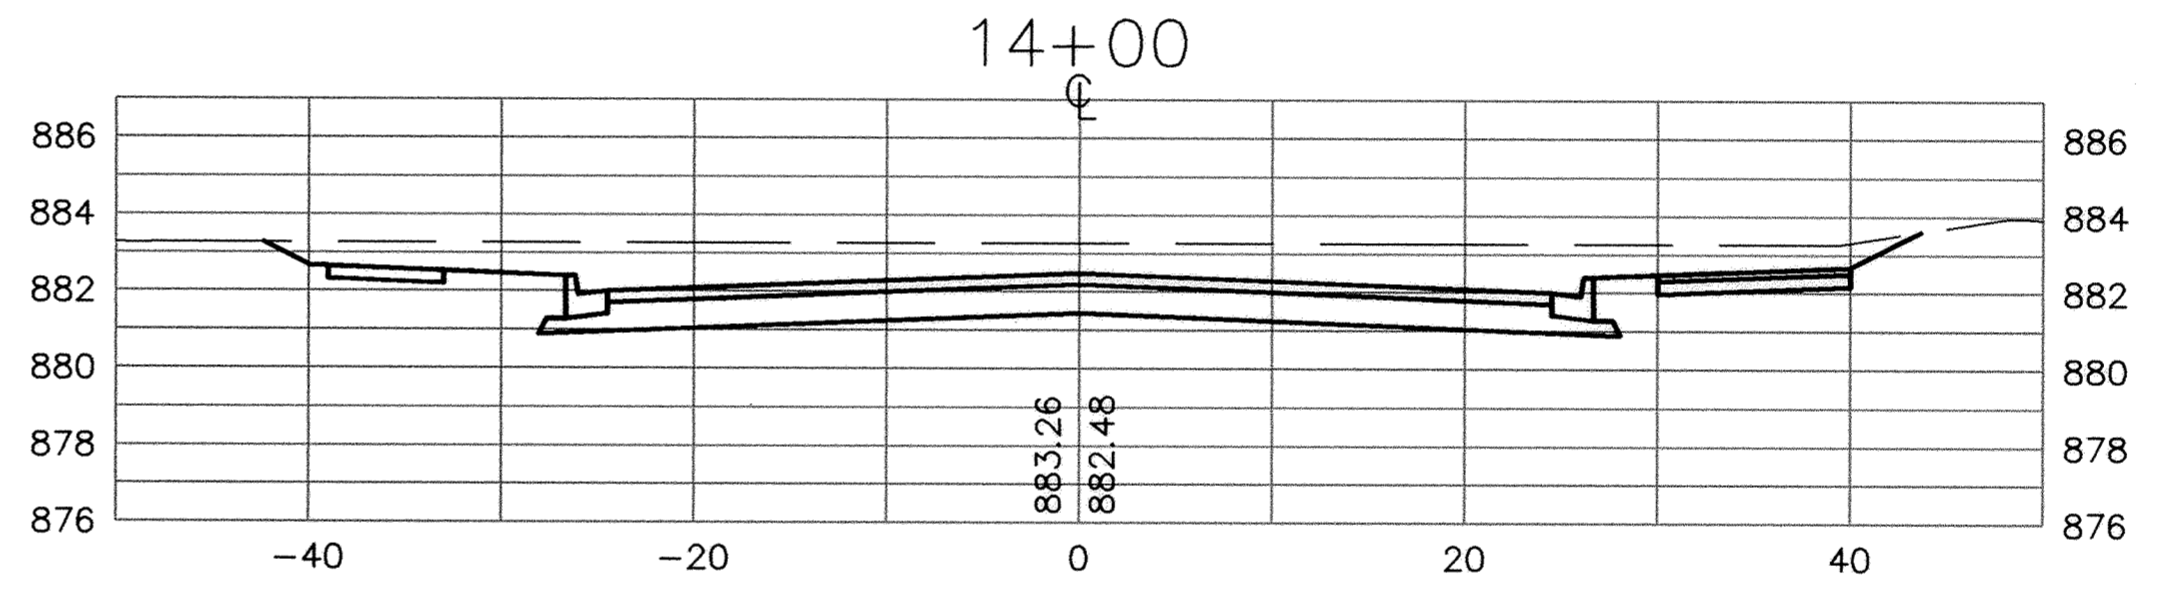
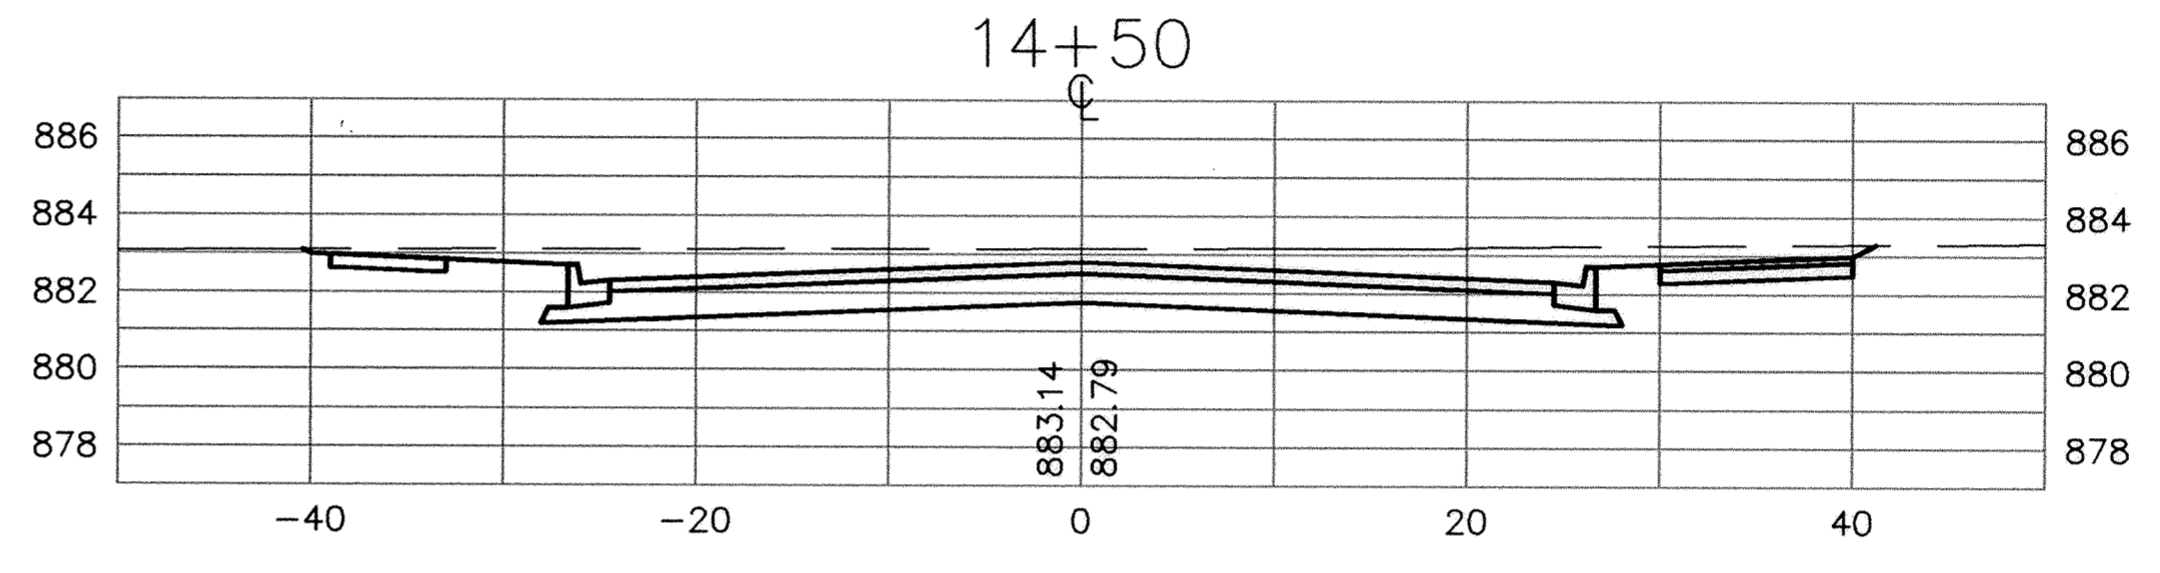
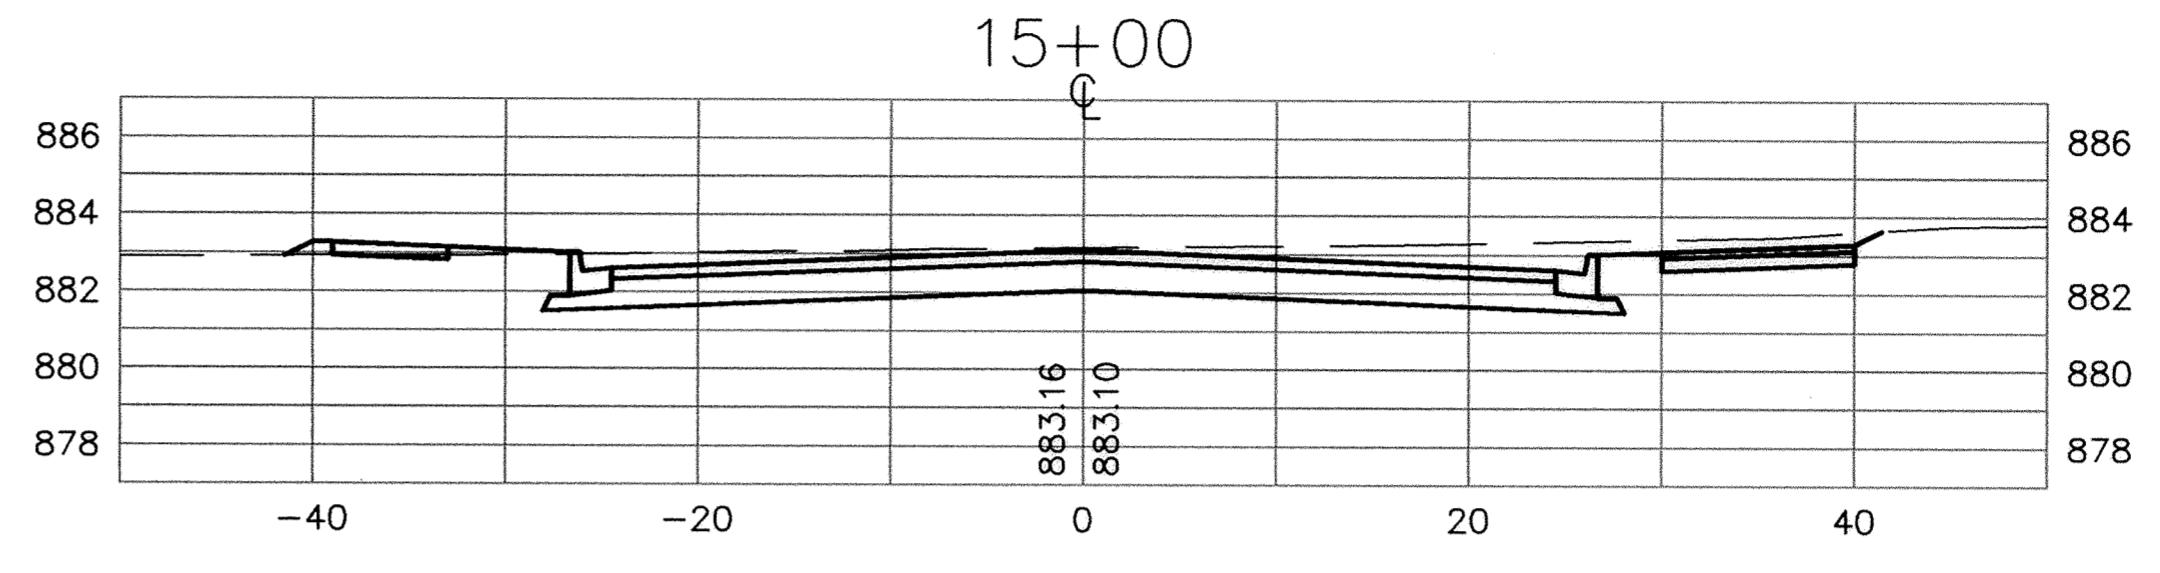
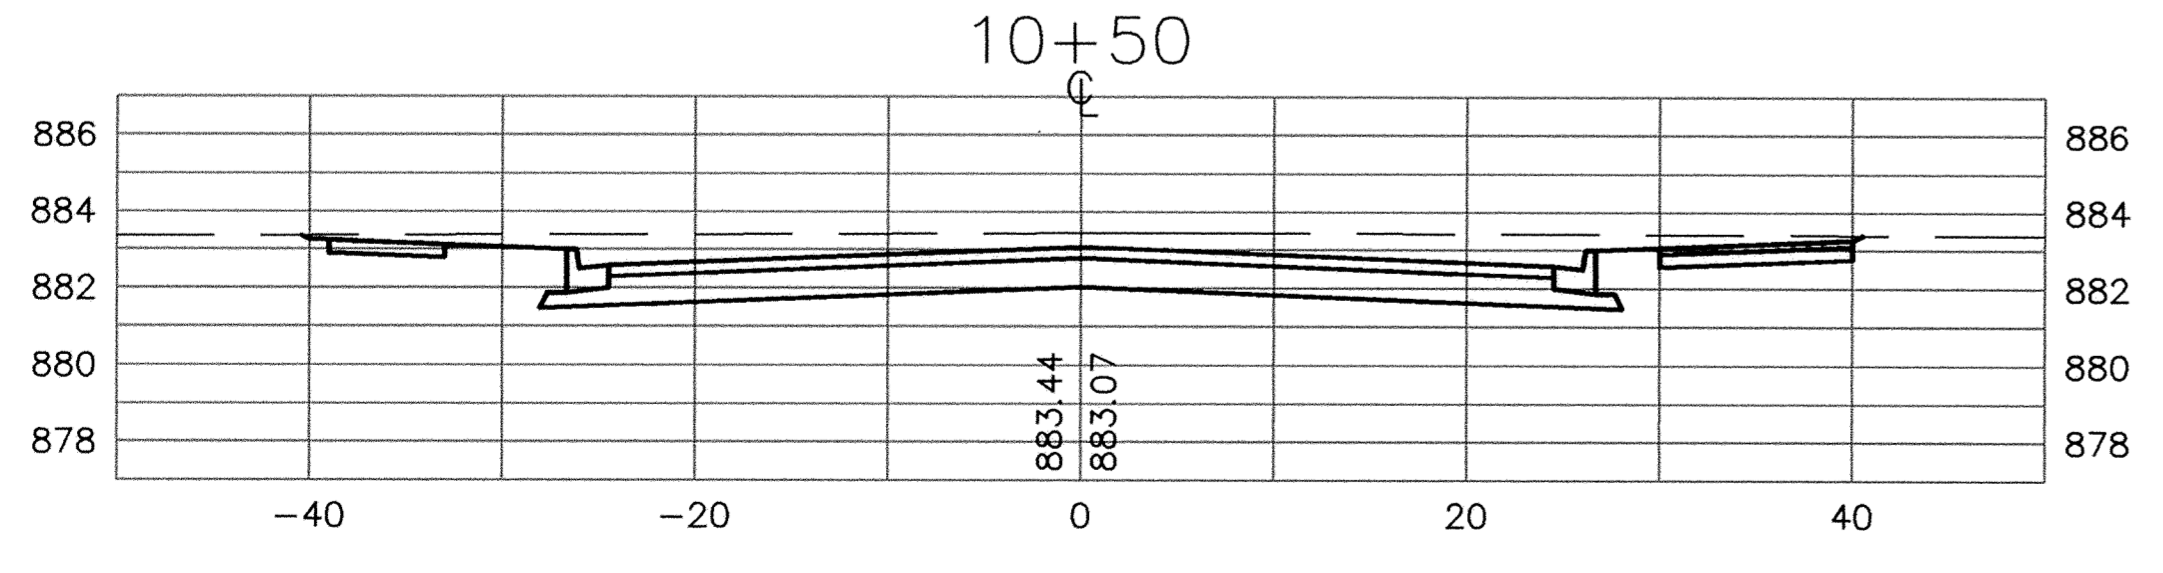
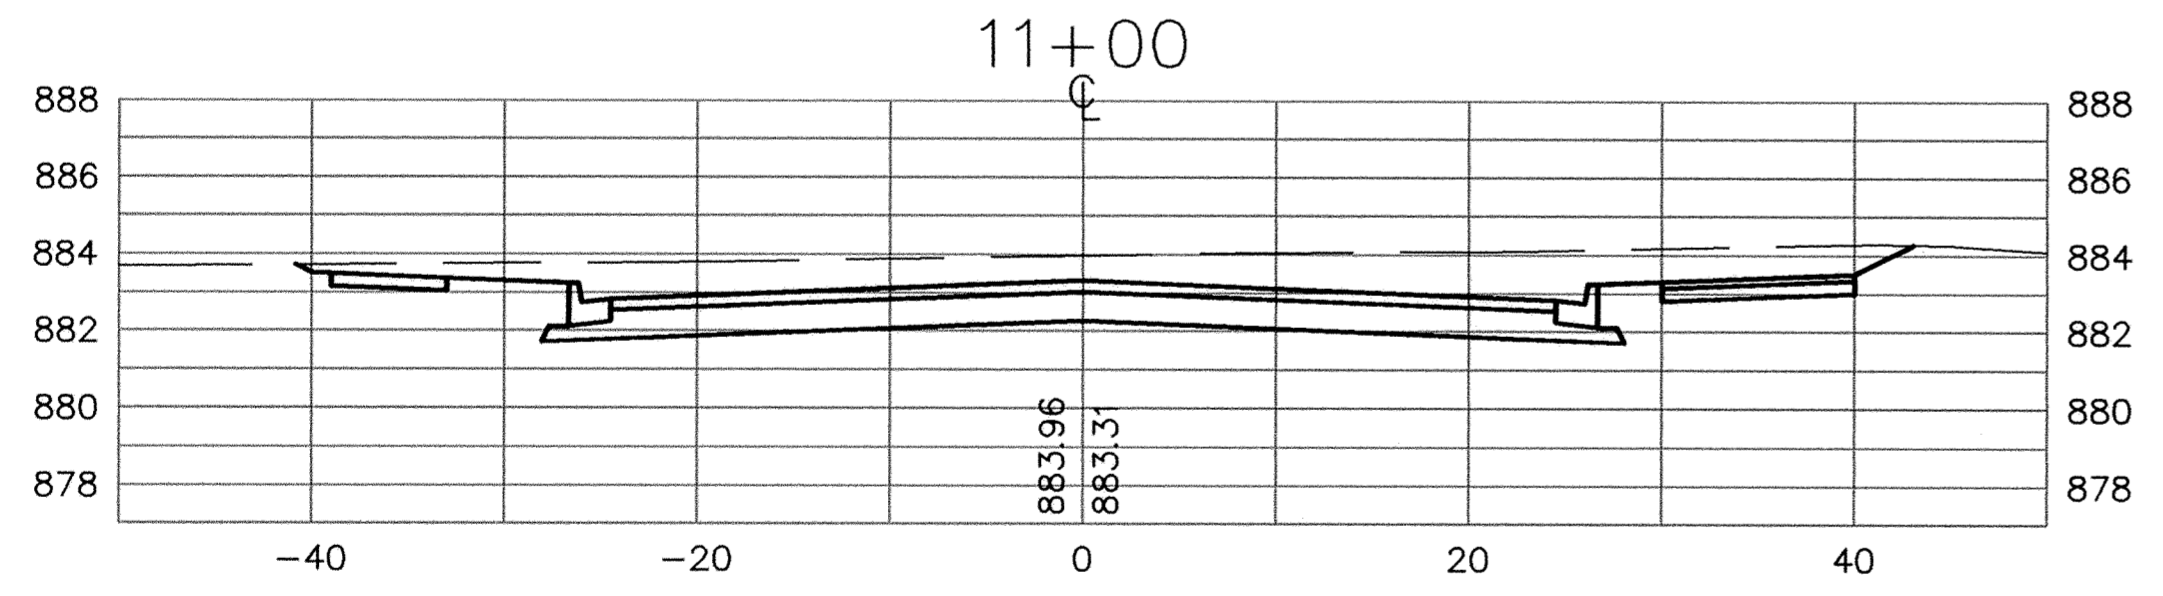
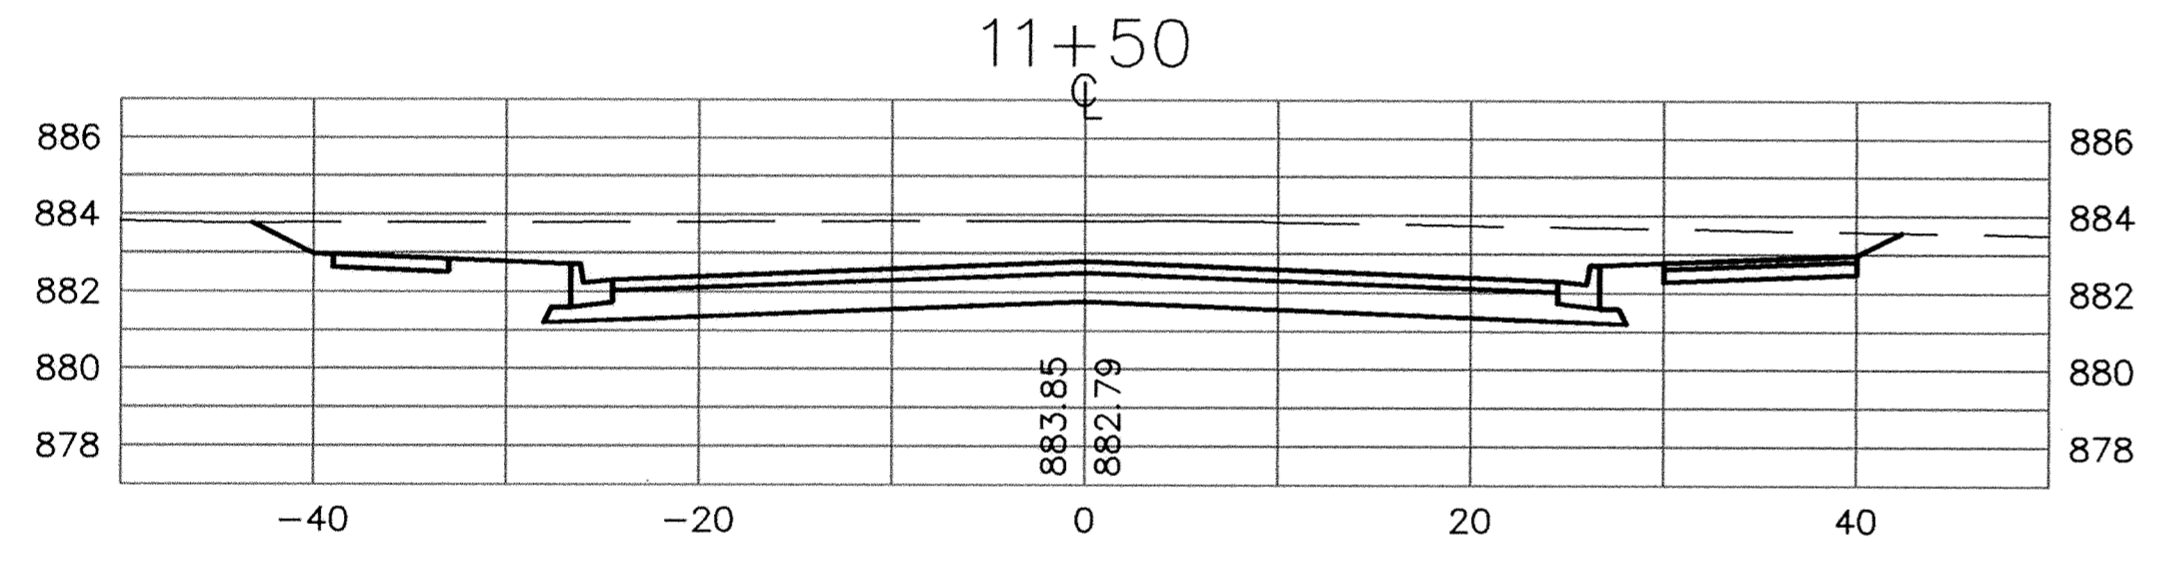
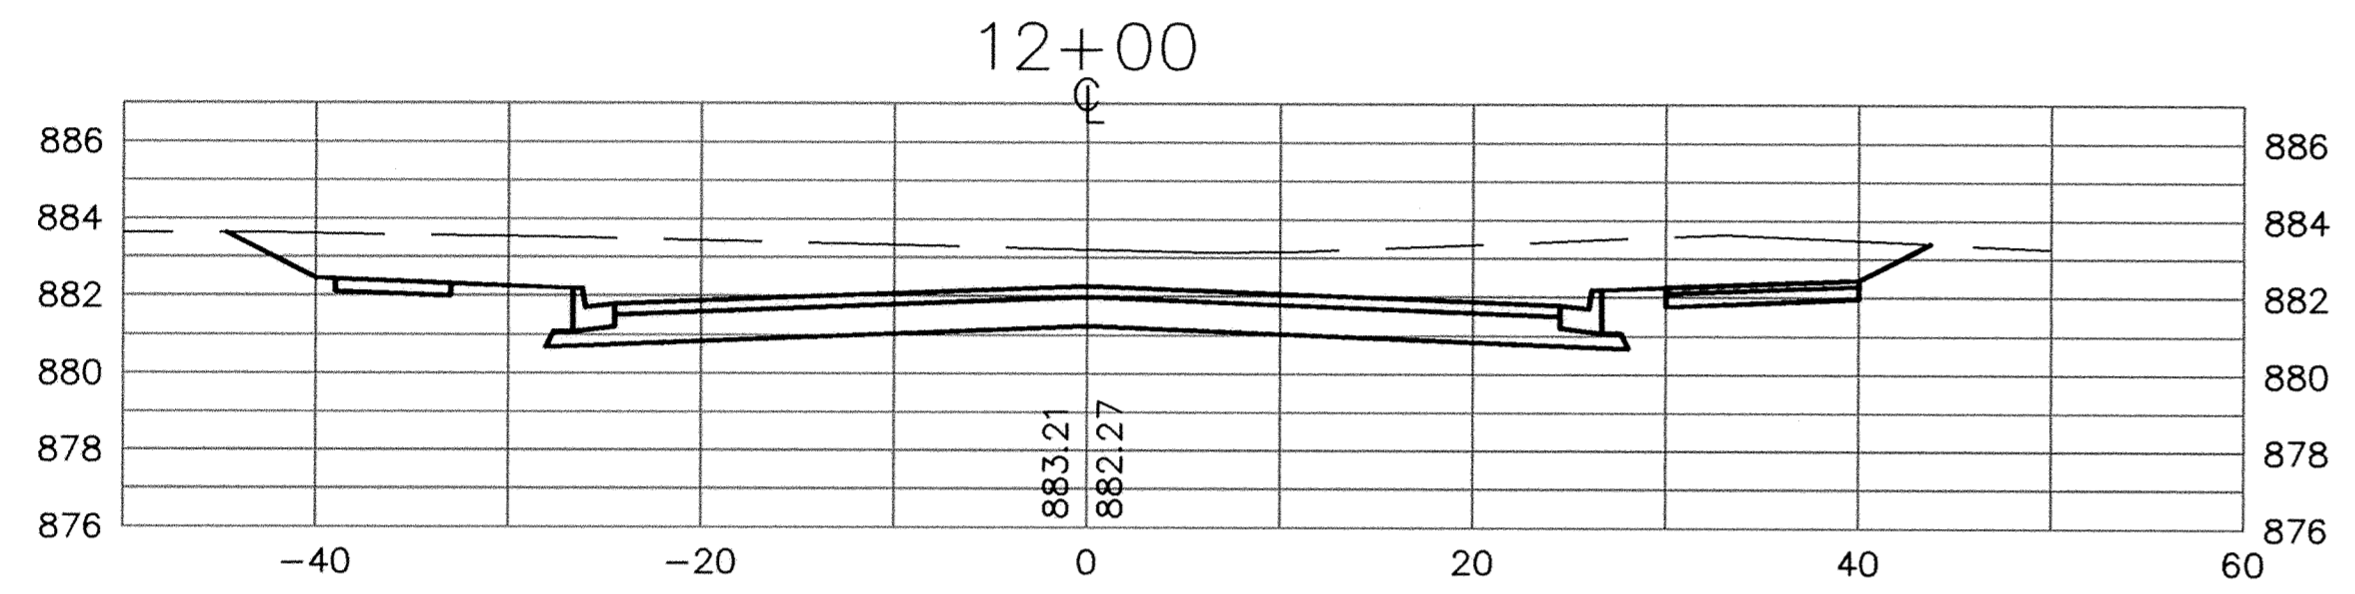


SACO PRODUCTS • NEW HOPE, MINNESOTA
 REGISTERED BY PART NUMBER 6932
 SACO PRODUCTS • NEW HOPE, MINNESOTA
 REGISTERED BY PART NUMBER 6932
 SACO PRODUCTS • NEW HOPE, MINNESOTA
 REGISTERED BY PART NUMBER 6932
 SACO PRODUCTS • NEW HOPE, MINNESOTA
 REGISTERED BY PART NUMBER 6932

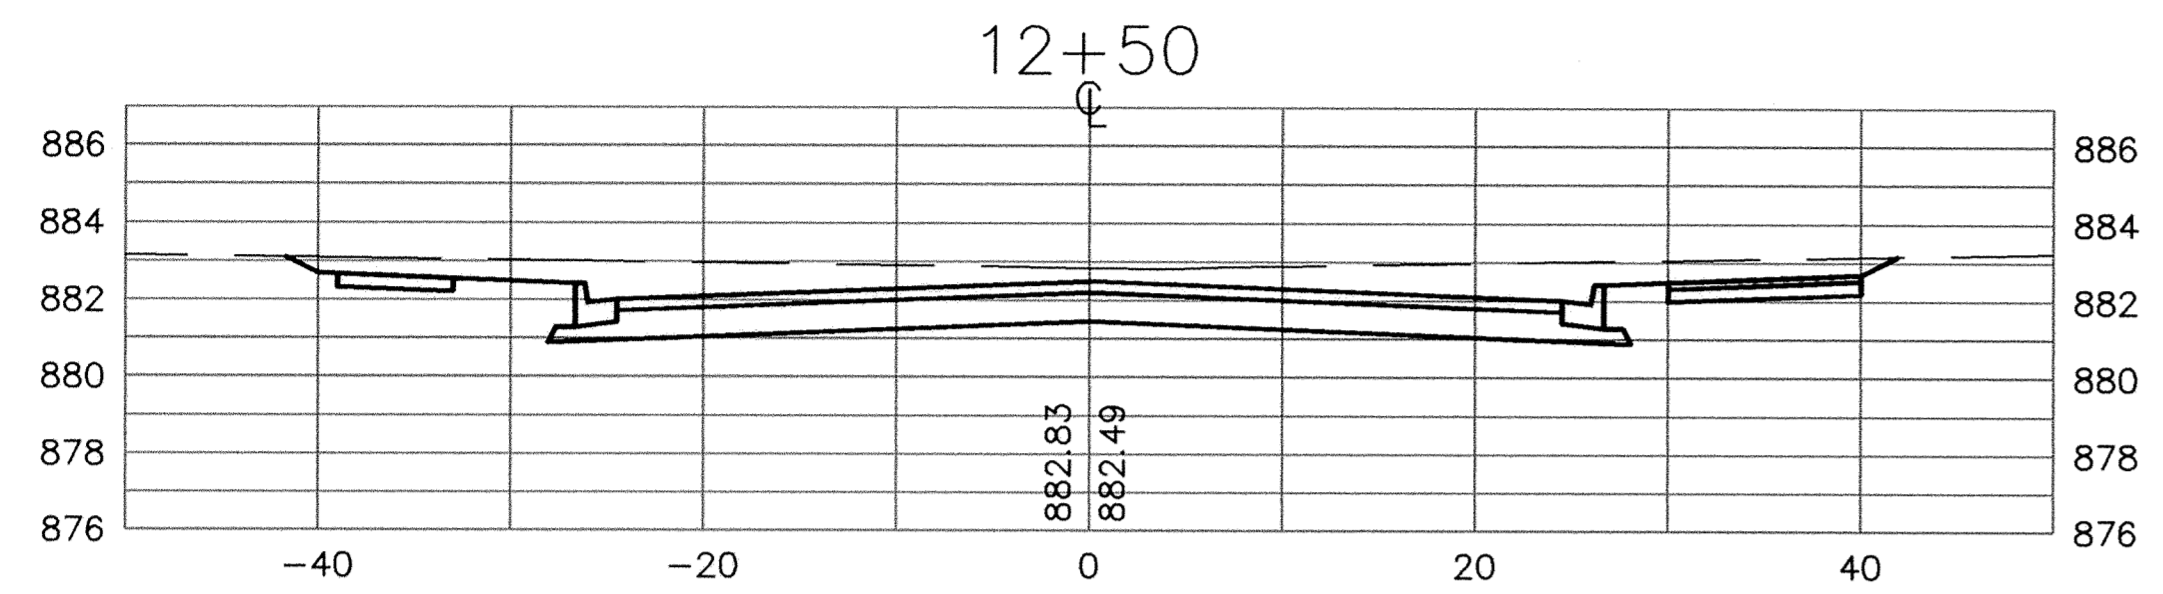

**RECORD PLAN
JANUARY 1996**

I HEREBY CERTIFY THAT THIS PLAN, SPECIFICATION,
 OR REPORT WAS PREPARED BY ME OR UNDER MY DIRECT
 SUPERVISION AND THAT I AM A DULY REGISTERED
 PROFESSIONAL ENGINEER UNDER THE LAWS OF THE
 STATE OF MINNESOTA.
Mark V. Guzman
 DATE 8/15/94 REG. NO. 19130

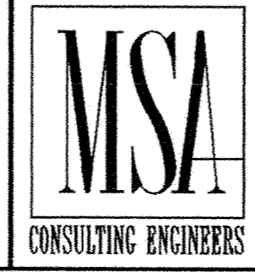

1326 ENERGY PARK DRIVE
 ST. PAUL, MINNESOTA 55108
 (612) 644-4389
 9800 SHELARD PARKWAY
 MINNEAPOLIS, MINNESOTA 55441
 (612) 546-0432

DATE	DESCRIPTION	DESIGNED
		<i>JB</i>
		CHECKED
		DRAWN
		GRAPHIC SCALE
		0 10
		0 VERT. 5

CITY OF ELK RIVER		
JOPLIN STREET CROSS SECTIONS		
DATE	AUG. 1994	SHEET 40 OF 63 SHEETS
		PROJECT NO. 230-223
		10+50 TO 15+00