


**CONTROL PANEL SCHEMATIC**  
NO SCALE

**GENERAL NOTES**

1. SERVICE VOLTAGE IS 120/240V, 1Ø, 3W
2. CONTROL PANEL SHALL BEAR SERIALIZED LABEL INDICATING CONFORMANCE W/ U.L. 508

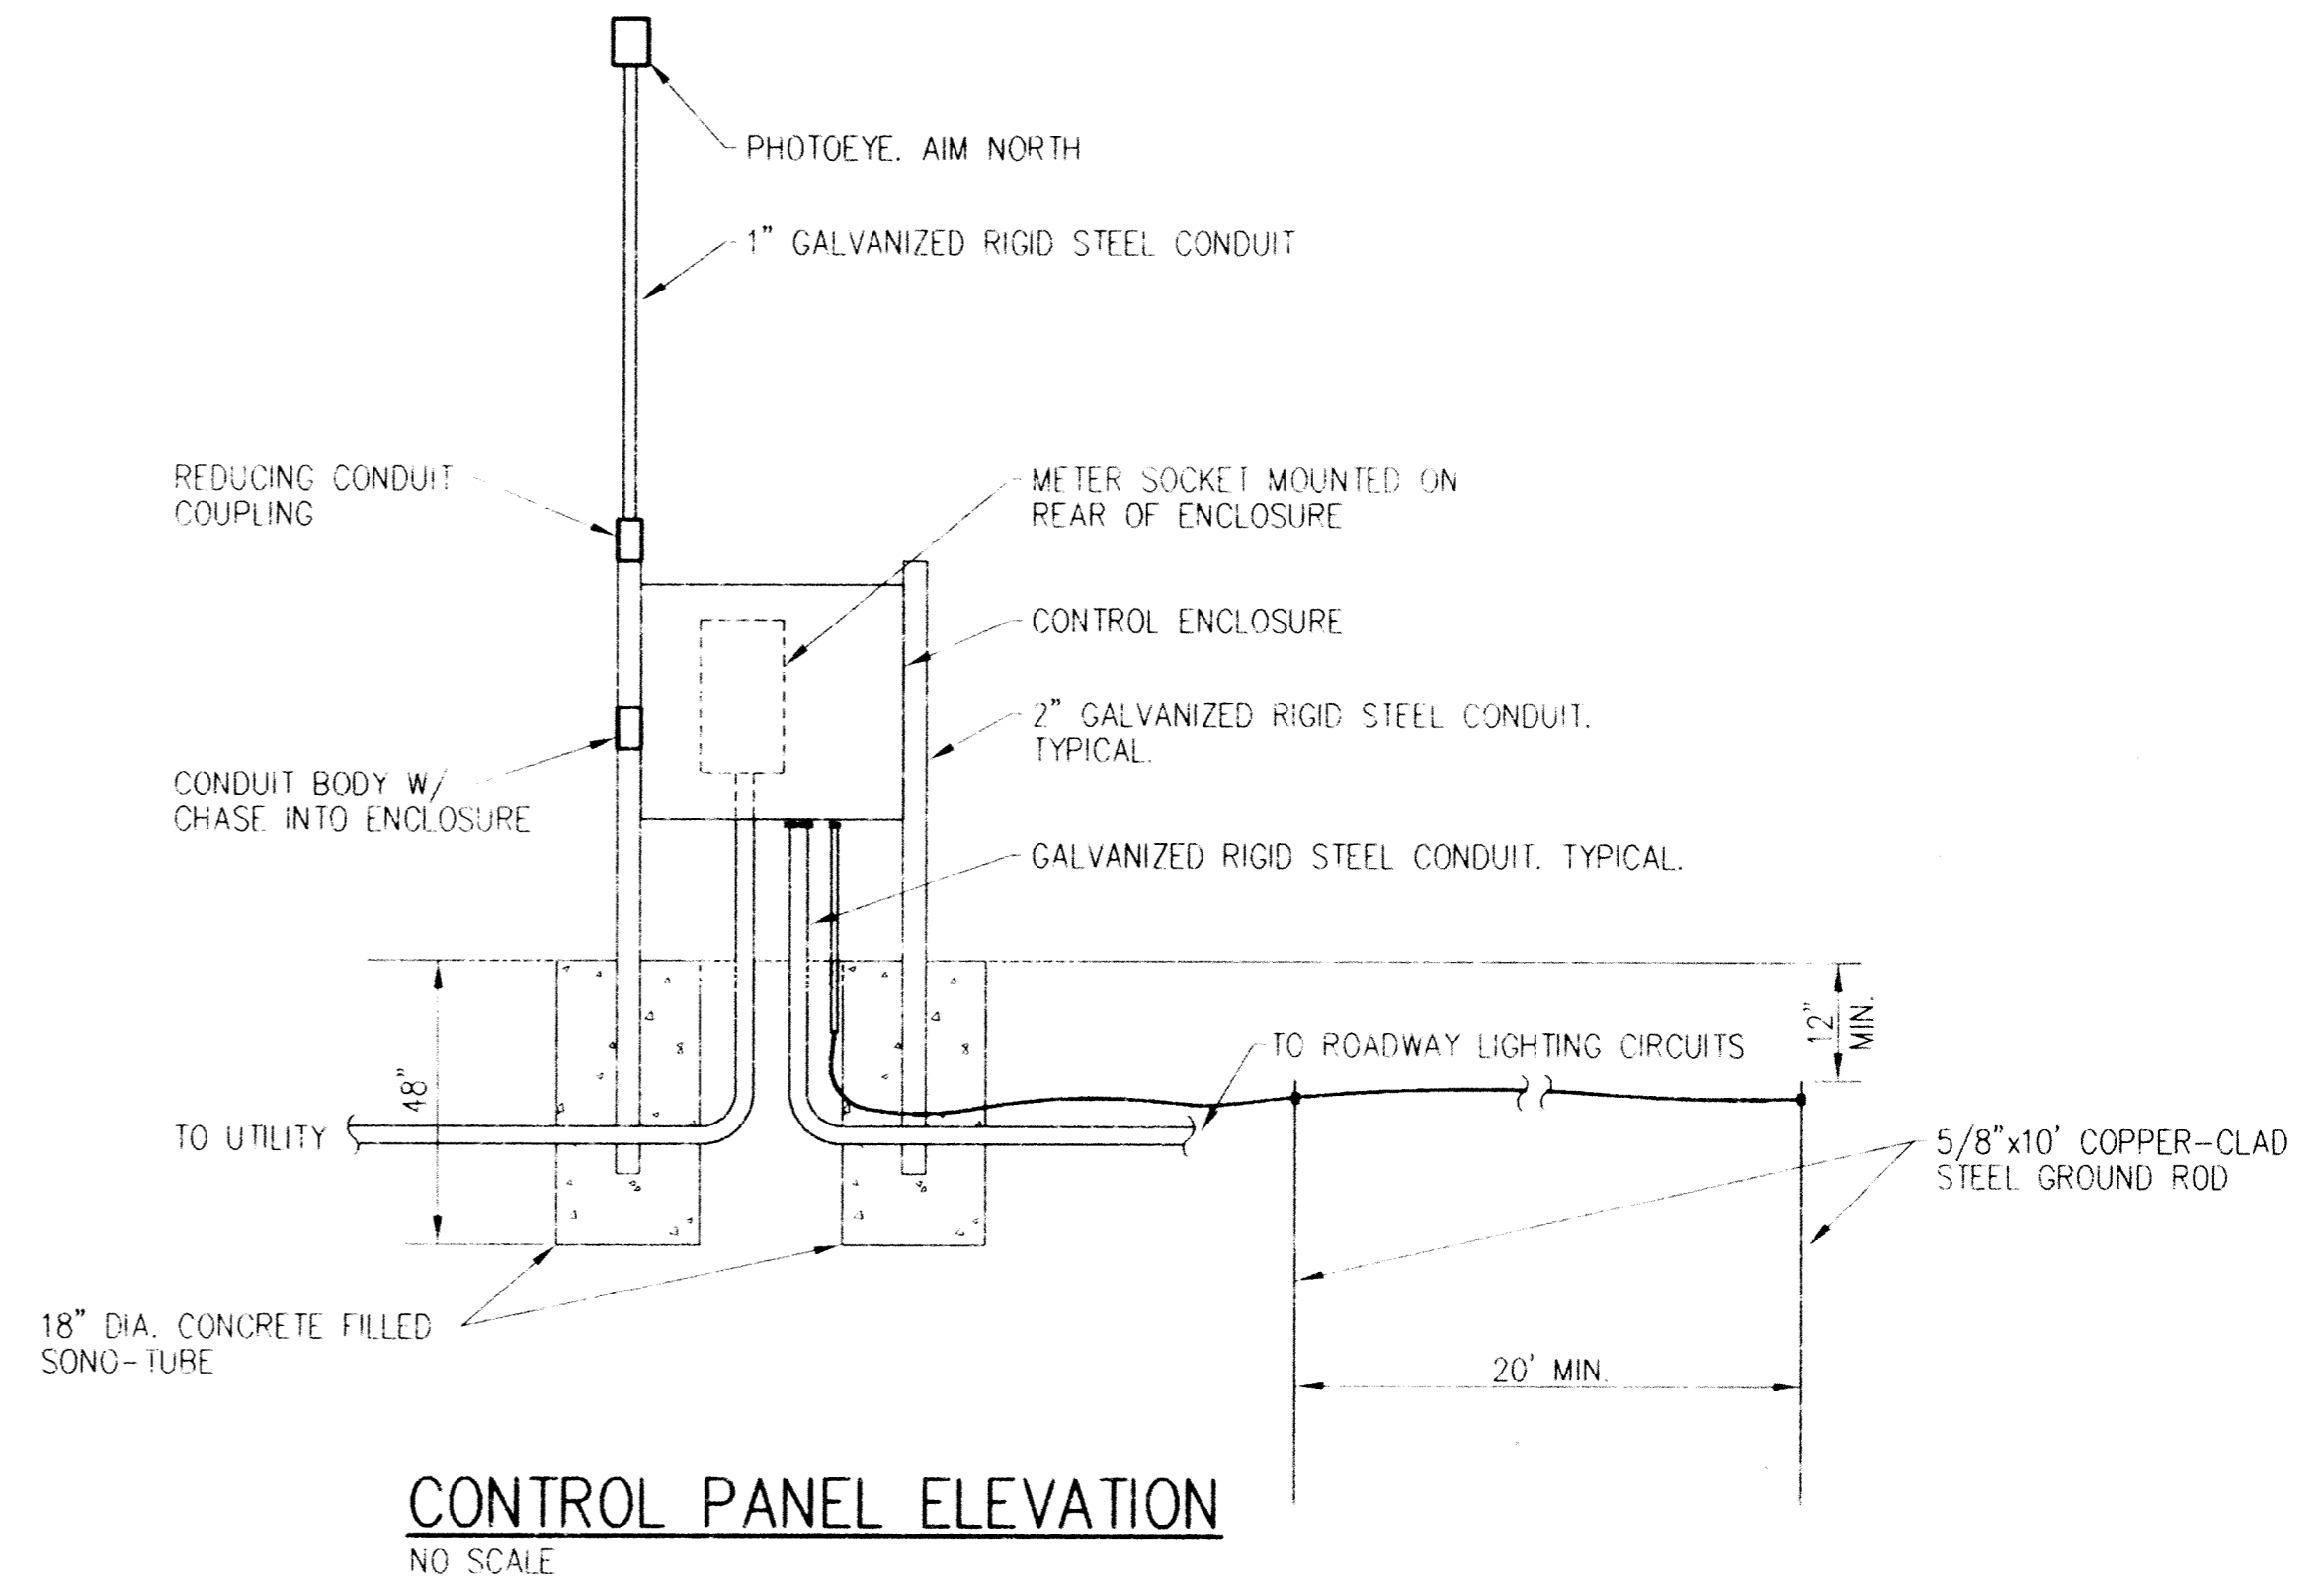

**CONTROL PANEL ELEVATION**  
NO SCALE

**RECORD PLAN**  
**JANUARY 1996**

This drawing was prepared by: <b>Kaeding &amp; Associates, Inc.</b> 7300 France Avenue South Suite 330 Minneapolis, MN 55435 Telephone: (612) 831-0317 Fax: (612) 831-2179	I HEREBY CERTIFY THAT THIS PLAN, SPECIFICATION, OR REPORT WAS PREPARED BY ME OR UNDER MY DIRECT SUPERVISION AND THAT I AM A FULLY REGISTERED PROFESSIONAL ENGINEER UNDER THE LAWS OF THE STATE OF MINNESOTA.  <i>[Signature]</i> DATE 10 AUG 94 REG. NO. 9955	<b>MSA</b> CONSULTING ENGINEERS  1326 ENERGY PARK DRIVE ST. PAUL, MINNESOTA 55108 (612) 644-4389  9800 SHELARD PARKWAY MINNEAPOLIS, MINNESOTA 55441 (612) 546-0432	DATE DESCRIPTION DESIGNED PFK CHECKED PFK DRAWN DTB	CITY OF ELK RIVER CONTROL PANEL SCHEMATIC & ELEVATION ORONO ROAD S.A.P. STA 47+98.41 TO STA 53+00	DATE AUG 1994 SHEET 57 OF 63 SHEETS PROJECT NO. 230-223
			REVISIONS GRAPHIC SCALE 0 HORIZ. 0 VERT.		