



SARGENT & LUNDY • NEW HAVEN, CONNECTICUT
 REPORT BY PART NUMBER 6582
 SARGENT & LUNDY • NEW HAVEN, CONNECTICUT
 REPORT BY PART NUMBER 6582
 SARGENT & LUNDY • NEW HAVEN, CONNECTICUT
 REPORT BY PART NUMBER 6582
 SARGENT & LUNDY • NEW HAVEN, CONNECTICUT
 REPORT BY PART NUMBER 6582

KEY	DESCRIPTION	WIDTH	COLOR	REMARKS	QUANTITY
①	LANE LINE	4"	WHITE	SOLID	300 LF
②	LANE LINE	4"	WHITE	SKIP	50 LF
③	CENTERLINE STRIPE	4"	YELLOW	SOLID DOUBLE	355 LF
⑥	CENTERLINE STRIPE	4"	YELLOW	SKIP	150 LF
⑦	CENTERLINE STRIPE	4"	YELLOW	SOLID	360 LF
↵	LEFT TURN ARROW	10"X 8' LONG	WHITE	SOLID	1 EA
↘	RIGHT TURN ARROW	10"X 8' LONG	WHITE	SOLID	1 EA

ORONO ROAD

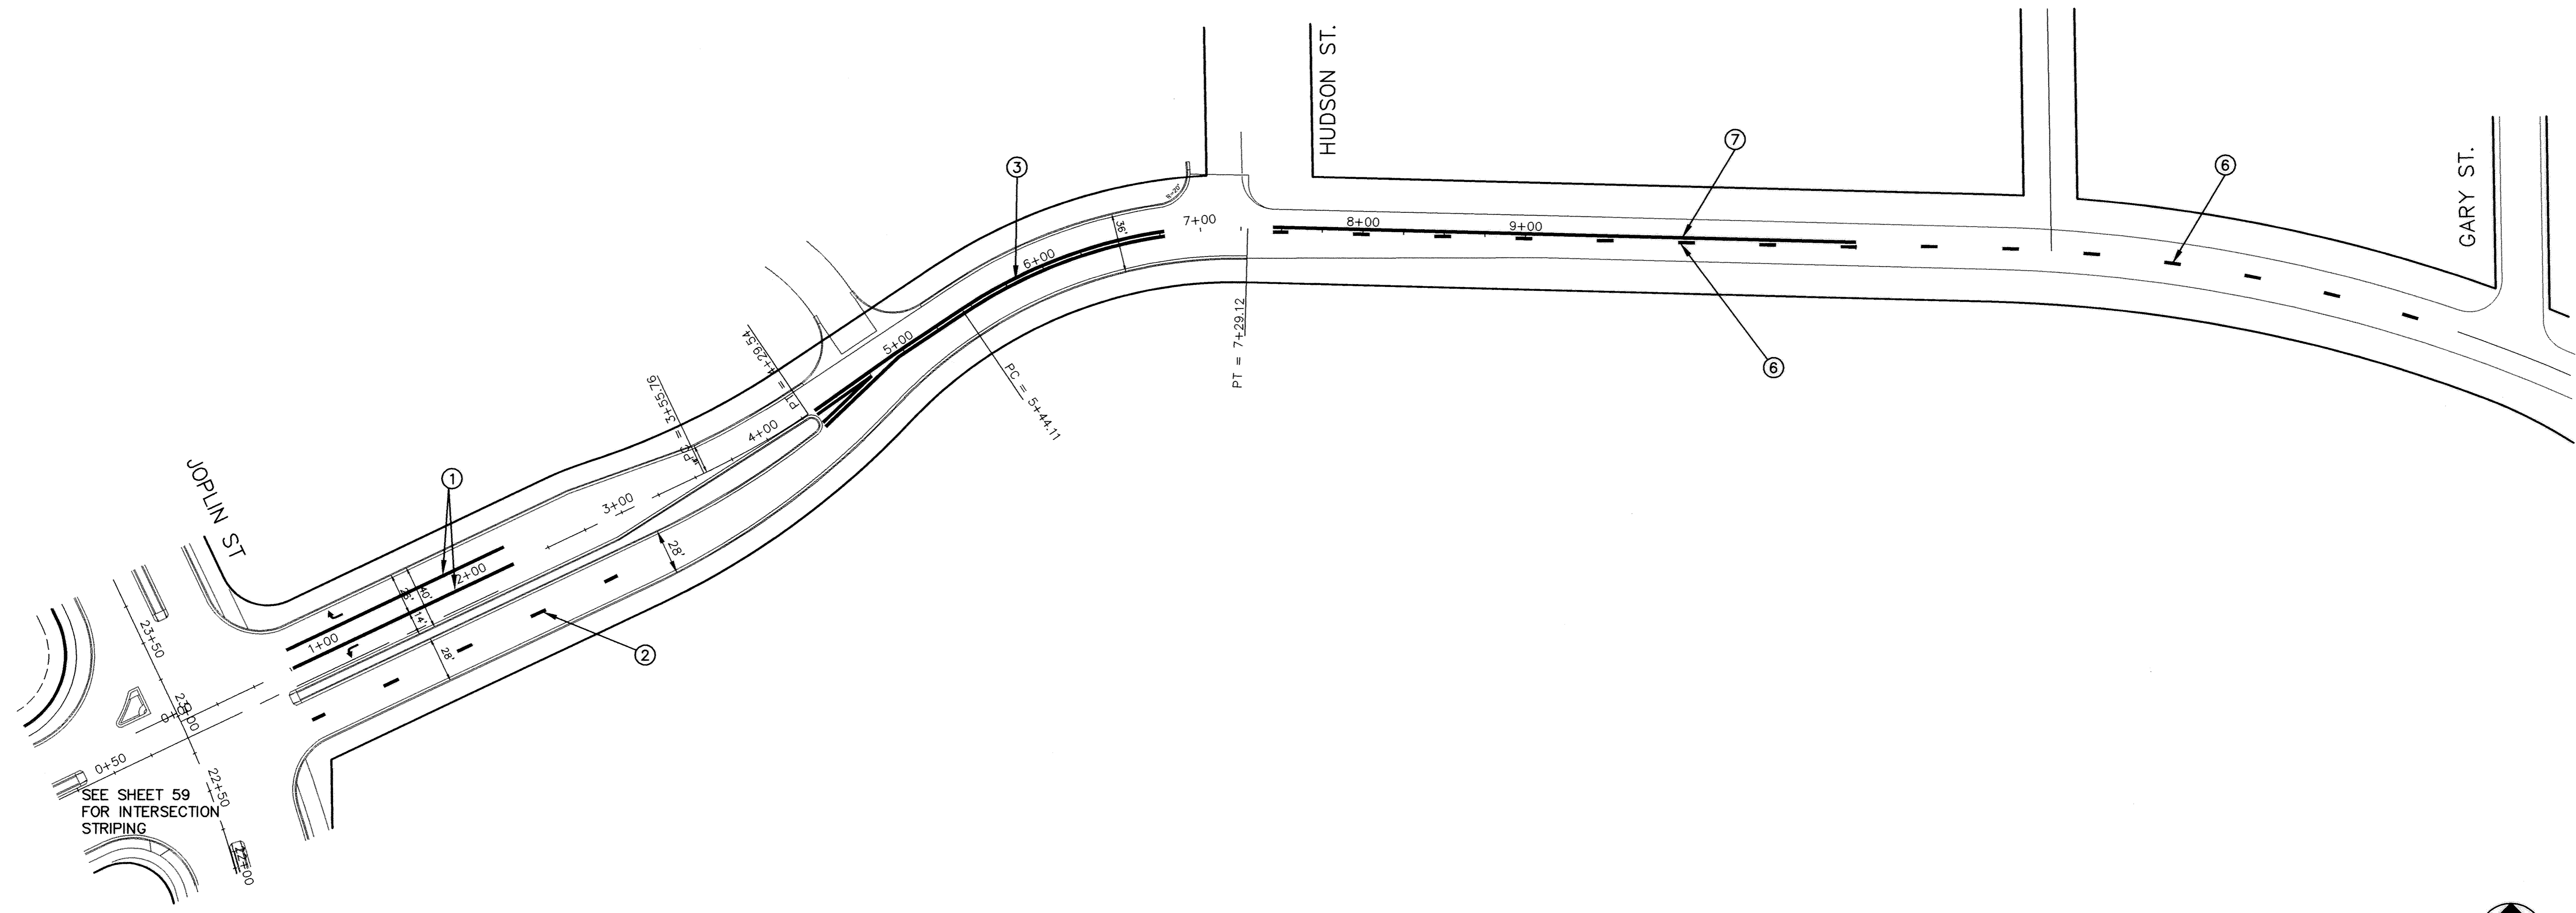

RECORD PLAN
JANUARY 1996

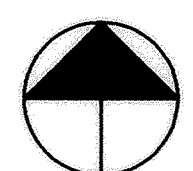

I HEREBY CERTIFY THAT THIS PLAN, SPECIFICATION,
 OR REPORT WAS PREPARED BY ME OR UNDER MY DIRECT
 SUPERVISION AND THAT I AM A DULY REGISTERED
 PROFESSIONAL ENGINEER UNDER THE LAWS OF THE
 STATE OF MINNESOTA.
Mark V. Luukkonen
 DATE 9/21/94 REG. NO. 19130



1326 ENERGY PARK DRIVE
 ST. PAUL, MINNESOTA 55108
 (612) 644-4389
 9800 SHELARD PARKWAY
 MINNEAPOLIS, MINNESOTA 55441
 (612) 546-0432

DATE	DESCRIPTION	DESIGNED	SE

CHECKED _____
 DRAWN _____
 GRAPHIC SCALE
 0 50
 0 VERT. 5

CITY OF ELK RIVER
SIGNING & STRIPPING
ORONO ROAD

DATE <u>OCT 1995</u>	SHEET 59B OF 63 SHEETS	PROJECT NO. <u>230-259</u>
----------------------	--------------------------------------	----------------------------