



KEY	DESCRIPTION	WIDTH	COLOR	REMARKS	QUANTITY
③	CENTERLINE STRIPE	4"	YELLOW	SOLID DOUBLE	2736 LF


183RD AVENUE

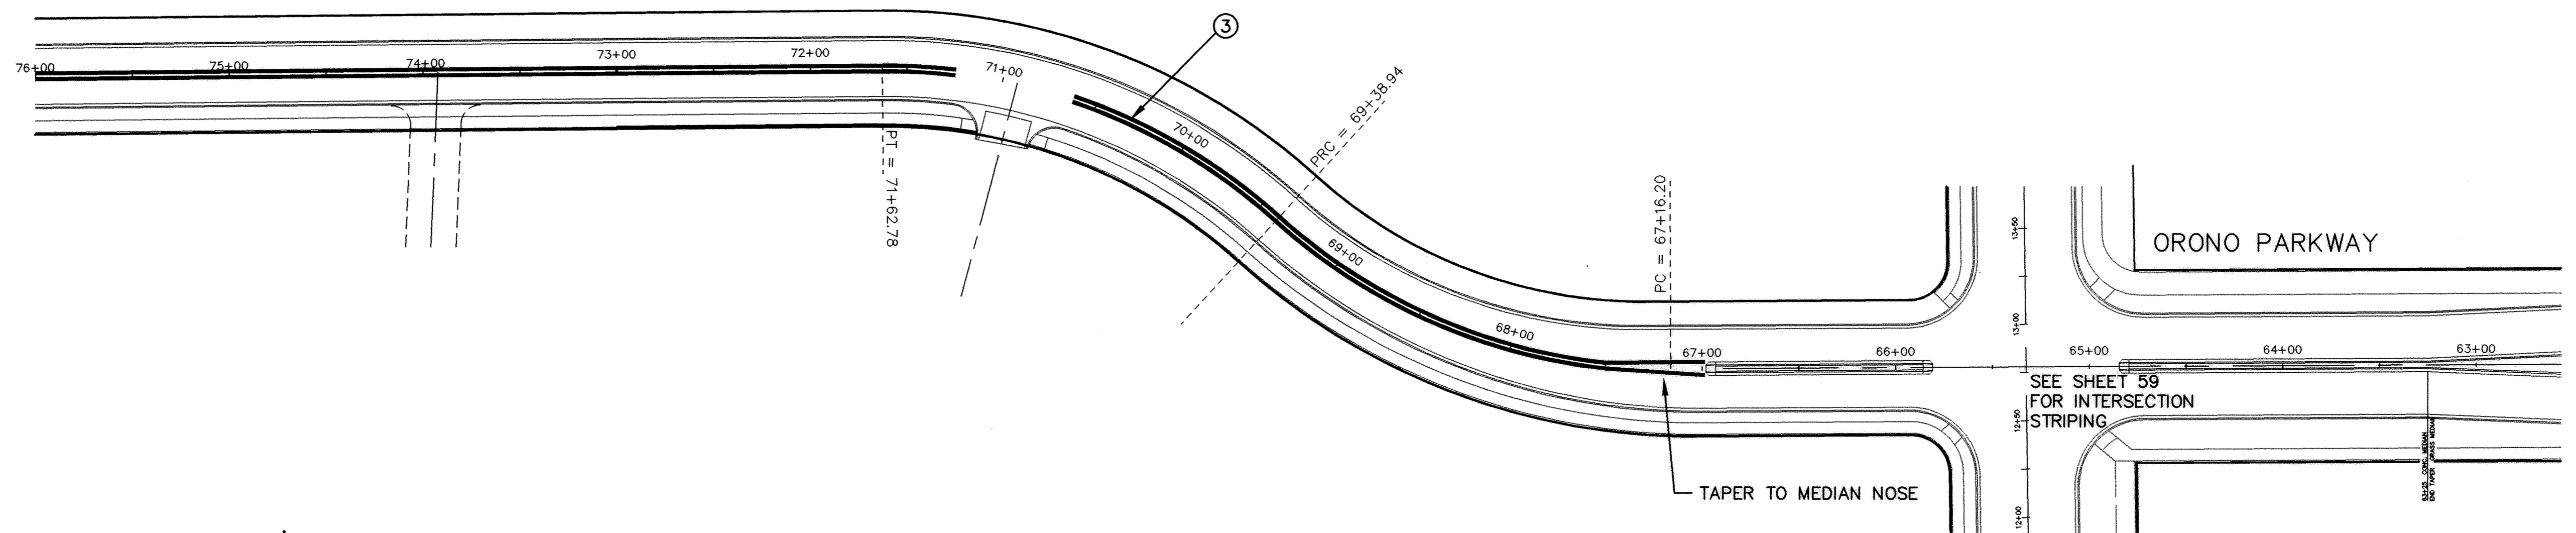

183RD AVENUE

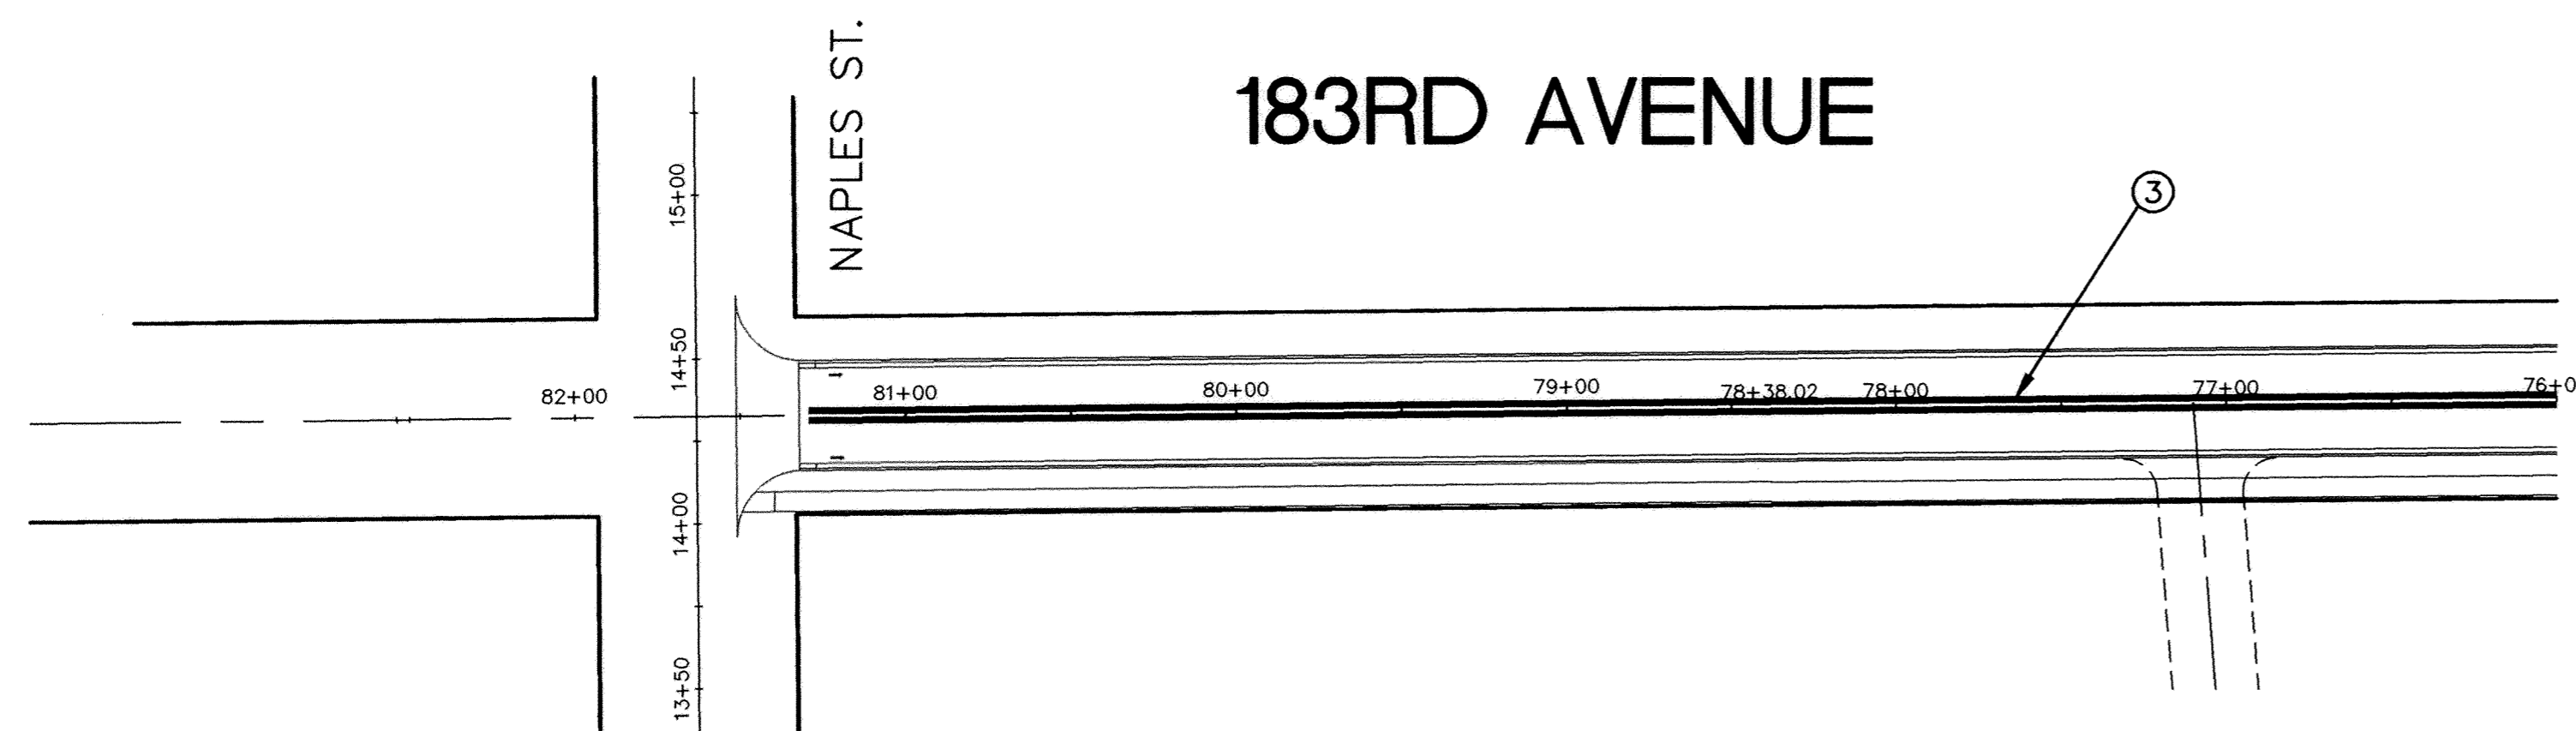

RECORD PLAN
JANUARY 1996

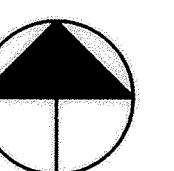

CITY OF ELK RIVER
SIGNING & STRIPPING
183RD AVE.

I HEREBY CERTIFY THAT THIS PLAN, SPECIFICATION, OR REPORT WAS PREPARED BY ME OR UNDER MY DIRECT SUPERVISION AND THAT I AM A DULY REGISTERED PROFESSIONAL ENGINEER UNDER THE LAWS OF THE STATE OF MINNESOTA.
Mark V. Luskano
DATE 9/21/94 REG. NO. 19130



1326 ENERGY PARK DRIVE
ST. PAUL, MINNESOTA 55108
(612) 644-4389

9800 SHELDON PARKWAY
MINNEAPOLIS, MINNESOTA 55441
(612) 546-0432

DATE	DESCRIPTION	DESIGNED
		CHECKED
		DRAWN
		GRAPHIC SCALE
		0 50
		0 VERT. 5

DATE	SHEET	OF	SHEETS	PROJECT NO.
OCT 1995	59C	63	SHEETS	230-223