
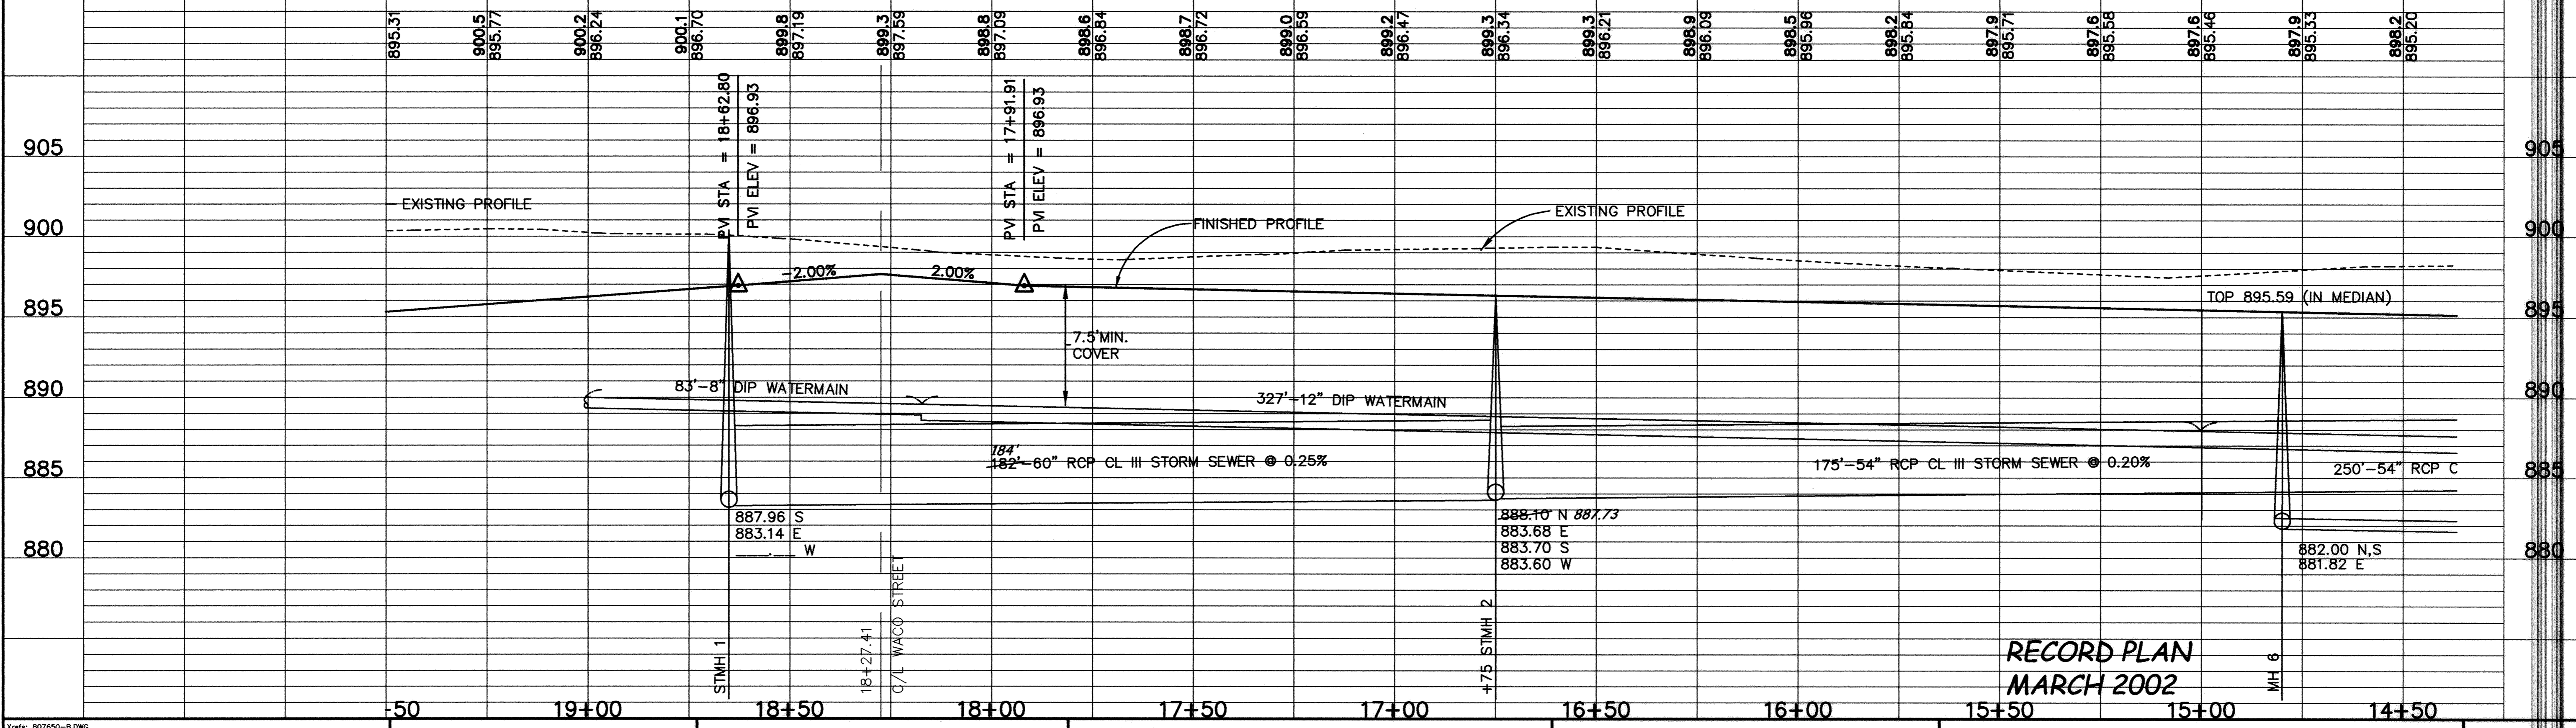
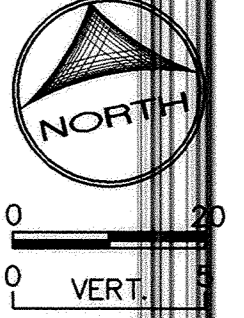


BUSINESS CENTER DRIVE

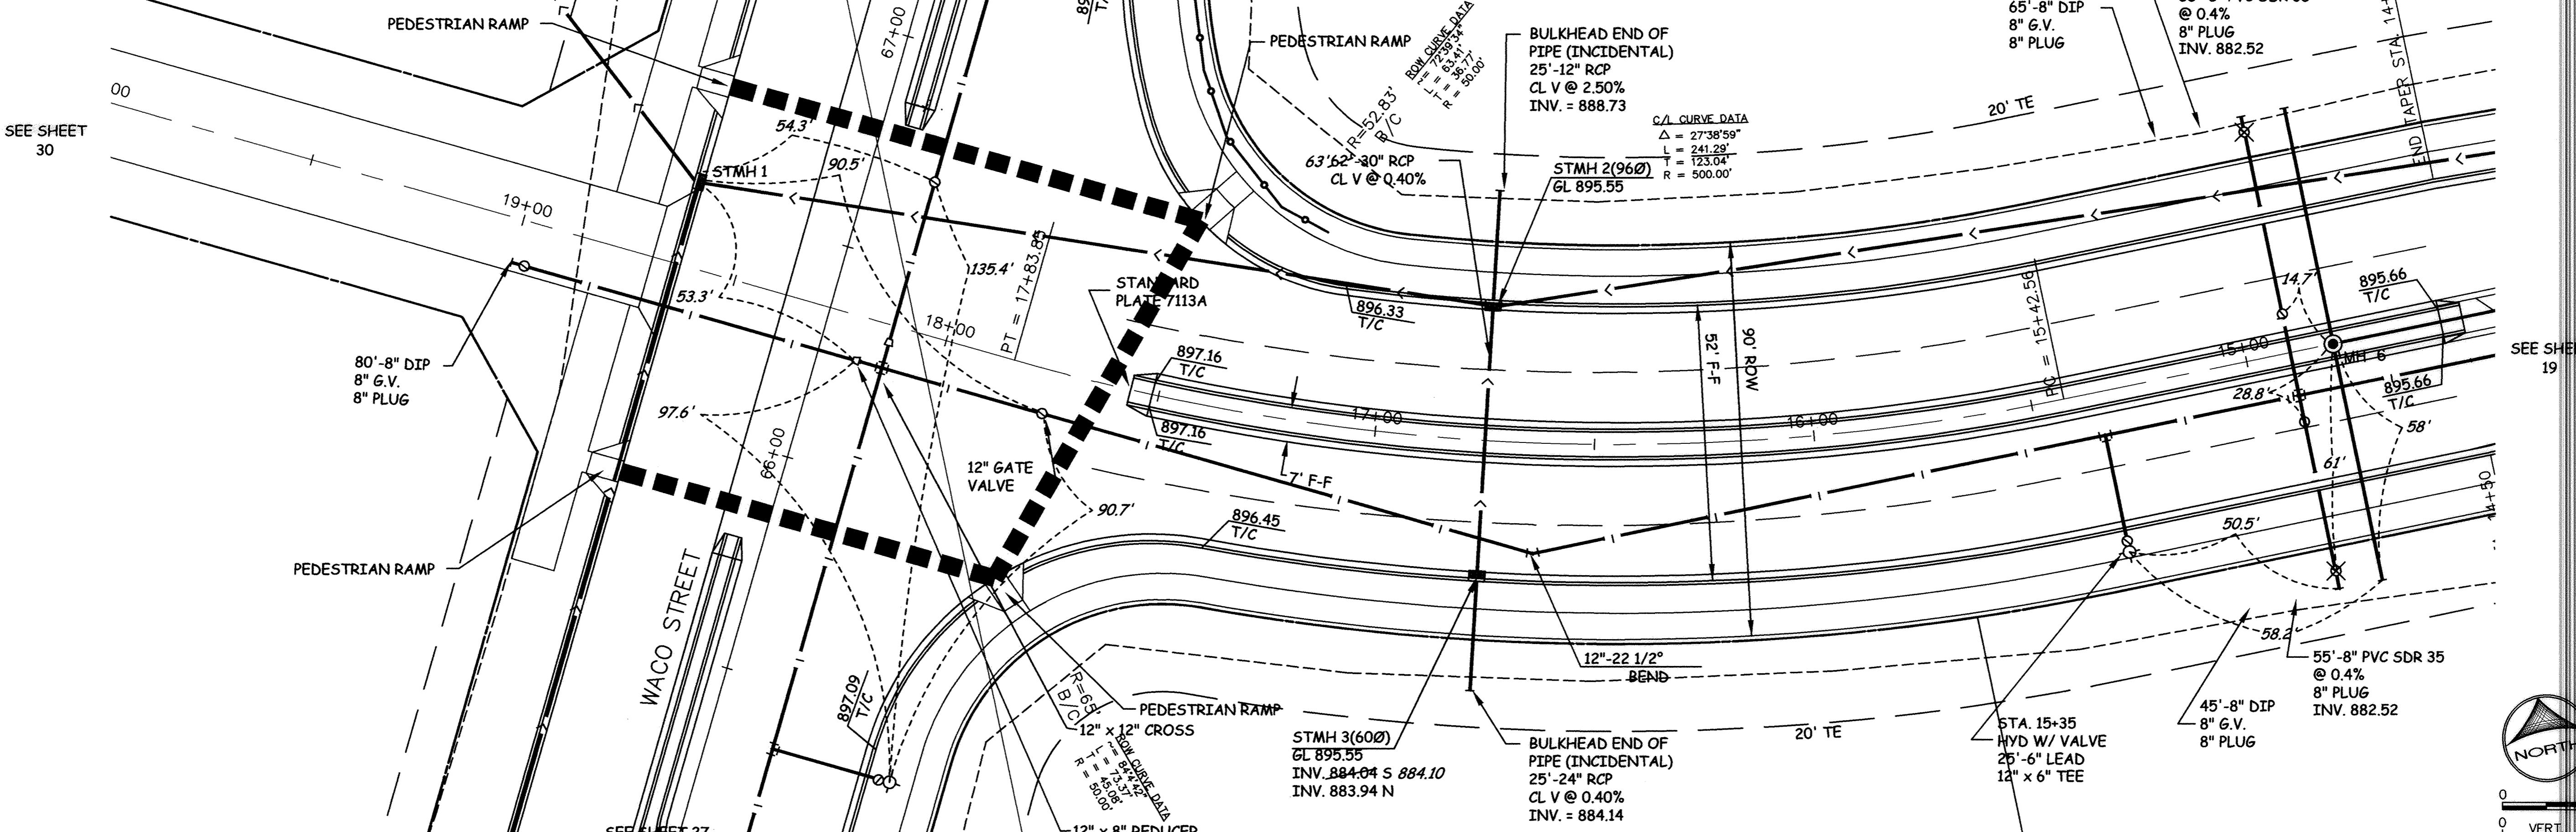

**RECORD PLAN
MARCH 2002**

DESIGNED BY: JMA DRAWN BY: RKM
 APPROVED BY: TJM JOB NUMBER 807650
 CAD DATE: April 23, 2002 11:04:58 a.m.
 CAD FILE: 807650\807650-4.DWG (ASBUILT)

I HEREBY CERTIFY THAT THIS PLAN, SPECIFICATION,
 OR REPORT WAS PREPARED BY ME OR UNDER MY DIRECT
 SUPERVISION AND THAT I AM A DULY REGISTERED
 PROFESSIONAL ENGINEER UNDER THE LAWS OF THE
 STATE OF MINNESOTA.
 DATE: _____ REG. NO.: 15316

| NO. | DATE | BY | REVISION DESCRIPTION |
|-----|------|----|----------------------|
| | | | |
| | | | |
| | | | |



Howard R. Green Company
 CONSULTING ENGINEERS

1326 ENERGY PARK DRIVE
 ST. PAUL, MINNESOTA 55108
 (651) 644-4389

CITY OF ELK RIVER
 WESTERN AREA PHASE IV
 STREET AND UTILITY IMPROVEMENTS

**PLAN AND PROFILE
 BUSINESS CENTER DRIVE**
 S.A.P. 204-131-02, 204-126-03, S.P. 7102-99 15+00 TO 18+62.63

SHEET NO.
20