

DRAWING NUMBER

DRAWING NUMBER

DRAWING NUMBER

DRAWING NUMBER

7 PRODUCTS • NEW HOPE, MINNESOTA
REVISION BY PART NUMBER 8592

SACD PRODUCTS • NEW HOPE, MINNESOTA
REVISION BY PART NUMBER 8592

SACD PRODUCTS • NEW HOPE, MINNESOTA
REVISION BY PART NUMBER 8592



SACD PRODUCTS • NEW HOPE, MINNESOTA
REVISION BY PART NUMBER 8592

PROTECTIVE ROAD OR DRIVE ON THIS LINE

PROTECTIVE ROAD OR DRIVE ON THIS LINE

PROTECTIVE ROAD OR DRIVE ON THIS LINE

PROTECTIVE ROAD OR DRIVE ON THIS LINE

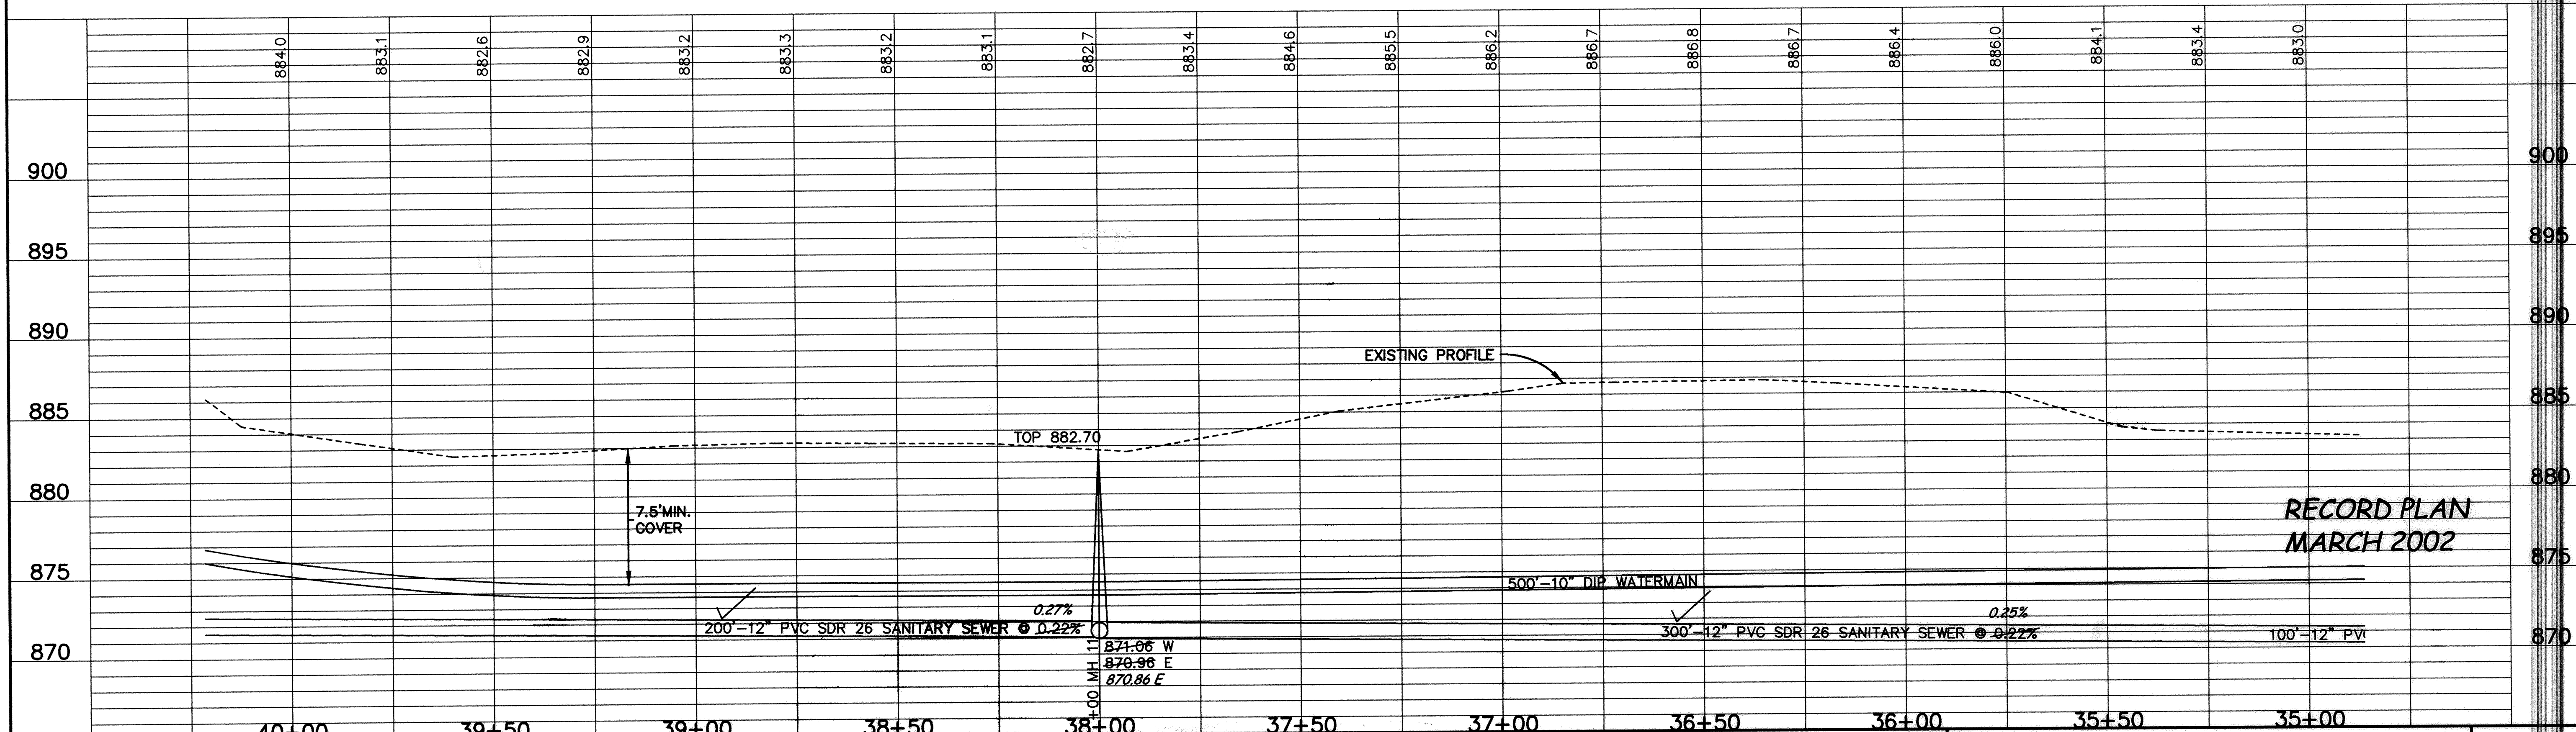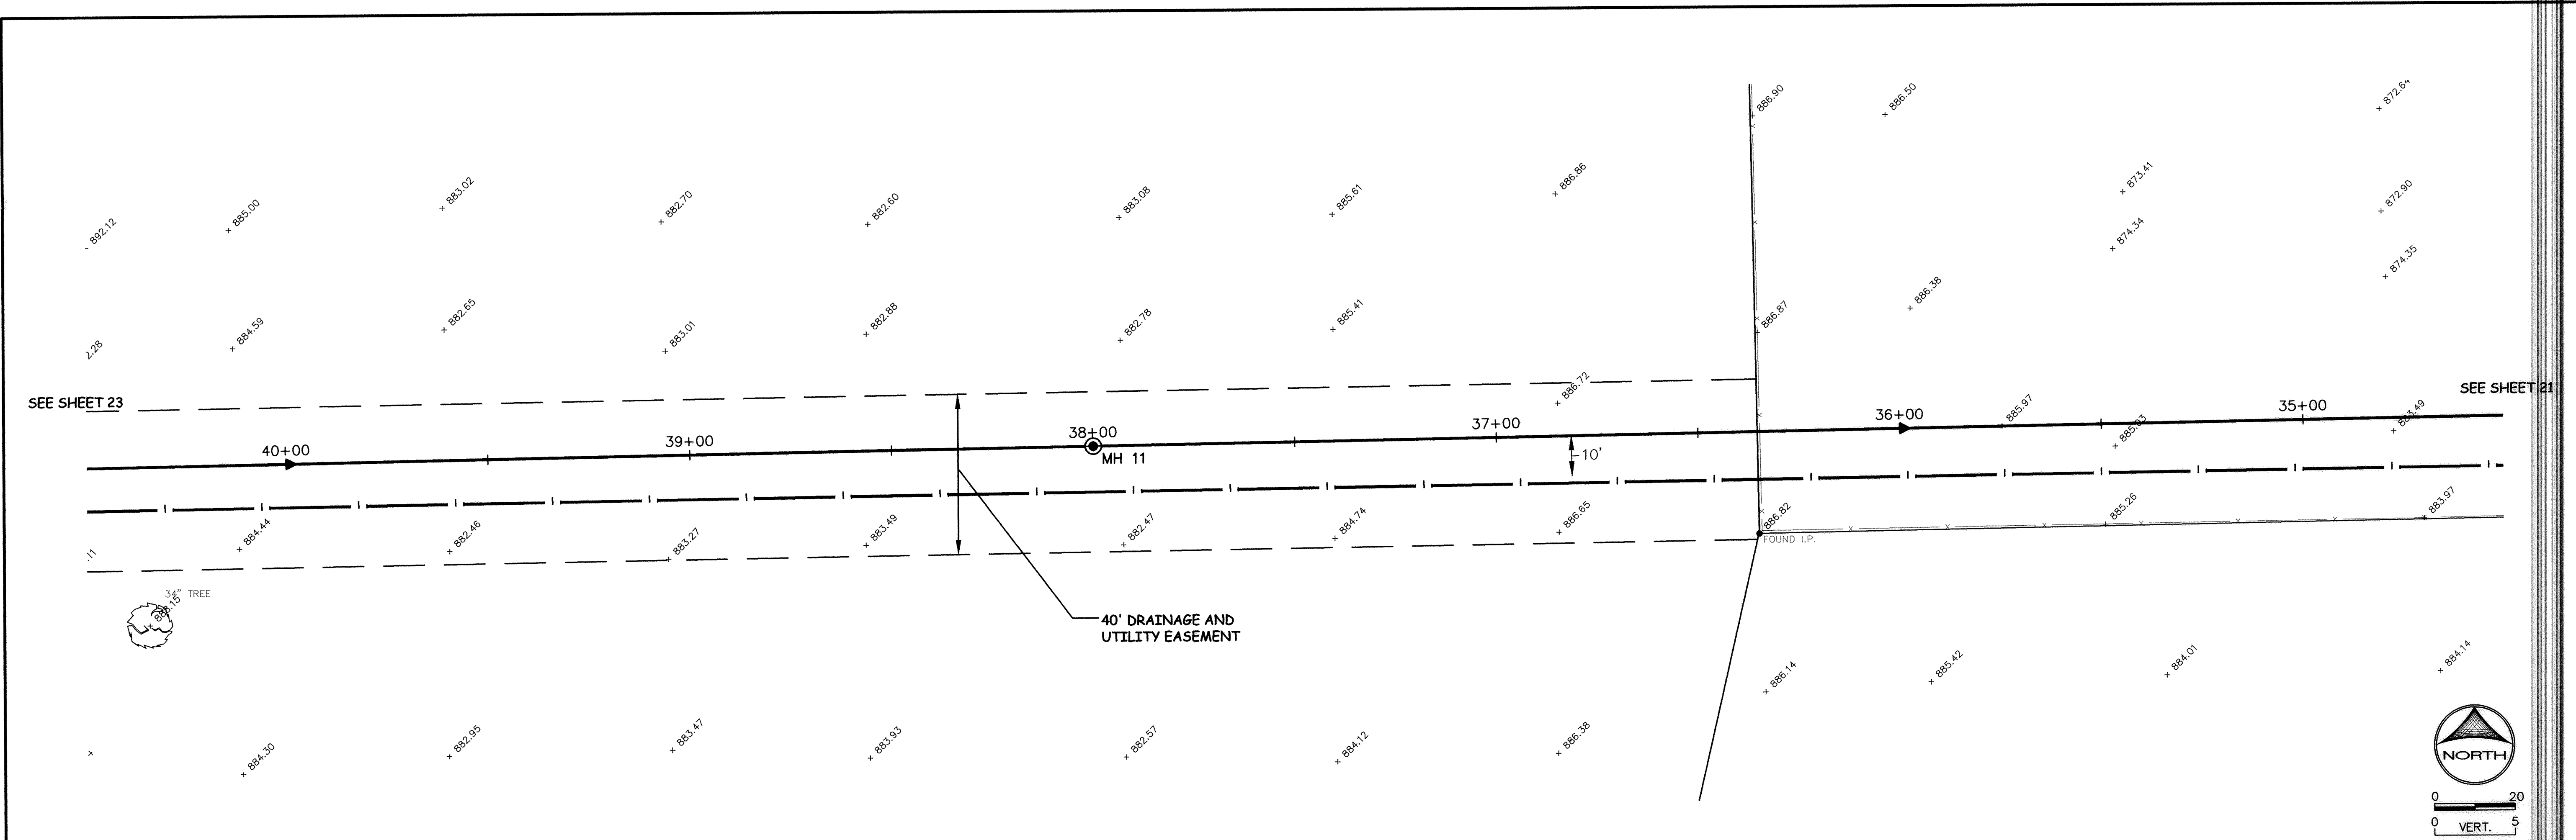

DESIGNED BY: JMA DRAWN BY: RKM
APPROVED BY: TJM JOB NUMBER: 807650
CAD DATE: April 23, 2002 11:30:47 a.m.
CAD FILE: 807650\807650-SOUTH2.DWG (ASBUILT)

I HEREBY CERTIFY THAT THIS PLAN, SPECIFICATION, OR REPORT WAS PREPARED BY ME OR UNDER MY DUTY SUPERVISION AND THAT I AM A DULY REGISTERED PROFESSIONAL ENGINEER UNDER THE LAWS OF THE STATE OF MINNESOTA.

DATE: _____ REG. NO. 15316

NO.	DATE	BY	REVISION DESCRIPTION

Howard R. Green Company
CONSULTING ENGINEERS

1326 ENERGY PARK DRIVE
ST. PAUL, MINNESOTA 55108
(651) 644-4389

CITY OF ELK RIVER
WESTERN AREA PHASE IV
STREET AND UTILITY IMPROVEMENTS

PLAN AND PROFILE
SOUTH UTILITY CONSTRUCTION
S.A.P. 204-131-02, 204-126-03, S.P. 7102-99 35+00 TO 40+00

SHEET NO.
22