

PROJECTS • NEW HOPE, MINNESOTA
REVISION BY PART NUMBER 0532

SACD PROJECTS • NEW HOPE, MINNESOTA
REVISION BY PART NUMBER 0532




SACD PROJECTS • NEW HOPE, MINNESOTA
REVISION BY PART NUMBER 0532

SACD PROJECTS • NEW HOPE, MINNESOTA
REVISION BY PART NUMBER 0532

POSITION LINE OF PART ON THIS LINE

SEE SHEET 25


SEE SHEET 23

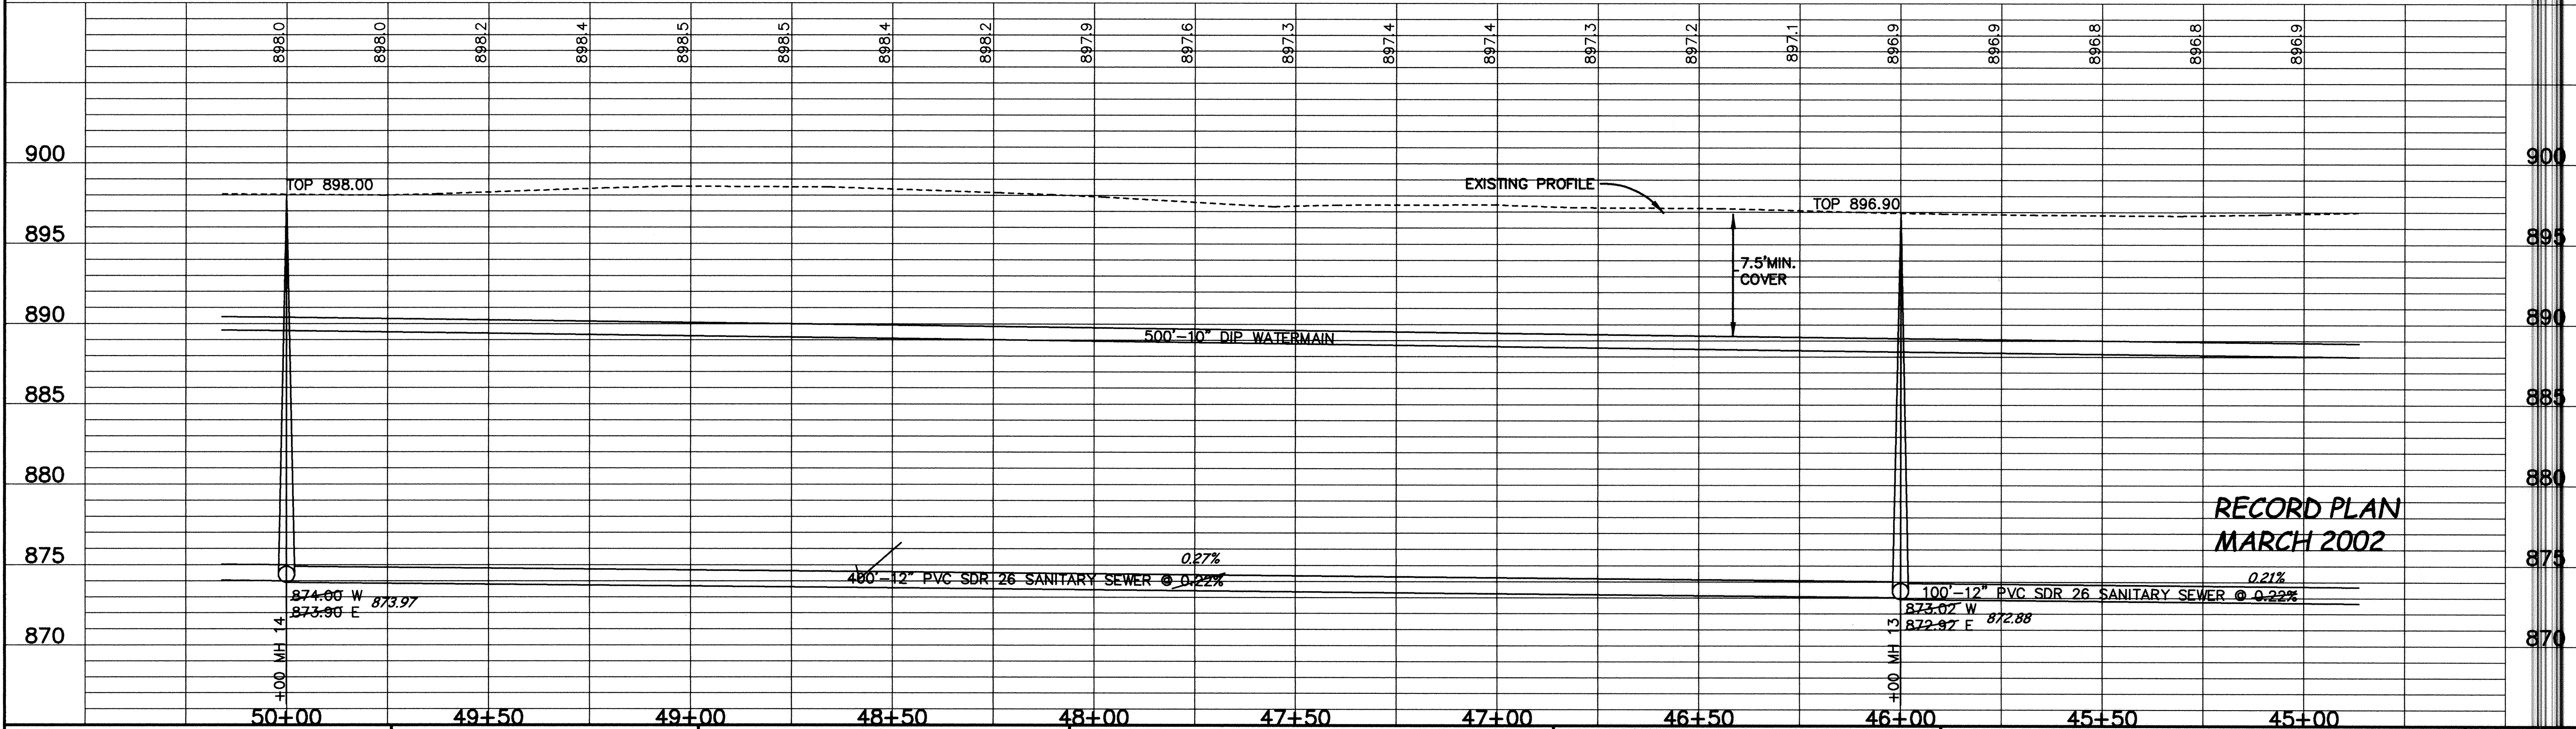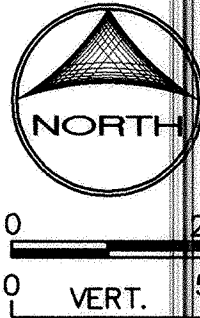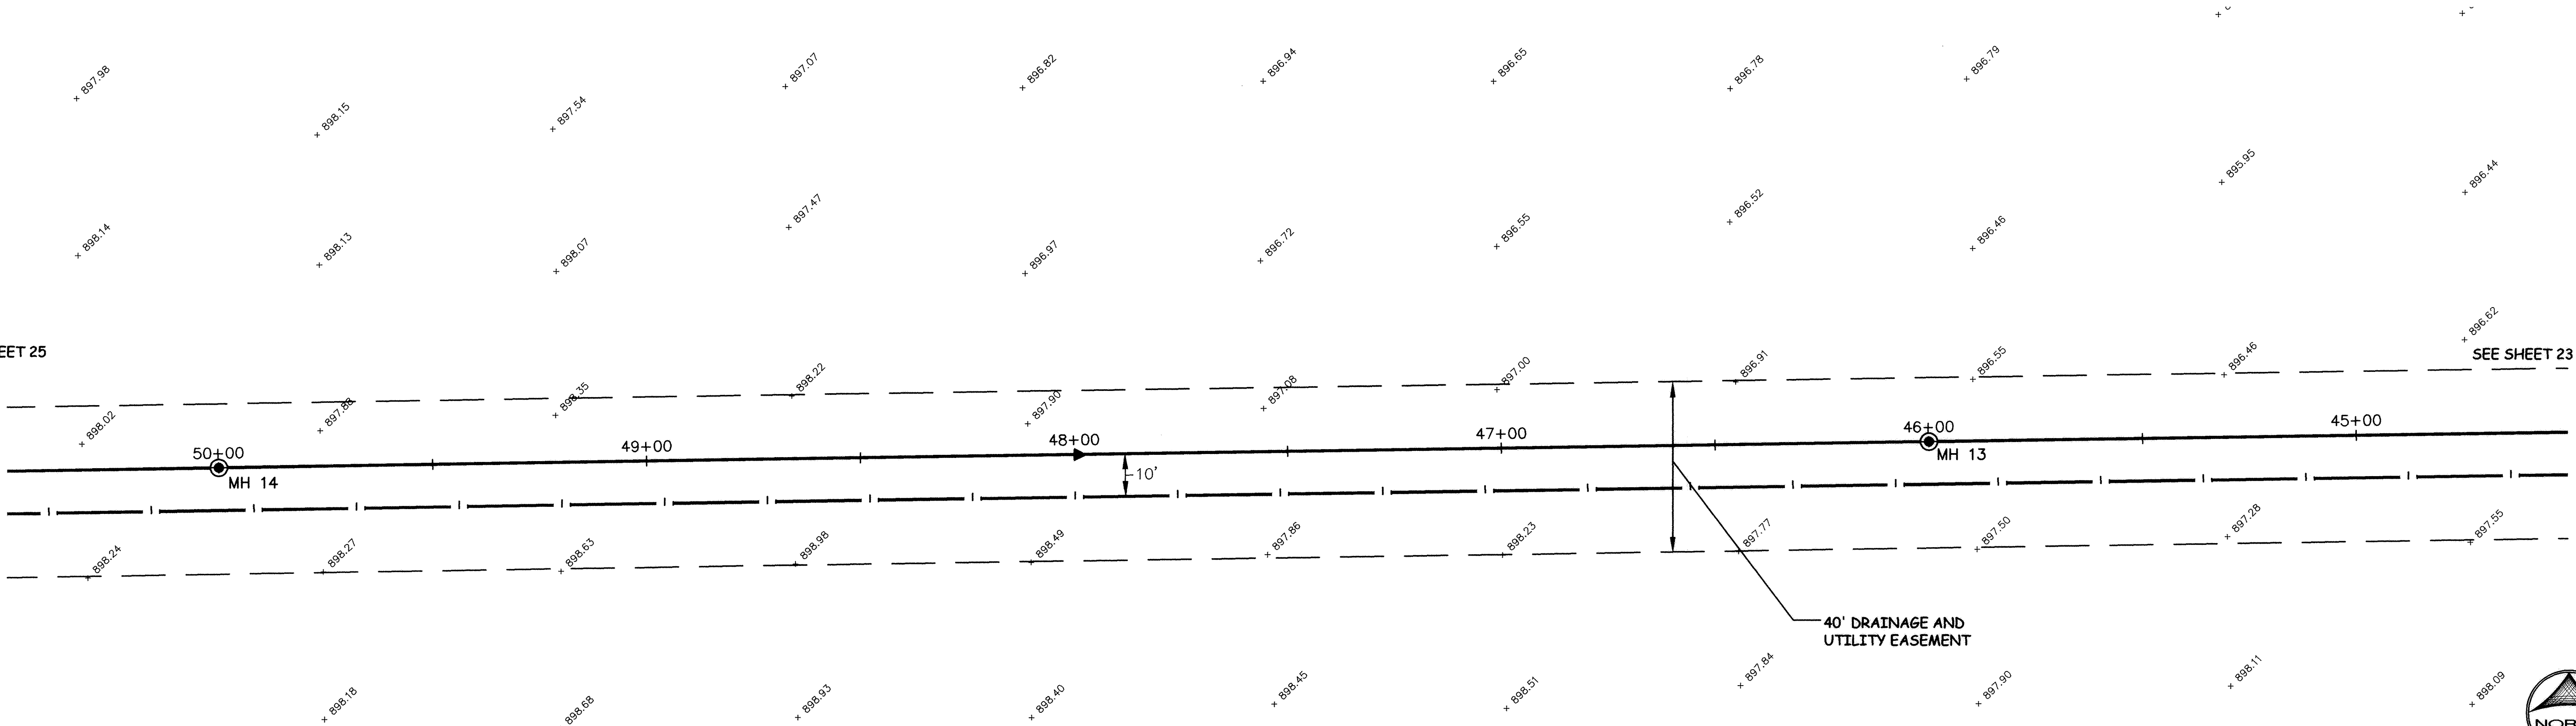

DESIGNED BY: JMA DRAWN BY: RKM
APPROVED BY: TJM JOB NUMBER 807650
CAD DATE: April 23, 2002 11:59:08 a.m.
CAD FILE: 807650\807650-SOUTH4.DWG (ASBUILT)

I HEREBY CERTIFY THAT THIS PLAN, SPECIFICATION,
OR REPORT WAS PREPARED BY ME OR UNDER MY DIRECT
SUPERVISION AND THAT I AM A DULY REGISTERED
PROFESSIONAL ENGINEER UNDER THE LAWS OF THE
STATE OF MINNESOTA.
DATE _____ REG. NO. 15316

NO.	DATE	BY	REVISION DESCRIPTION

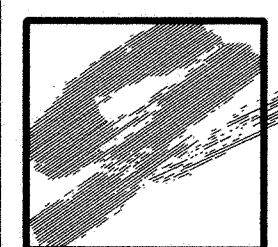

Howard R. Green Company
CONSULTING ENGINEERS

1326 ENERGY PARK DRIVE
ST. PAUL, MINNESOTA 55108
(651) 644-4389

CITY OF ELK RIVER
WESTERN AREA PHASE IV
STREET AND UTILITY IMPROVEMENTS

PLAN AND PROFILE
SOUTH UTILITY CONSTRUCTION
S.A.P. 204-131-02, 204-126-03, S.P. 7102-99 45+00 TO 50+00

SHEET NO.
24