
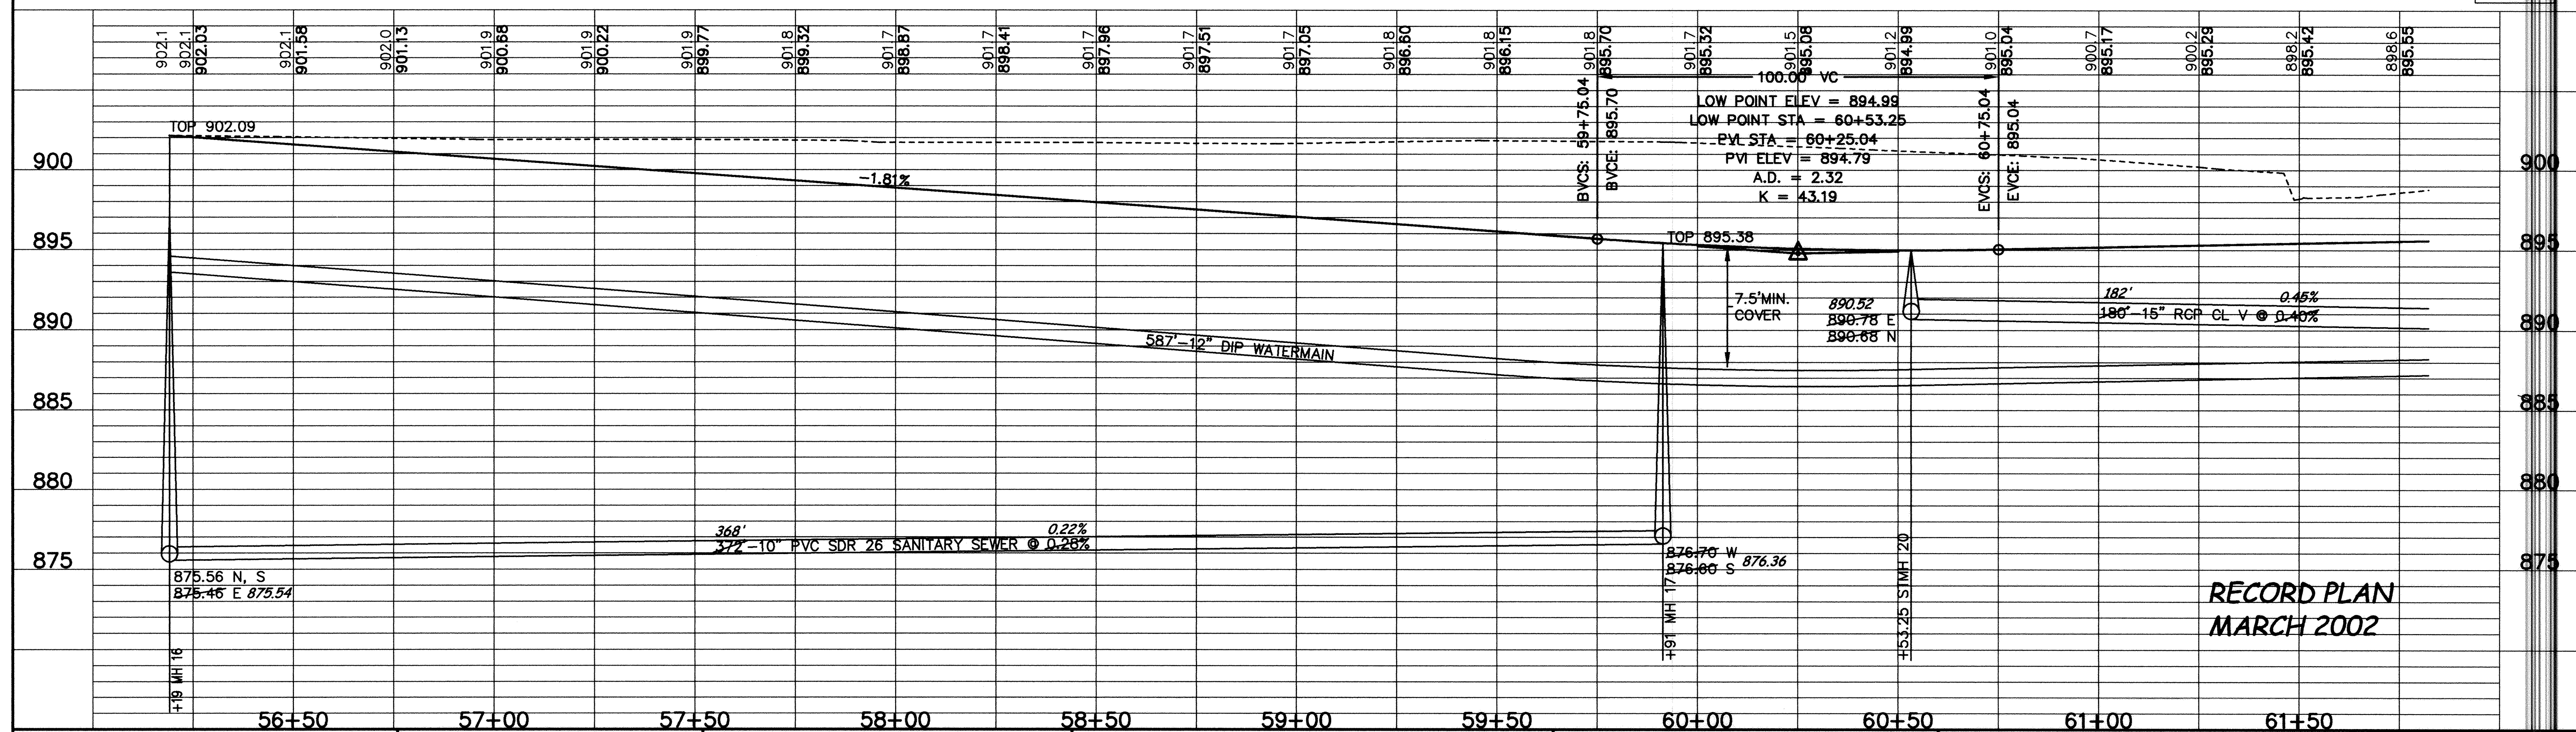


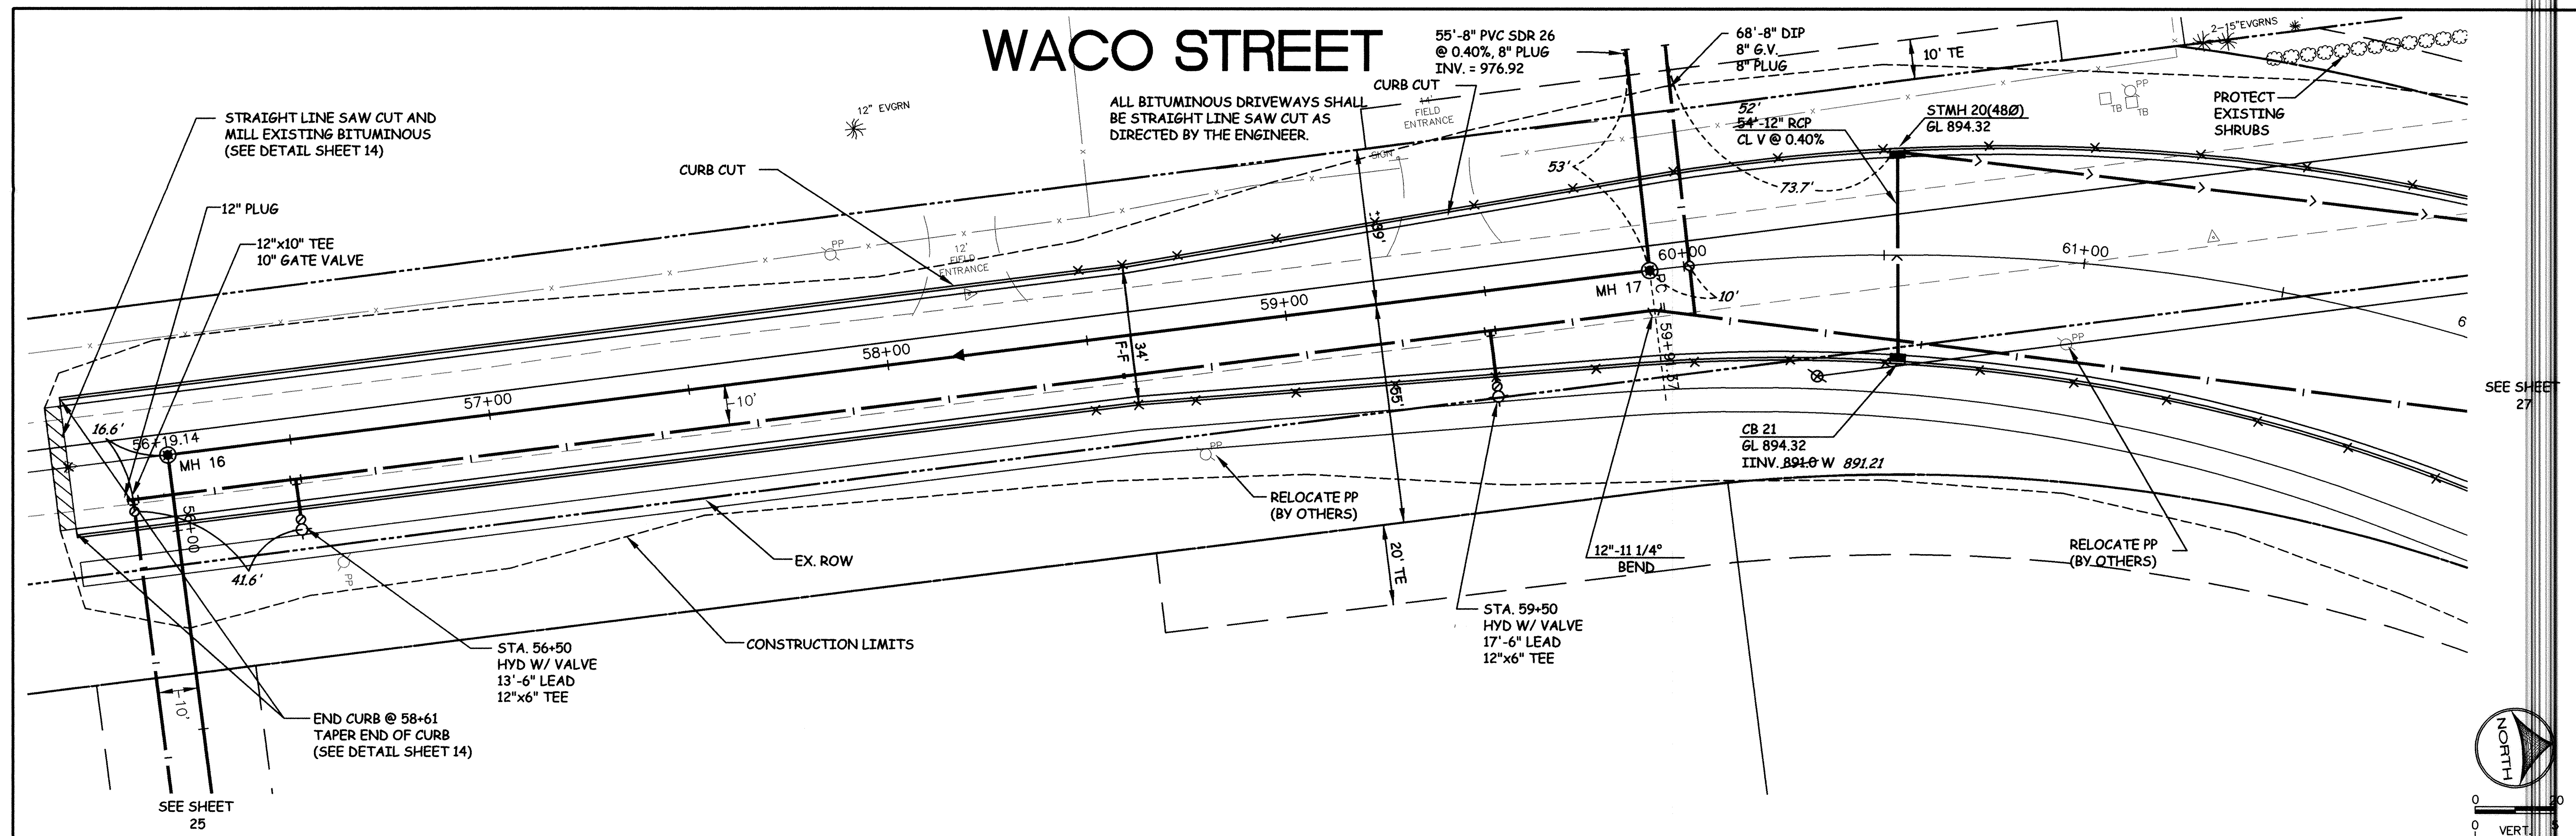

Xref: 807650-B.DWG

DESIGNED BY: JMA	DRAWN BY: RKM
APPROVED BY: TJM	JOB NUMBER 807650
CAD DATE: April 23, 2002 12:45:28 p.m.	
CAD FILE: 807650\807650-5.DWG (ASBUILT)	