
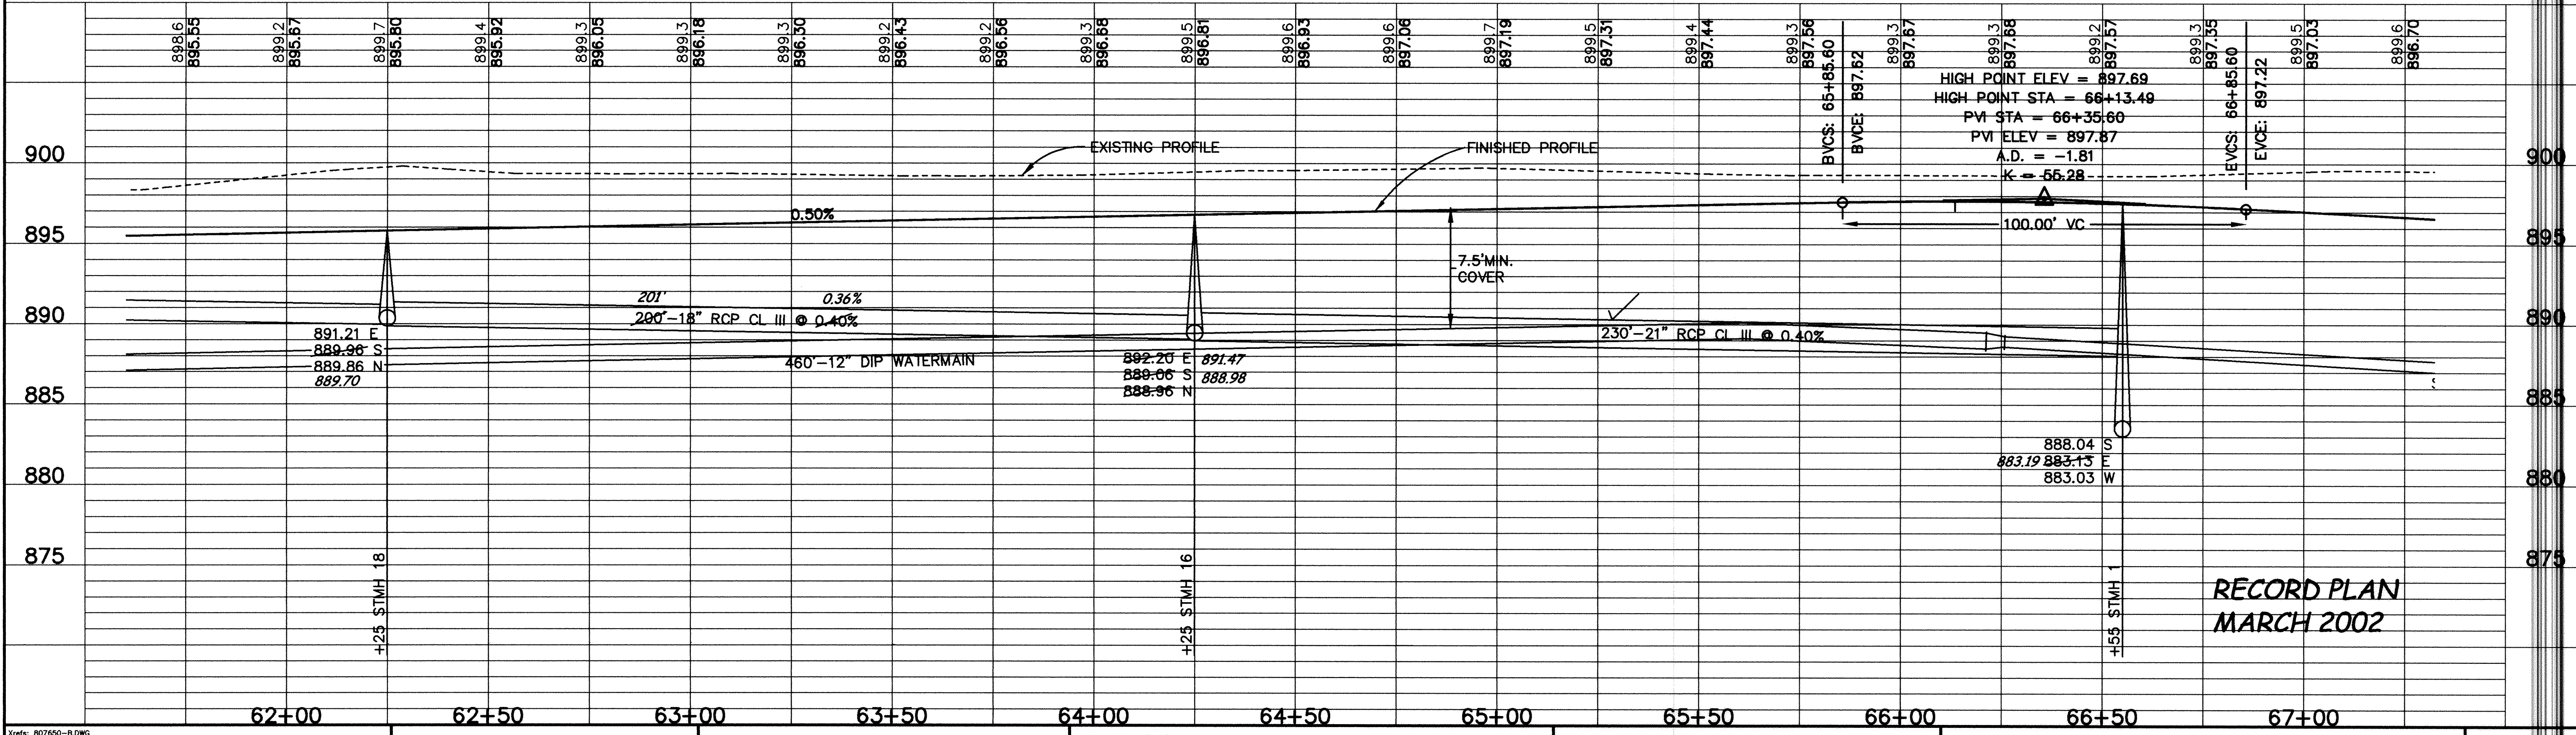


WACO STREET

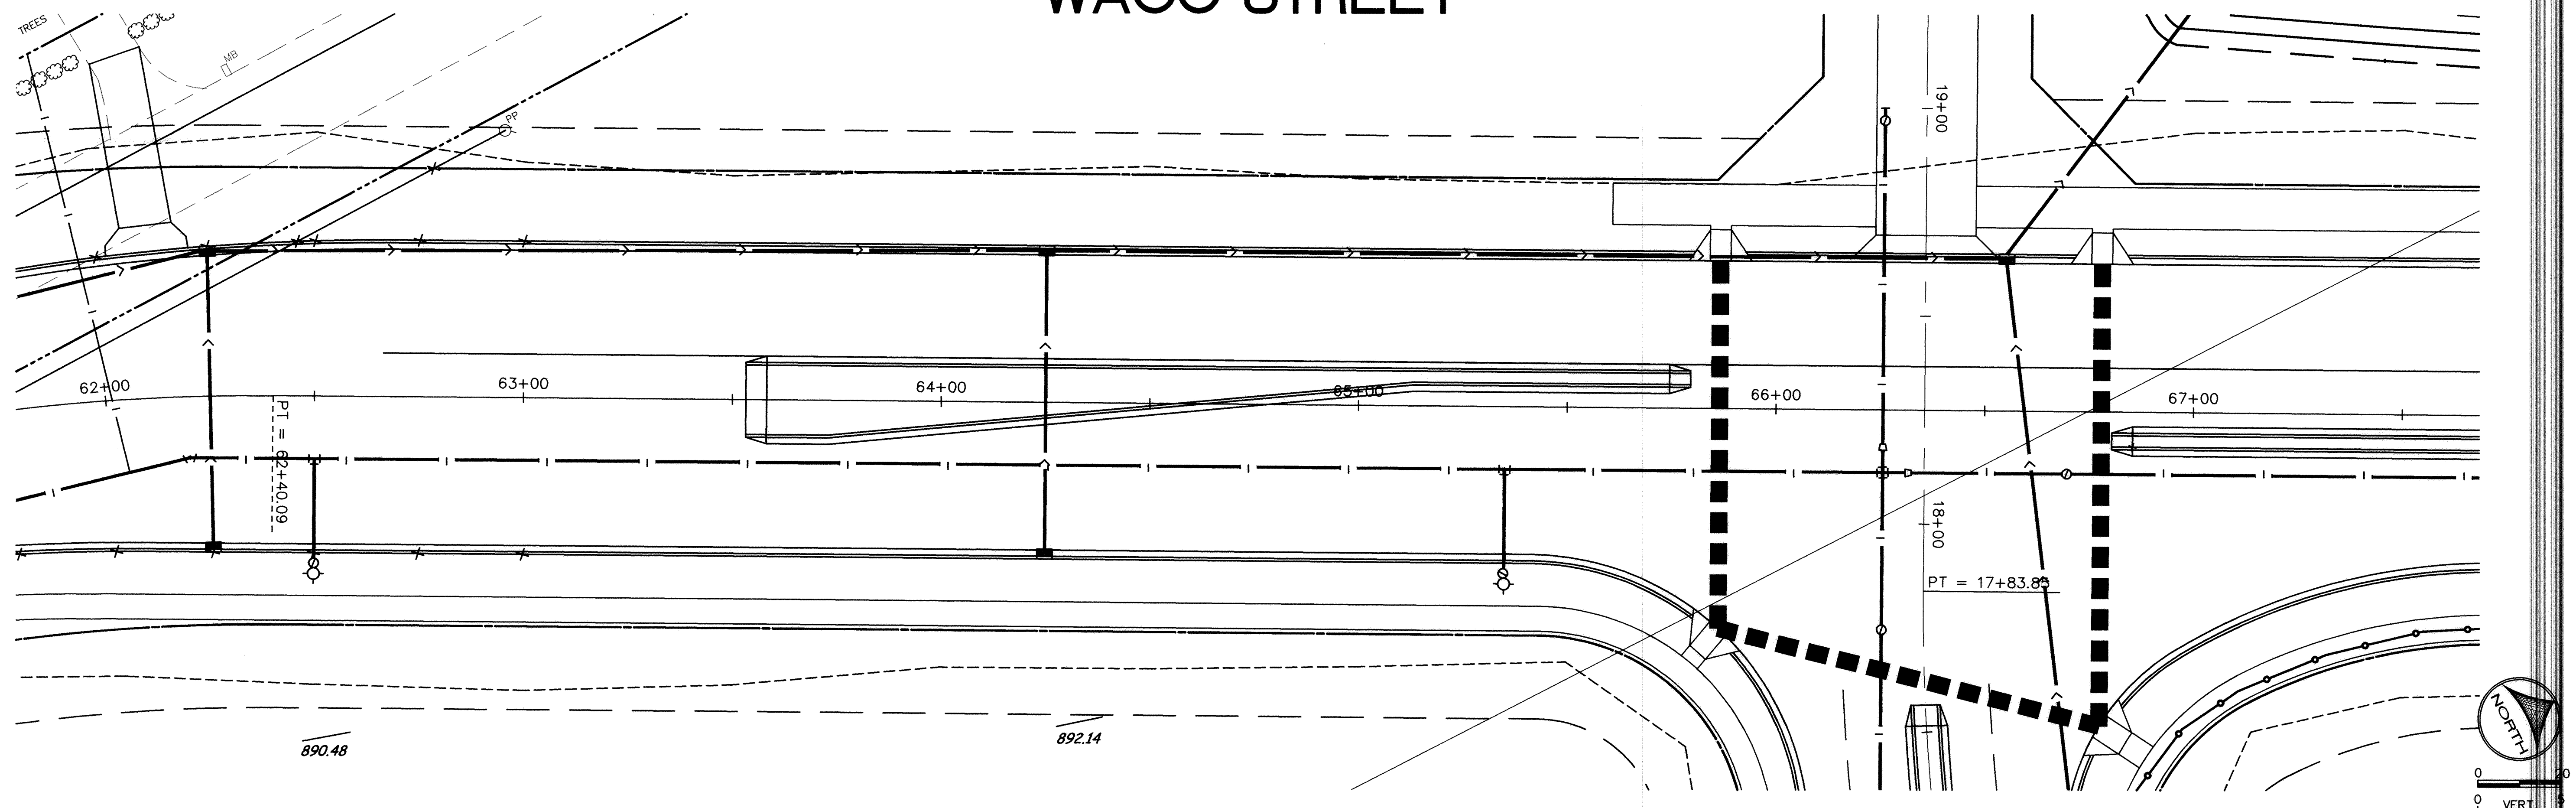

DESIGNED BY: JMA
APPROVED BY: TJM
CAD DATE: April 23, 2002 1:20:22 p.m.
CAD FILE: 807650\807650-6.DWG (ASBUILT)

I HEREBY CERTIFY THAT THIS PLAN, SPECIFICATION, OR REPORT WAS PREPARED BY ME OR UNDER MY DIRECT SUPERVISION AND THAT I AM A DULY REGISTERED PROFESSIONAL ENGINEER UNDER THE LAWS OF THE STATE OF MINNESOTA.

NO.	DATE	BY	REVISION DESCRIPTION

1326 ENERGY PARK DRIVE
ST. PAUL, MINNESOTA 55108
(651) 644-4389

Howard R. Green Company
CONSULTING ENGINEERS

CITY OF ELK RIVER
WESTERN AREA PHASE IV
STREET AND UTILITY IMPROVEMENTS

PLAN AND PROFILE
WACO STREET
S.A.P. 204-131-02, 204-126-03, S.P. 7102-99 6H+75 TO 67+25

SHEET NO.
27