


WACO SEDIMENT POND

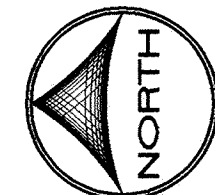

DRAWING NUMBER

DRAWING NUMBER

DRAWING NUMBER


DRAWING NUMBER

REORDER BY PART NUMBER 6552

REORDER BY PART NUMBER 6552

REORDER BY PART NUMBER 6552

ORDER BY PART NUMBER 8552

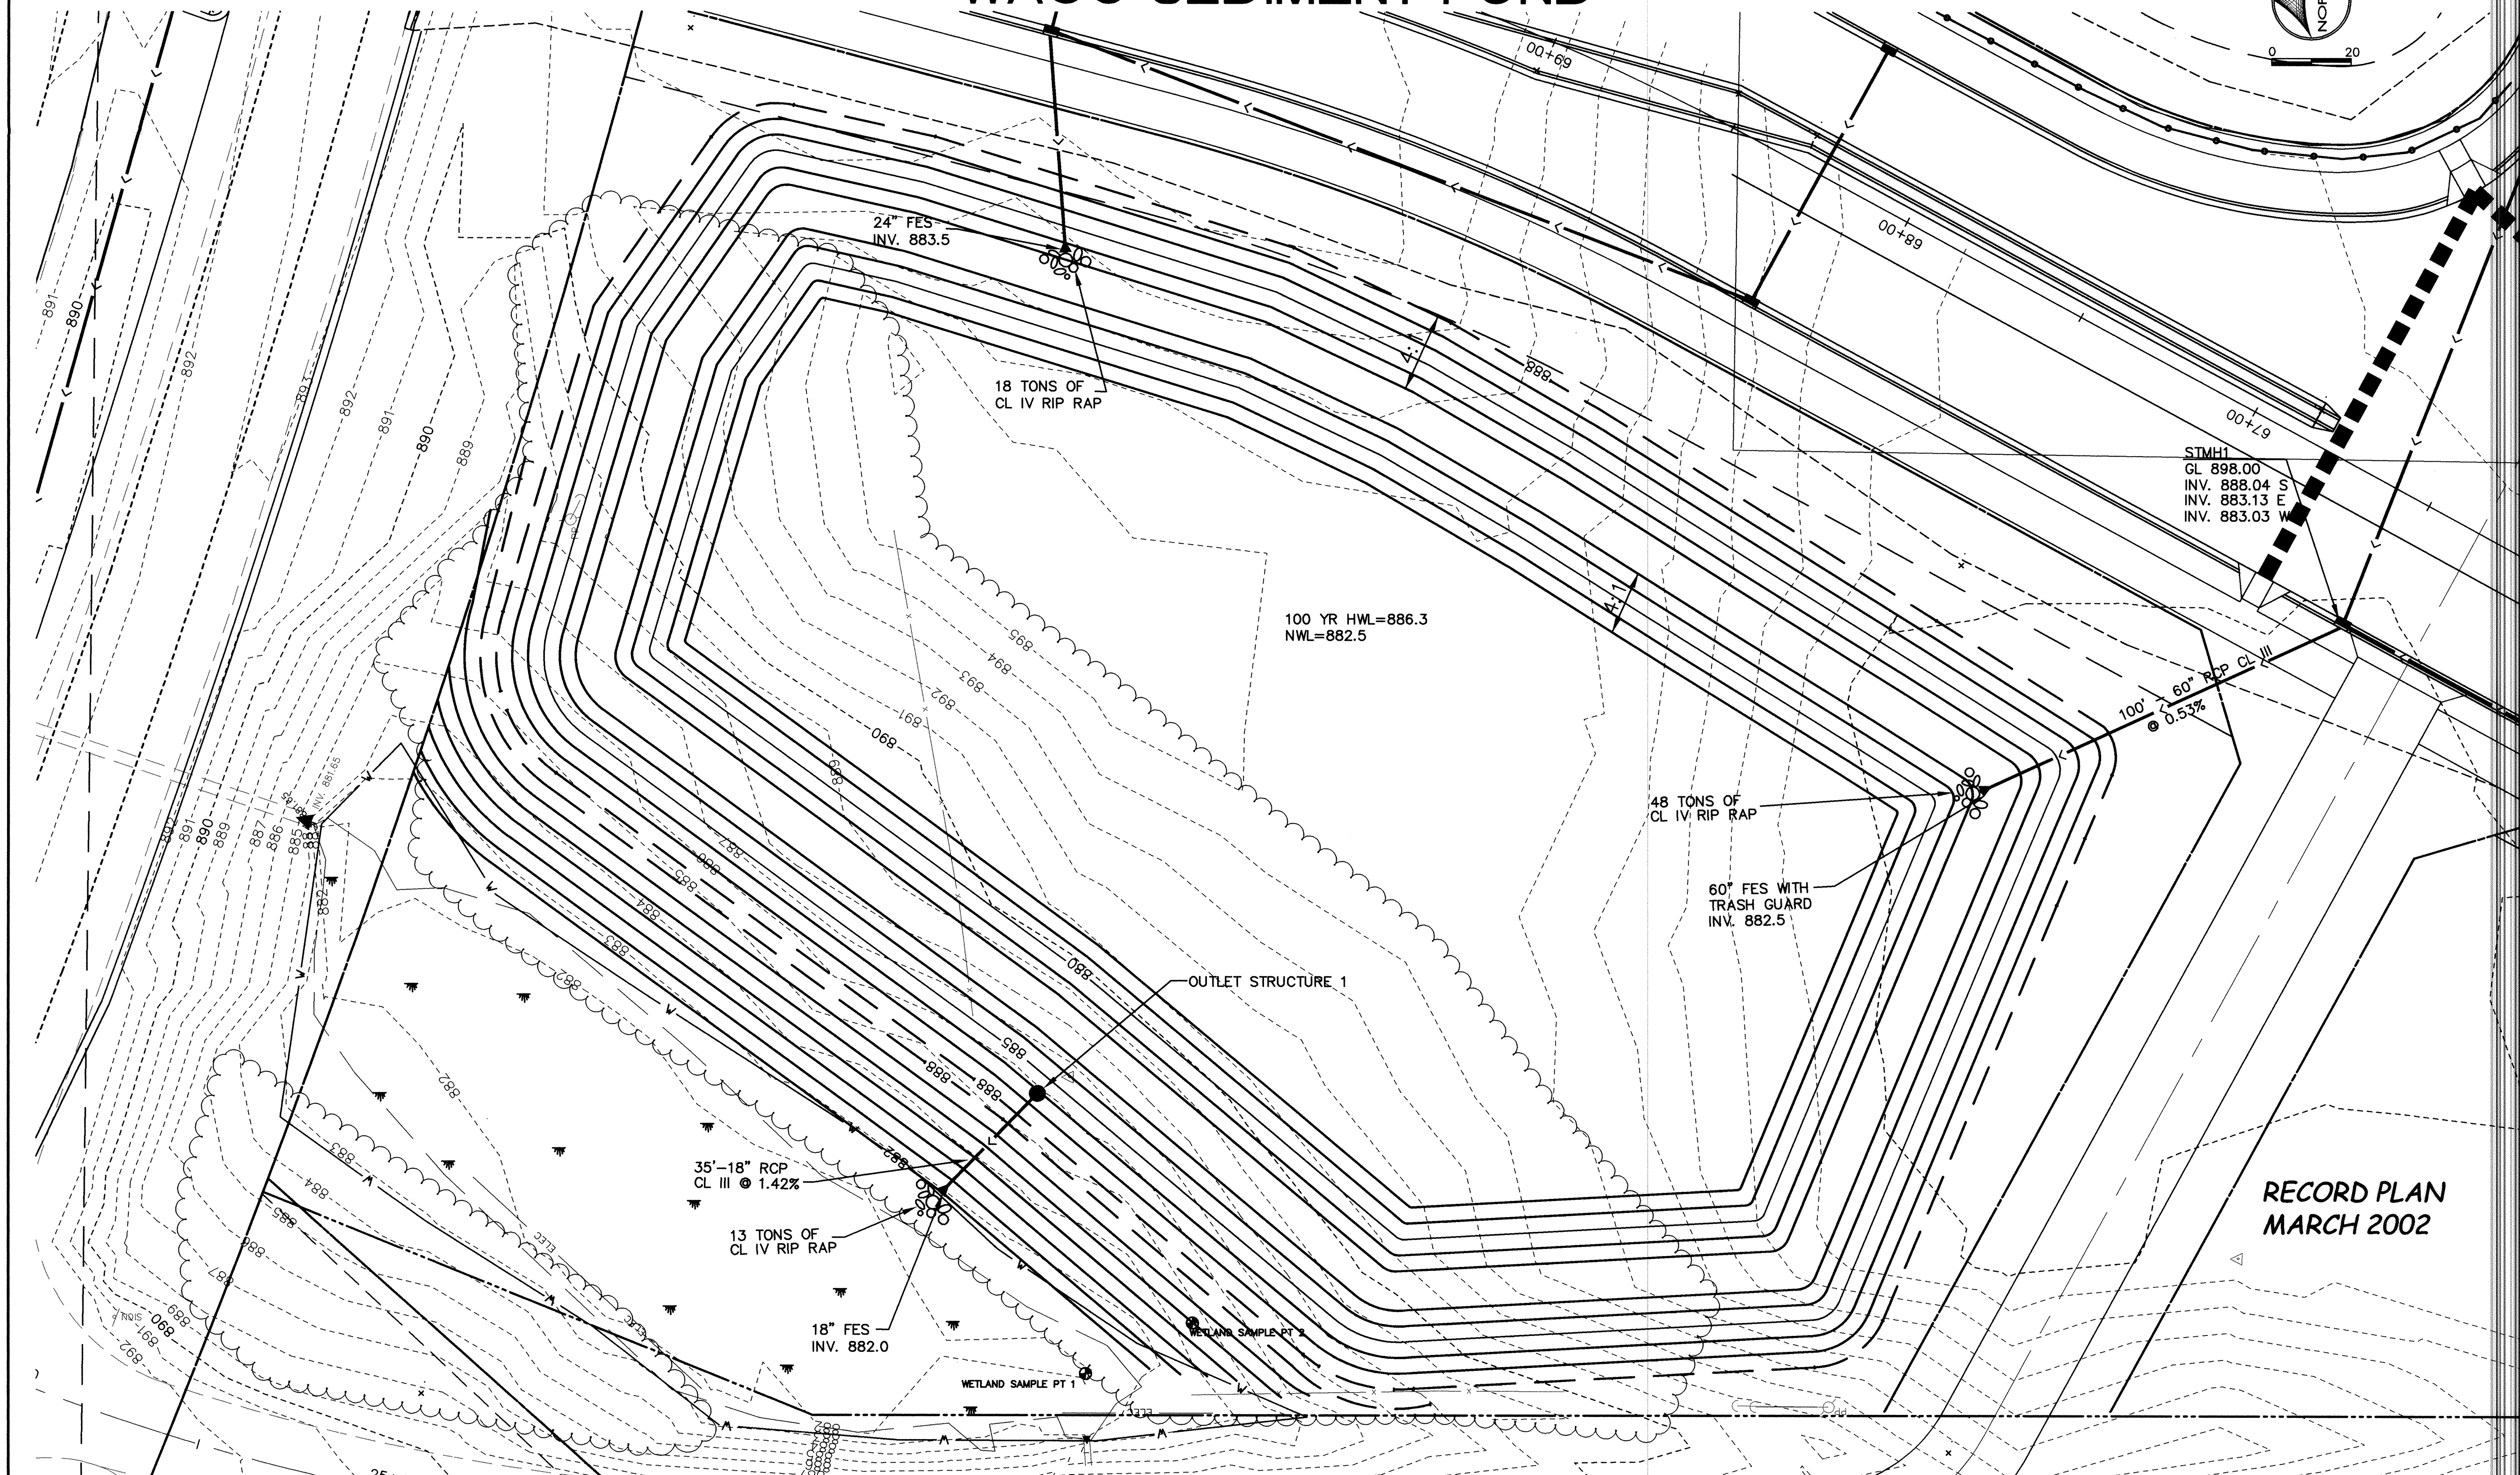


RECORD PLAN
MARCH 2002

DESIGNED BY: DESIGNED_BY DRAWN BY: RKM
 APPROVED BY: APPROVED_BY JOB NUMBER 807650
 CAD DATE: April 23, 2002 1:48:23 p.m.
 CAD FILE: 807650\807650-POND.DWG (ASBUILT)

I HEREBY CERTIFY THAT THIS PLAN, SPECIFICATION,
OR REPORT WAS PREPARED BY ME OR UNDER MY DIRECT
SUPERVISION AND THAT I AM A DULY REGISTERED
PROFESSIONAL ENGINEER UNDER THE LAWS OF THE
STATE OF MINNESOTA.

DATE _____ REG. NO. 15316

NO.	DATE	BY	REVISION DESCRIPTION

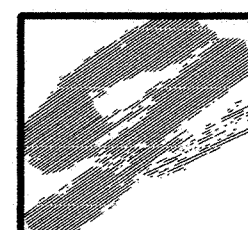

Howard R. Green Company
CONSULTING ENGINEERS

1326 ENERGY PARK DRIVE
ST. PAUL, MINNESOTA 55108
(651) 644-4389

CITY OF ELK RIVER
WESTERN AREA PHASE IV
STREET AND UTILITY IMPROVEMENTS

PLAN AND PROFILE WACO STREET SEDIMENT POND

S.A.P. 204-131-02, 204-126-03, S.P. 7102-99

SHEET NO.

32