
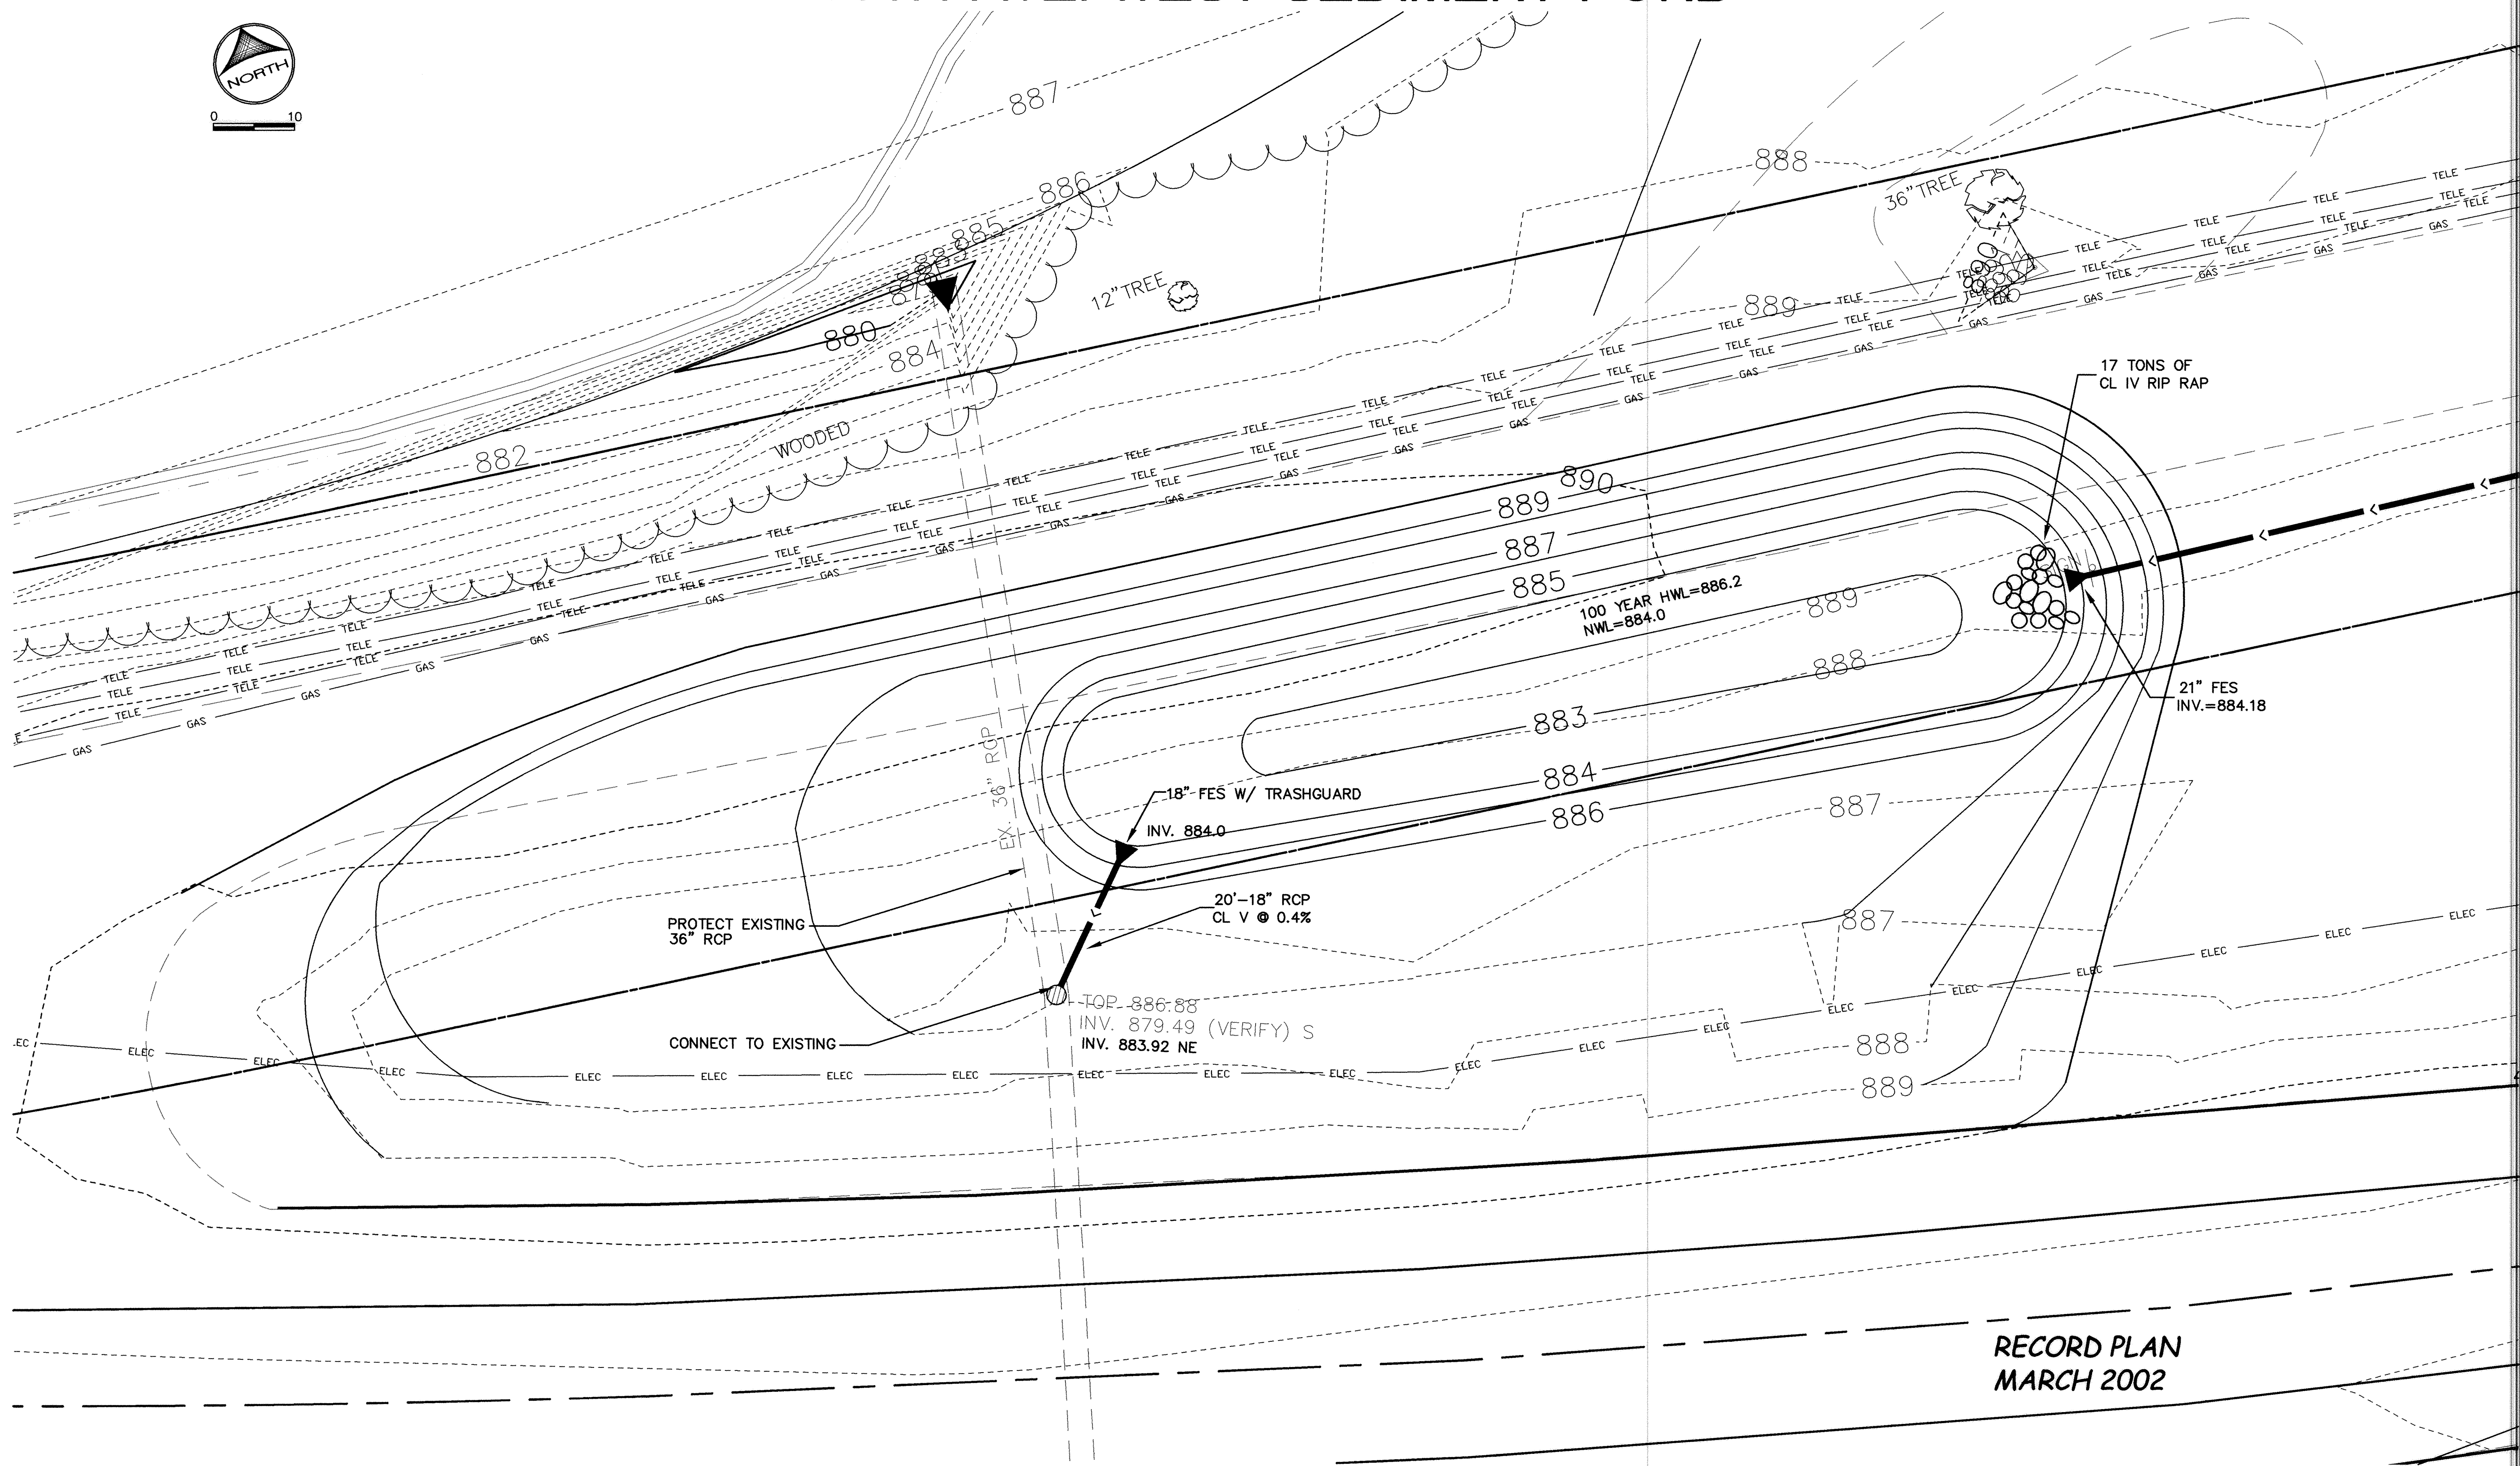


185TH AVE. WEST SEDIMENT POND

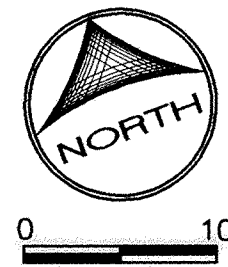


RECORD PLAN
MARCH 2002

Xrefs: 807650-B.DWG

DESIGNED BY: JMA DRAWN BY: RKM
APPROVED BY: TJM JOB NUMBER 807650
CAD DATE: April 23, 2002 1:51:50 p.m.
CAD FILE: 807650\807650-POND2.DWG (ASBUILT)

I HEREBY CERTIFY THAT THIS PLAN, SPECIFICATION,
OR REPORT WAS PREPARED BY ME OR UNDER MY DIRECT
SUPERVISION AND THAT I AM A DULY REGISTERED
PROFESSIONAL ENGINEER UNDER THE LAWS OF THE
STATE OF MINNESOTA.
DATE _____ REG. NO. 15316

NO.	DATE	BY	REVISION DESCRIPTION

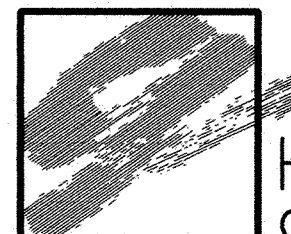

Howard R. Green Company
CONSULTING ENGINEERS

1326 ENERGY PARK DRIVE
ST. PAUL, MINNESOTA 55108
(651) 644-4389

CITY OF ELK RIVER
WESTERN AREA PHASE IV
STREET AND UTILITY IMPROVEMENTS

WEST 185TH AVENUE SEDIMENT POND
S.A.P. 204-131-02, 204-126-03, S.P. 7102-99

SHEET NO.
33

DRAWING NUMBER
WEST4.00
21 (33)

SACD PRODUCTS • NEW HOPE, MINNESOTA
RENDERED BY PART NUMBER 1832
POTENTIAL SOURCE OF WATER TO THE LAKE

SACD PRODUCTS • NEW HOPE, MINNESOTA
RENDERED BY PART NUMBER 1832
POTENTIAL SOURCE OF WATER TO THE LAKE

SACD PRODUCTS • NEW HOPE, MINNESOTA
RENDERED BY PART NUMBER 1832
POTENTIAL SOURCE OF WATER TO THE LAKE

SACD PRODUCTS • NEW HOPE, MINNESOTA
RENDERED BY PART NUMBER 1832
POTENTIAL SOURCE OF WATER TO THE LAKE

DRAWING NUMBER

DRAWING NUMBER

DRAWING NUMBER

DRAWING NUMBER