

DRAWING NUMBER

DRAWING NUMBER

DRAWING NUMBER

DRAWING NUMBER
WEST 4.00
23 (37)



TO PRODUCTS • NEW HOPE, MINNESOTA
REVISION BY PART NUMBER 8552

SACD PRODUCTS • NEW HOPE, MINNESOTA
REVISION BY PART NUMBER 8552

SACD PRODUCTS • NEW HOPE, MINNESOTA
REVISION BY PART NUMBER 8552

SACD PRODUCTS • NEW HOPE, MINNESOTA
REVISION BY PART NUMBER 8552

TRUNK HIGHWAY NO. 10

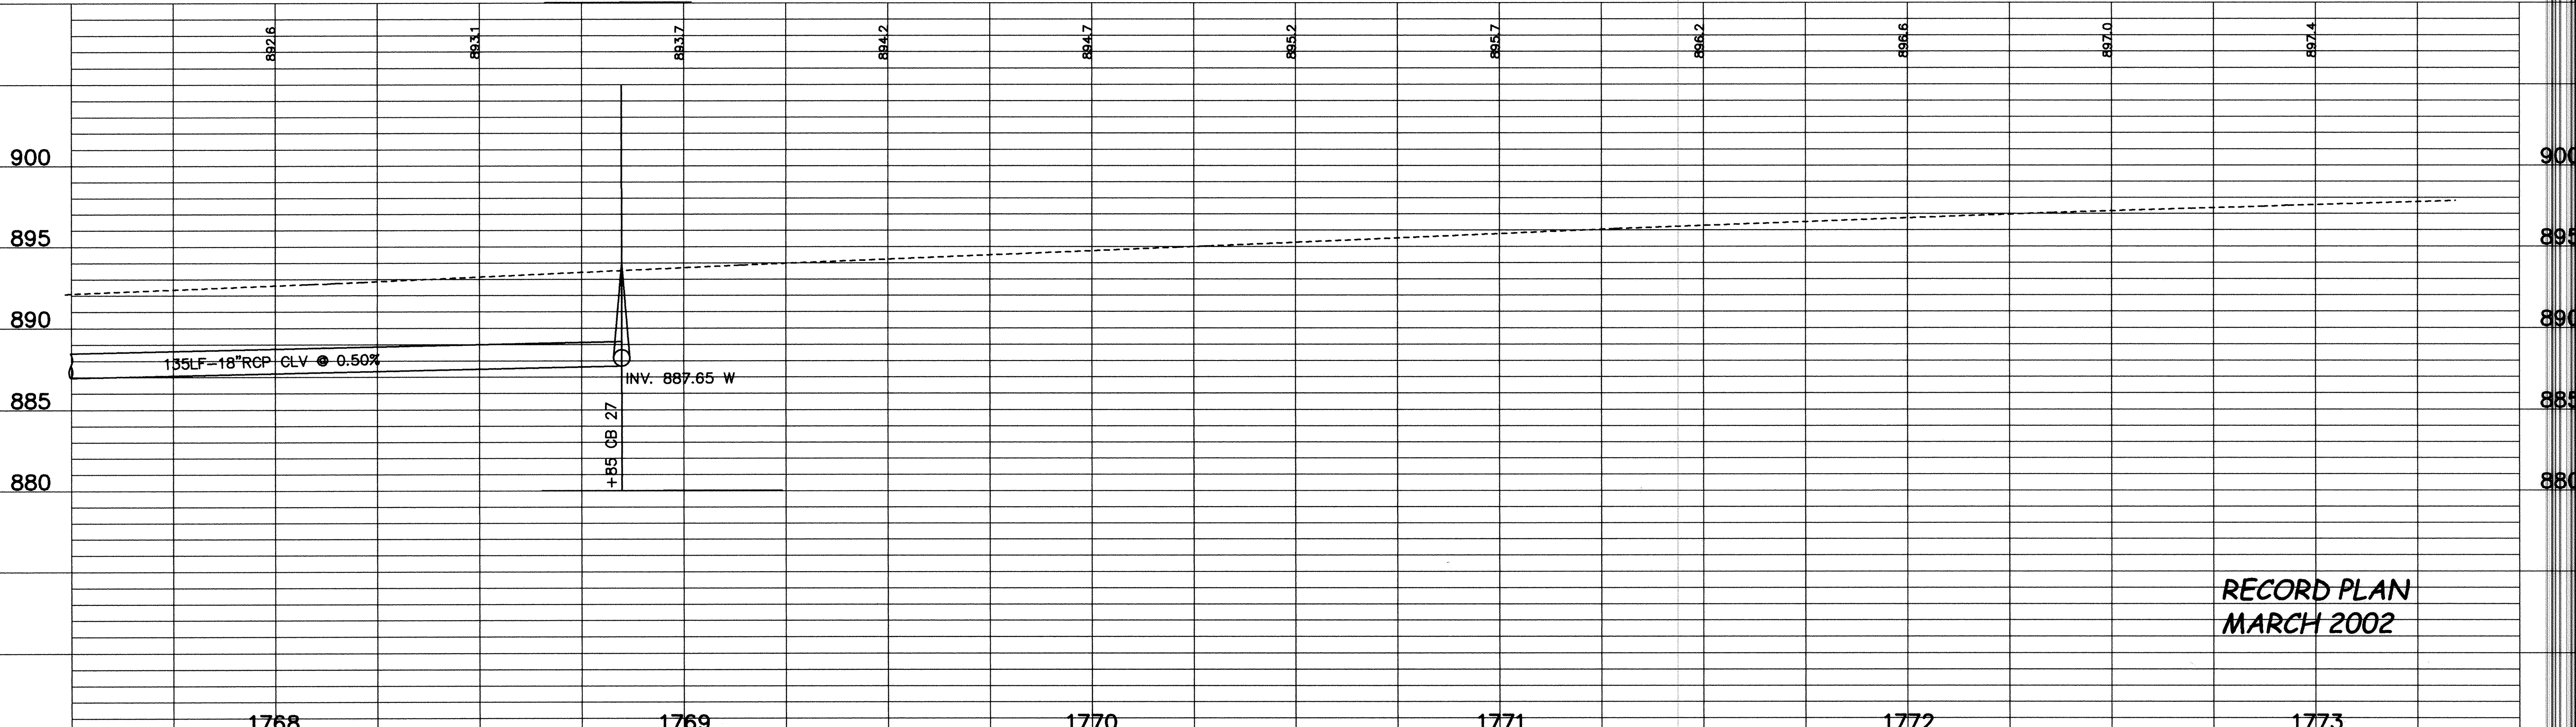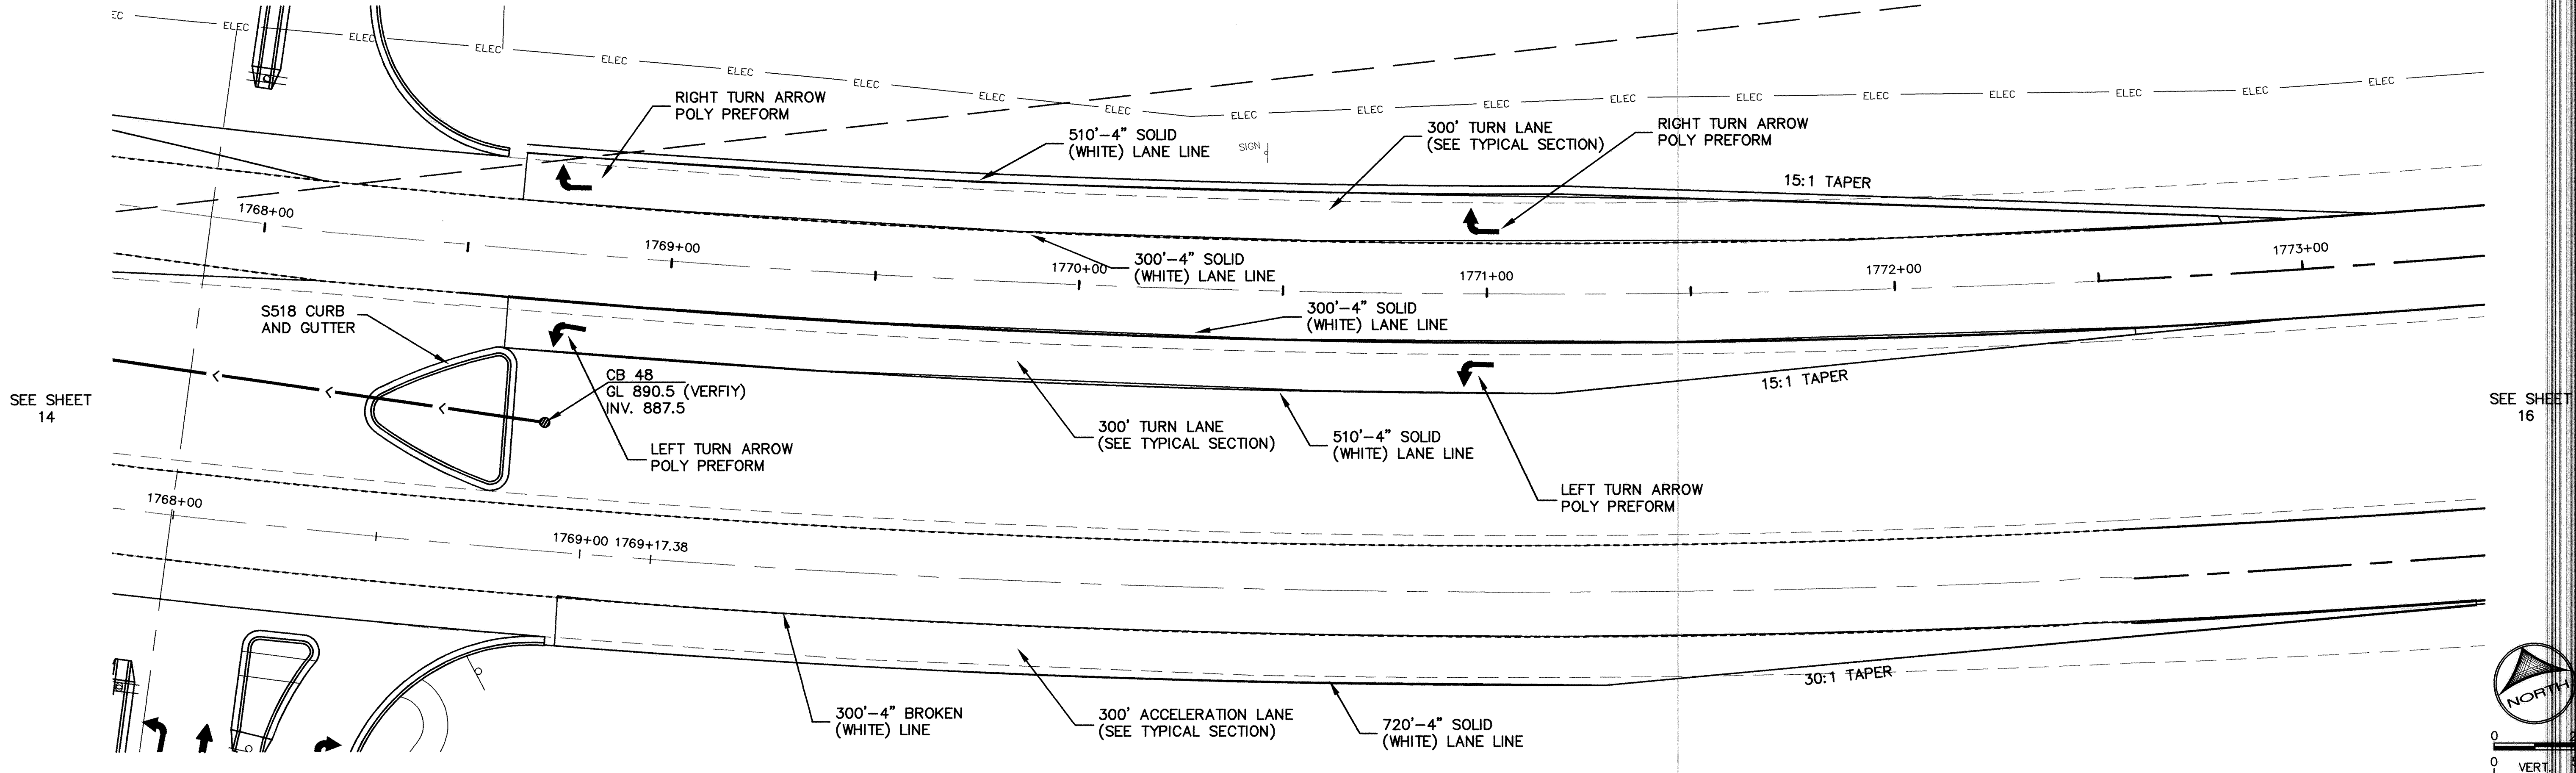

RECORD PLAN
MARCH 2002

DESIGNED BY: JMA DRAWN BY: RKM
APPROVED BY: TJM JOB NUMBER 807650
CAD DATE: April 23, 2002 2:01:37 p.m.
CAD FILE: 807650\807650-P2.DWG (ASBUILT)

I HEREBY CERTIFY THAT THIS PLAN, SPECIFICATION,
OR REPORT WAS PREPARED BY ME OR UNDER MY DIRECT
SUPERVISION AND THAT I AM A DULY REGISTERED
PROFESSIONAL ENGINEER UNDER THE LAWS OF THE
STATE OF MINNESOTA.
DATE _____ REG. NO. 15316

NO.	DATE	BY	REVISION DESCRIPTION

1326 ENERGY PARK DRIVE
ST. PAUL, MINNESOTA 55108
(651) 644-4389
Howard R. Green Company
CONSULTING ENGINEERS

CITY OF ELK RIVER
WESTERN AREA PHASE IV
STREET AND UTILITY IMPROVEMENTS

PLAN AND PROFILE
TRUNK HIGHWAY NO. 10 - WEST BOUND
S.A.P. 204-131-02, 204-126-03, S.P. 7102-99 1767+50 TO 1773+00

SHEET NO.
37