




CONCRETE CURB AND GUTTER B618

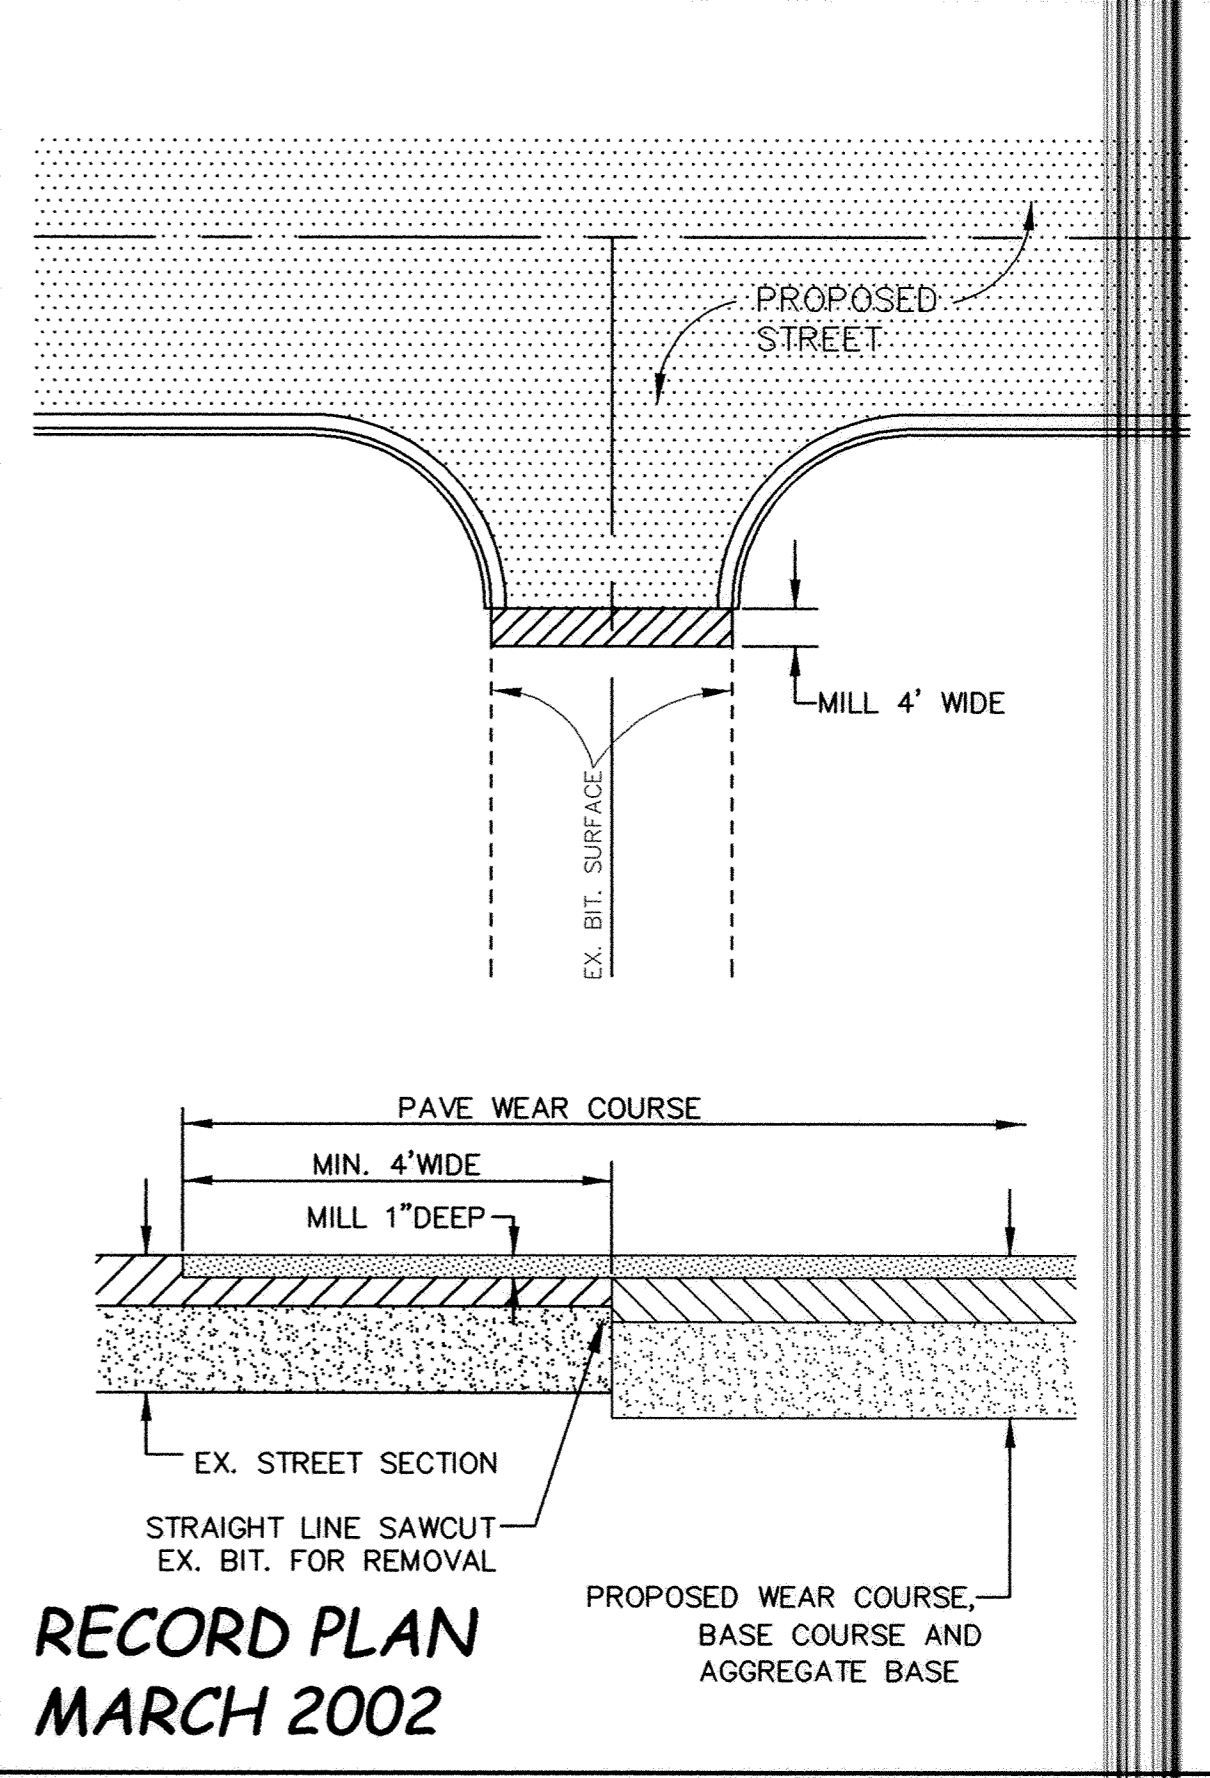


MATCH EXISTING BITUMINOUS SURFACING

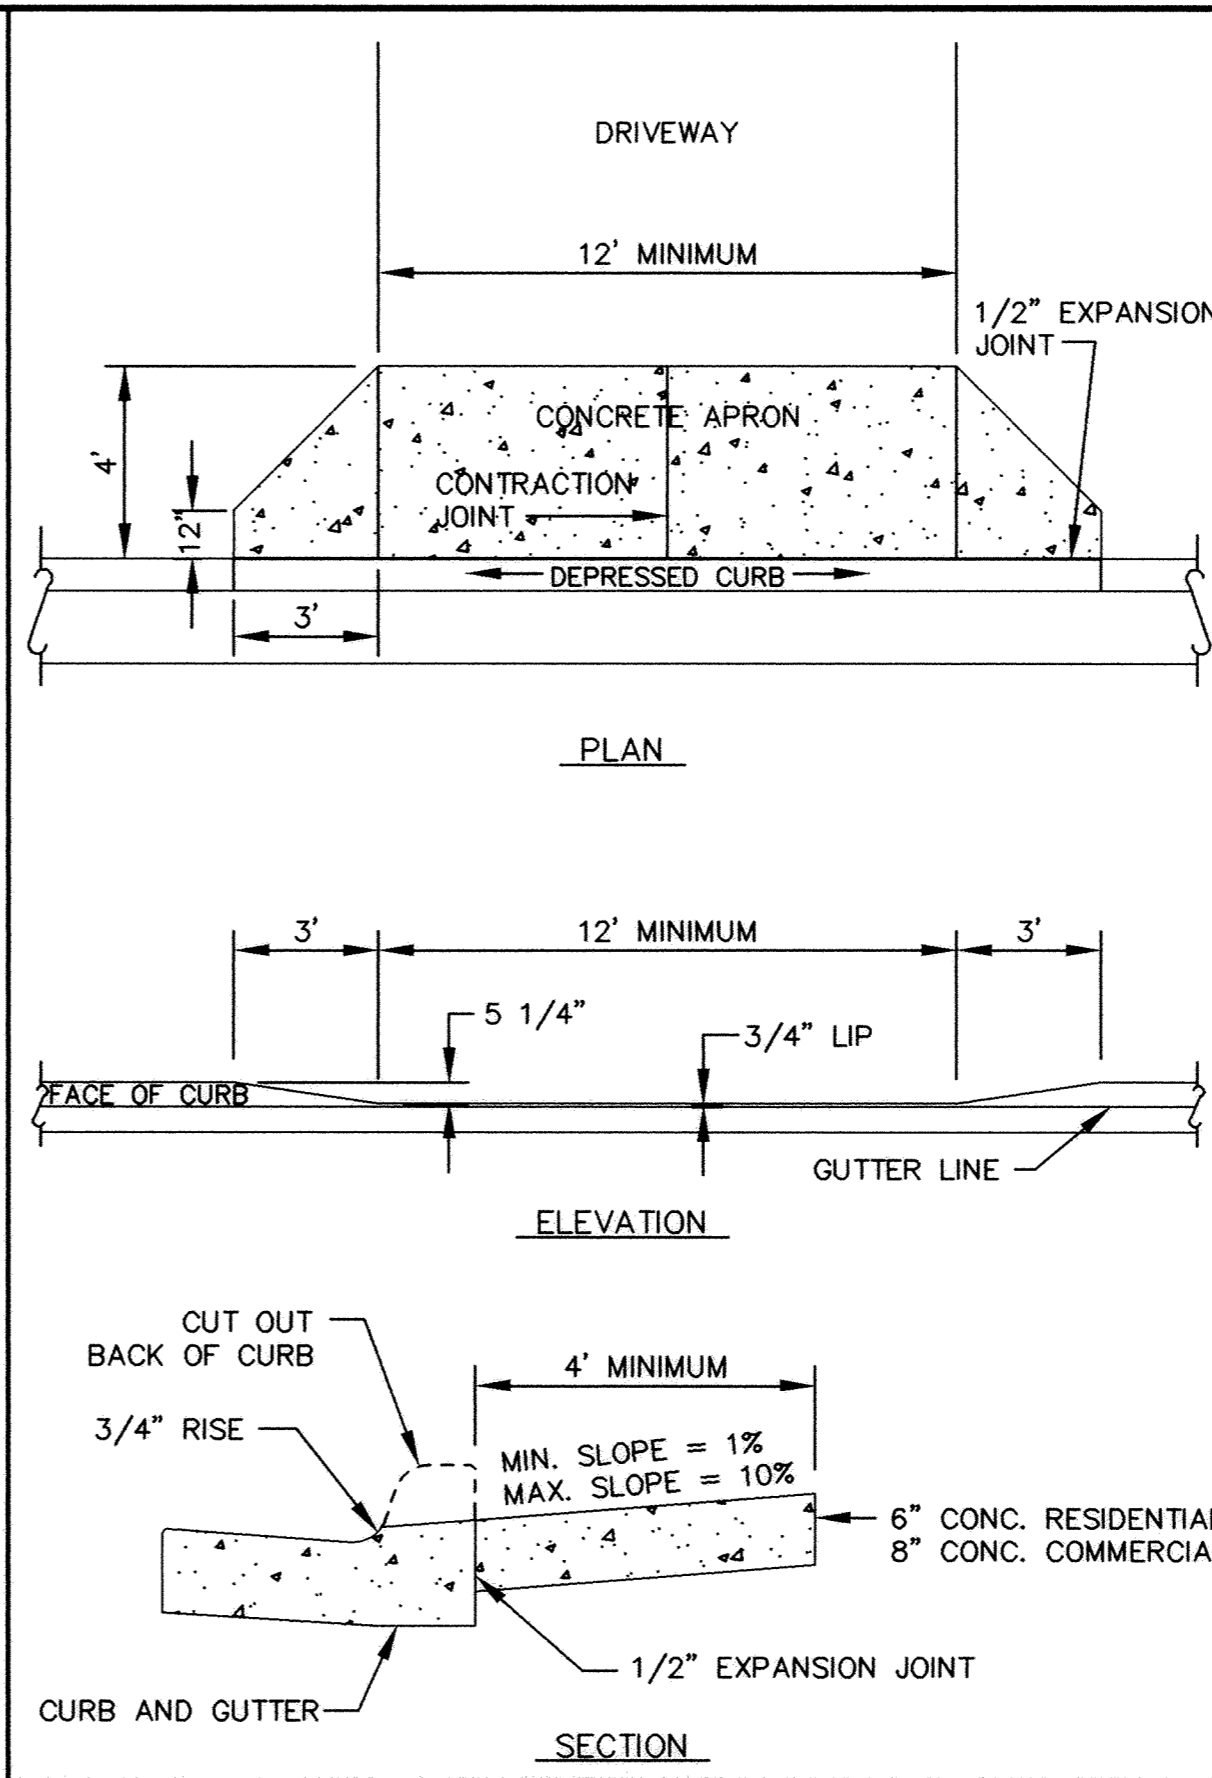


DEPRESSED CURB WITH DRIVEWAY APRON

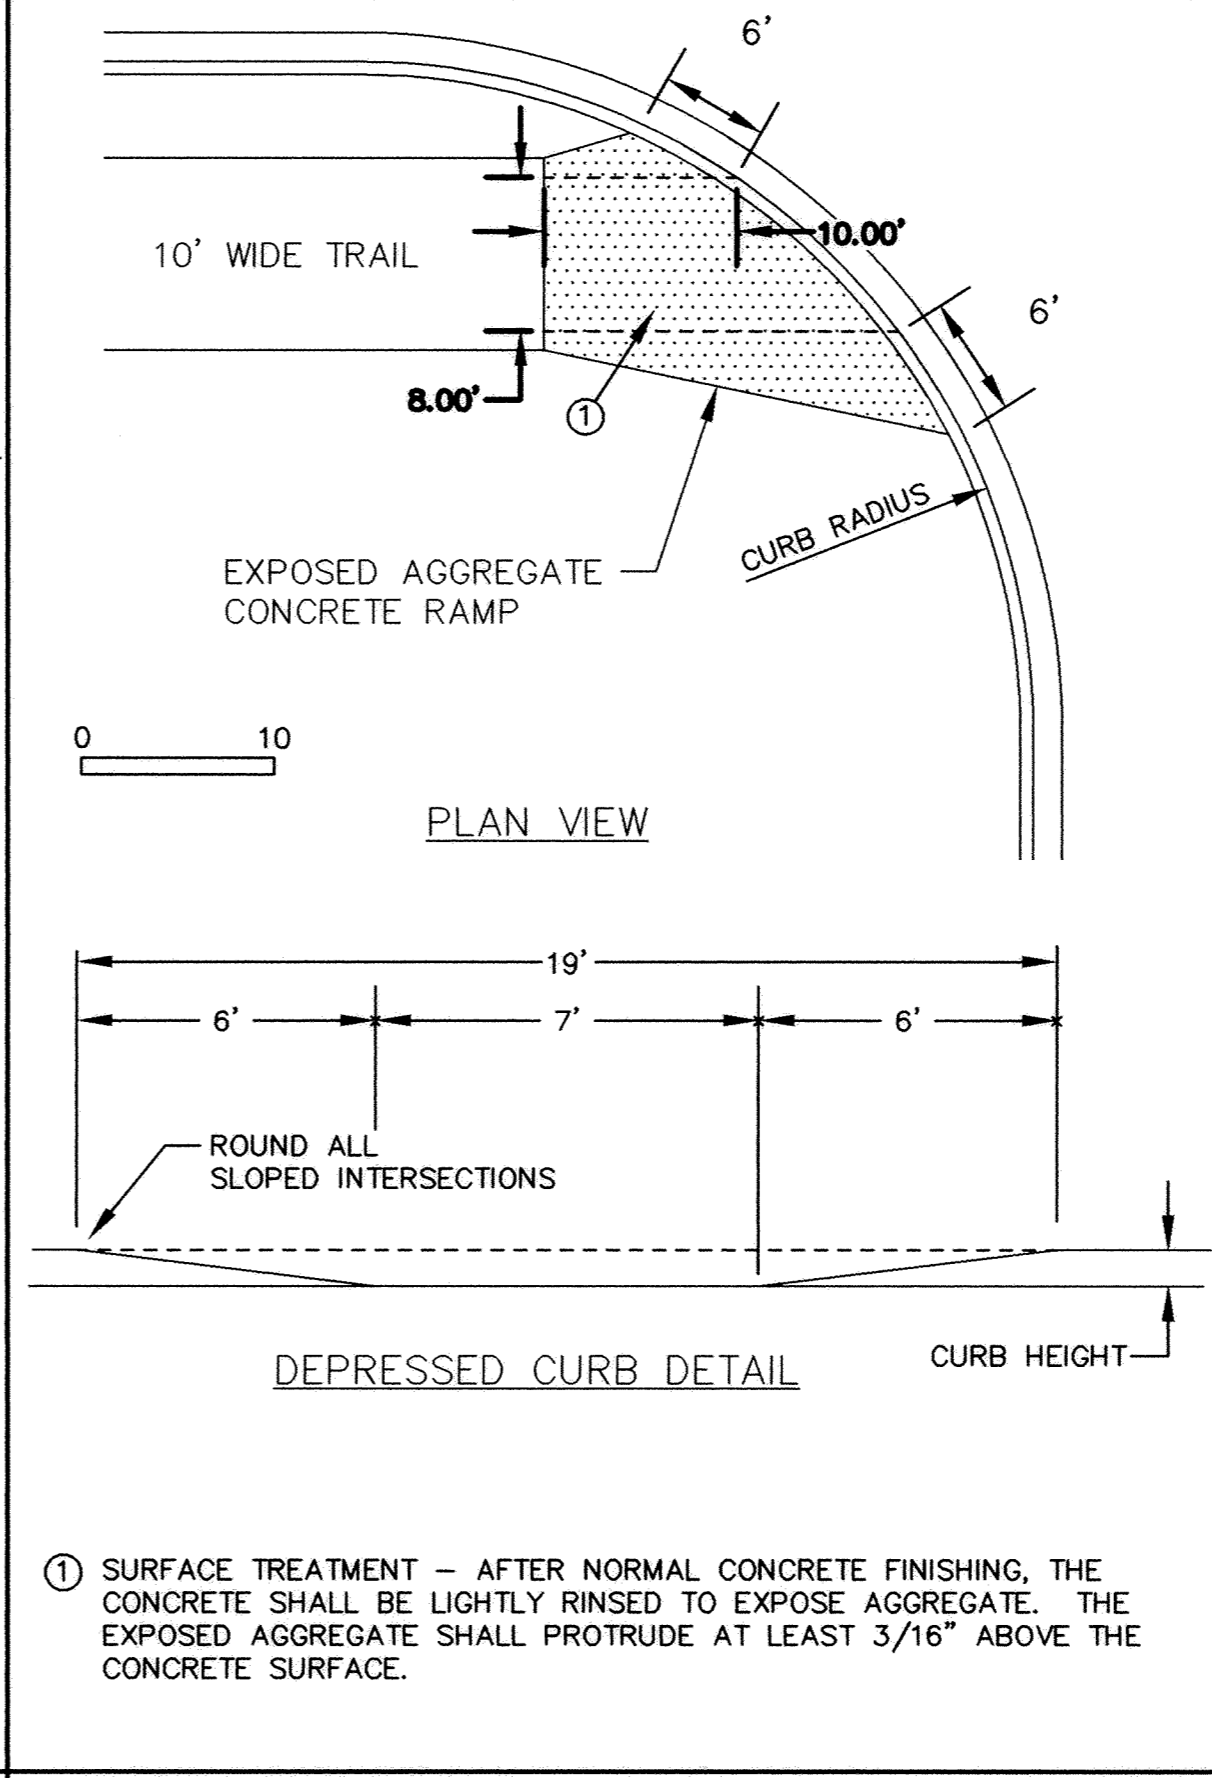


PEDESTRIAN CURB RAMPS FOR TRAILS

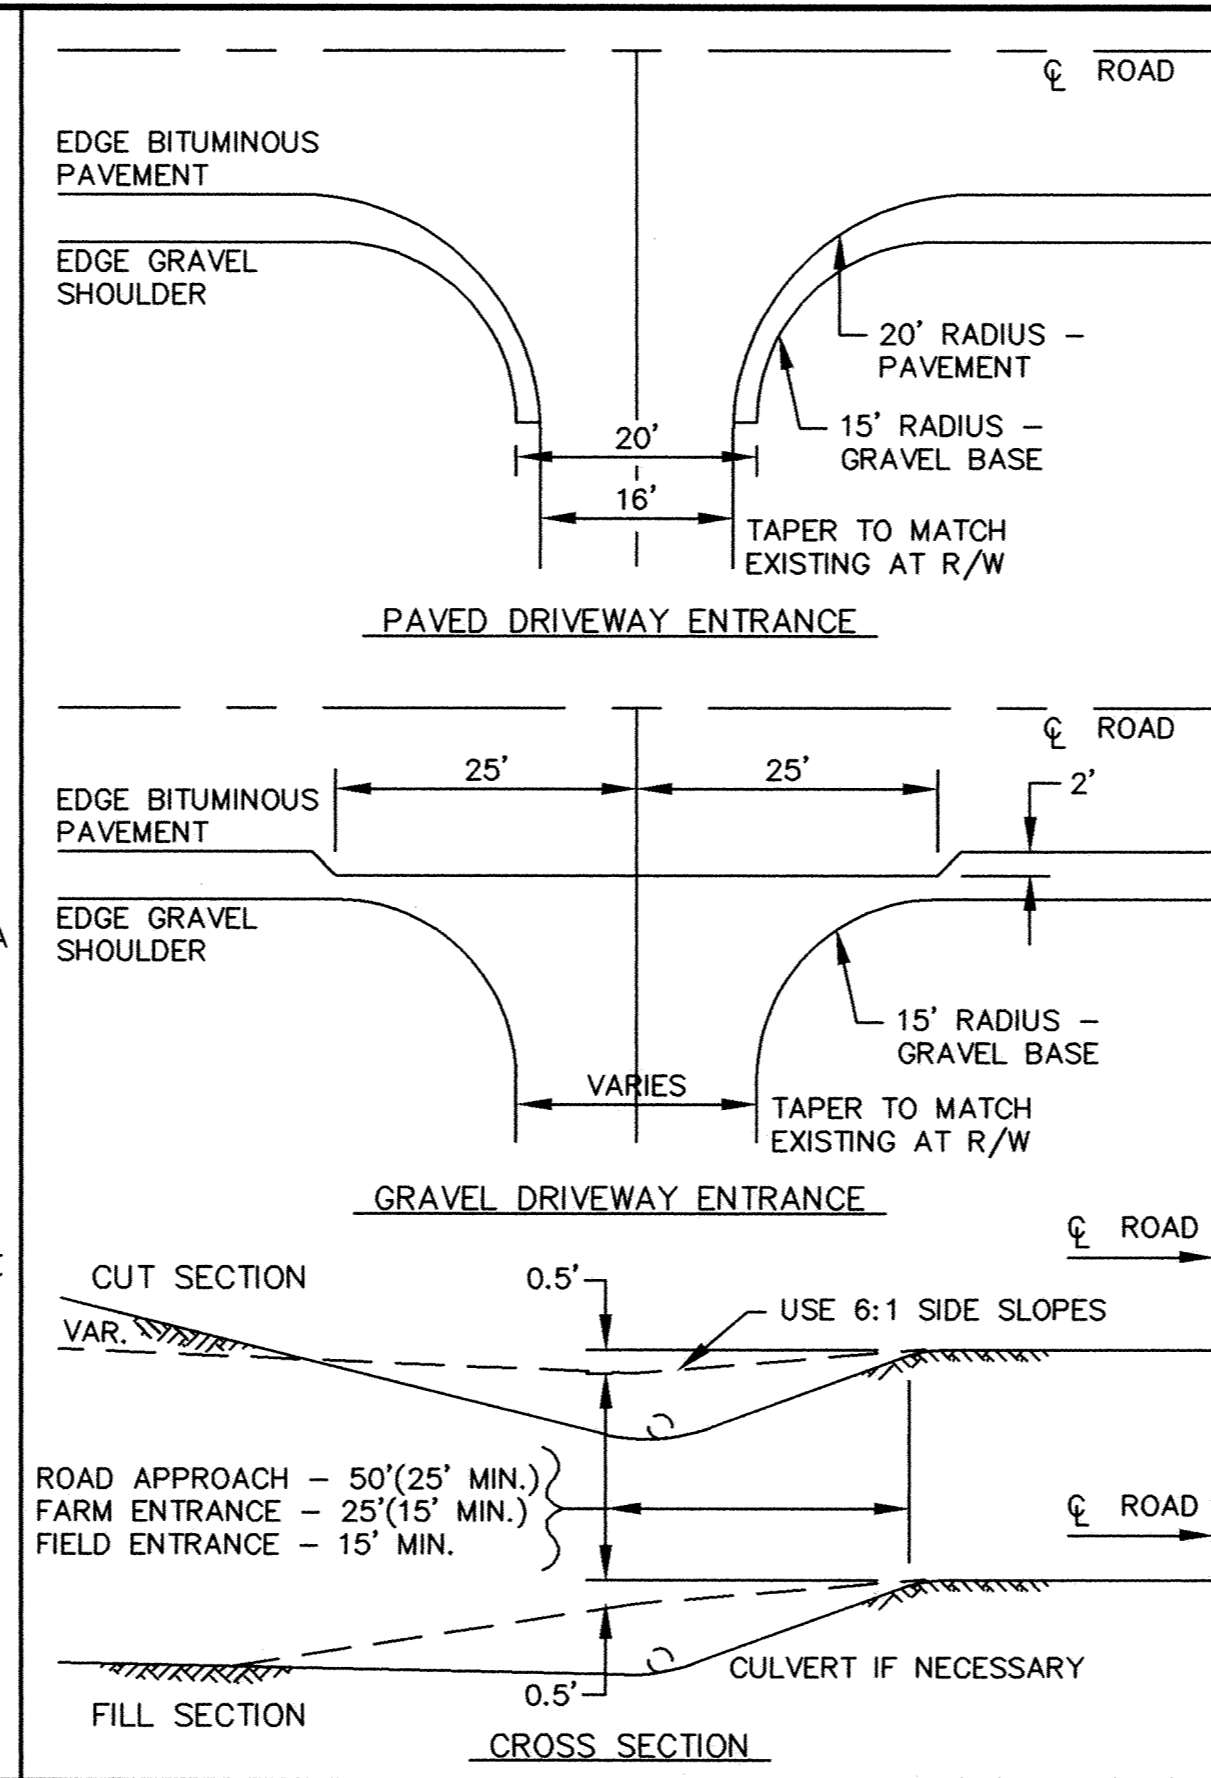


RURAL DRIVEWAY ENTRANCE

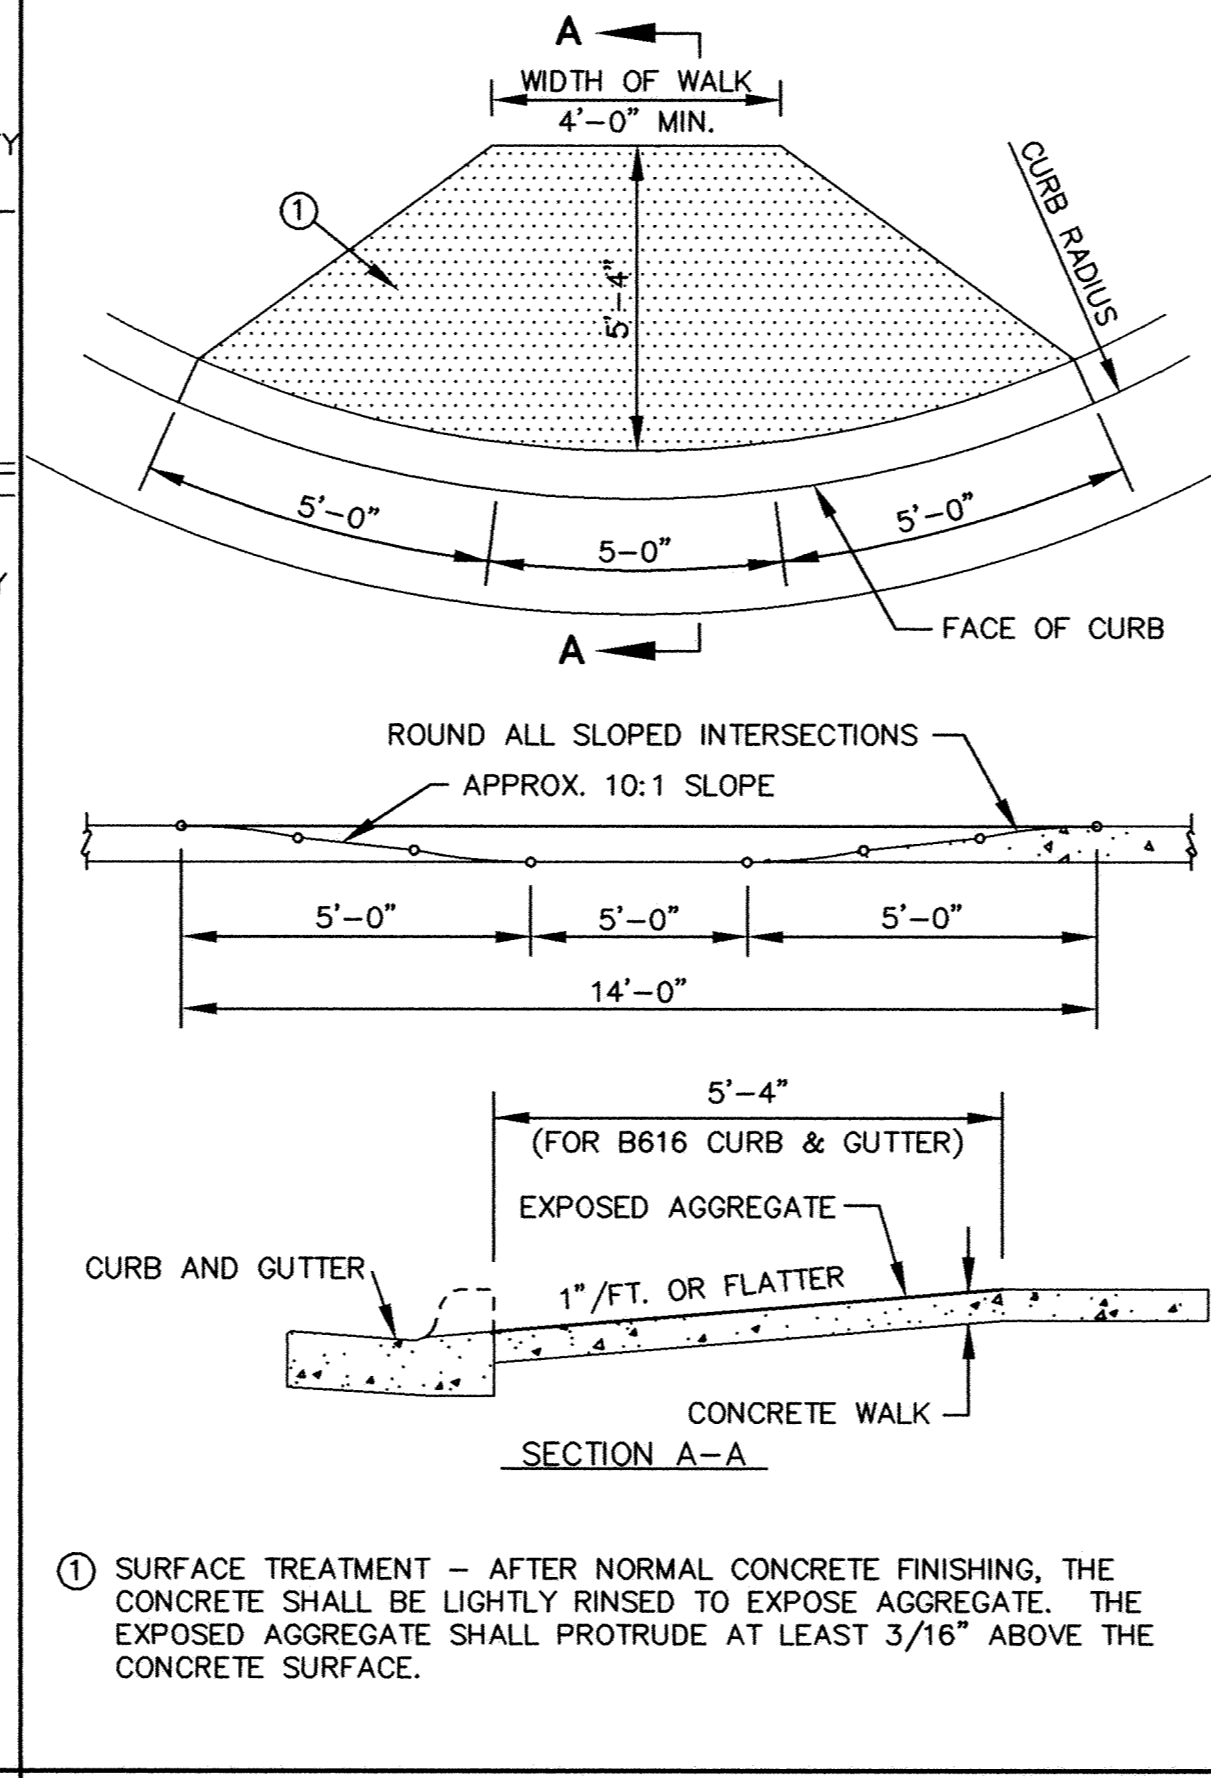


PEDESTRIAN CURB RAMPS FOR SIDEWALKS

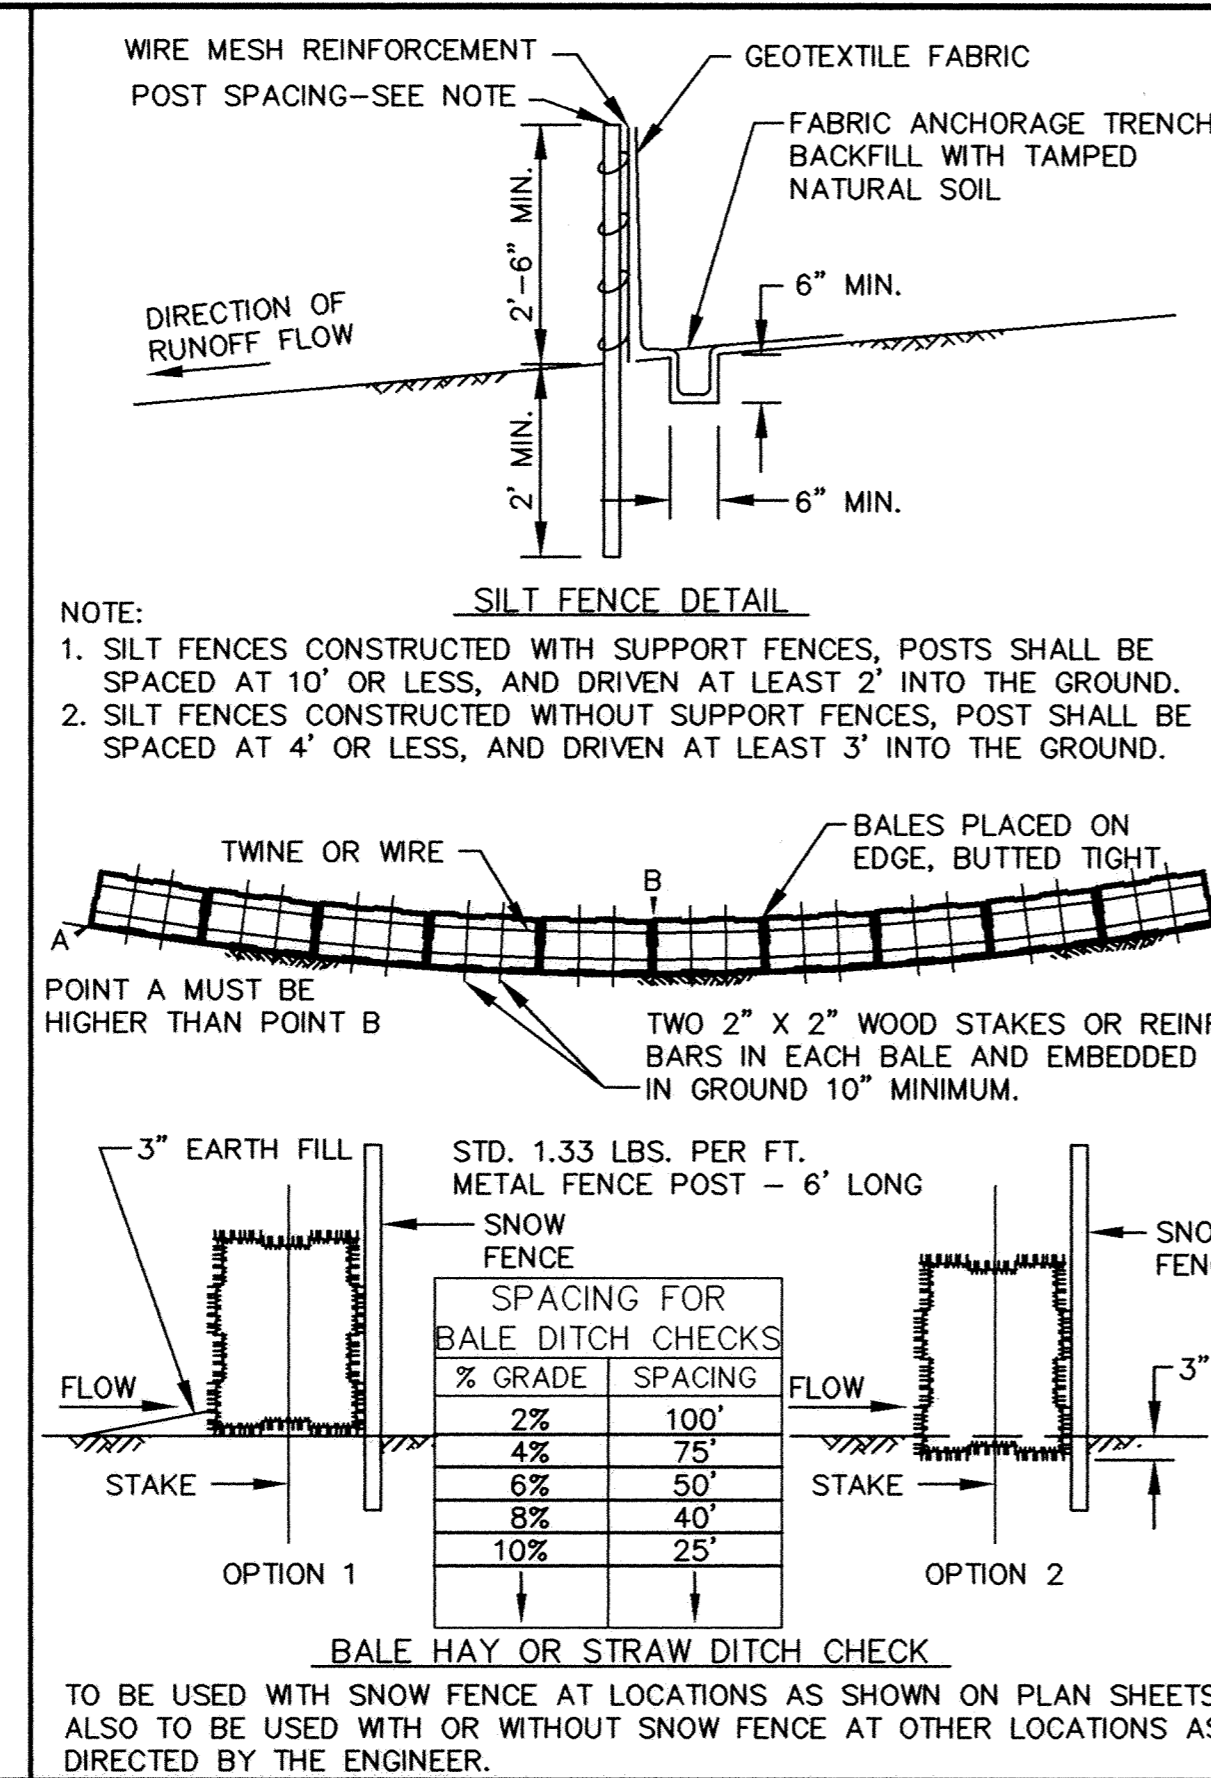


EROSION CONTROL DETAIL

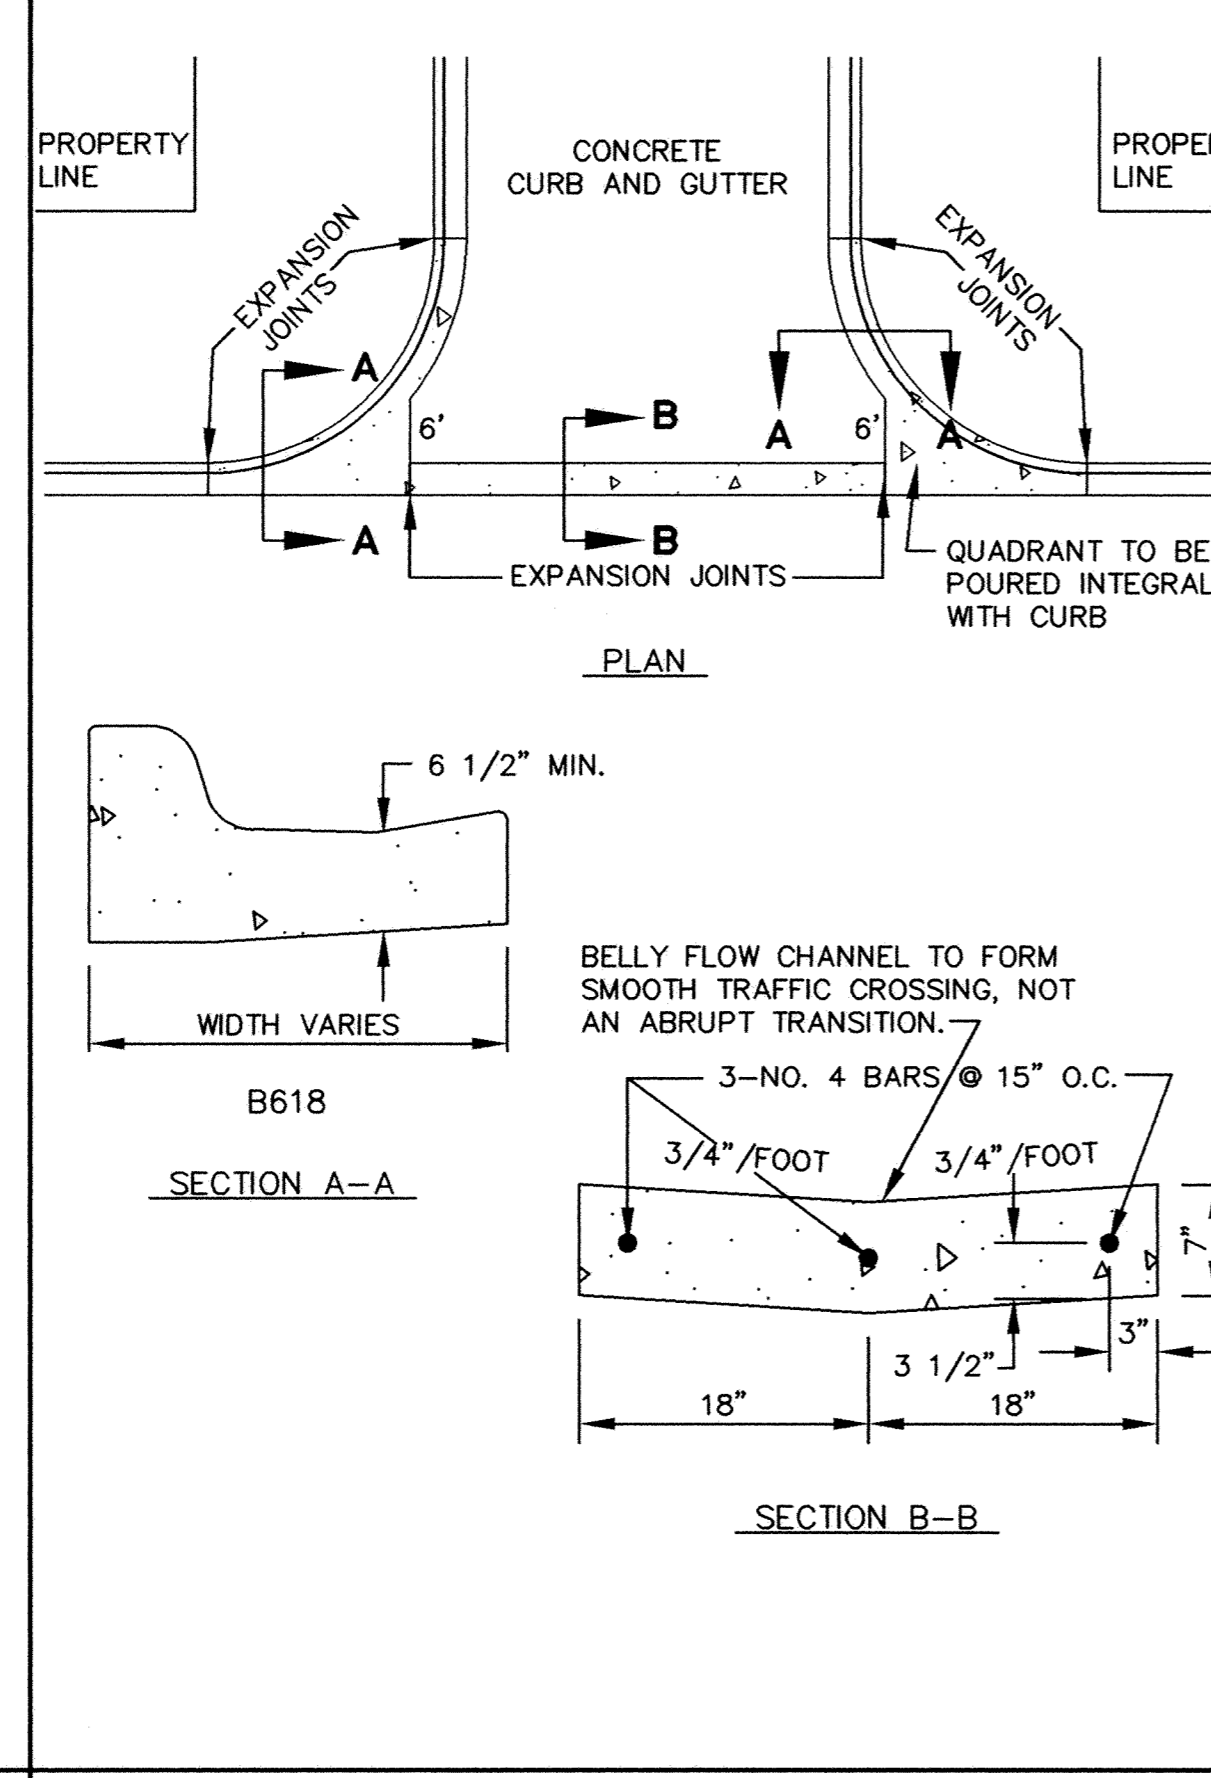

CONCRETE "V" GUTTER

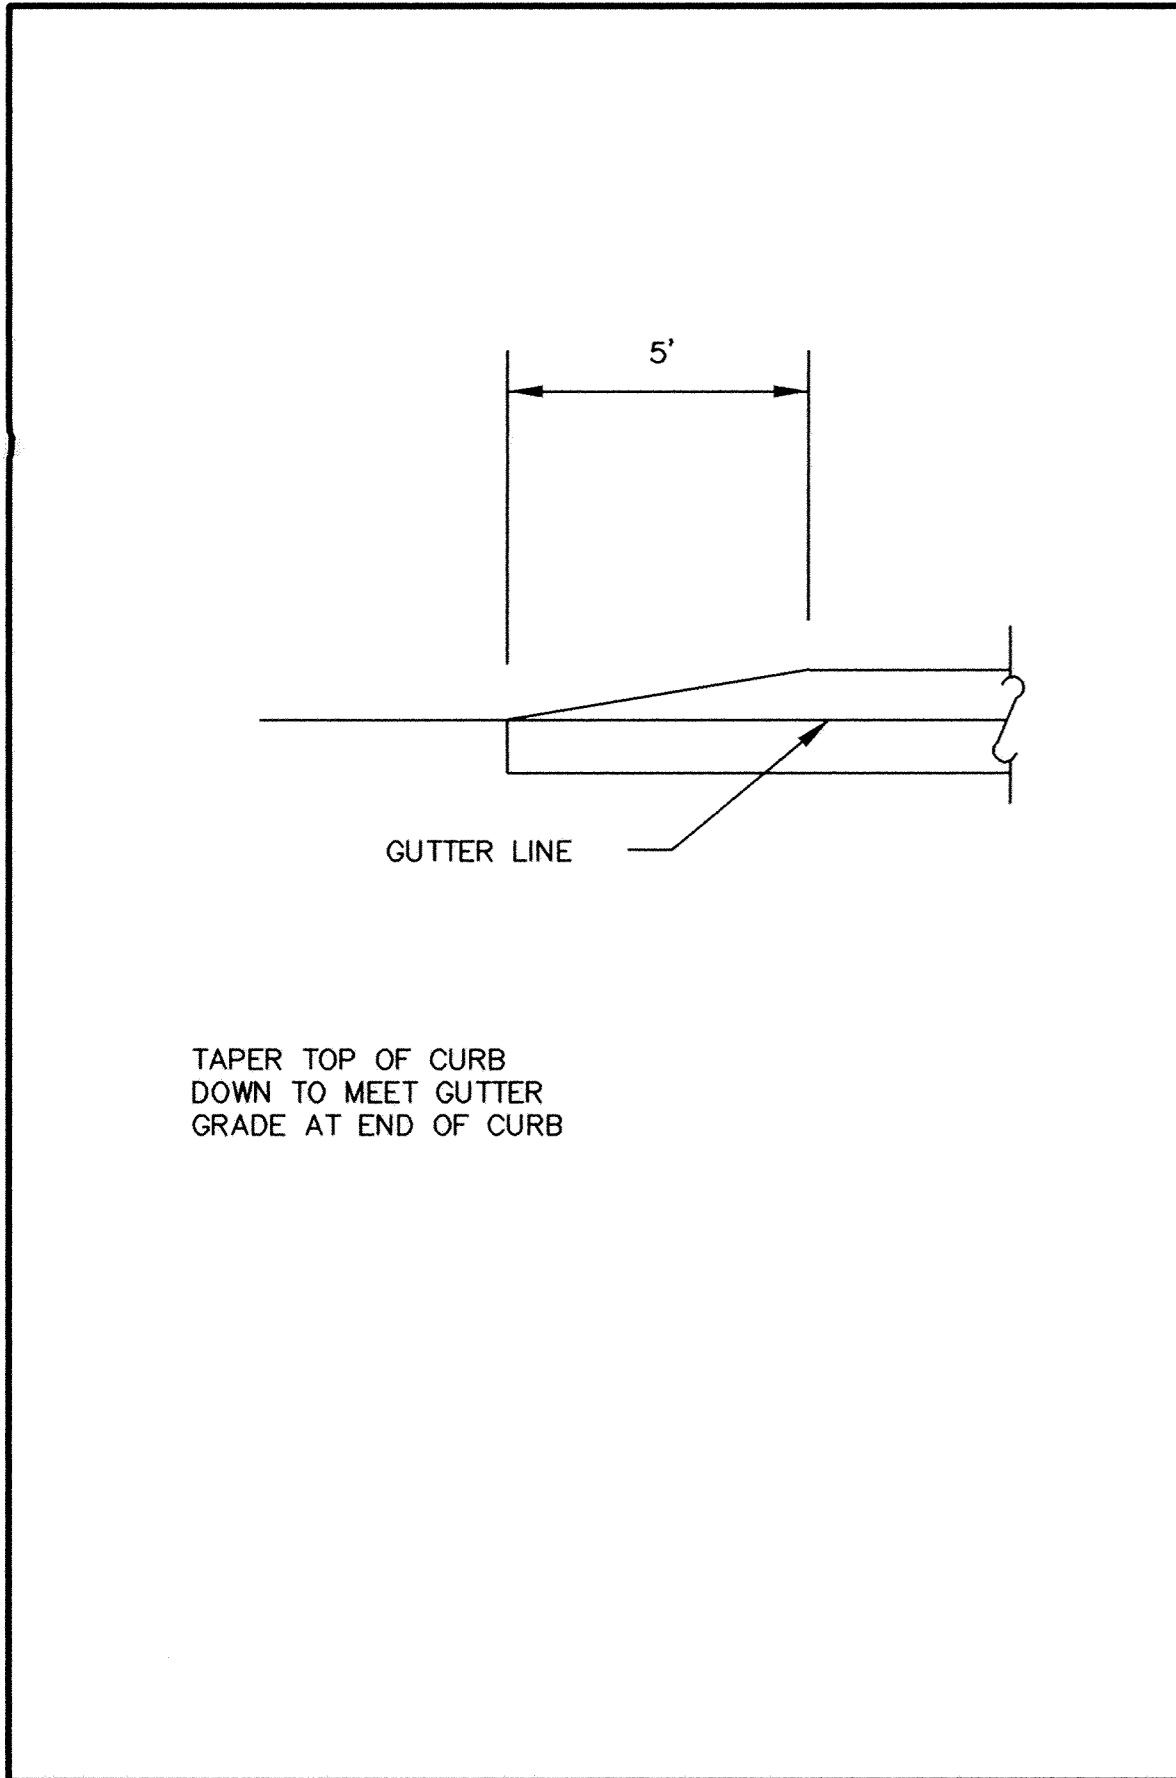

STANDARD TAPERED CURB END

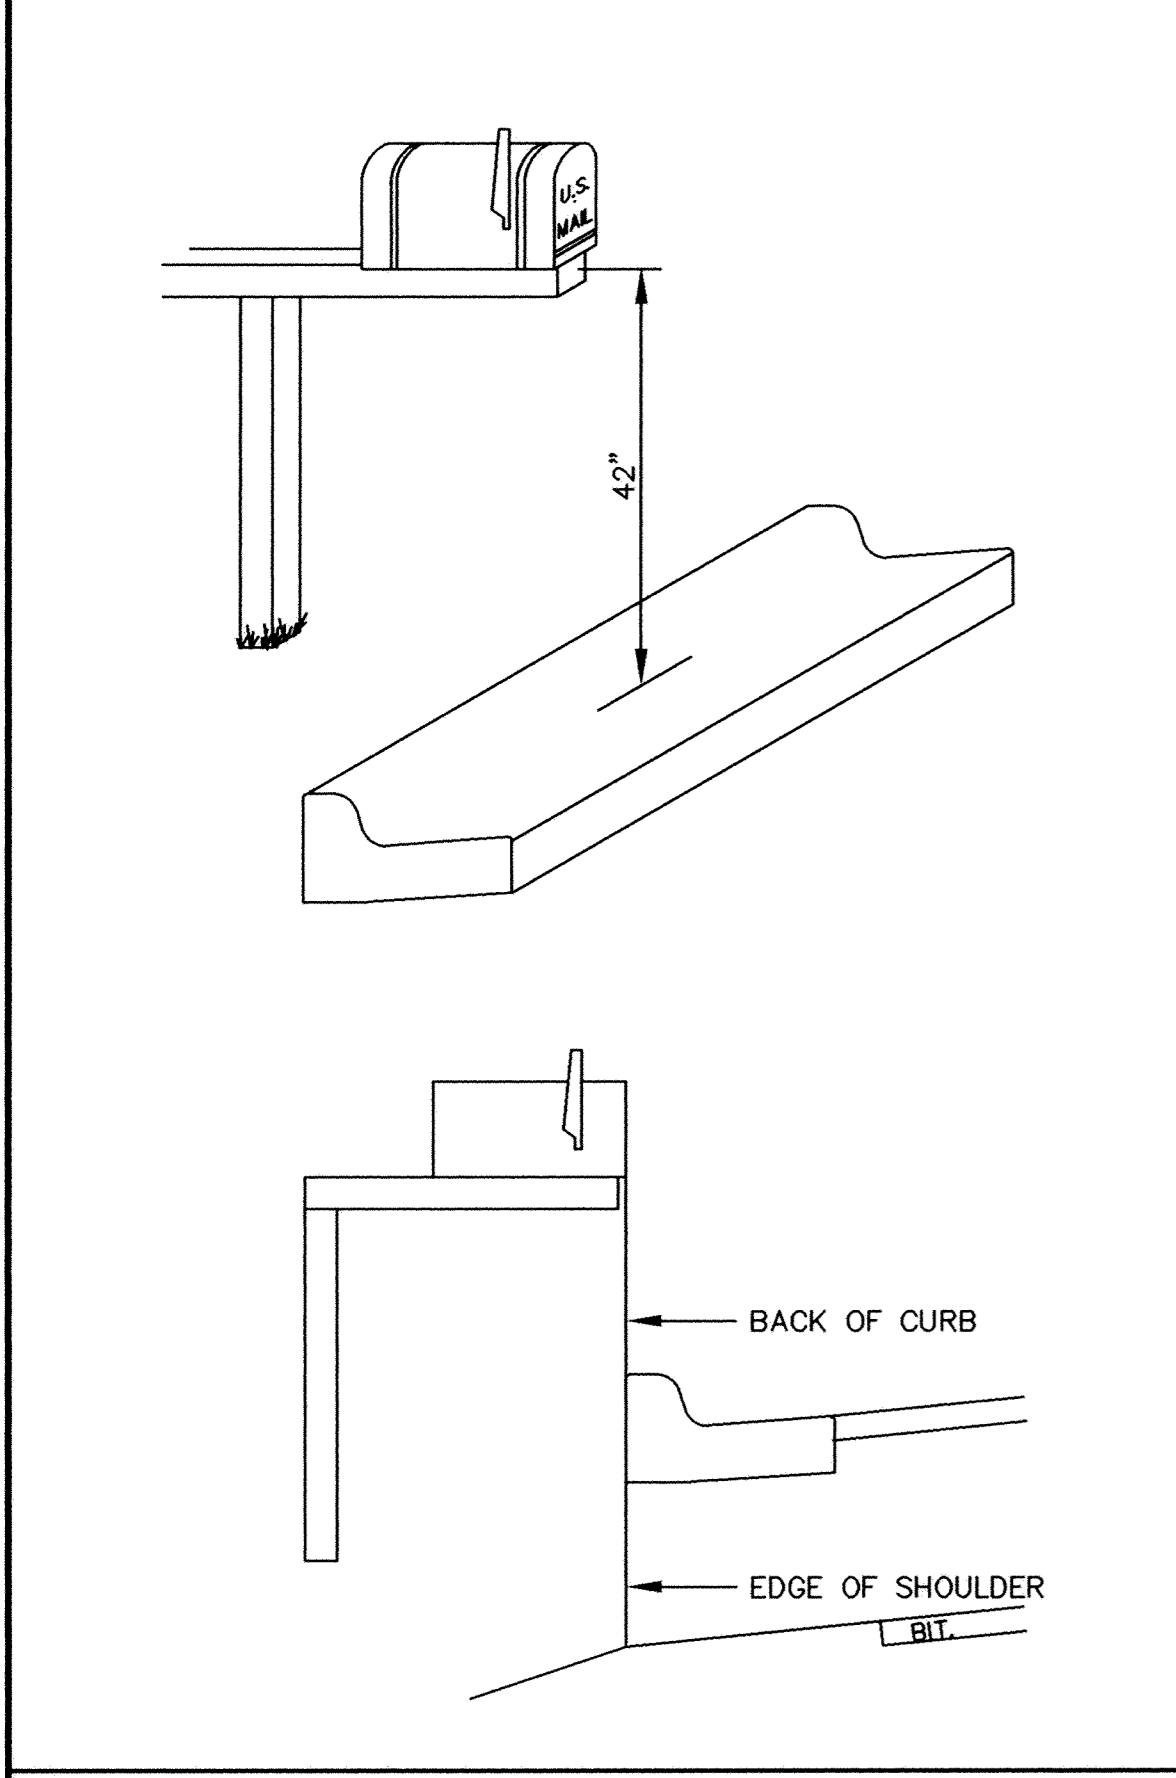

MAIL BOX

DESIGNED BY: JMA DRAWN BY: RKM
 APPROVED BY: TJM JOB NUMBER 807650
 CAD DATE: June 28, 2000 7:19:15 a.m.
 CAD FILE: 807650\807650-ST.DWG

I HEREBY CERTIFY THAT THIS PLAN, SPECIFICATION, OR REPORT WAS PREPARED BY ME OR UNDER MY DIRECT SUPERVISION AND THAT I AM A DULY REGISTERED PROFESSIONAL ENGINEER UNDER THE LAWS OF THE STATE OF MINNESOTA.

DATE: _____ REG. NO. 15316

NO.	DATE	BY	REVISION DESCRIPTION

1326 ENERGY PARK DRIVE
 ST. PAUL, MINNESOTA 55108
 (651) 644-4389

Howard R. Green Company
 CONSULTING ENGINEERS

CITY OF ELK RIVER
 WESTERN AREA PHASE IV
 STREET AND UTILITY IMPROVEMENTS

STREET CONSTRUCTION DETAILS
 S.A.P. 204-131-02, 204-126-03, S.P. 7102-99

SHEET NO.
14