

LIFT STATION COVER SLAB PLAN
Scale: 1/2" = 1'-0"

1/2" ASPHALT FIBER EXPANSION JOINT SEPARATION REQ'D

30"X48" ALUM. ACCESS COVER (TYPICAL)

12'X12' PRECAST CONCRETE COVER SLAB WITH COVERS CAST IN PLACE (SEE ELEC. PLANS FOR CONDUIT OPENINGS)

18" DIP SANITARY SEWER (SEE SHEET 14)

8'X8' PRECAST CONC. BOX CULVERT SECTIONS


12"X12"X12"X12" CROSS

12" DIP

NEENAH R-1755-E CASTING ABOVE

12" PVC FORCEMAIN (SEE SHEET 14)

VALVE VAULT

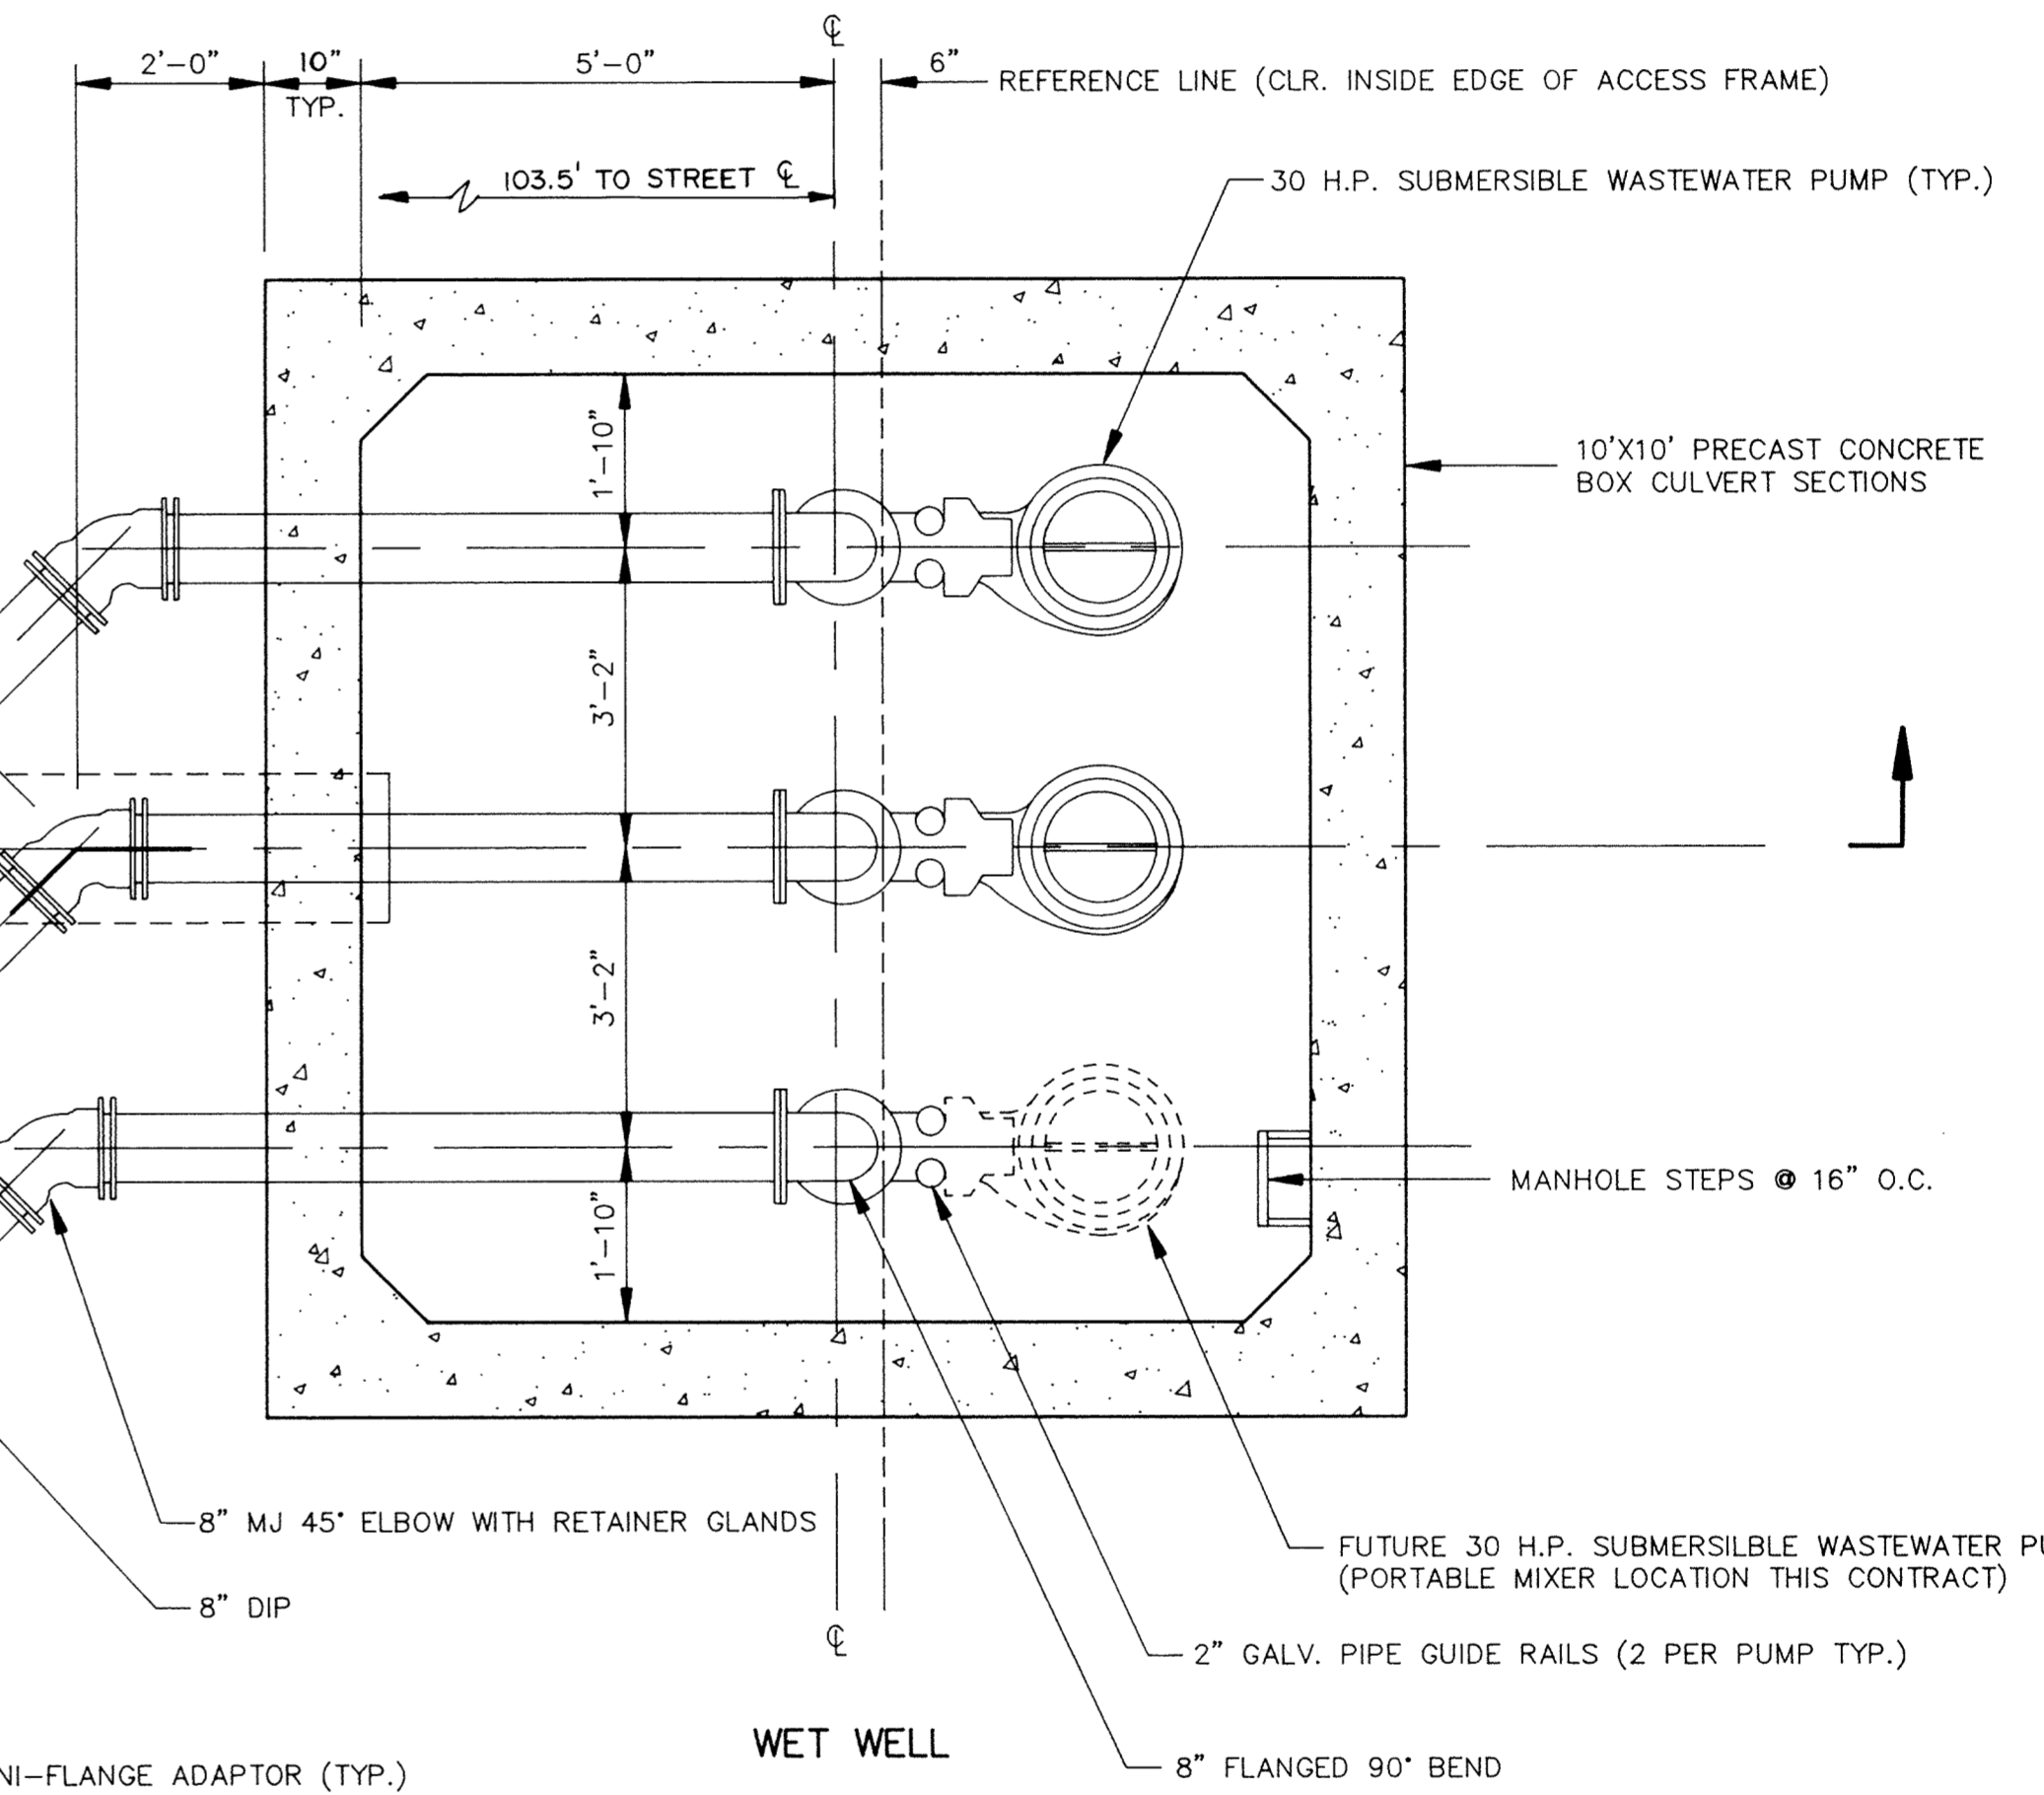

WET WELL

LIFT STATION PLAN
Scale: 1/2" = 1'-0"

NOTE: SEE SHEET 16 FOR SECTION

RECORD PLAN JAN. 1993

I HEREBY CERTIFY THAT THIS PLAN, SPECIFICATION, OR REPORT WAS PREPARED BY ME OR UNDER MY DIRECT SUPERVISION AND THAT I AM A DULY REGISTERED PROFESSIONAL ENGINEER UNDER THE LAWS OF THE STATE OF MINNESOTA
K.R. Rosell
DATE 3/19/92 REG NO 20389

MSA CONSULTING ENGINEERS
Maier Stewart & Associates Inc.
9800 SHELARD PARKWAY (612) 546-0432 MINNEAPOLIS, MINNESOTA 55441
1959 SLOAN PLACE (612) 774-6021 ST. PAUL, MINNESOTA 55117

DATE	DESCRIPTION	DESIGNED	GG
		CHECKED	PEB
		DRAWN	GG
REVISIONS		GRAPHIC SCALE	
		0	HORIZ 2
		0	VERT

CITY OF ELK RIVER			
S.A.P. 204-113-06			
WESTERN AREA SANITARY LIFT STATION			
PLAN VIEWS			
DATE	FEB. 1992	SHEET	15 OF 36 SHEETS
PROJECT NO.		230-431	