
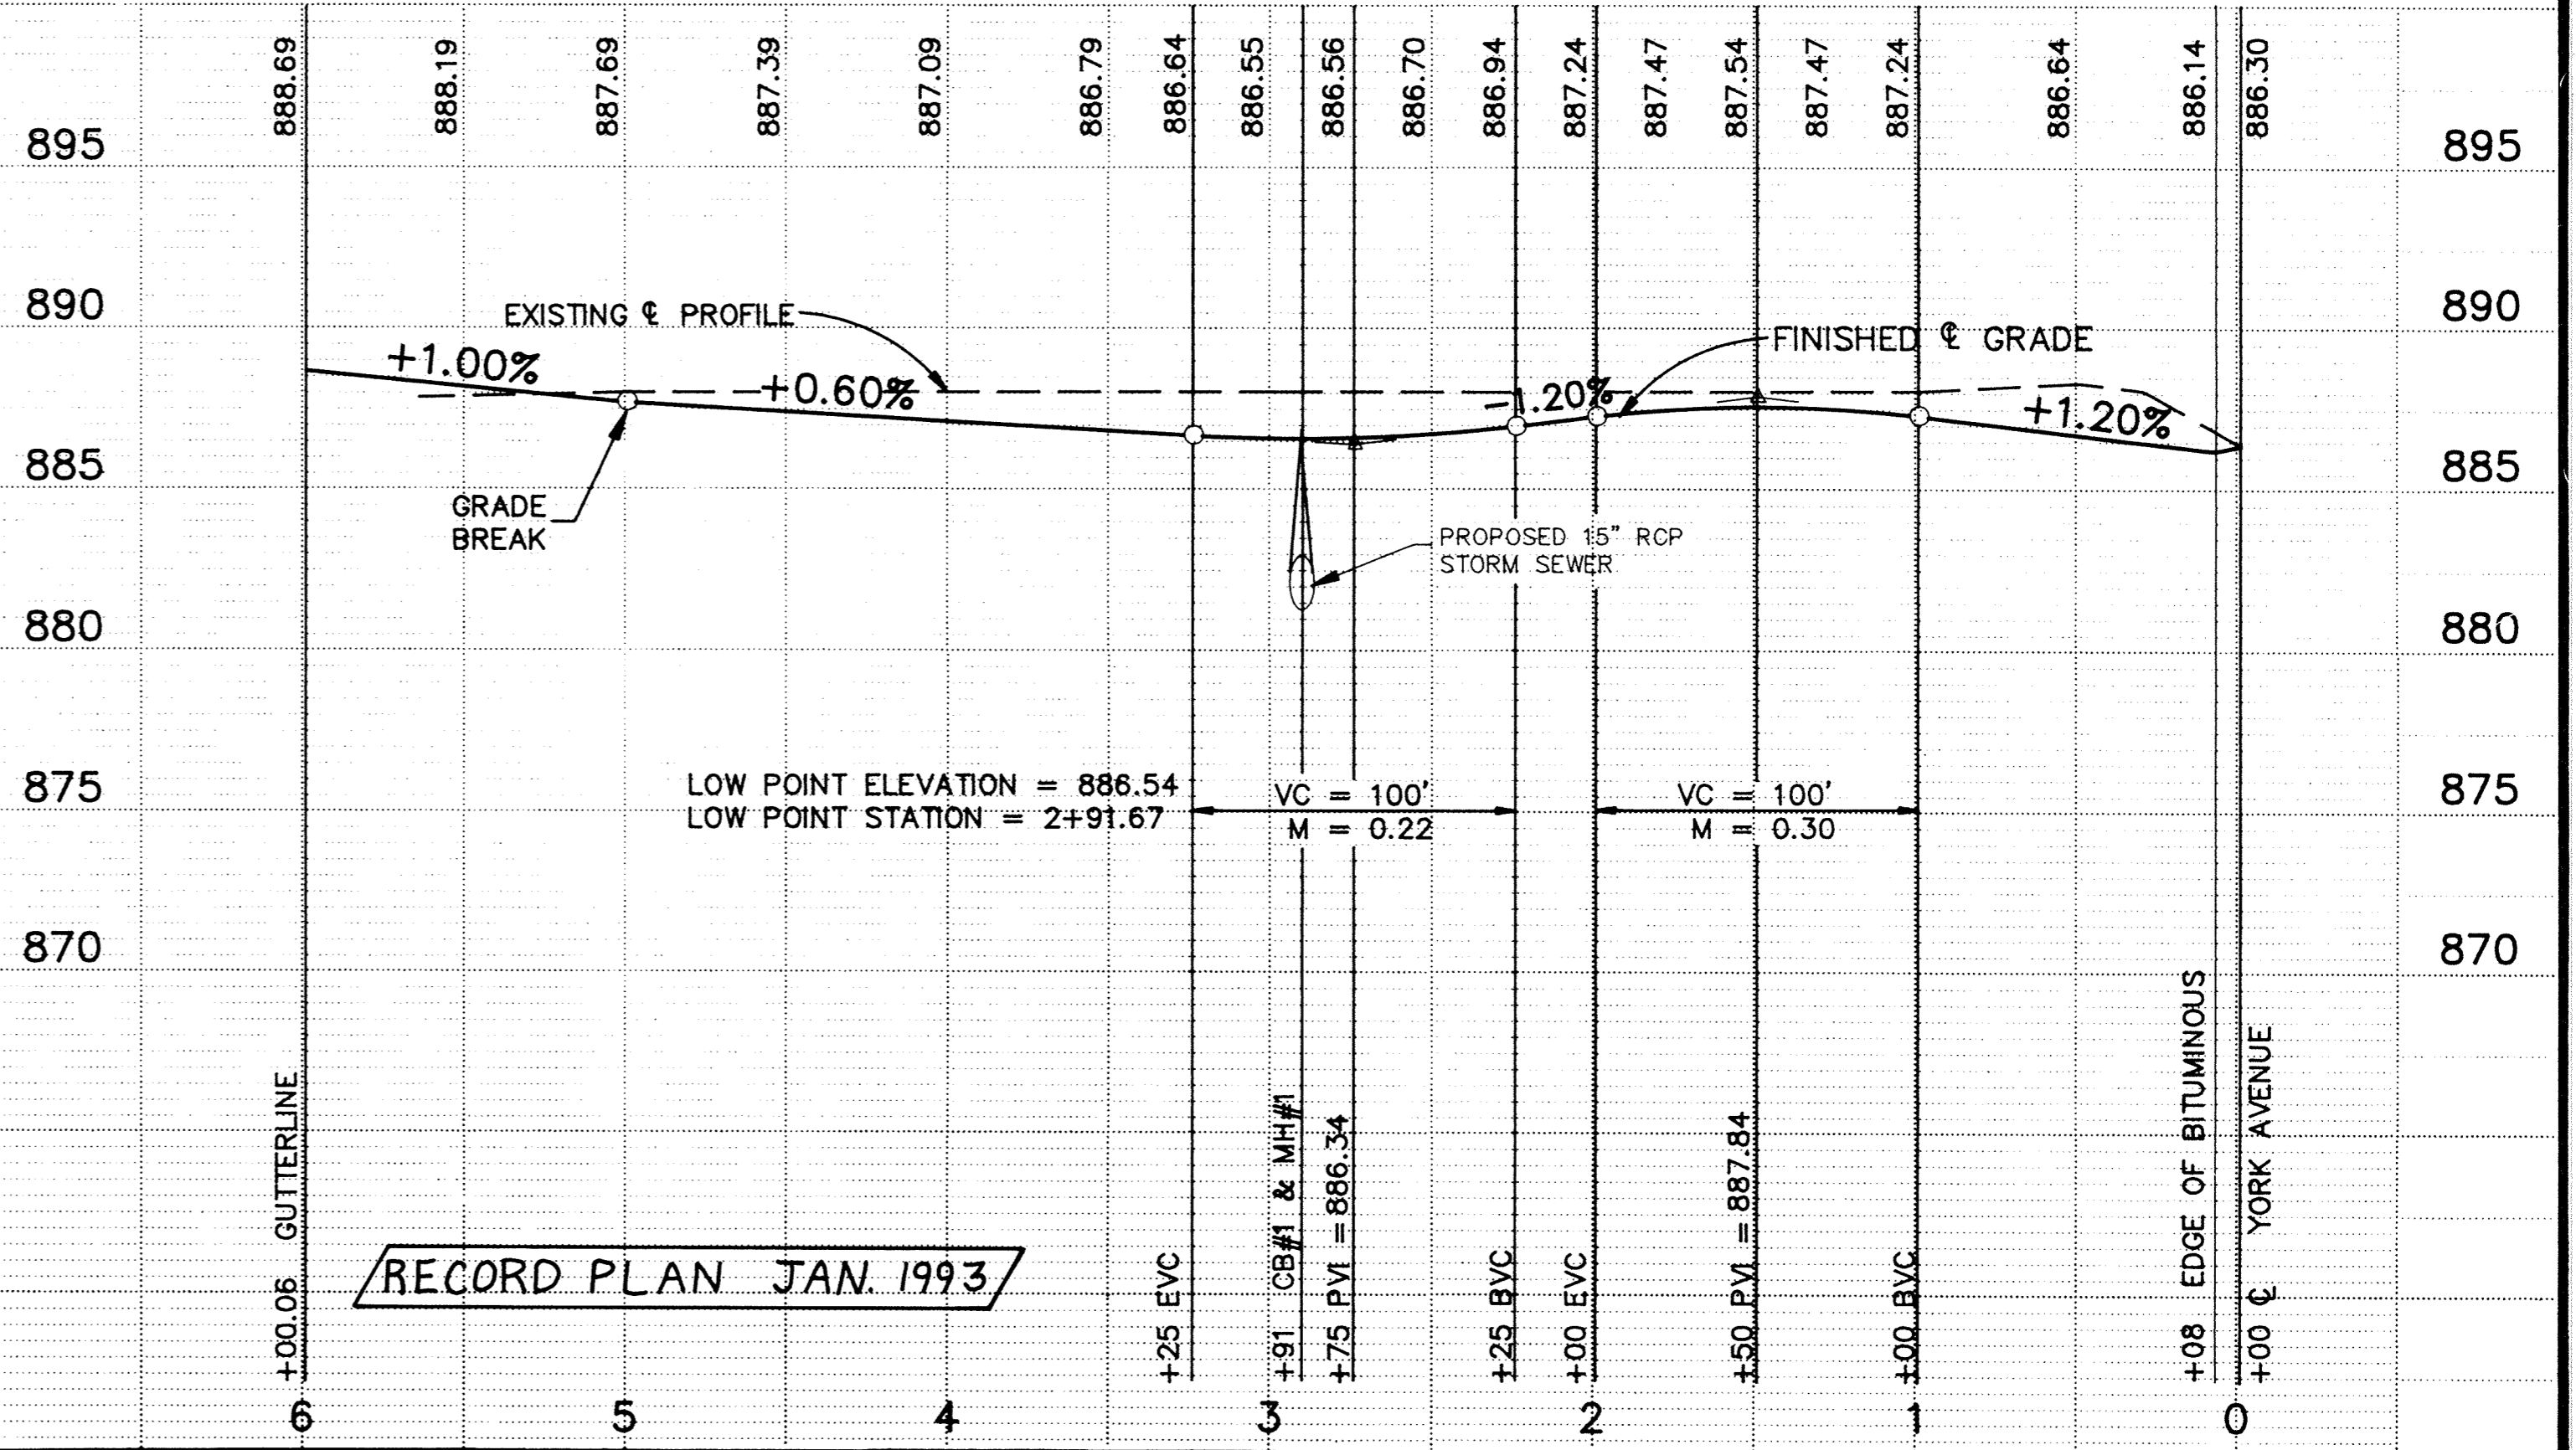
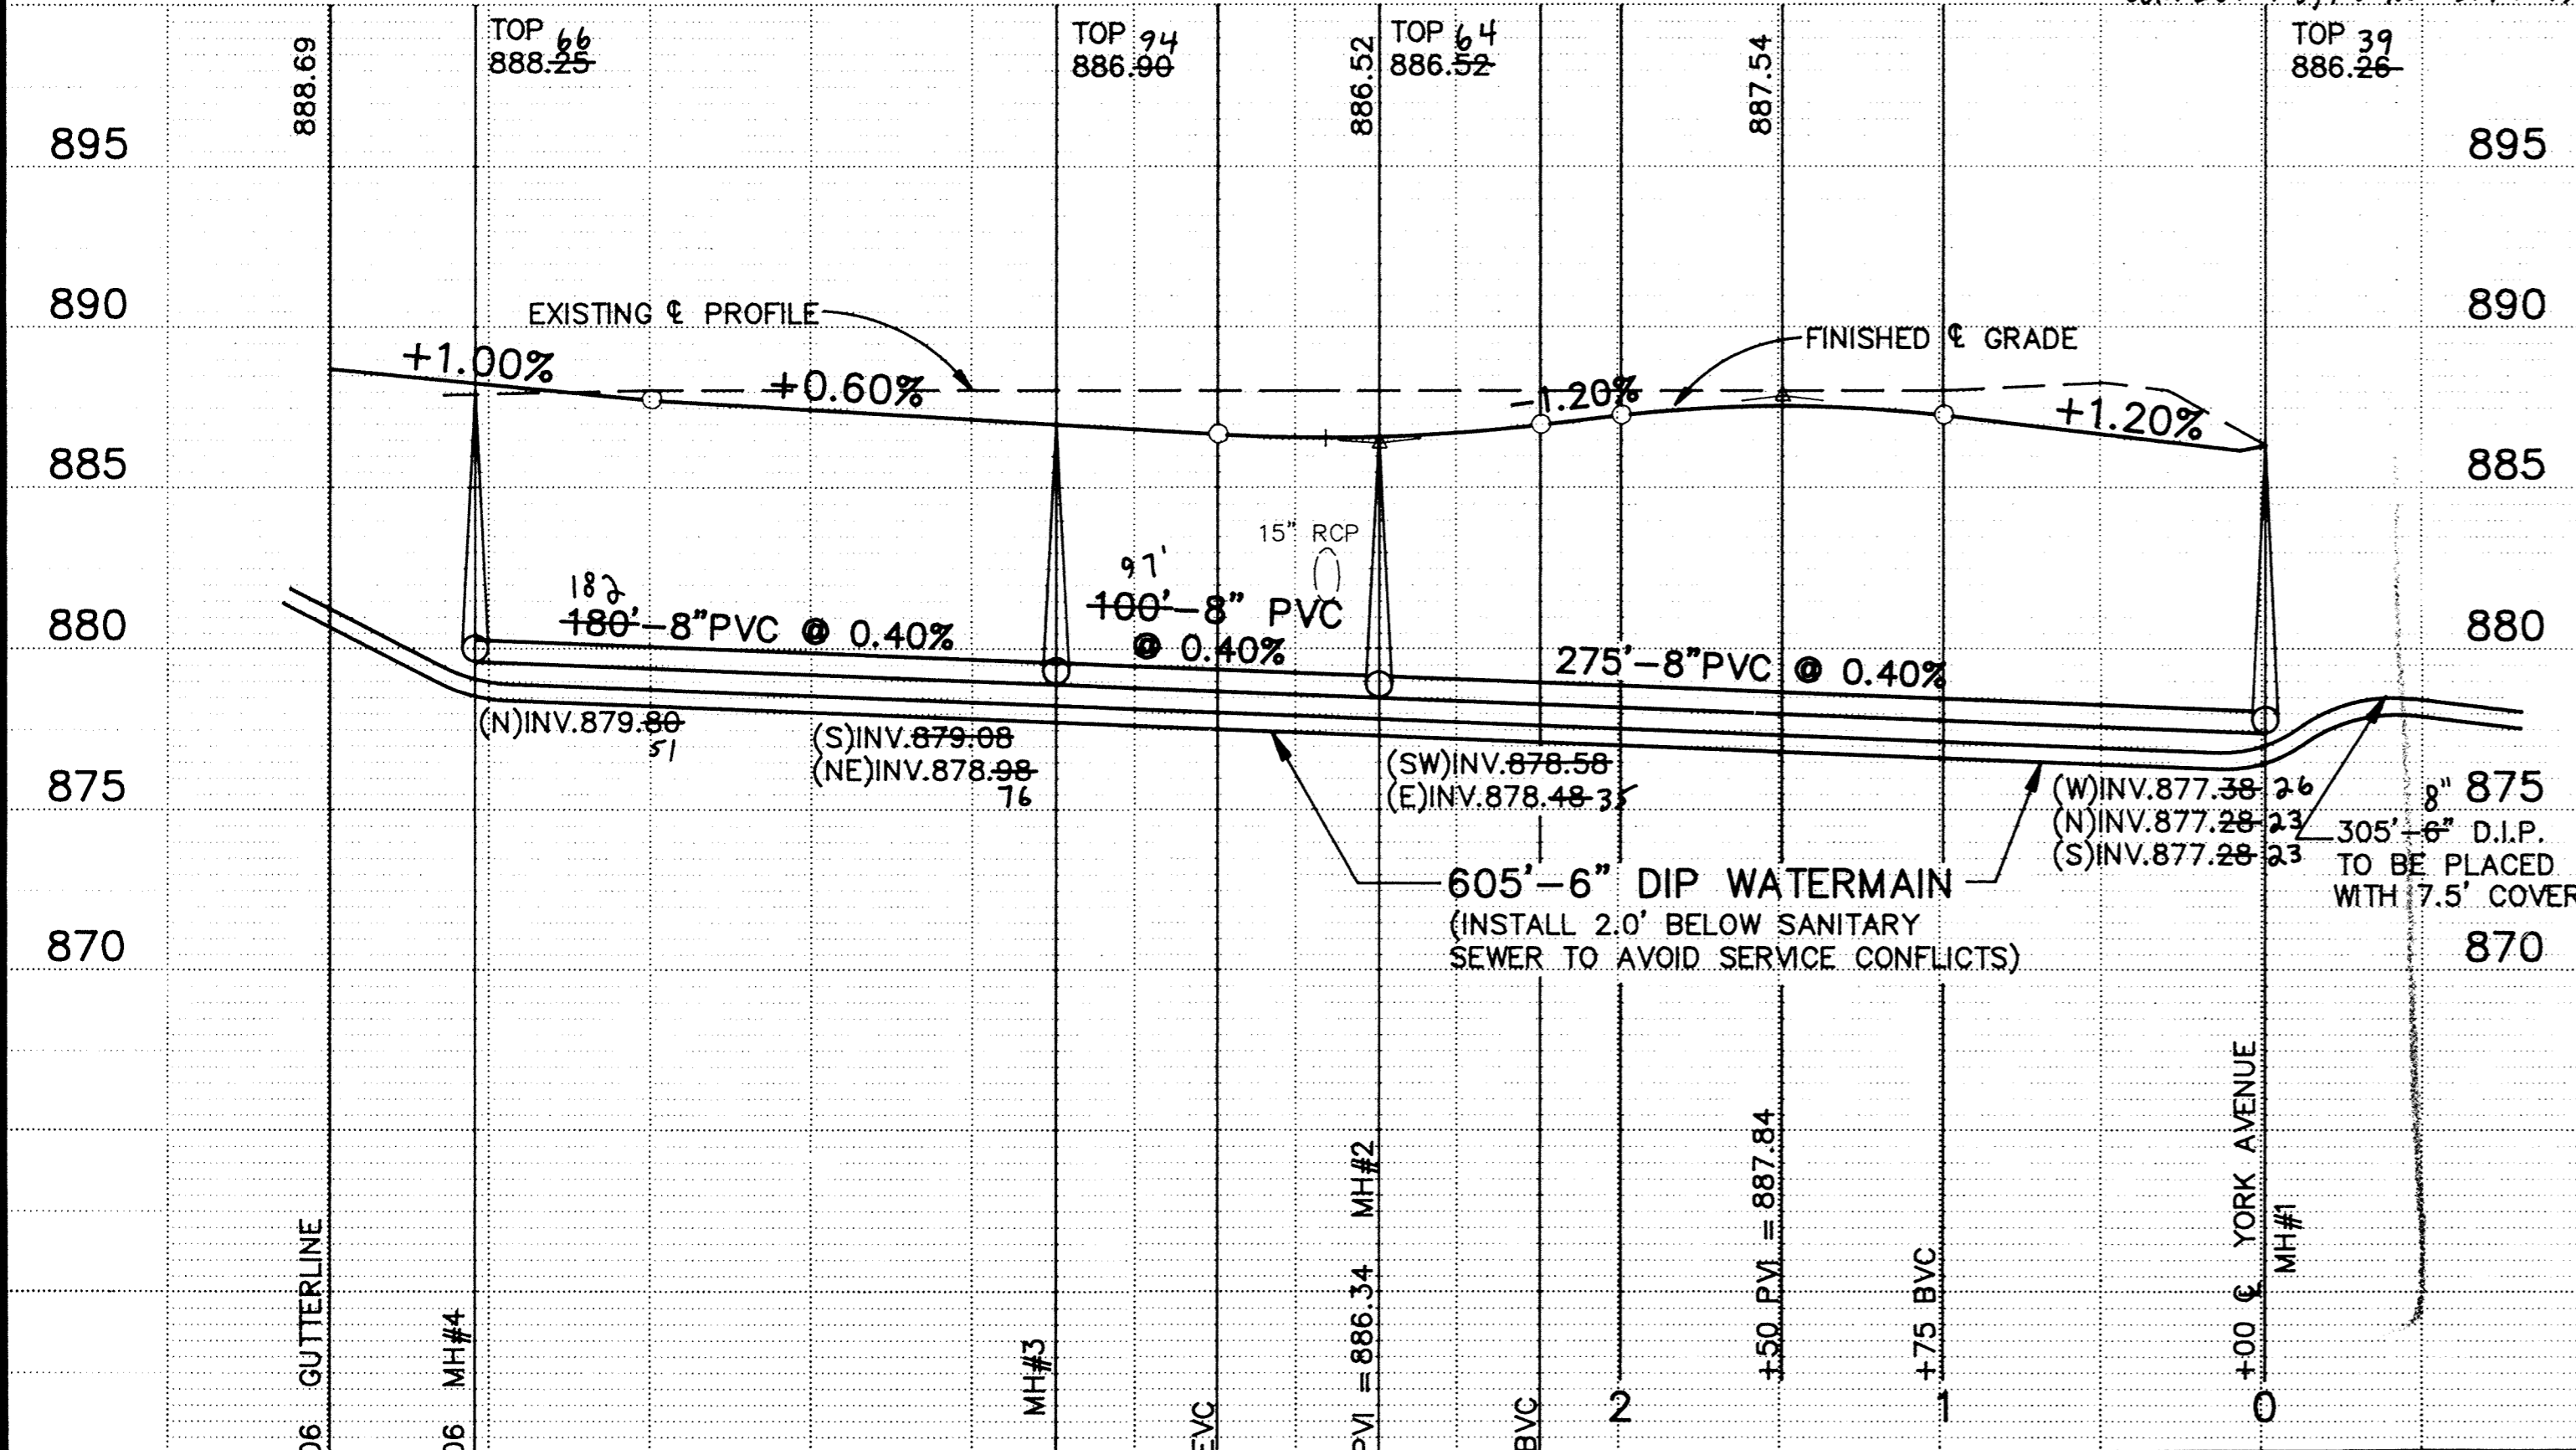
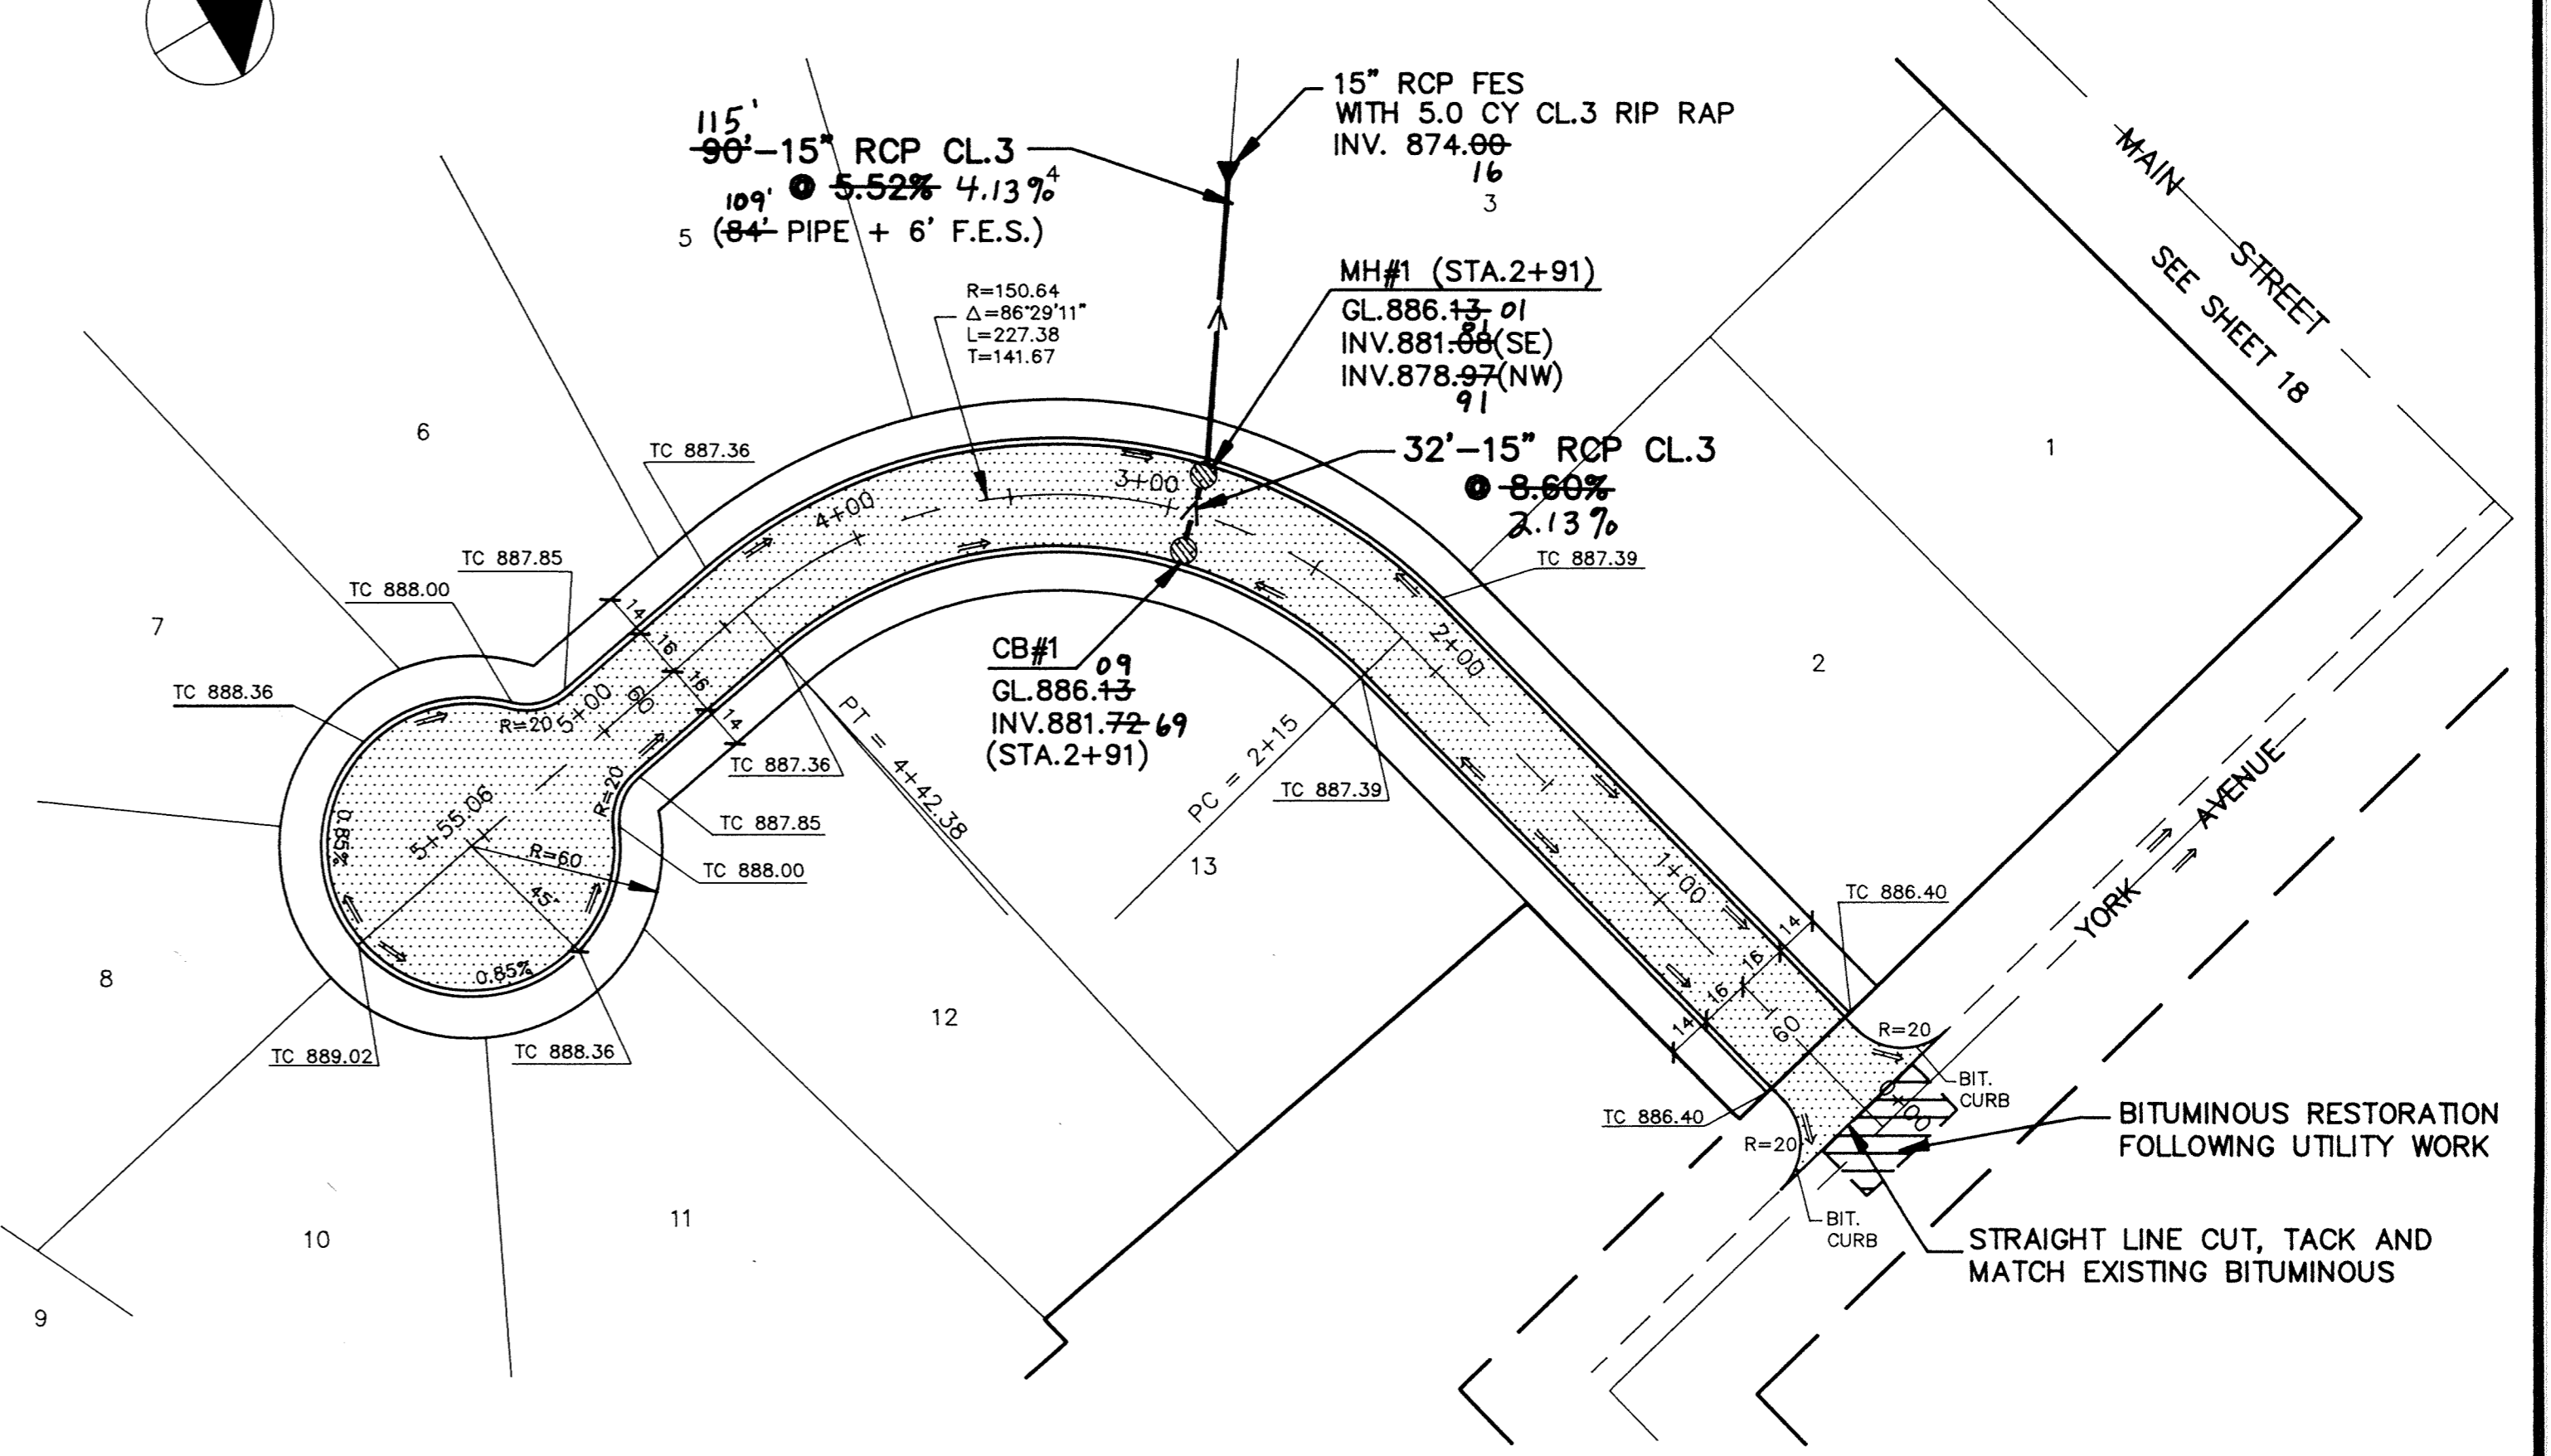


# 183RD COURT

# 183RD COURT

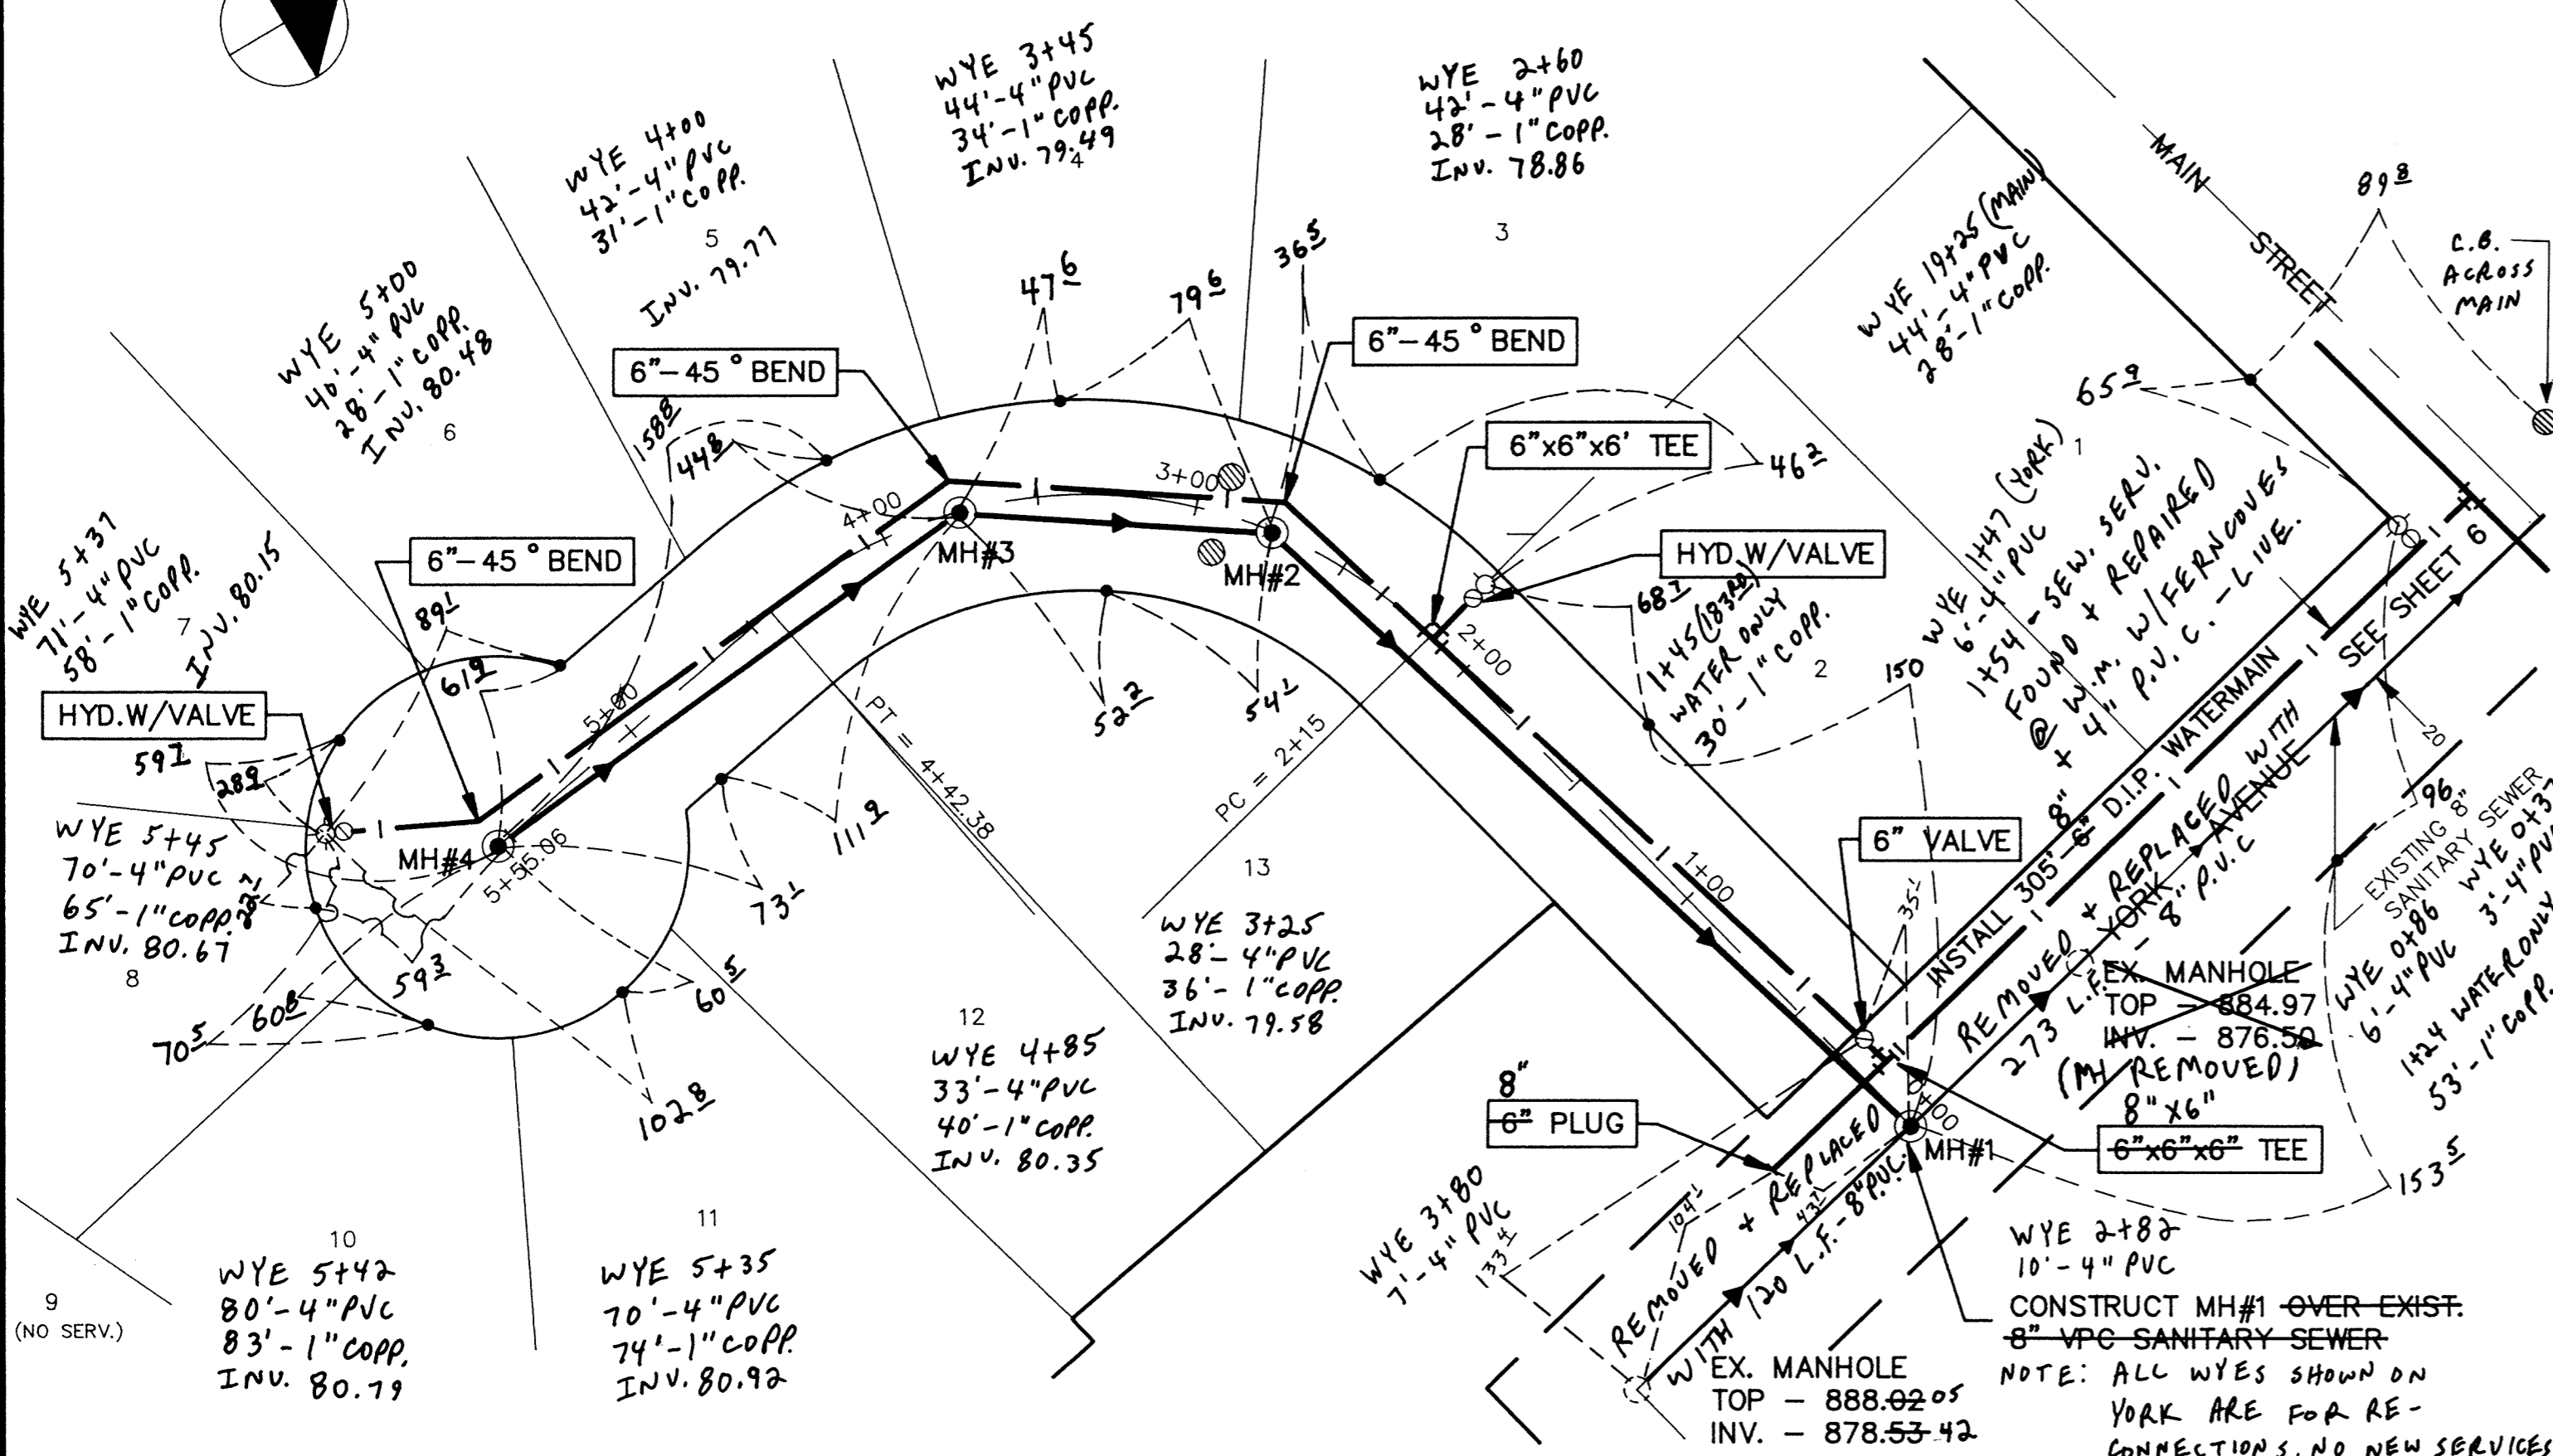

RECORD PLAN JAN. 1993

I HEREBY CERTIFY THAT THIS PLAN, SPECIFICATION, OR REPORT WAS PREPARED BY ME OR UNDER MY DIRECT SUPERVISION AND THAT I AM A DULY REGISTERED PROFESSIONAL ENGINEER UNDER THE LAWS OF THE STATE OF MINNESOTA.

*K.R. Russell*

DATE 3/19/92 REG. NO. 20389

**Maier Stewart & Associates Inc.**  
 CONSULTING ENGINEERS  
 9800 SHELARD PARKWAY (612) 546-0432 MINNEAPOLIS, MINNESOTA 55441  
 1959 SLOAN PLACE (612) 774-6021 ST. PAUL, MINNESOTA 55117

REVISIONS	DATE	DESCRIPTION	DESIGNED	BY	CHECKED	PER

**CITY OF ELK RIVER**  
 SANITARY SEWER AND WATERMAIN  
 STORM SEWER AND STREET CONSTRUCTION  
 183RD COURT

DATE SEPT. 1991 SHEET 22 OF 36 SHEETS PROJECT NO. 230-127-20