


SAICO PRODUCTS • NEW HAMBURG, MINNESOTA  
RECORDED BY PLAN NUMBER 6533  
REVISIONS BY PLAN NUMBER 6533  
SAICO PRODUCTS • NEW HAMBURG, MINNESOTA  
RECORDED BY PLAN NUMBER 6533  
REVISIONS BY PLAN NUMBER 6533

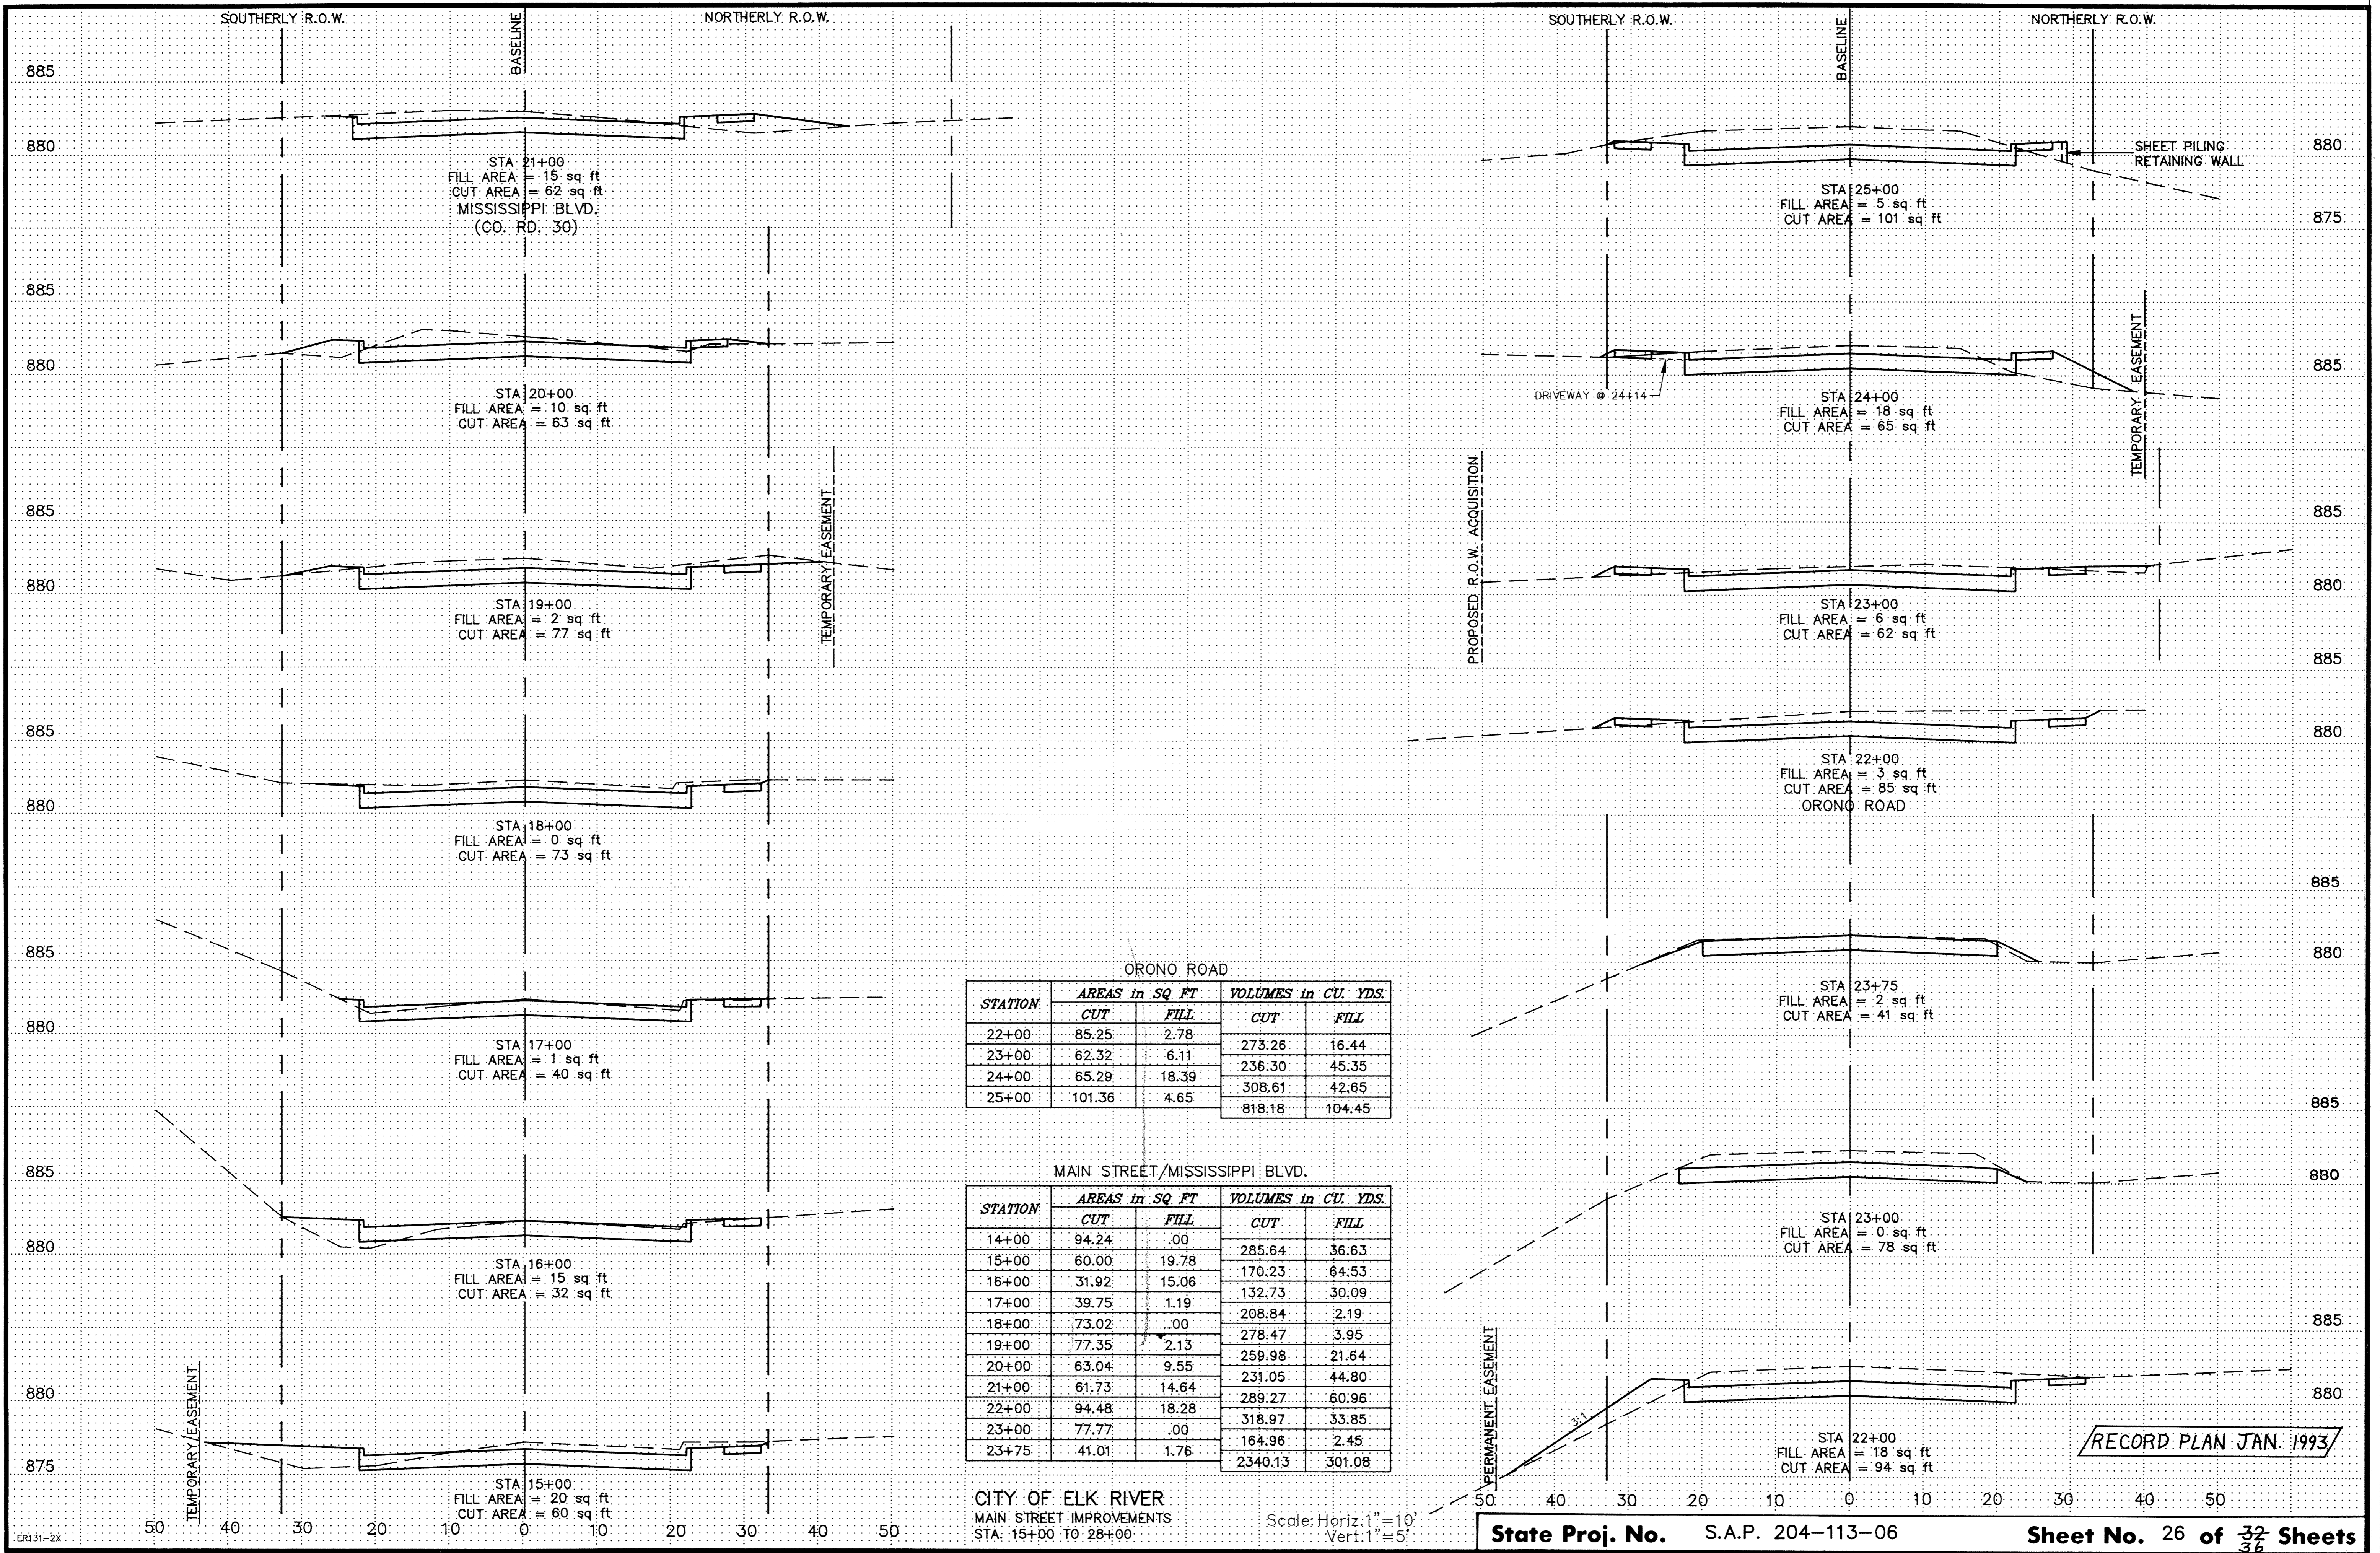

ORONO ROAD

STATION	AREAS in SQ FT		VOLUMES in CU. YDS.	
	CUT	FILL	CUT	FILL
22+00	85.25	2.78	273.26	16.44
23+00	62.32	6.11	236.30	45.35
24+00	65.29	18.39	308.61	42.65
25+00	101.36	4.65	818.18	104.45

MAIN STREET/MISSISSIPPI BLVD.

STATION	AREAS in SQ FT		VOLUMES in CU. YDS.	
	CUT	FILL	CUT	FILL
14+00	94.24	.00	285.64	36.63
15+00	60.00	19.78	170.23	64.53
16+00	31.92	15.06	132.73	30.09
17+00	39.75	1.19	208.84	2.19
18+00	73.02	.00	278.47	3.95
19+00	77.35	2.13	259.98	21.64
20+00	63.04	9.55	231.05	44.80
21+00	61.73	14.64	289.27	60.96
22+00	94.48	18.28	318.97	33.85
23+00	77.77	.00	164.96	2.45
23+75	41.01	1.76	2340.13	301.08

CITY OF ELK RIVER  
MAIN STREET IMPROVEMENTS  
STA. 15+00 TO 28+00

Scale: Horiz. 1"=10'  
Vert. 1"=5'

RECORD PLAN JAN. 1993

PLATE 3 Full Cross Section DOTTED blueprint Order Form # MNB Plate 3DV  
Eri31-2x