



S&CO PRODUCTS • NEW MOORE MANAGERIA  
RENDERED BY PLAN NUMBER 8533  
S&CO PRODUCTS • NEW MOORE MANAGERIA  
RENDERED BY PLAN NUMBER 8533  
S&CO PRODUCTS • NEW MOORE MANAGERIA  
RENDERED BY PLAN NUMBER 8533

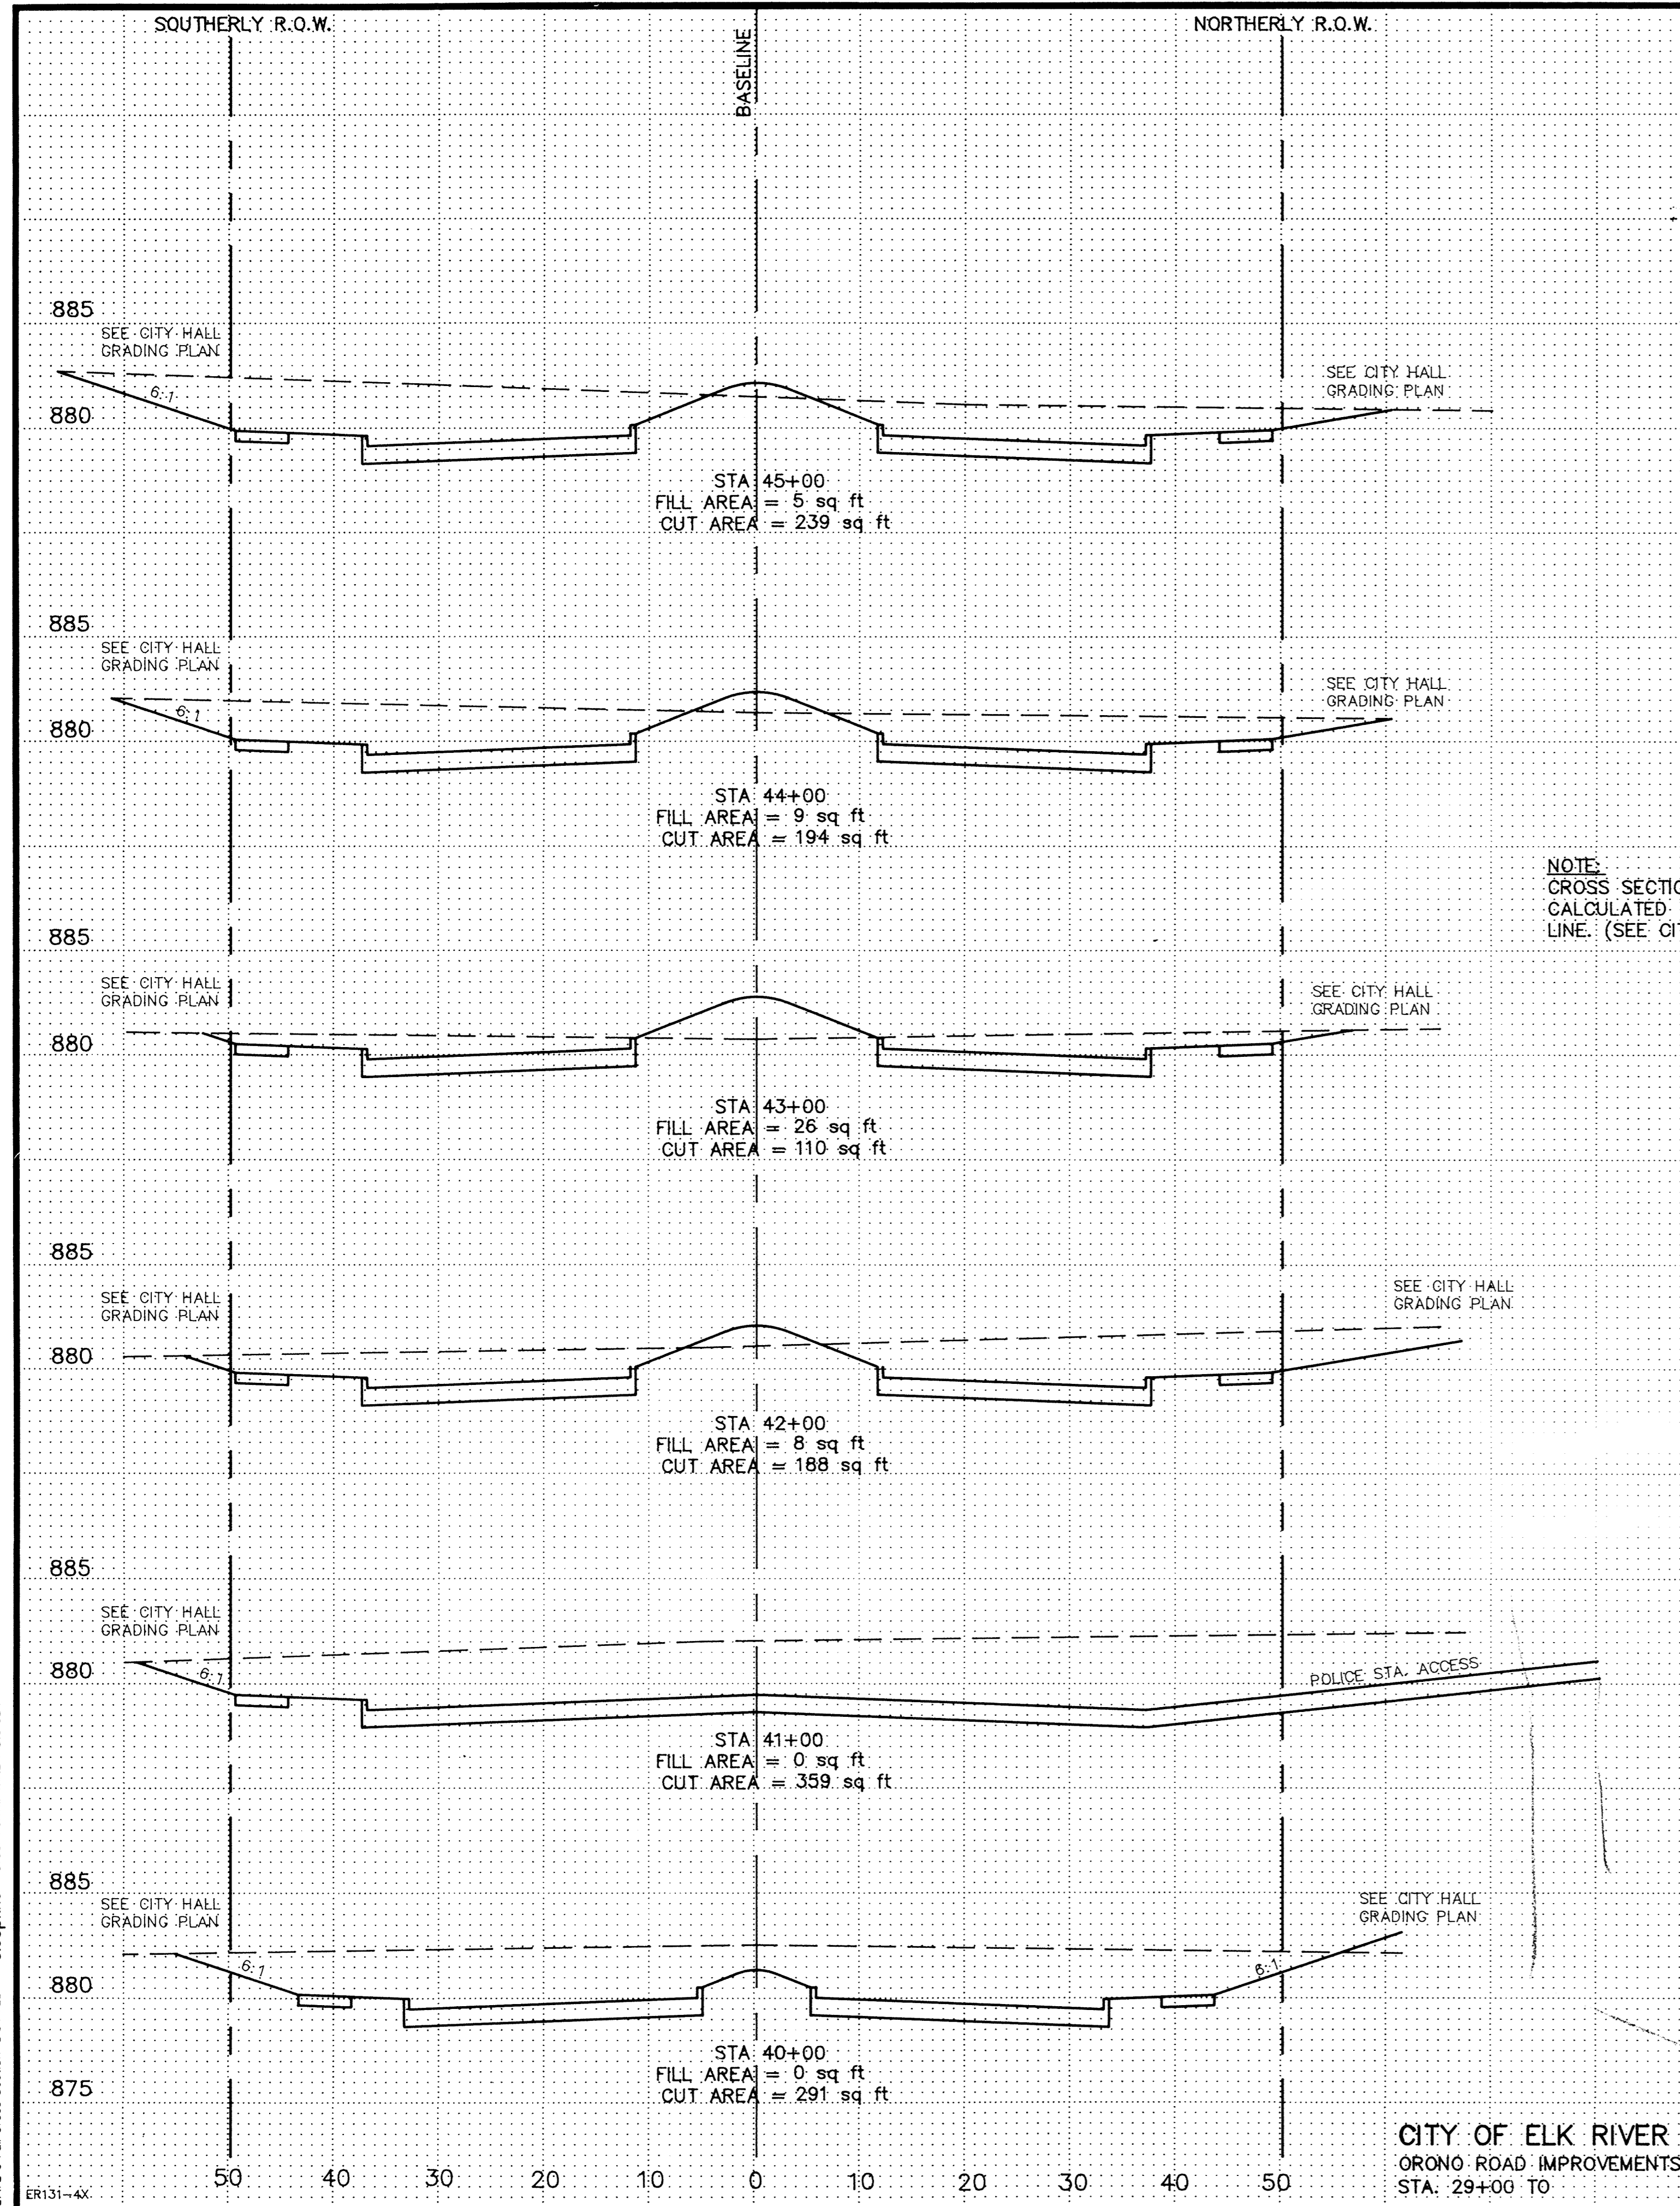

NOTE:  
CROSS SECTION QUANTITIES ARE  
CALCULATED TO NORTHERLY R.O.W.  
LINE. (SEE CITY HALL GRADING PLAN)

STATION	AREAS in SQ FT		VOLUMES in CU. YDS.	
	CUT	FILL	CUT	FILL
39+00	239.96	.00	983.96	.00
40+00	291.38	.00	1205.06	.00
41+00	359.35	.00	1014.32	15.05
42+00	188.38	8.13	552.26	62.89
43+00	109.84	25.83	562.71	65.14
44+00	194.03	9.34	802.25	27.35
45+00	239.19	5.43	825.79	26.96
46+00	206.74	9.14	641.24	48.74
47+00	139.53	17.19	545.62	74.79
48+00	155.11	23.20	7133.22	320.93

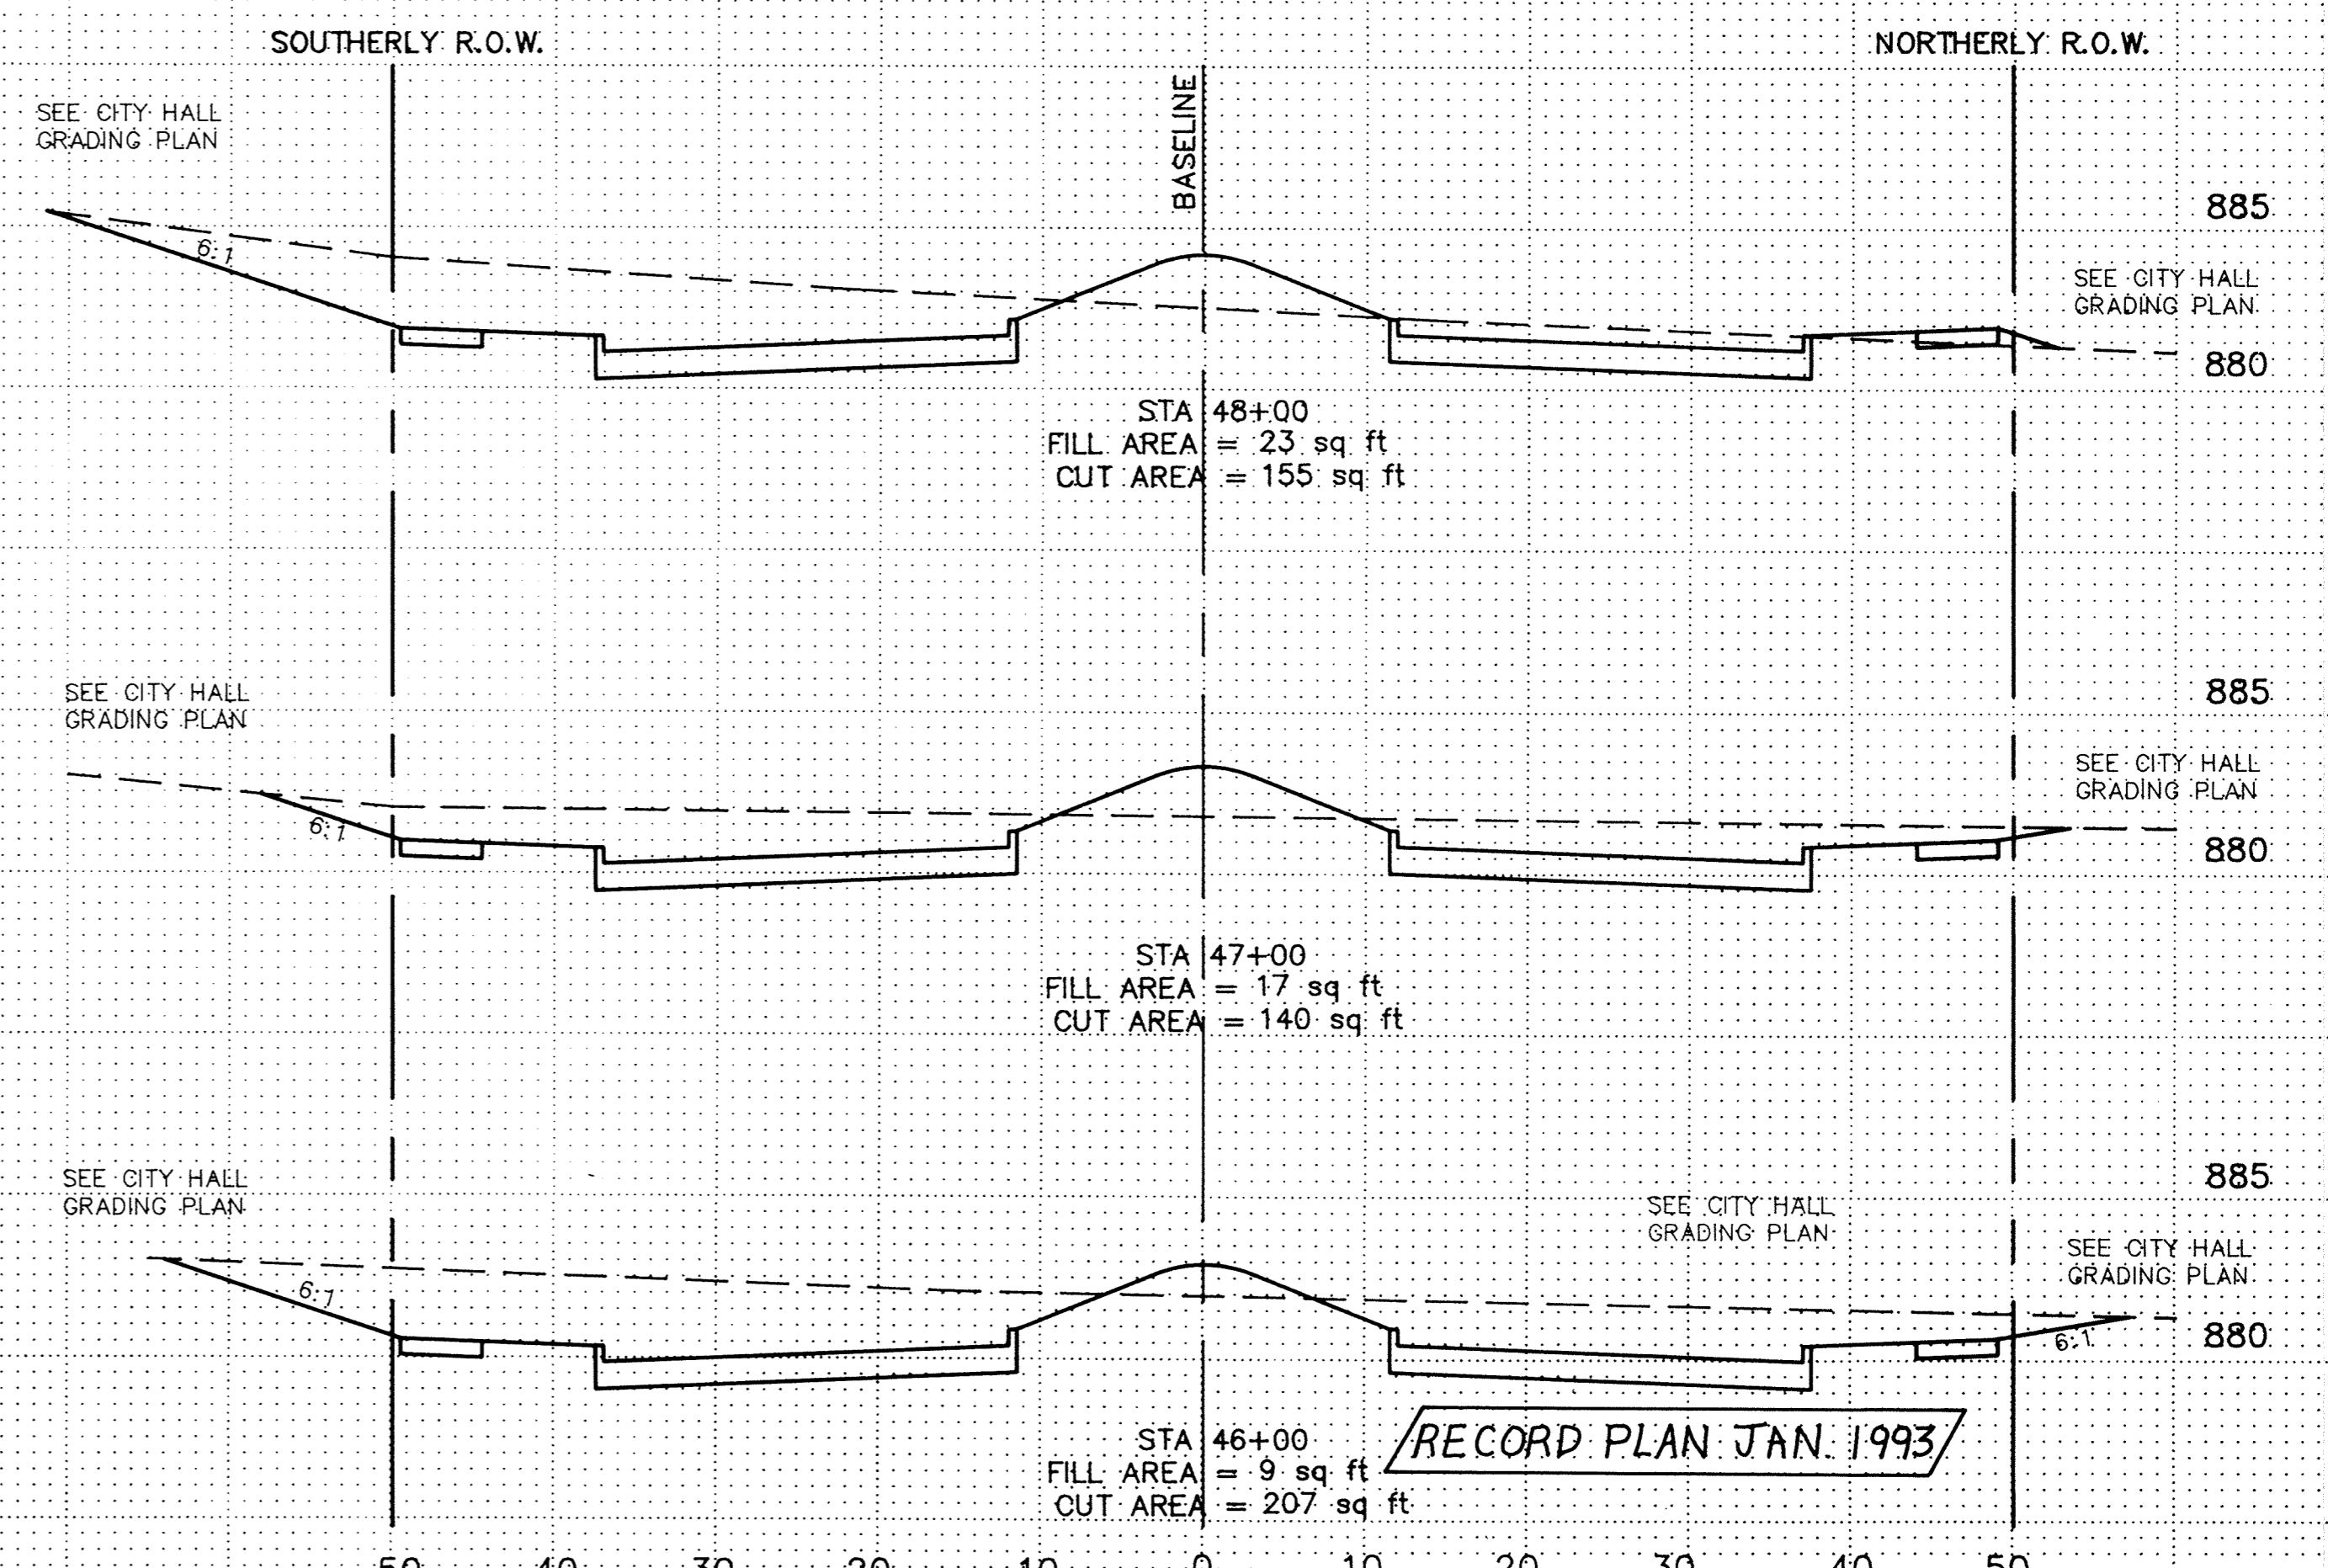

RECORD PLAN JAN. 1993

CITY OF ELK RIVER  
ORONO ROAD IMPROVEMENTS  
STA. 29+00 TO

Scale: Horiz. 1" = 10'  
Vert. 1" = 5'

State Proj. No. S.A.P. 204-113-06

Sheet No. 28 of 36 Sheets

980

blueprint  
Order Form # MNB Plate 30V  
ER131-4X