
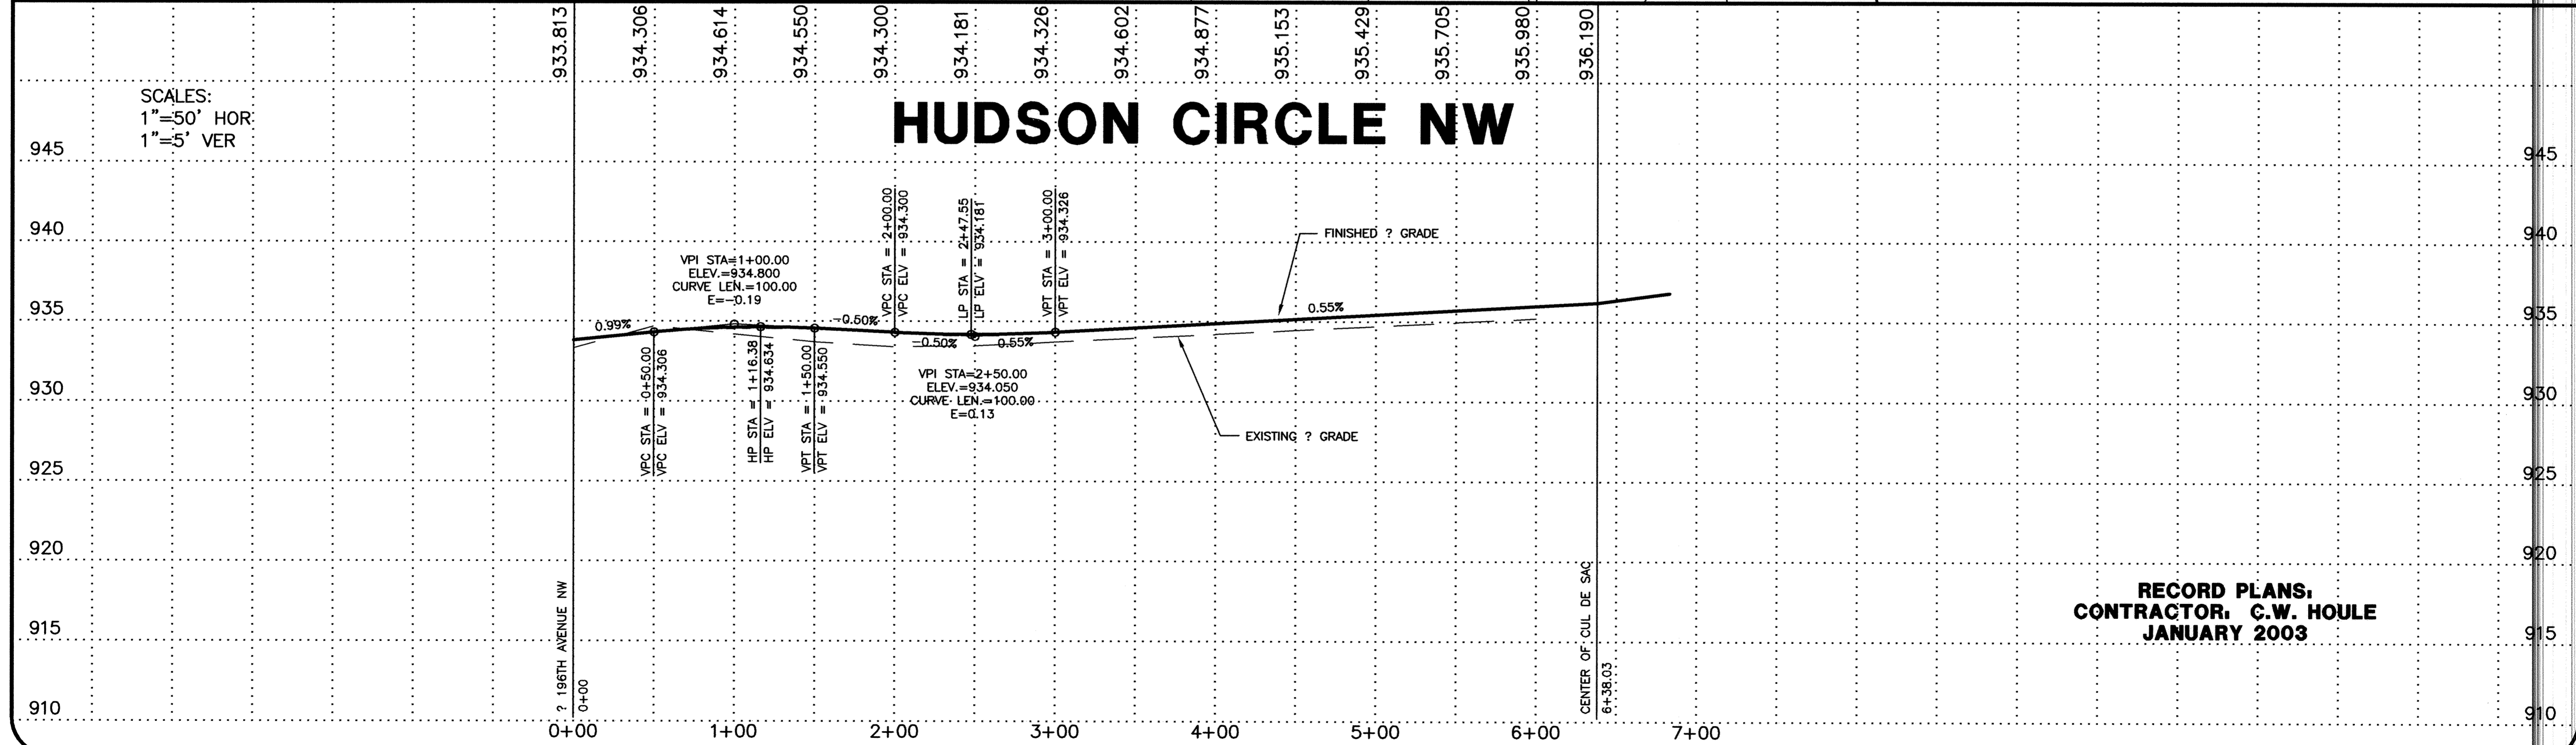


- NOTES**
- FIVE FOOT TRANSITION FROM B-6 CURB TO SURMOUNTABLE CURB IS REQUIRED PER ELK RIVER SPECIFICATIONS.
  - STREET ADJUSTMENT RINGS TO BE USED FOR WEAR COURSE PAVEMENT MANHOLES.

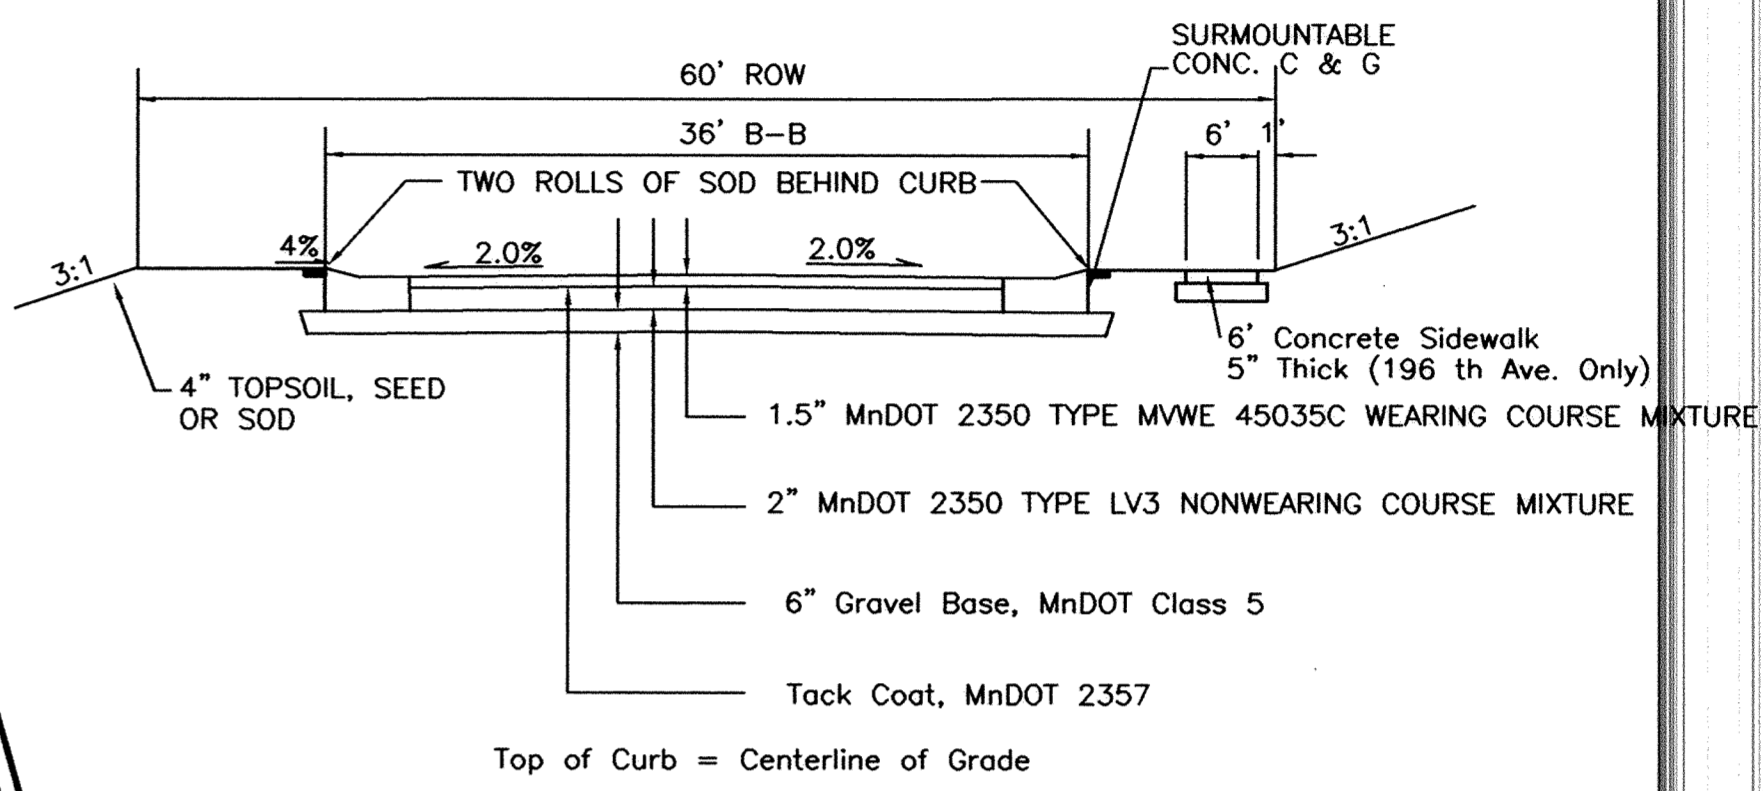

**RECORD PLANS,  
 CONTRACTOR: C.W. HOULE  
 JANUARY 2003**

DATE	BY	REVISIONS	REVISION
4/25/02	DRL	CITY COMMENTS	
5/06/02	DRL	CITY COMMENTS	
1-2003	KEJ	RECORD DRAWING	HOWARD GREEN

I HEREBY CERTIFY THAT THIS PLAN, SPECIFICATION, OR REPORT WAS PREPARED BY ME OR UNDER MY DIRECT SUPERVISION AND THAT I AM A DULY LICENSED PROFESSIONAL ENGINEER UNDER THE LAWS OF THE STATE OF MINNESOTA.

*Kenneth Adolf*  
 KENNETH ADOLF

DATE: 03-25-02 REG. NO. 12048

REVIEWED BY: \_\_\_\_\_ DATE: \_\_\_\_\_

P:\ENR6\1846\056\11600\ACPO1003.DWG, 03/07/03 09:55:21 AM, SherryM, 11

**SCHOELL & MADSON, INC.**  
 ENGINEERS \* SURVEYORS \* PLANNING  
 SOIL TESTING \* ENVIRONMENTAL SERVICES  
 10580 WAYZATA BOULEVARD, SUITE 1  
 MINNETONKA, MN 55305  
 (952) 546-7601 FAX: (952) 546-9065  
 www.schoellmadson.com

OWNER/DEVELOPER  
**WINDSOR DEVELOPMENT**  
 9145 EDINBURGH LANE  
 WOODBURY, MN 55125  
 DATE: MARCH, 2002

PROJECT NAME/SHEET TITLE  
**WINDSOR OAK HILL 2ND ADDITION**  
 ELK RIVER, MN  
**STREET CONSTRUCTION**

S.M.I. PROJECT NO. 61846-056 SHEET 4 OF 13 SHEETS

DRAWING NUMBER  
 WINDS2.02  
 DRAWING NUMBER  
 WINDS2.02  
 DRAWING NUMBER  
 WINDS2.02  
 SAFCO PRODUCTS • NEW HOPE, MINNESOTA  
 REVISION BY PART NUMBER 0528  
 SAFCO PRODUCTS • NEW HOPE, MINNESOTA  
 REVISION BY PART NUMBER 0528  
 SAFCO PRODUCTS • NEW HOPE, MINNESOTA  
 REVISION BY PART NUMBER 0528