
WINDSOR OAK HILL 2ND ADDITION

PREPARED FOR: WINDSOR DEVELOPMENT CITY OF ELK RIVER, MINNESOTA

SANITARY SEWER, WATERMAIN, STORM DRAINAGE & STREET PAVING

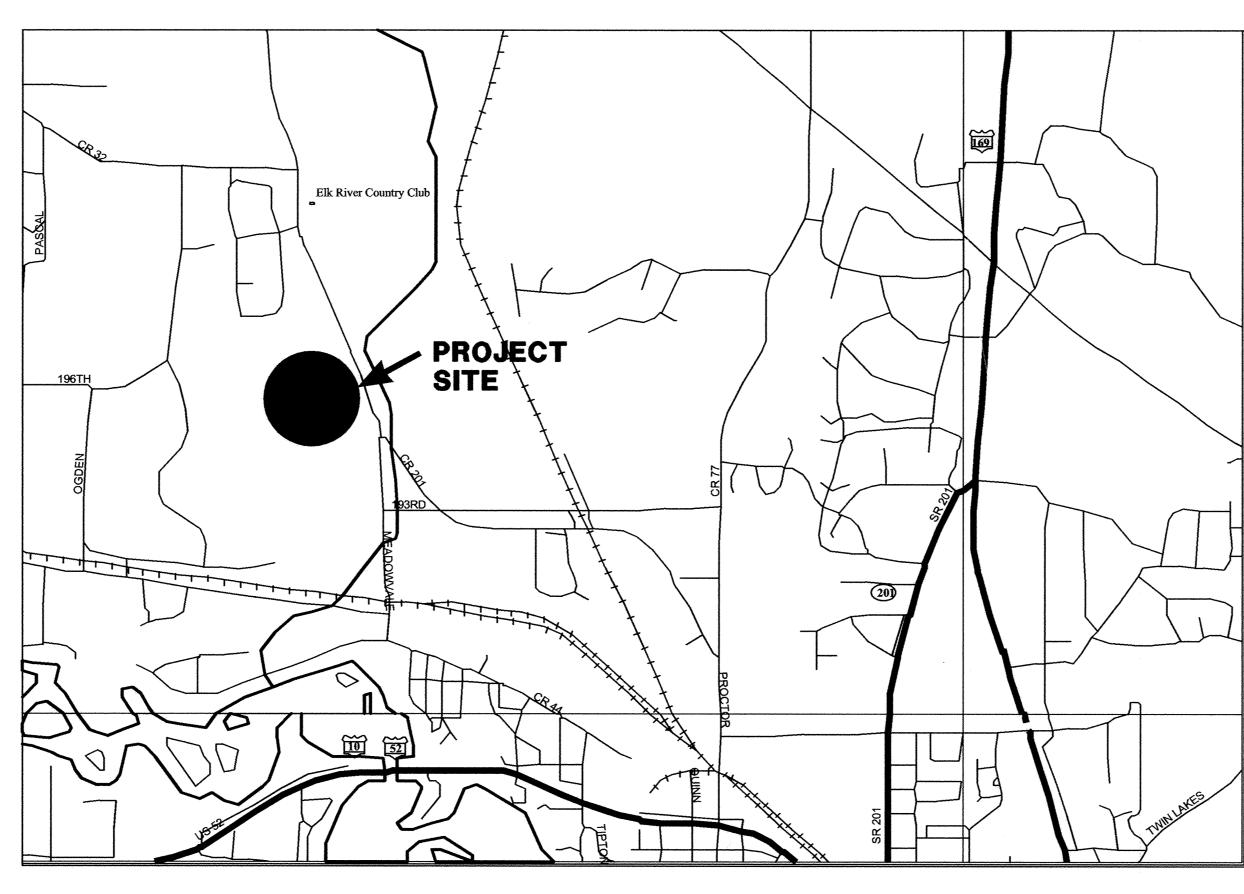

LOCATION MAP NO SCALE

SCHOELL & MADSON, INC.

ENGINEERS * SURVEYORS * PLANNERS SOIL TESTING * ENVIRONMENTAL SERVICES 10580 WAYZATA BOULEVARD MINNETONKA, MINNESOTA 55305 SHEET INDEX

DESCRIPTION

COVER INDEX SHEET STORM SEWER CONSTRUCTION STORM SEWER CONSTRUCTION

DETAILS

RECORD PLANS CONTRACTOR: C.W. HOULE JANUARY 2003

I HEREBY CERTIFY THAT THIS PLAN WAS PREPARED BY ME OR UNDER MY DIRECT SUPERVISION AND THAT I AM A DULY REGISTERED PROFESSIONAL ENGINEER UNDER THE LAWS OF THE STATE OF MINNESOTA.

Kenneth alof

DATE ___03/25/02 REG. NO. 12048

DRL CITY COMMENT

S.M.I. PROJECT NO. 61846-056 SHEET 1 OF 13 SHEETS

THE CONTRACTOR SHALL CONTACT ALL PUBLIC UTILITIES FOR LOCATION OF ALL UNDERGROUND WIRES, CABLES, CONDUITS, PIPES, MANHOLE, VALVES OR OTHER BURIED STRUCTURES BEFORE DIGGING THE CONTRACTOR SHALL REPAIR OR REPLACE THE ABOVE WHEN

DAMAGED DURING CONSTRUCTION AT NO COST TO THE OWNER.

F:\ENG\61846\056\1600\COVER.DWG. 03/07/03 09:38:51 AM. SherryN