


BENCHMARK:
TOP OF IRON PIPE AS SHOWN
ELEVATION = 922.75 FT. (NGVD-1929)

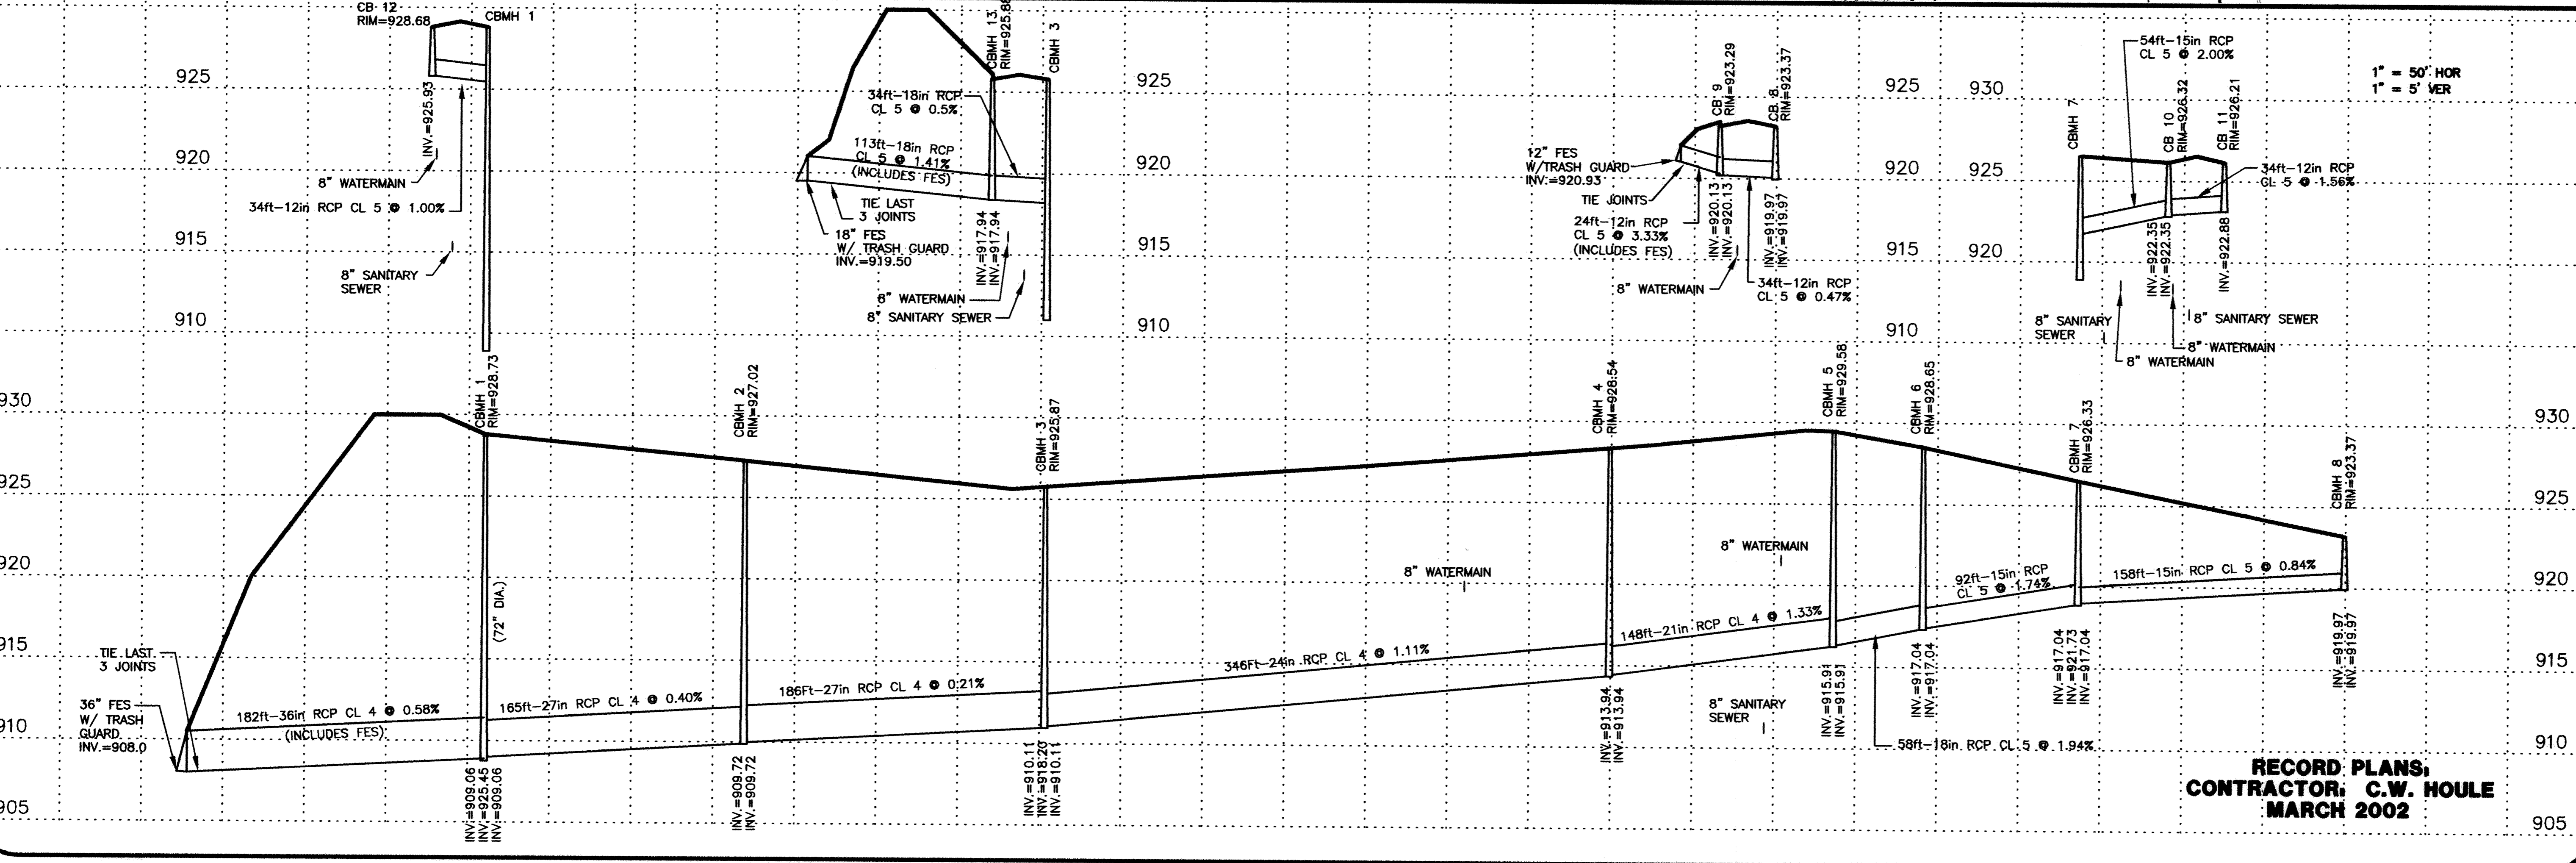

**RECORD PLANS,
CONTRACTOR: C.W. HOULE
MARCH 2002**

DATE	BY	REVISIONS	REVISION
3-9-01	DS	CITY COMMENTS	
3-22-01	DS	PIPE SIZES CBMH 7	
3-2002	SJM	RECORD DRAWING	

HEREBY CERTIFY THAT THIS PLAN, SPECIFICATION, OR REPORT WAS PREPARED BY ME OR UNDER MY DIRECT SUPERVISION AND THAT I AM A DULY LICENSED PROFESSIONAL ENGINEER UNDER THE LAWS OF THE STATE OF MINNESOTA.

Kenneth Adolf
Kenneth Adolf
DATE: 01-29-01 REG. NO. 12048
REVIEWED BY: _____ DATE: _____

SCHOELL & MADSON, INC.
ENGINEERS * SURVEYORS * PLANNING
SOIL TESTING * ENVIRONMENTAL SERVICES
10580 WAYZATA BOULEVARD, SUITE 1
MINNETONKA, MN 55305
(952) 546-7601 FAX: (952) 546-9065
www.schoellmadson.com

OWNER/DEVELOPER
WINDSOR DEVELOPMENT
9145 EDNBURGH LANE
WOODBURY, MN 55125
DATE: JAN., 2001

PROJECT NAME/SHEET TITLE
**WINDSOR OAK HILL
ELK RIVER, MN
196TH AVENUE NW
STORM SEWER PLAN**

SCHOELL & MADSON, INC. ENGINEERS * SURVEYORS * PLANNING
 10580 WAYZATA BOULEVARD, SUITE 1, MINNETONKA, MN 55305
 (952) 546-7601 FAX: (952) 546-9065 www.schoellmadson.com
 PROJECT NAME/SHEET TITLE: WINDSOR OAK HILL, ELK RIVER, MN, 196TH AVENUE NW, STORM SEWER PLAN
 DATE: JAN., 2001
 DRAWING NUMBER: WINDS 02