
CONSTRUCTION PLANS FOR: WINDSOR OAK HILL

PREPARED FOR:
WINDSOR DEVELOPMENT
CITY OF ELK RIVER, MINNESOTA

SANITARY SEWER, WATERMAIN, STORM DRAINAGE & STREET PAVING

WARNING
THE CONTRACTOR SHALL CONTACT ALL PUBLIC UTILITIES FOR
LOCATION OF ALL UNDERGROUND WIRES, CABLES, CONDUITS, PIPES,
MANHOLE, VALVES OR OTHER BURIED STRUCTURES BEFORE DIGGING
THE CONTRACTOR SHALL REPAIR OR REPLACE THE ABOVE WHEN
DAMAGED DURING CONSTRUCTION AT NO COST TO THE OWNER.

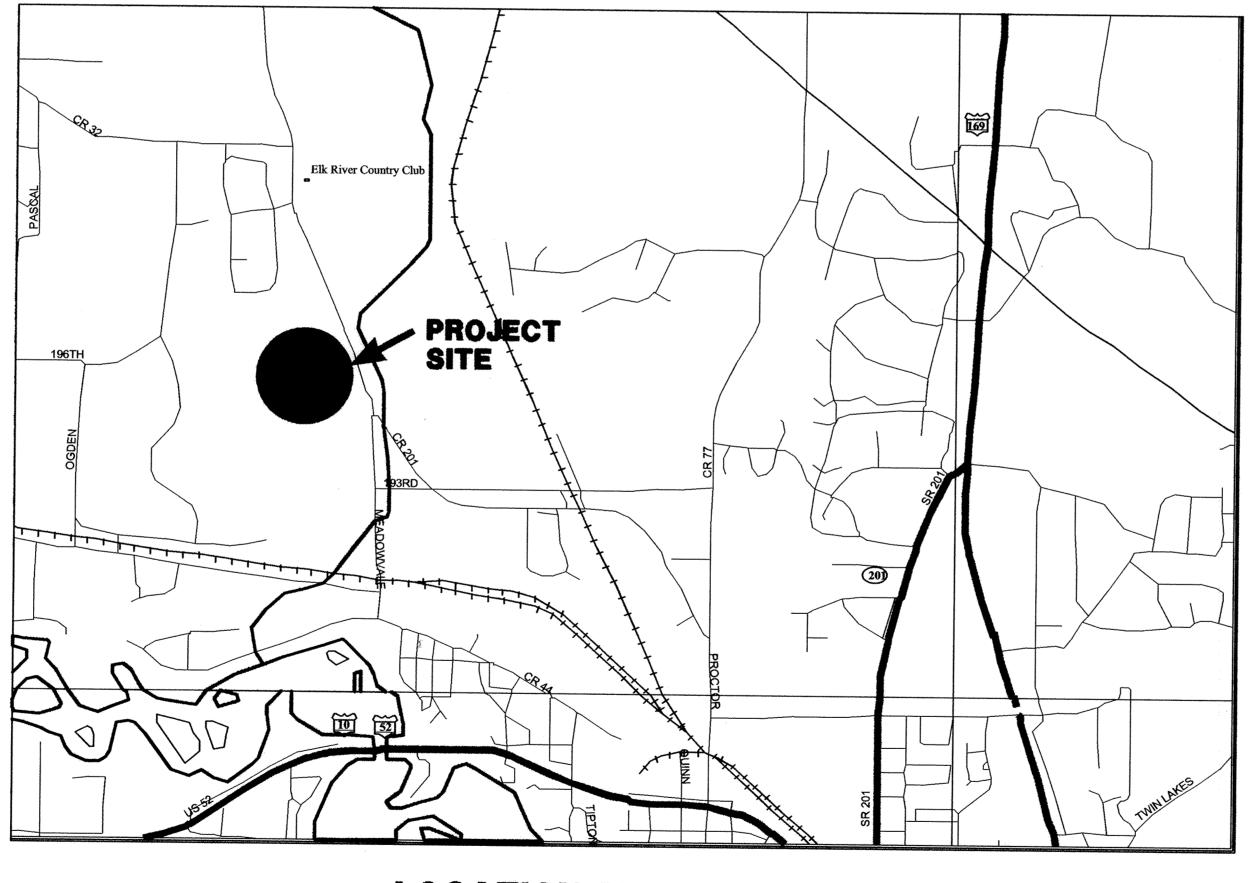

LOCATION MAP
NO SCALE

SHEET INDEX

DESCRIPTION

COVER INDEX SHEET

STREET CONSTRUCTION-196TH AVENUE

STREET CONSTRUCTION-ELGIN STREET NW

STREET CONSTRUCTION—ELGIN CIRCLE

7. SANITARY SEWER & WATERMAIN_196TH AVENUE

8. SANITARY SEWER & WATERMAIN-FIGIN STREET N

9. SANITARY SEWER & WATERMAIN-FIGIN CIRCLE N

10. SANITARY SEWER & WATERMAIN-195TH COURT

11. STORM SEWER CONSTRUCTION—196TH AVENUE N

12. STORM SEWER CONSTRUCTION—ELGIN STREET NW
13. STORM SEWER CONSTRUCTION—196TH AVE. & OUTLET

14. DETAILS

5. DETAILS

FOR INFORMATION ONLY

GRADING, DRAINAGE & EROSION CONTROL PLAN

. GRADING DETAILS

I HEREBY CERTIFY THAT THIS PLAN WAS PREPARED BY ME OR UNDER MY DIRECT SUPERVISION AND THAT I AM A DULY REGISTERED PROFESSIONAL ENGINEER UNDER THE LAWS OF THE STATE OF MINNESOTA.

Kenneth alof

DATE <u>1-29-01</u> REG. NO. <u>12048</u>

RECORD PLANS, CONTRACTOR, C.W. HOULE MARCH 2002

SCHOELL & MADSON, INC.

ENGINEERS • SURVEYORS • PLANNERS
SOIL TESTING • ENVIRONMENTAL SERVICES
10580 WAYZATA BOULEVARD MINNETONKA, MINNESOTA 55305

3-2002 SJM RECORD DRAWINGS
3-22-01 DS CITY COMMENTS
3-9-01 DS CITY COMMENTS
DATE BY REVISION
REVISIONS

846-037 SHEET 1 OF 15 SHEETS

F:\ENG\61846\037\05\Covr2234.dwg, 12/24/02 08:22:03 AM, traceec

S.M.I. PROJECT NO. 61846-037 SHEET 1 OF 15 SHEE