


RECORD DRAWING

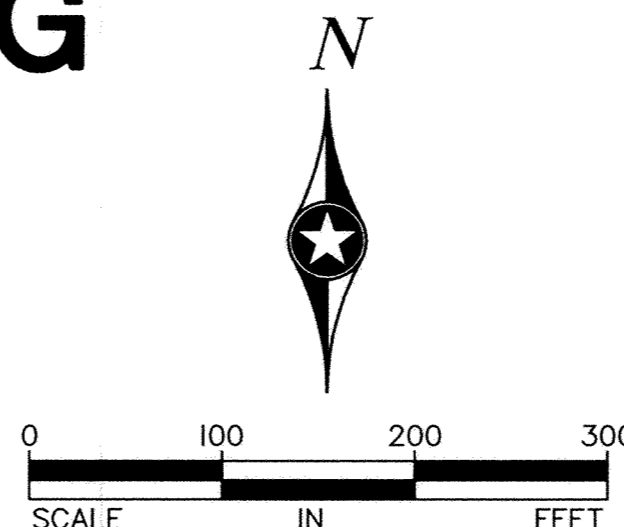

LEGEND	
	EXISTING CONTOURS
	APPROXIMATE WET LANDS AS LOCATED BY BPA
	APPROXIMATE WET LANDS AS LOCATED BY DYNAMICS DESIGN
	APPROXIMATE SOIL TYPE BOUNDARY
	EXISTING TREE
	EXISTING TREE LINE
	FOUND MONUMENT
	SET MONUMENT
	FOUND CAST IRON MONUMENT
	SIGN
	EXISTING POLE
	EXISTING GUY ANCHOR
	EXISTING ELECTRIC BOX
	EXISTING TELEPHONE PEDESTAL
	PROPOSED STORM SEWER
	PROPOSED CATCH BASIN
	PROPOSED MANHOLE
	PROPOSED PRESSURIZED SANITARY SEWER
	PROPOSED PRESSURE CLEANOUT
	PROPOSED VALVE
	PROPOSED AIR RELEASE ASSEMBLY
	PROPOSED TEE

ALL AS-BUILT INFORMATION GIVEN AS OBLIQUED TEXT

RECORD DRAWING NOTES:

1. INFORMATION IS FURNISHED WITHOUT WARRANTY AS TO ACCURACY. USERS SHOULD FIELD VERIFY LOCATIONS AND ELEVATIONS.
2. ELEVATIONS SHOWN AND NOT ADJUSTED ARE DESIGN ELEVATIONS.
3. CONTRACTOR IS WEST BRANCH CONSTRUCTION DEVELOPER IS DYNAMICS DESIGN & LAND CO.

NOTES:

- 1.) ALL SEWER SERVICE LINES SHALL BE 1-1/4" POLYETHELENE
- 2.) ALL CROSSING OF PAVED AREAS SHALL BE SLEEVED

SEE ONSITE SEWAGE TREATMENT SYSTEM PLANS

RECORD DRAWING	
MEASURED BY:	LH @ BPA
INSPECTED BY:	R.N. @ H.R. GREEN
DATE:	6/02
DRAWN BY:	CCO, GB, PG @ BPA

REV. NO.	DATE	DESCRIPTION
1	6/24/02	CHANGES PER CITY ENGINEER
2	8/2/02	LOWERED GRADE
3	8/6/02	21' HOPE CHANGED TO 24' HOPE
4	2/13/03	ASBUILTS
5	1/31/05	UPDATED ASBUILTS

DATE:	3/27/02
DESIGN BY:	JKB, PG, GB
DRAWN BY:	CCO, JKB
CHECKED BY:	CCO, JKB
DWG FILE:	10_SAN
FILE NO.:	101304.0

I hereby certify that this plan was prepared by me or under my direct supervision and that I am a duly Licensed Professional Engineer under the laws of the State of Minnesota.

Signed: Reg. No. 19900
 Date: 3/11/05

WINDSOR PARK 3RD ADD. CITY OF ELK RIVER, MN. DYNAMICS DESIGN & LAND CO.	BOGART, PEDERSON & ASSOCIATES, INC. LAND SURVEYING ENGINEERING MAPPING 13076 FIRST STREET, BECKER, MN 55308-9322 TEL: 763-262-8822 FAX: 763-822-8844
---	---

SHEET NO.	10
17	

