
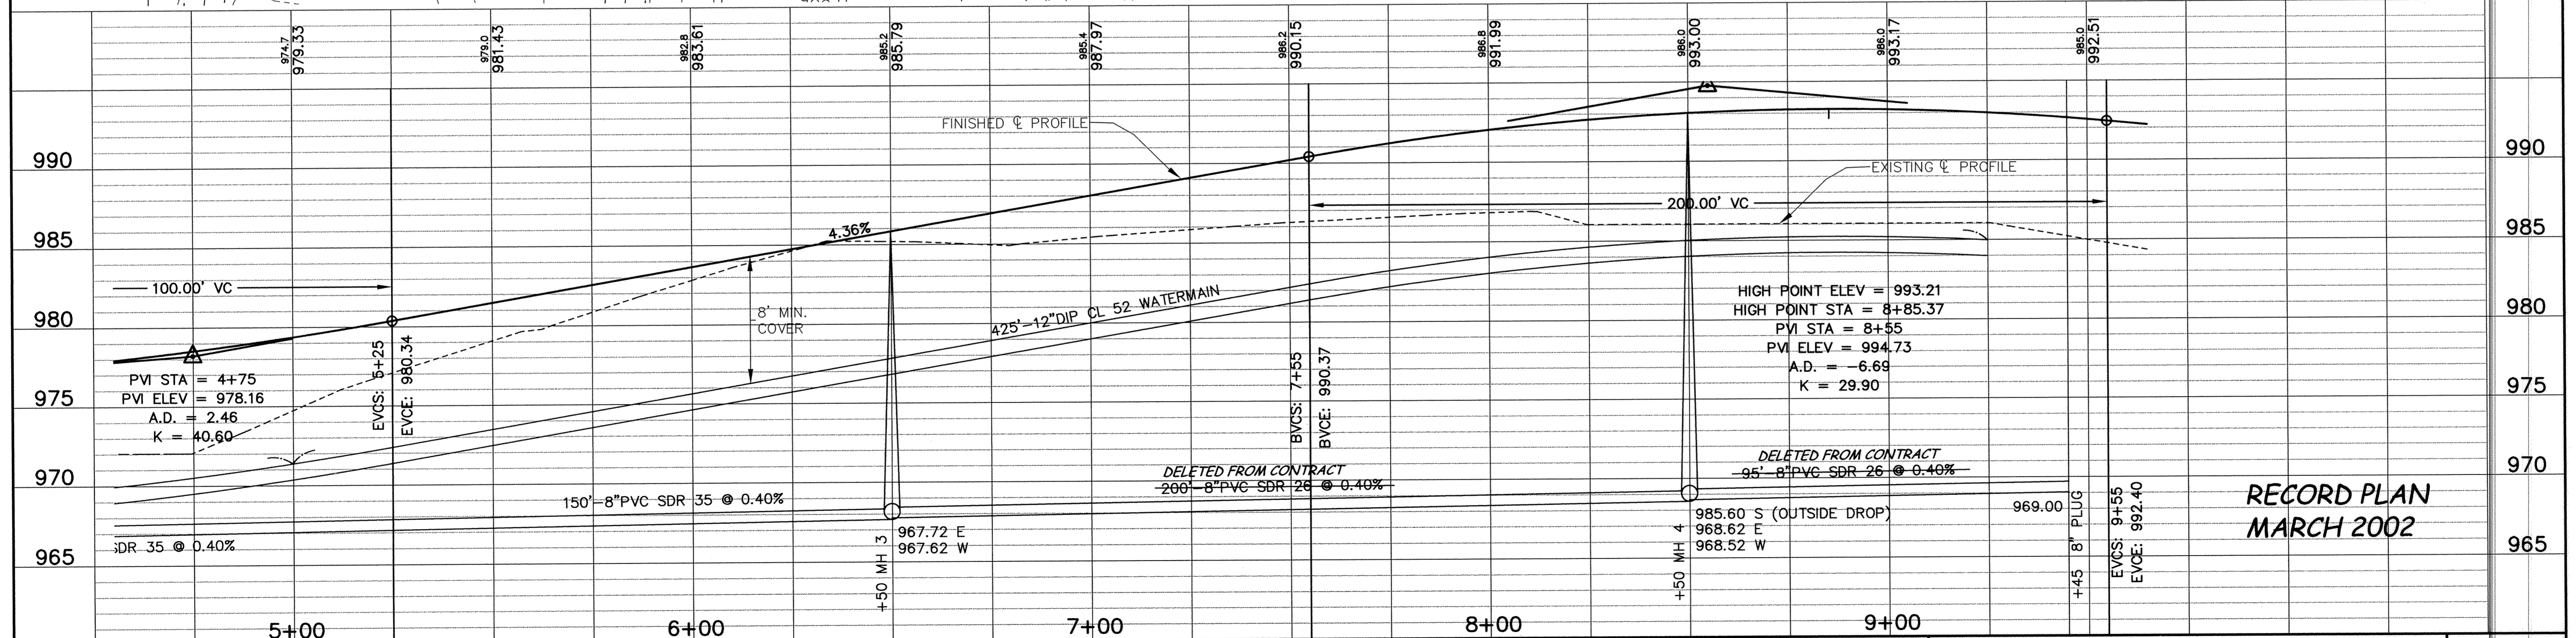


193RD STREET NW

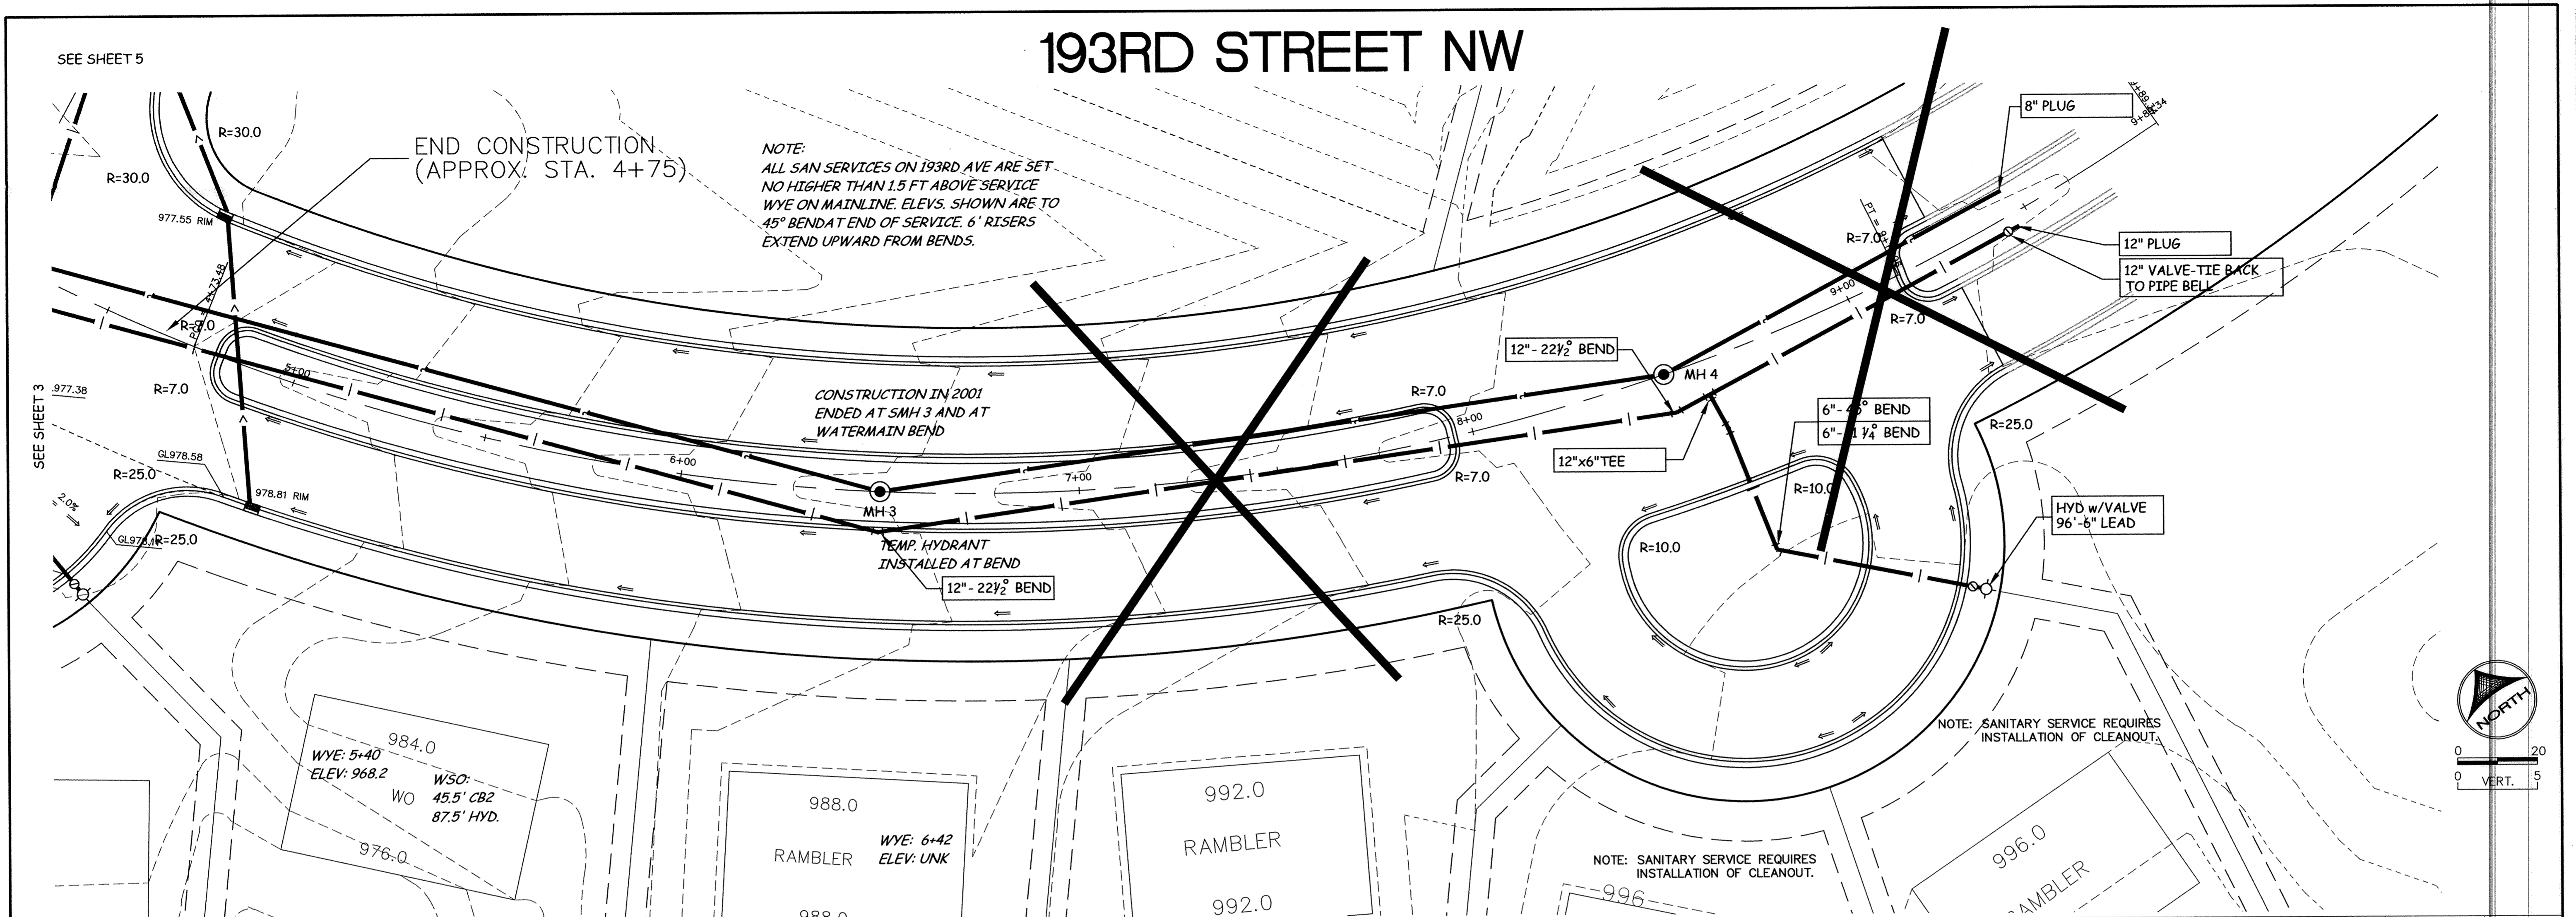

DESIGNED BY: DESIGNED_BY DRAWN BY: DRAWN_BY
 APPROVED BY: APPROVED_BY JOB NUMBER 809781J
 CAD DATE: April 18, 2002 9:45:49 a.m.
 CAD FILE: 811380\asbuilts\811380-P2.DWG

I HEREBY CERTIFY THAT THIS PLAN, SPECIFICATION, OR REPORT WAS PREPARED BY ME OR UNDER MY DIRECT SUPERVISION AND THAT I AM A DULY REGISTERED PROFESSIONAL ENGINEER UNDER THE LAWS OF THE STATE OF MINNESOTA.

DATE _____ REG. NO. _____

NO.	DATE	BY	REVISION DESCRIPTION
1	10/11/2000	EY	PLAN OMISSION

1326 ENERGY PARK DRIVE
 ST. PAUL, MINNESOTA 55108
 (651) 644-4389

Howard R. Green Company
 CONSULTING ENGINEERS

CITY OF ELK RIVER
THE WOODS OF HILLSIDE II
STREET AND UTILITY IMPROVEMENTS

193RD STREET NW
PLAN AND PROFILE
5+00 TO 9+50

SHEET NO.
4
 OF
11

DRAWING NUMBER
WOODS2.00

DRAWING NUMBER
WOODS2.00

DRAWING NUMBER
WOODS2.00

DRAWING NUMBER
WOODS2.00