
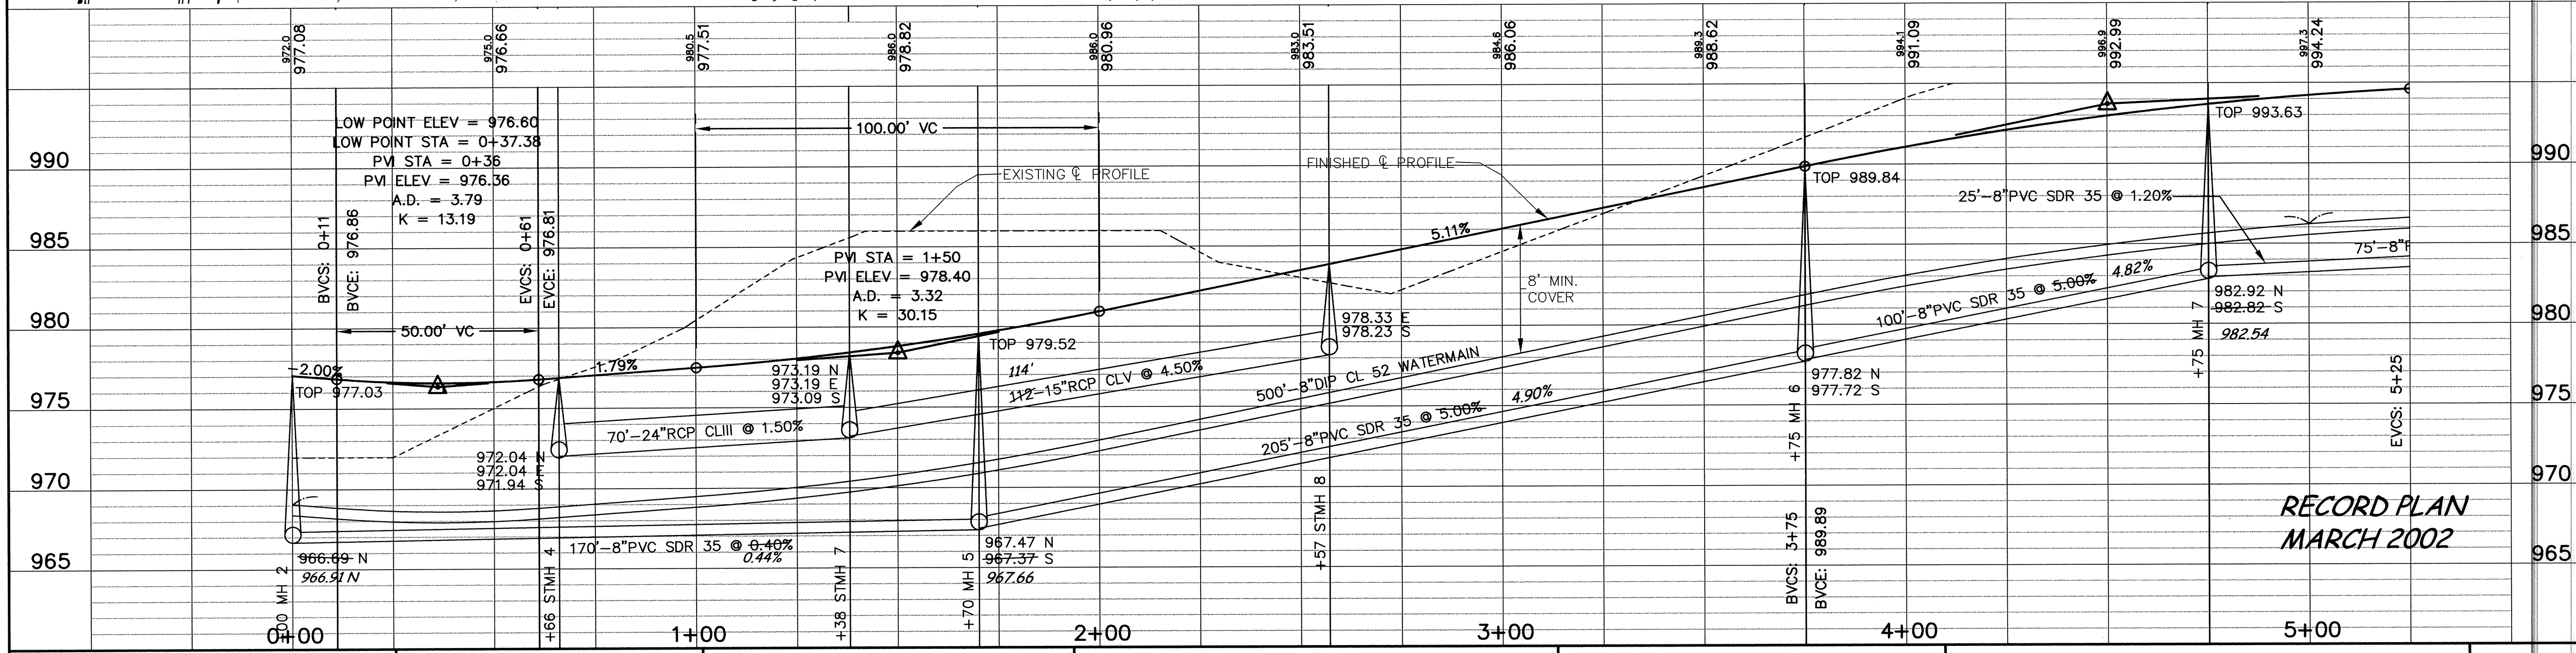
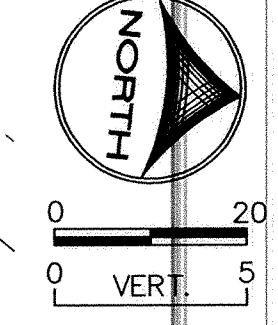


SACO PRODUCTS • NEW HOPE, MINNESOTA  
 REORDER BY PART NUMBER 6582  
 SACO PRODUCTS • NEW HOPE, MINNESOTA  
 REORDER BY PART NUMBER 6582  
 SACO PRODUCTS • NEW HOPE, MINNESOTA  
 REORDER BY PART NUMBER 6582

# ZANE AVENUE

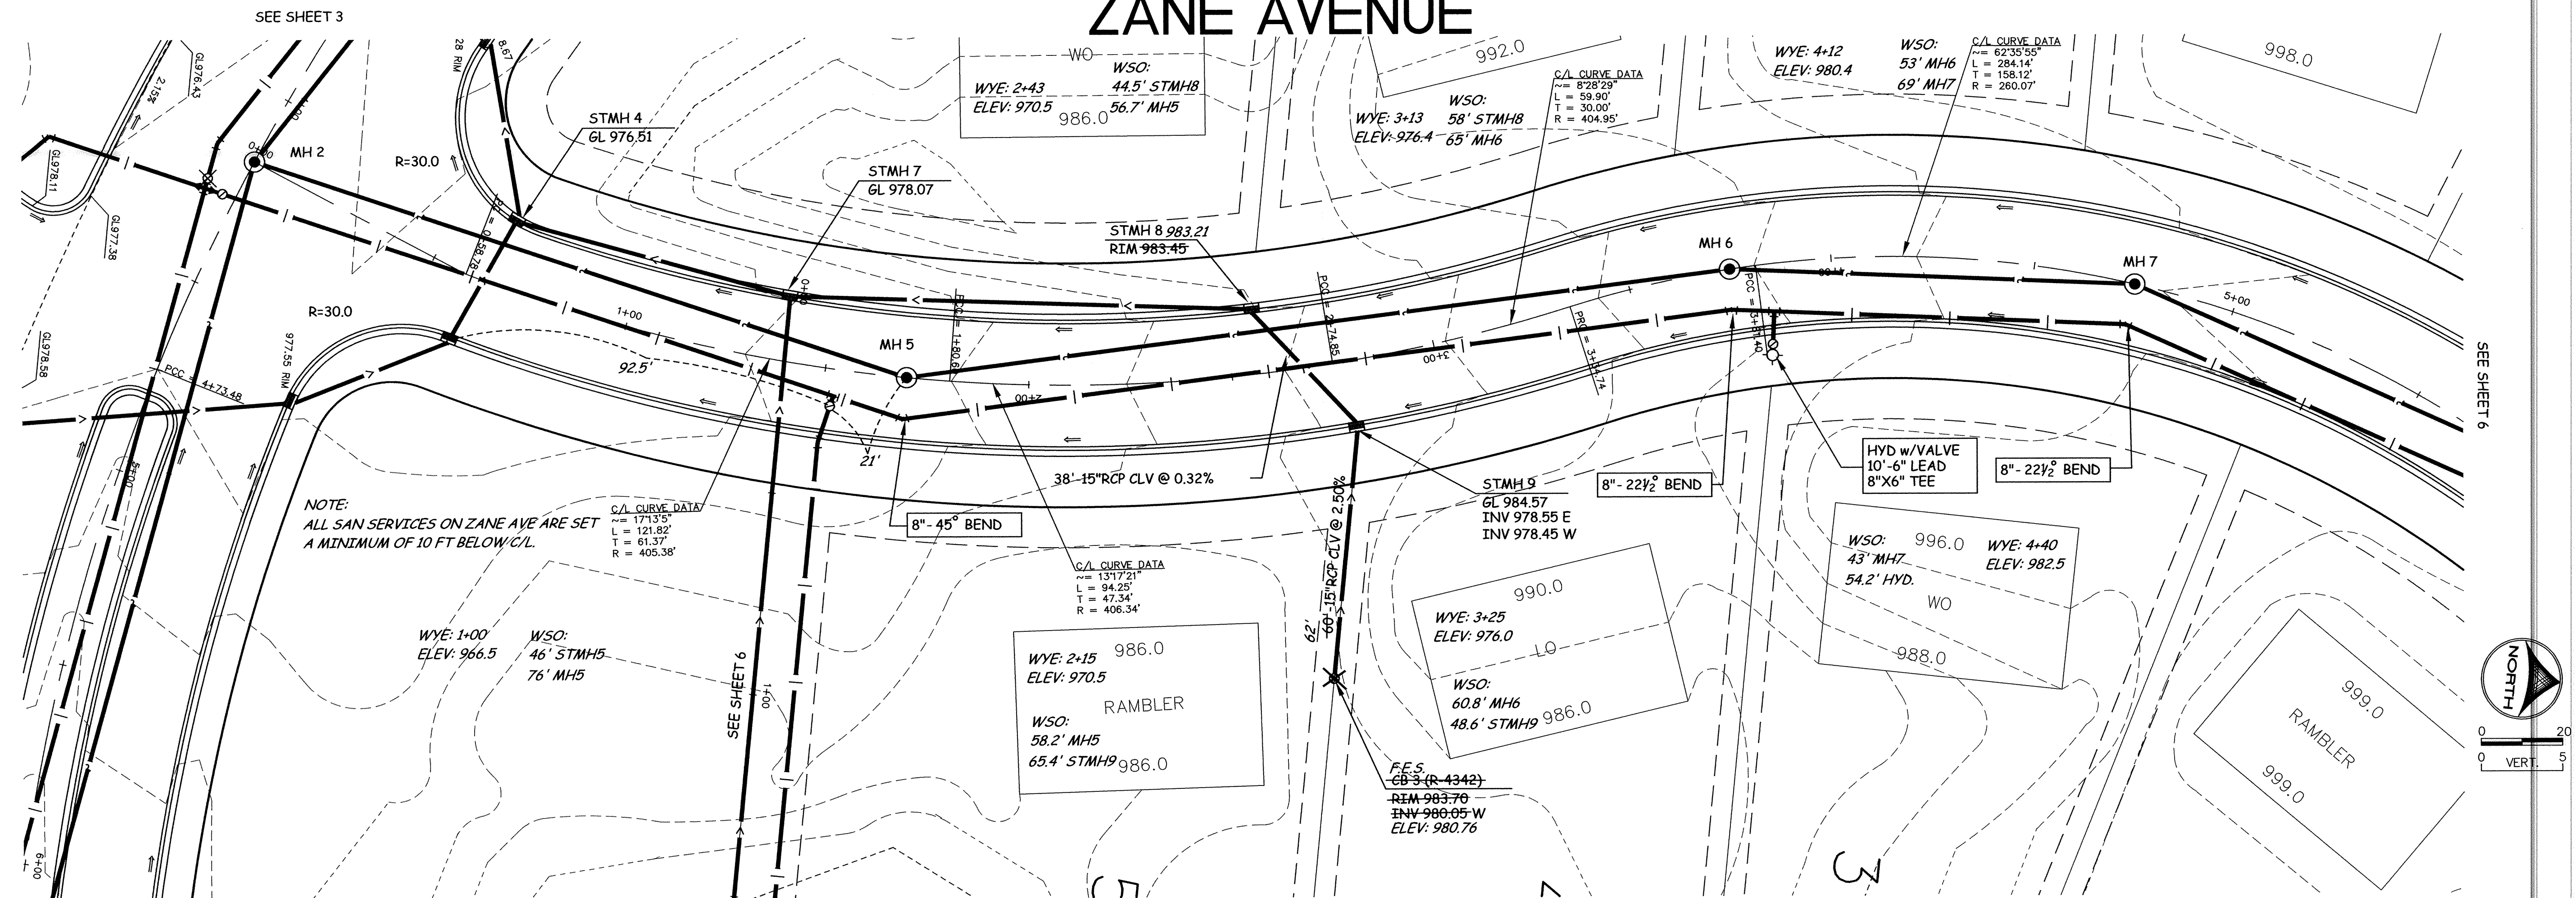

DESIGNED BY: DESIGNED\_BY  
 DRAWN BY: DRAWN\_BY  
 APPROVED BY: APPROVED\_BY  
 JOB NUMBER: 809781J  
 CAD DATE: April 18, 2002 9:54:46 a.m.  
 CAD FILE: 811380\osbuilts\811380-P3.DWG

I HEREBY CERTIFY THAT THIS PLAN, SPECIFICATION,  
 OR REPORT WAS PREPARED BY ME OR UNDER MY DIRECT  
 SUPERVISION AND THAT I AM A DULY REGISTERED  
 PROFESSIONAL ENGINEER UNDER THE LAWS OF THE  
 STATE OF MINNESOTA.  
 DATE: \_\_\_\_\_ REG. NO.: \_\_\_\_\_

NO.	DATE	BY	REVISION DESCRIPTION
1	10/11/2000	EY	REVISED STORM SEWER/WATERMAIN

**Howard R. Green Company**  
CONSULTING ENGINEERS

1326 ENERGY PARK DRIVE  
ST. PAUL, MINNESOTA 55108  
(651) 644-4389

**CITY OF ELK RIVER**  
**THE WOODS OF HILLSIDE II**  
**STREET AND UTILITY IMPROVEMENTS**

**ZANE AVENUE**  
**PLAN AND PROFILE**  
**0+00 TO 5+00**

SHEET NO.  
**5**  
 OF  
**11**