
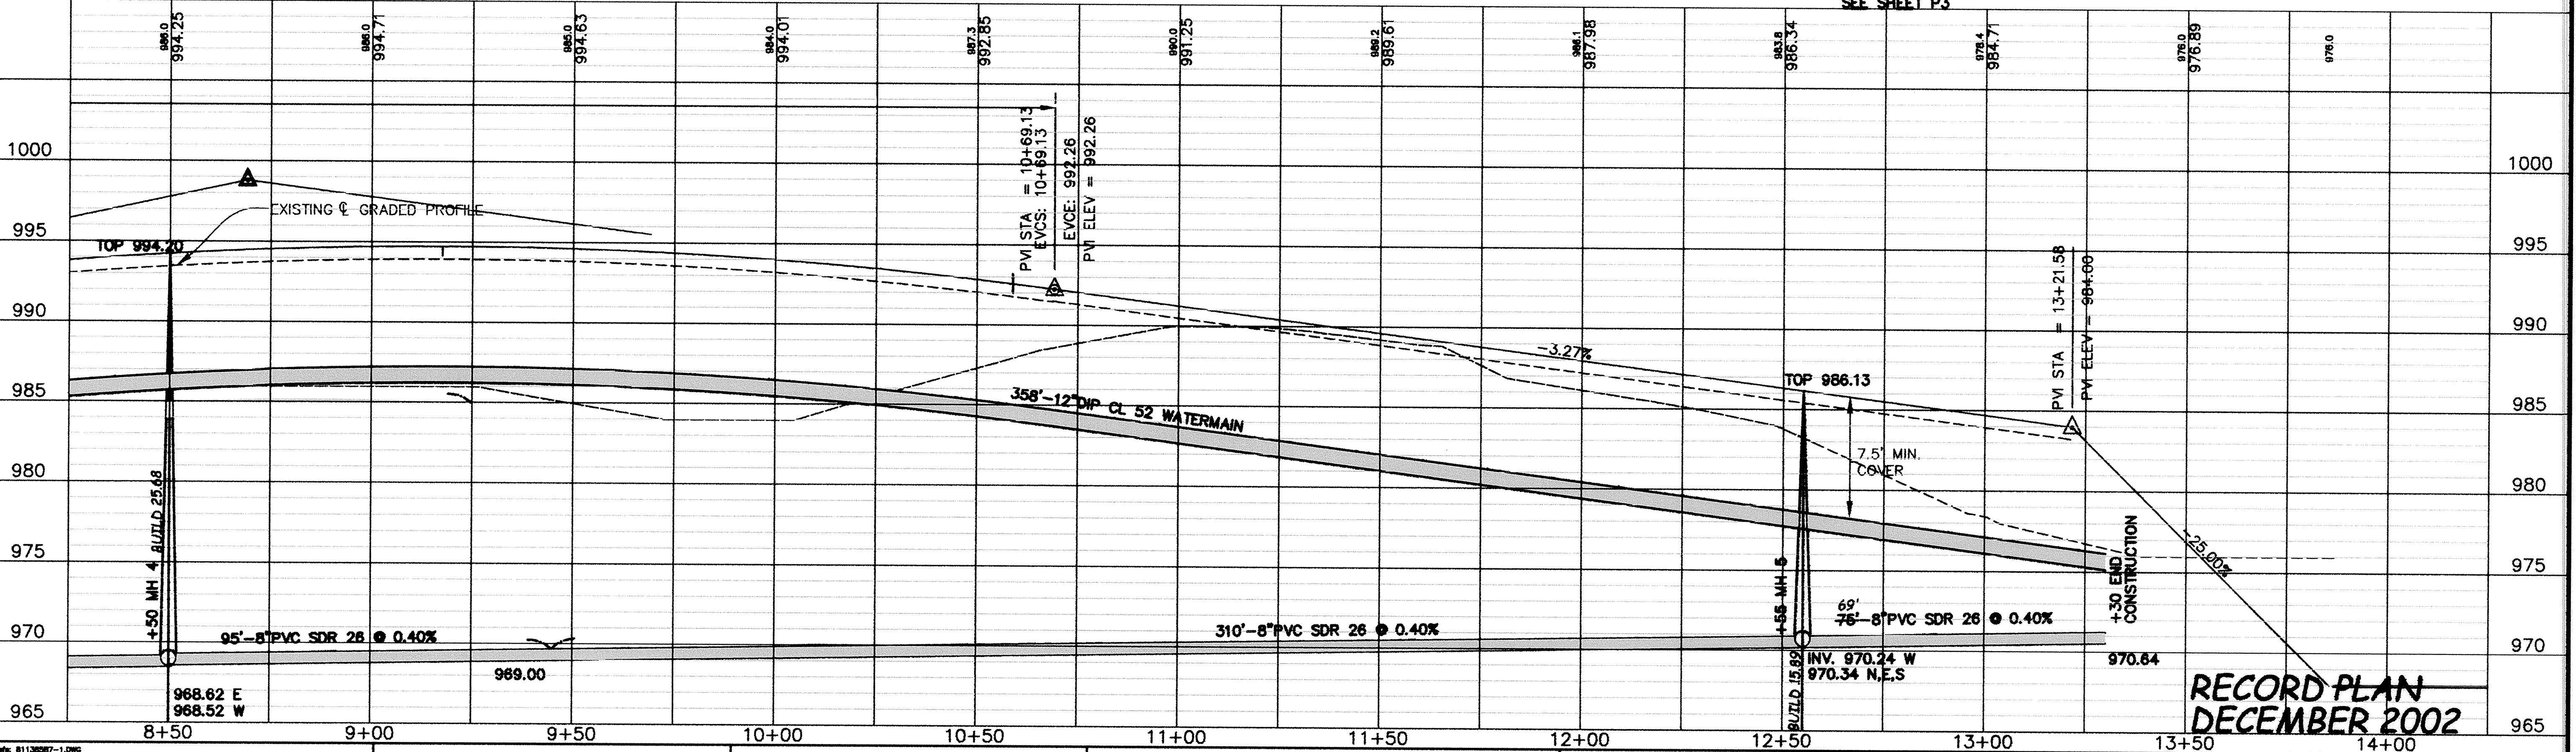


193RD STREET NW

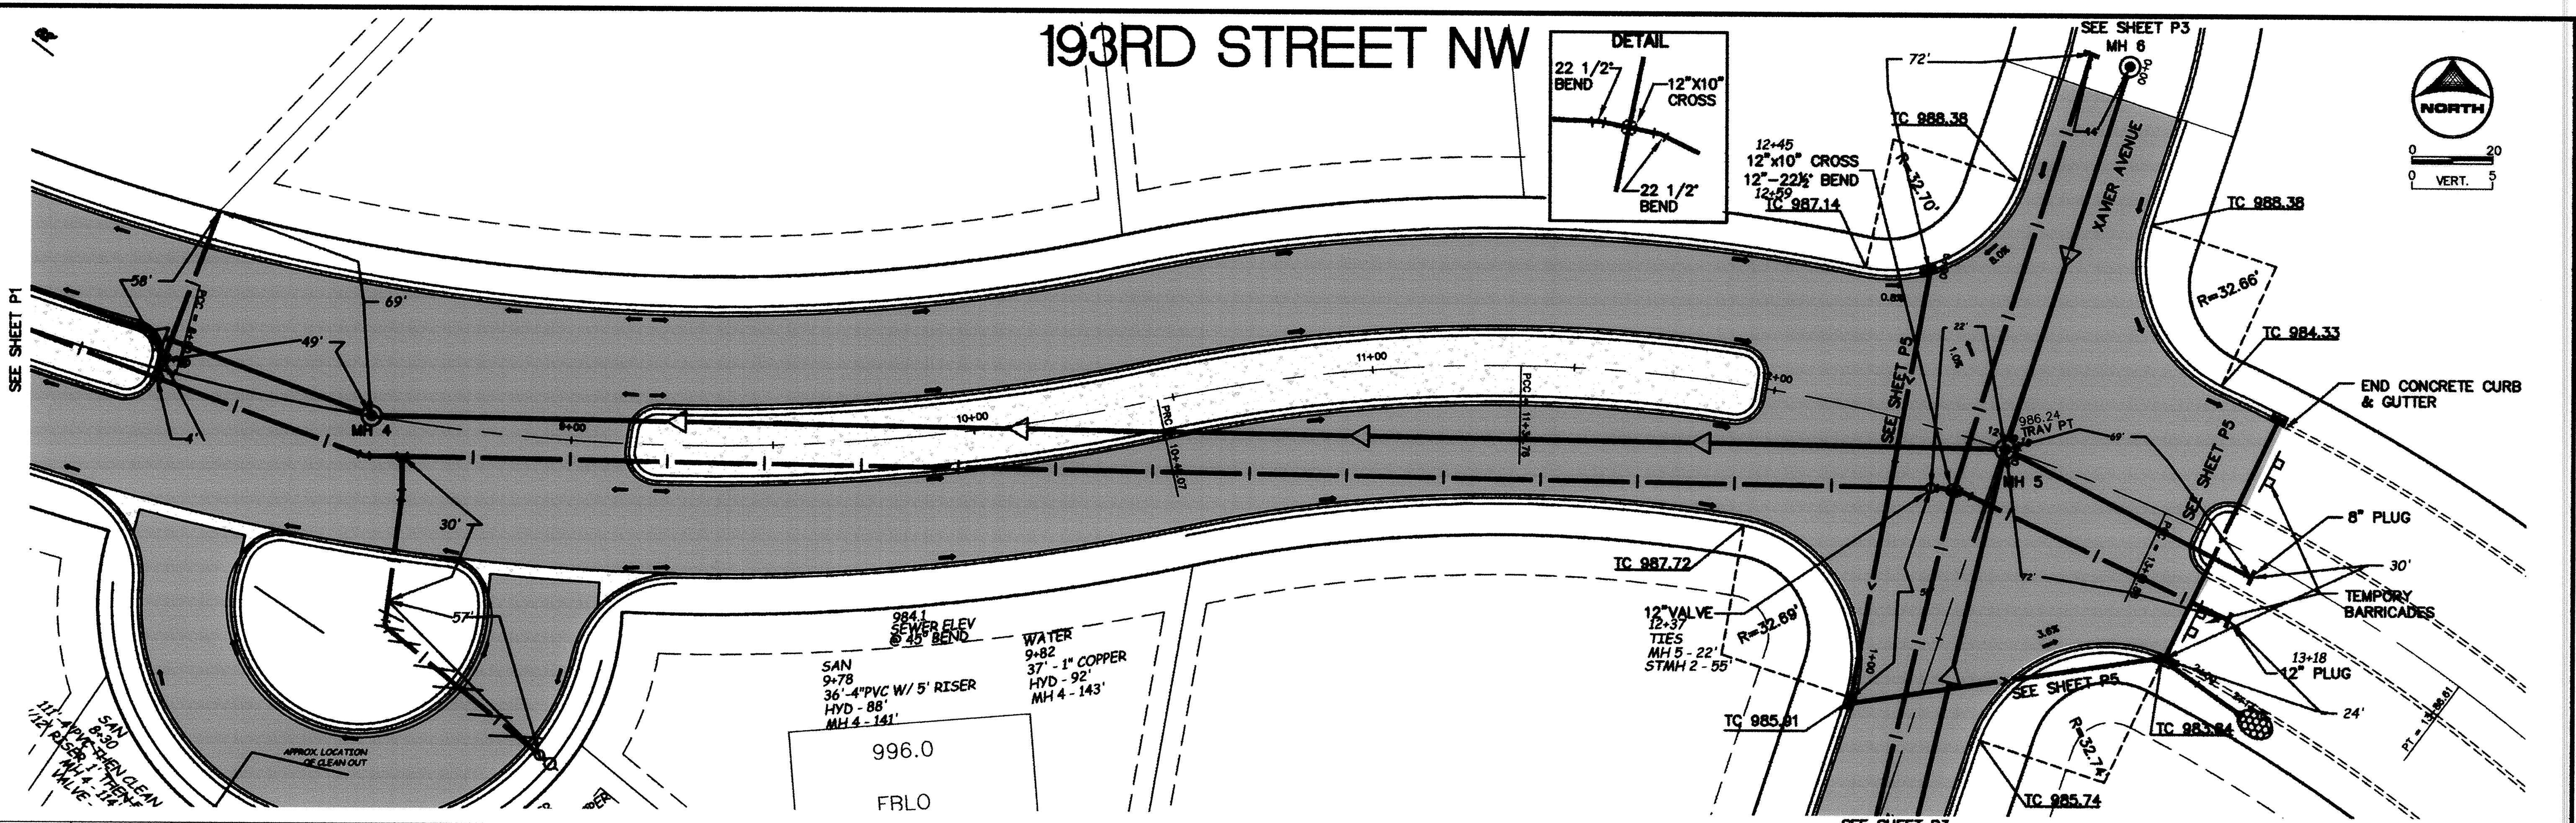

**RECORD PLAN
DECEMBER 2002**

DESIGNED BY: EY DRAWN BY: TAE
 APPROVED BY: TJM JOB NUMBER 811385J
 CAD DATE: April 04, 2003 7:54:06 a.m.
 CAD FILE: 811385J\dwg\811385P-1.DWG (JLALLEN)

I HEREBY CERTIFY THAT THIS PLAN, SPECIFICATION, OR REPORT WAS PREPARED BY ME OR UNDER MY DIRECT SUPERVISION AND THAT I AM A DULY LICENSED PROFESSIONAL ENGINEER UNDER THE LAWS OF THE STATE OF MINNESOTA.

SIGNATURE: _____ DATE: _____
 PRINTED NAME: TERRY J. MAUER LIC. NO. 15316

NO.	DATE	BY	REVISION DESCRIPTION
1	10/04/02	EY	EXTENDED UTILITIES TO STA. 13+30
1	10/24/02	EY	ADDED 12" GATE VALVE

1326 ENERGY PARK DRIVE
 ST. PAUL, MINNESOTA 55108
 (651) 644-4389

Howard R. Green Company
 CONSULTING ENGINEERS

CITY OF ELK RIVER
 THE WOODS OF HILLSIDE III
 STREET AND UTILITY IMPROVEMENTS

193RD STREET N.W.
 STREET AND UTILITY IMPROVEMENTS
 9+00 TO 13+50

SHEET NO.
P2

SACCO PRODUCTS • NEW HOPE, MINNESOTA
 REFERRED BY PART NUMBER 8052
 SACCO PRODUCTS • NEW HOPE, MINNESOTA
 REFERRED BY PART NUMBER 8052
 SACCO PRODUCTS • NEW HOPE, MINNESOTA
 REFERRED BY PART NUMBER 8052
 SACCO PRODUCTS • NEW HOPE, MINNESOTA
 REFERRED BY PART NUMBER 8052