

DRAWING NUMBER

DRAWING NUMBER

DRAWING NUMBER

DRAWING NUMBER

SAECO PRODUCTS • NEW HOPE, MINNESOTA
REORDER BY PART NUMBER 8838

SAECO PRODUCTS • NEW HOPE, MINNESOTA
REORDER BY PART NUMBER 8838



SAECO PRODUCTS • NEW HOPE, MINNESOTA
REORDER BY PART NUMBER 8838

SAECO PRODUCTS • NEW HOPE, MINNESOTA
REORDER BY PART NUMBER 8838

VANCE AVENUE

SEE SHEET P4

SEE SHEET P2

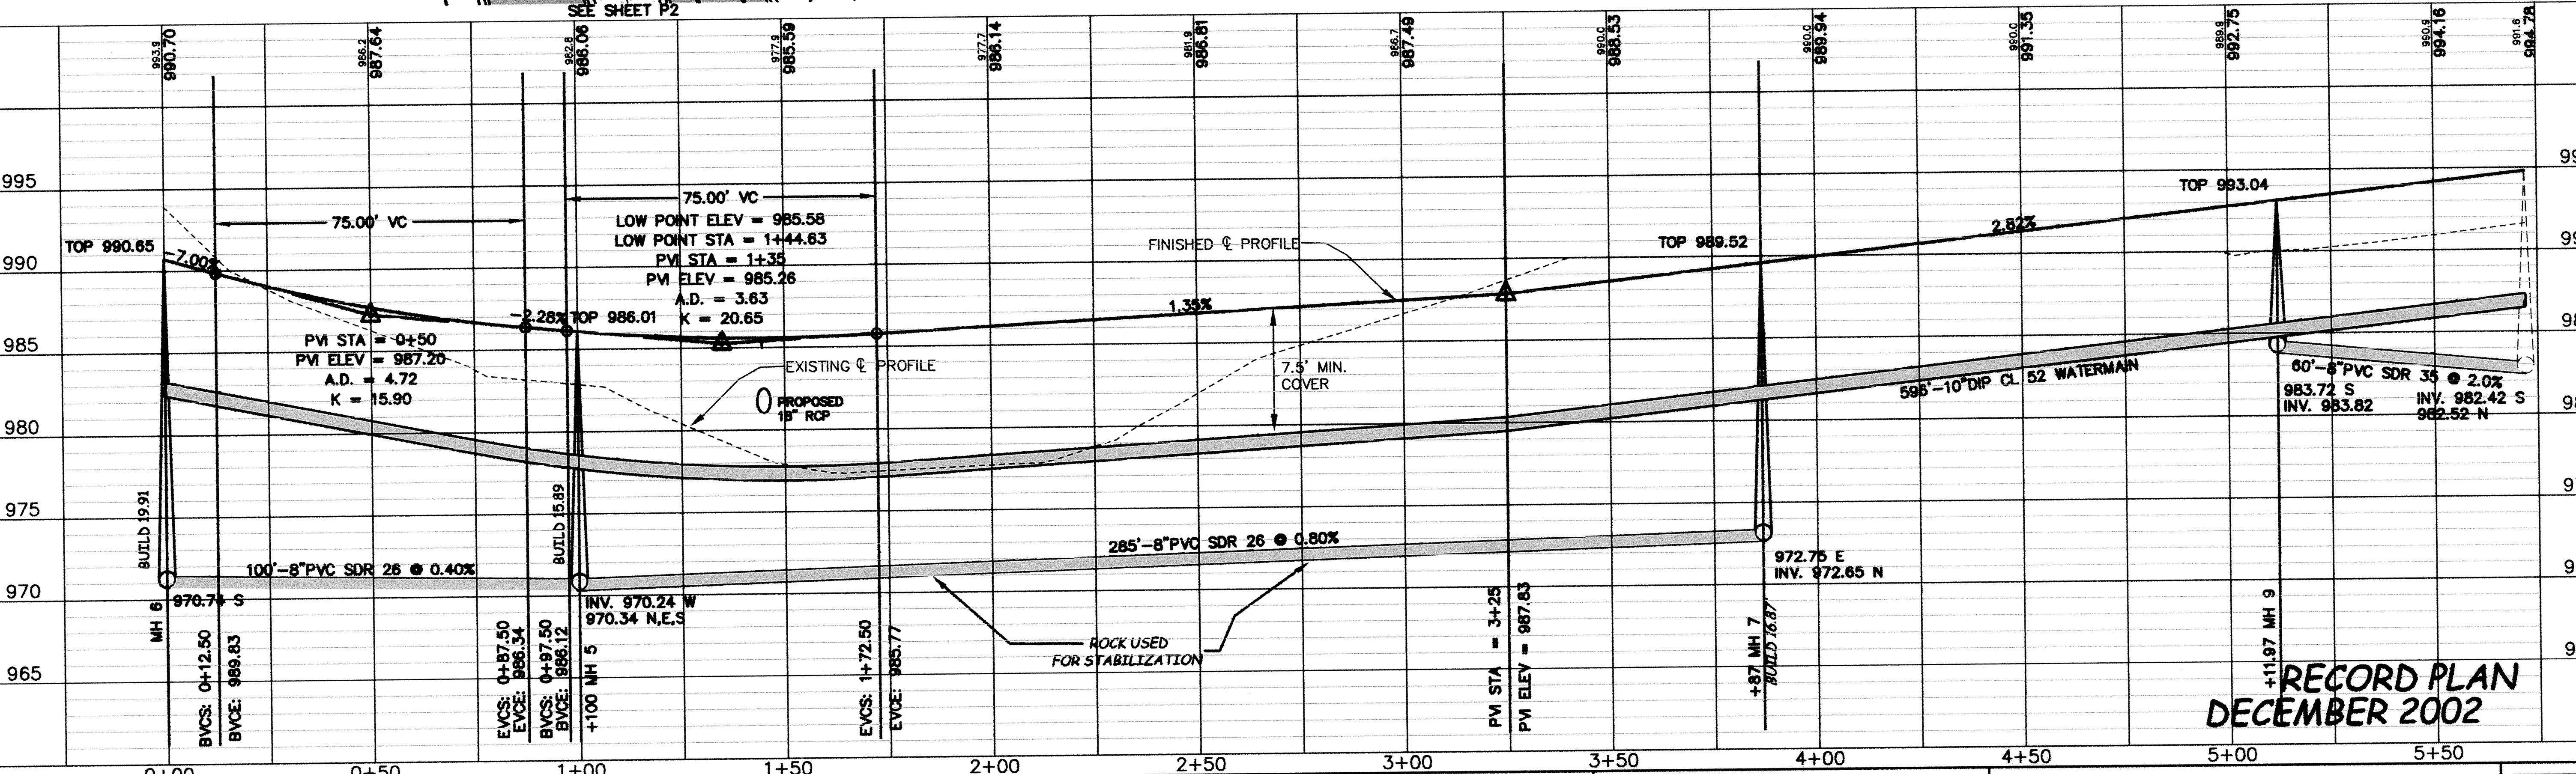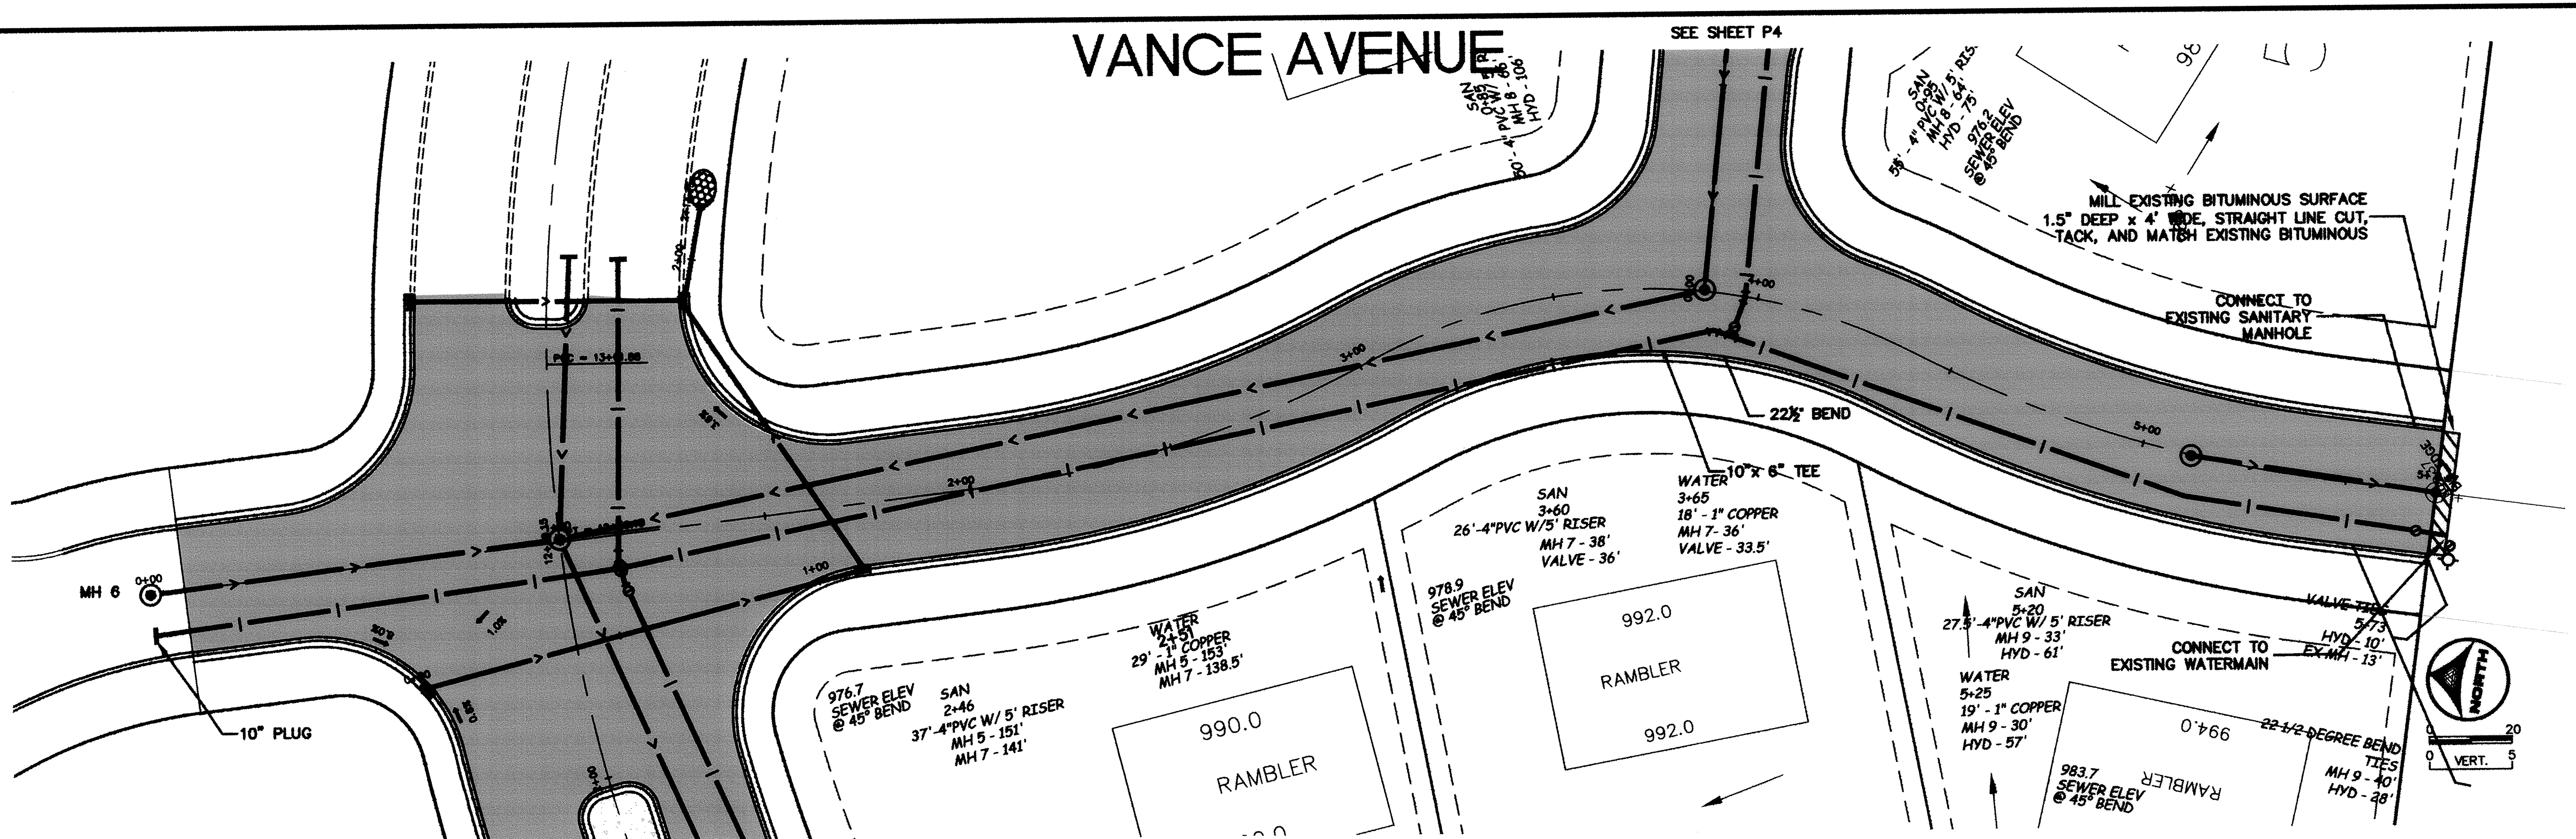

**RECORD PLAN
DECEMBER 2002**

DESIGNED BY: EY DRAWN BY: TAE
 APPROVED BY: TJM JOB NUMBER 811385J
 CAD DATE: February 01, 2003 10:26:33 a.m.
 CAD FILE: 811385J.dwg\811385P-3.DWG (JLALLEN)

I HEREBY CERTIFY THAT THIS PLAN, SPECIFICATION, OR REPORT WAS PREPARED BY ME OR UNDER MY DIRECT SUPERVISION AND THAT I AM A DULY LICENSED PROFESSIONAL ENGINEER UNDER THE LAWS OF THE STATE OF MINNESOTA.

SIGNATURE: _____ DATE: _____
 PRINTED NAME: TERRY J. MAUER LIC. NO. 15316

NO.	DATE	BY	REVISION DESCRIPTION

1326 ENERGY PARK DRIVE
 ST. PAUL, MINNESOTA 55108
 (651) 644-4389

Howard R. Green Company
 CONSULTING ENGINEERS

CITY OF ELK RIVER
THE WOODS OF HILLSIDE III
STREET AND UTILITY IMPROVEMENTS

VANCE AVENUE
STREET AND UTILITY IMPROVEMENTS
 0+00 TO 5+71.97

SHEET NO.
P3

SAECO PRODUCTS • NEW HOPE, MINNESOTA
REORDER BY PART NUMBER 8838