
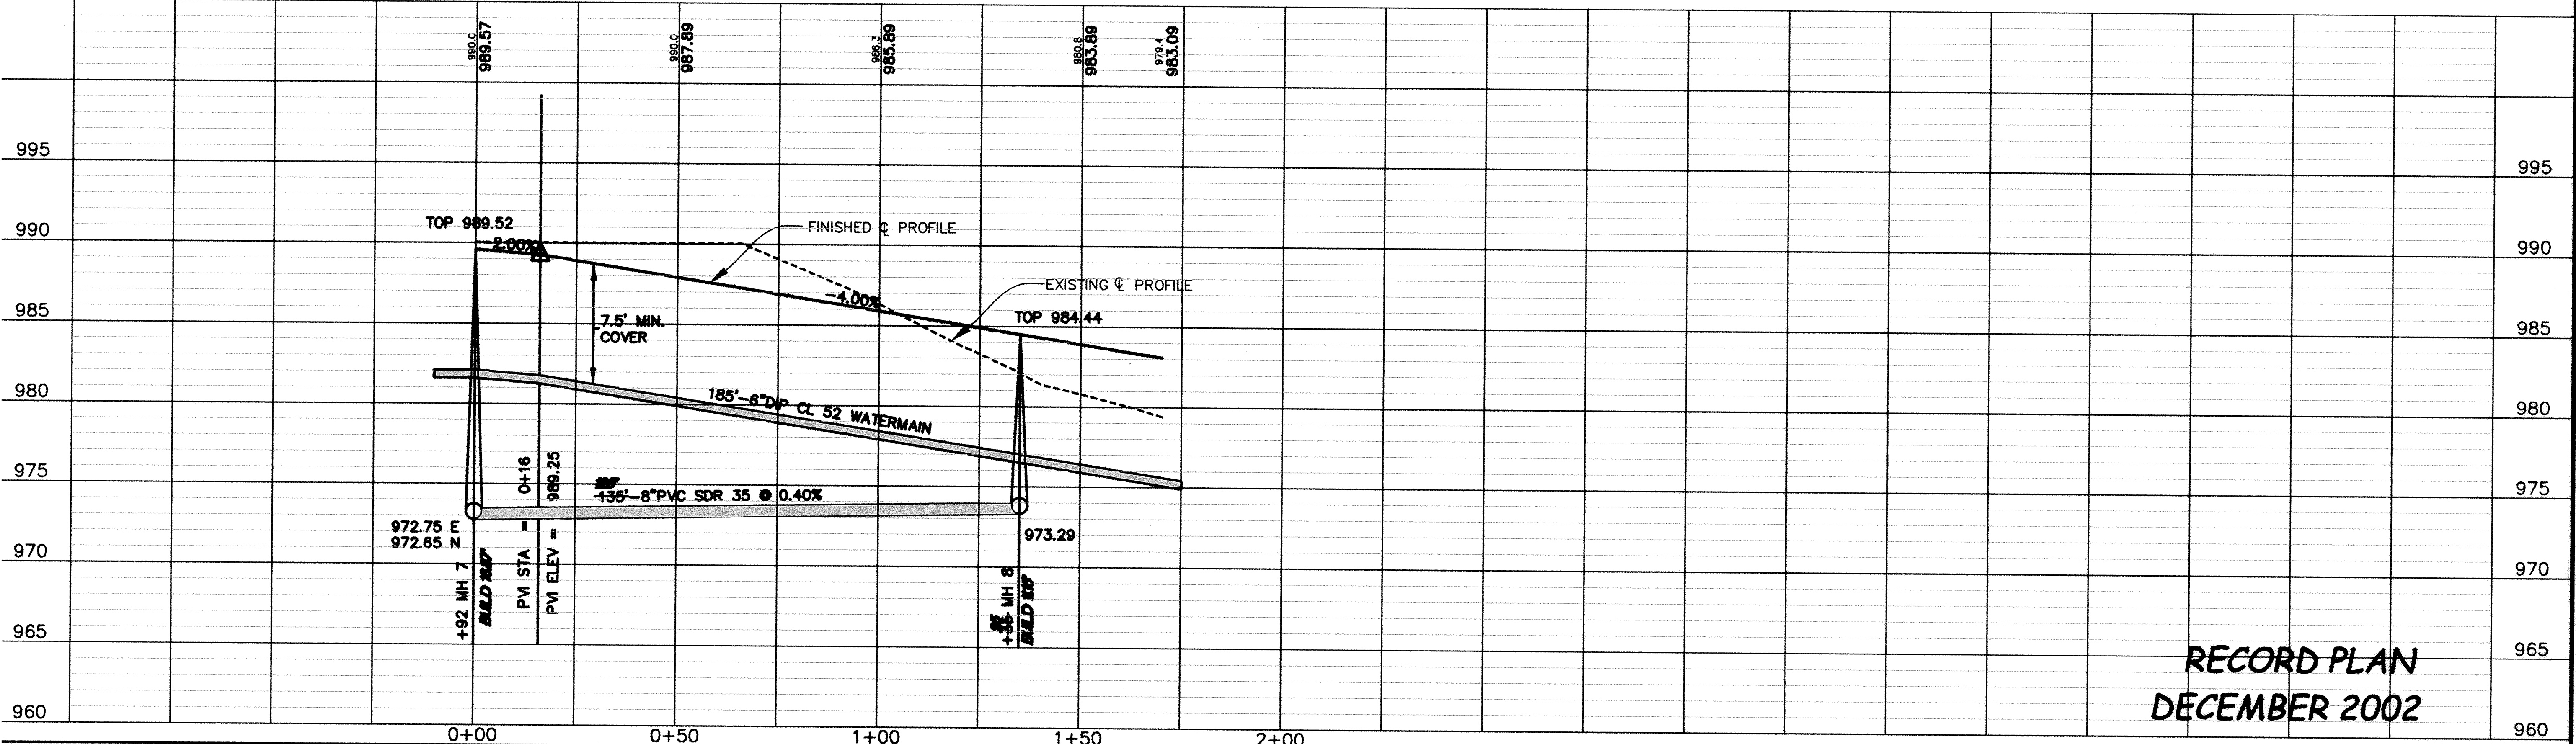
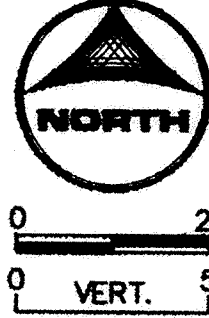


SACCO PRODUCTS • NEW HAVEN, MINNESOTA  
REVISIONS BY PART NUMBER 8552

SACCO PRODUCTS • NEW HAVEN, MINNESOTA  
REVISIONS BY PART NUMBER 8552

SACCO PRODUCTS • NEW HAVEN, MINNESOTA  
REVISIONS BY PART NUMBER 8552

SACCO PRODUCTS • NEW HAVEN, MINNESOTA  
REVISIONS BY PART NUMBER 8552

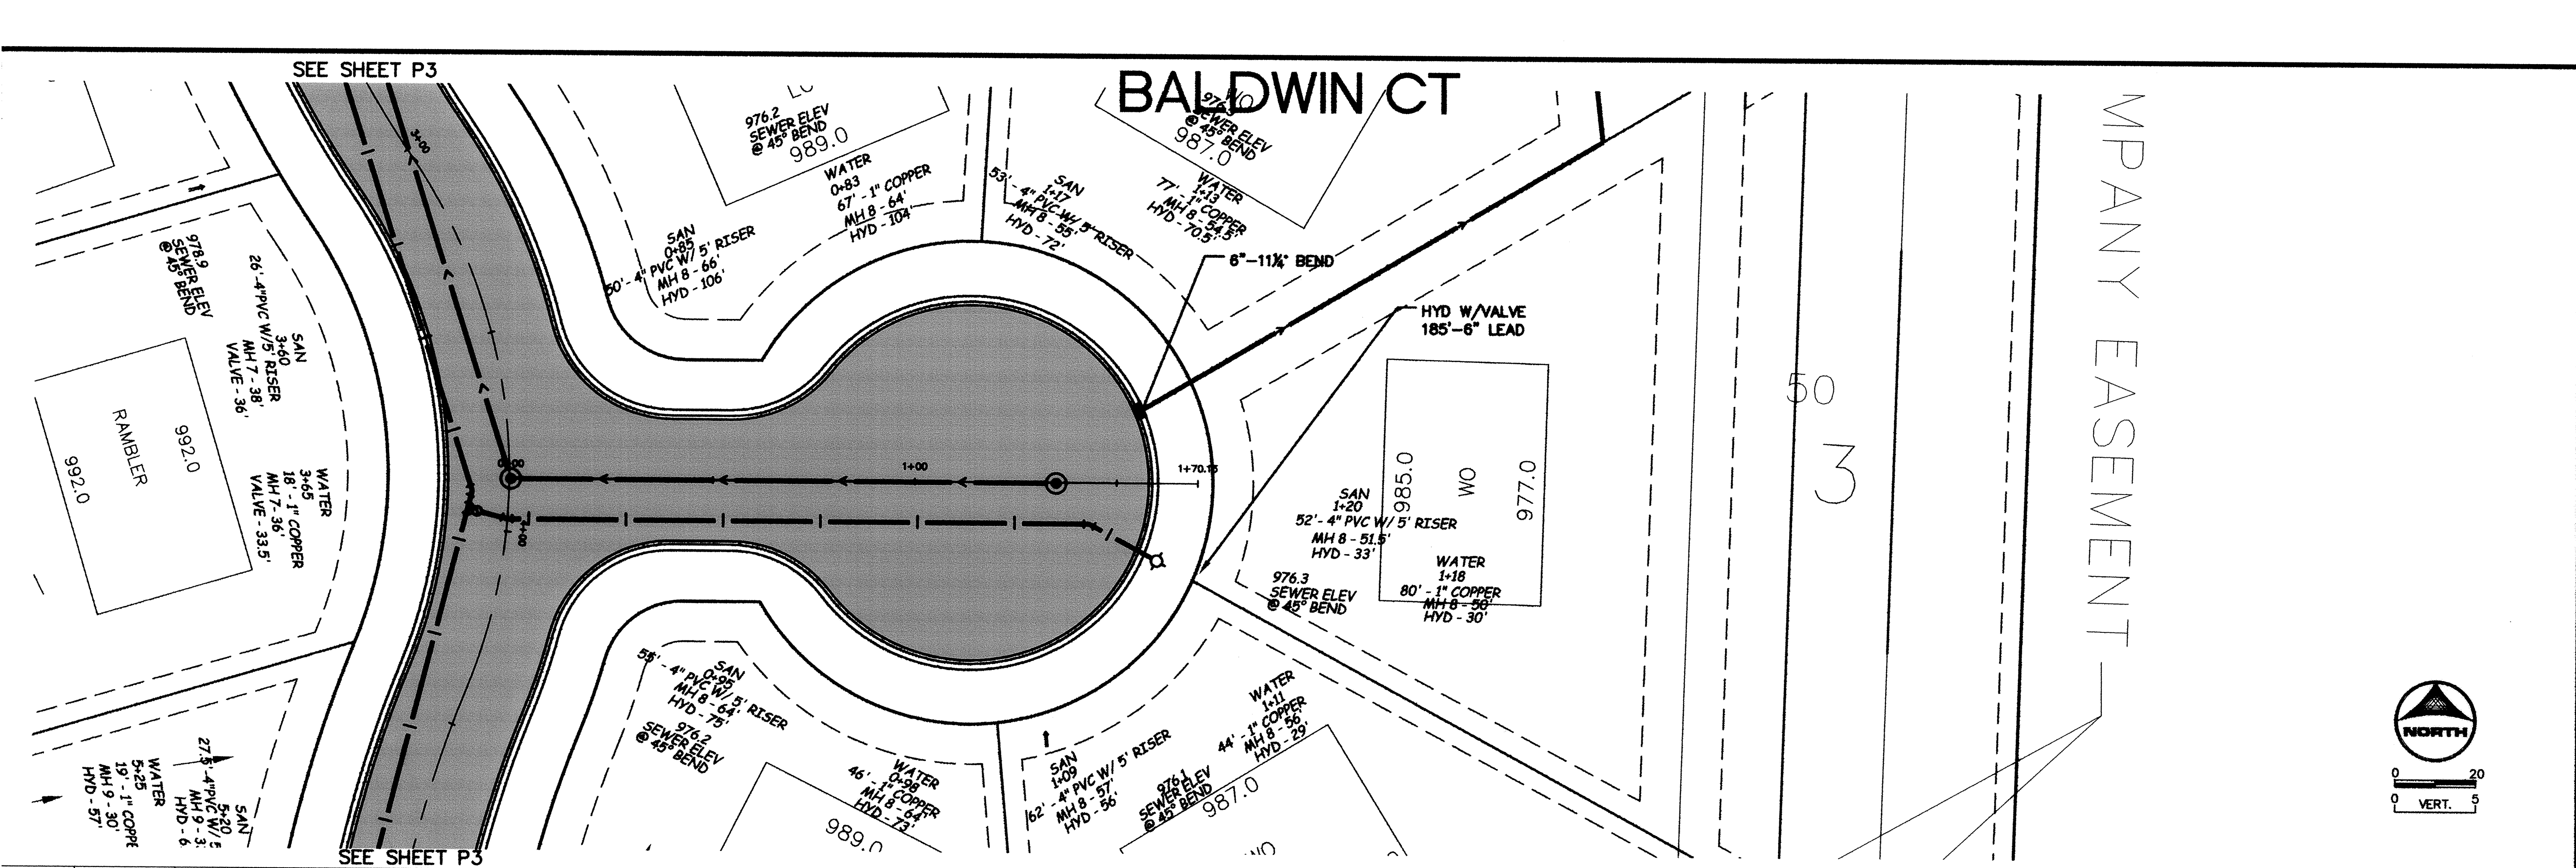

RECORD PLAN  
DECEMBER 2002

DESIGNED BY: EY DRAWN BY: TAE  
 APPROVED BY: TJM JOB NUMBER 811385J  
 CAD DATE: April 04, 2003 7:56:10 a.m.  
 CAD FILE: 811385\dwg\811385P-3.DWG (JLALLEN)

I HEREBY CERTIFY THAT THIS PLAN, SPECIFICATION, OR REPORT WAS PREPARED BY ME OR UNDER MY DIRECT SUPERVISION AND THAT I AM A DULY LICENSED PROFESSIONAL ENGINEER UNDER THE LAWS OF THE STATE OF MINNESOTA.

SIGNATURE \_\_\_\_\_ DATE \_\_\_\_\_  
 PRINTED NAME TERRY J. MAUER LIC. NO. 15316

NO.	DATE	BY	REVISION DESCRIPTION

1326 ENERGY PARK DRIVE  
 ST. PAUL, MINNESOTA 55108  
 (651) 644-4389

**Howard R. Green Company**  
 CONSULTING ENGINEERS

CITY OF ELK RIVER  
 THE WOODS OF HILLSIDE III  
 STREET AND UTILITY IMPROVEMENTS

BALDWIN COURT  
 STREET AND UTILITY IMPROVEMENTS

0+00 TO 1+70.13

SHEET NO.  
**P4**

WOODS 02