
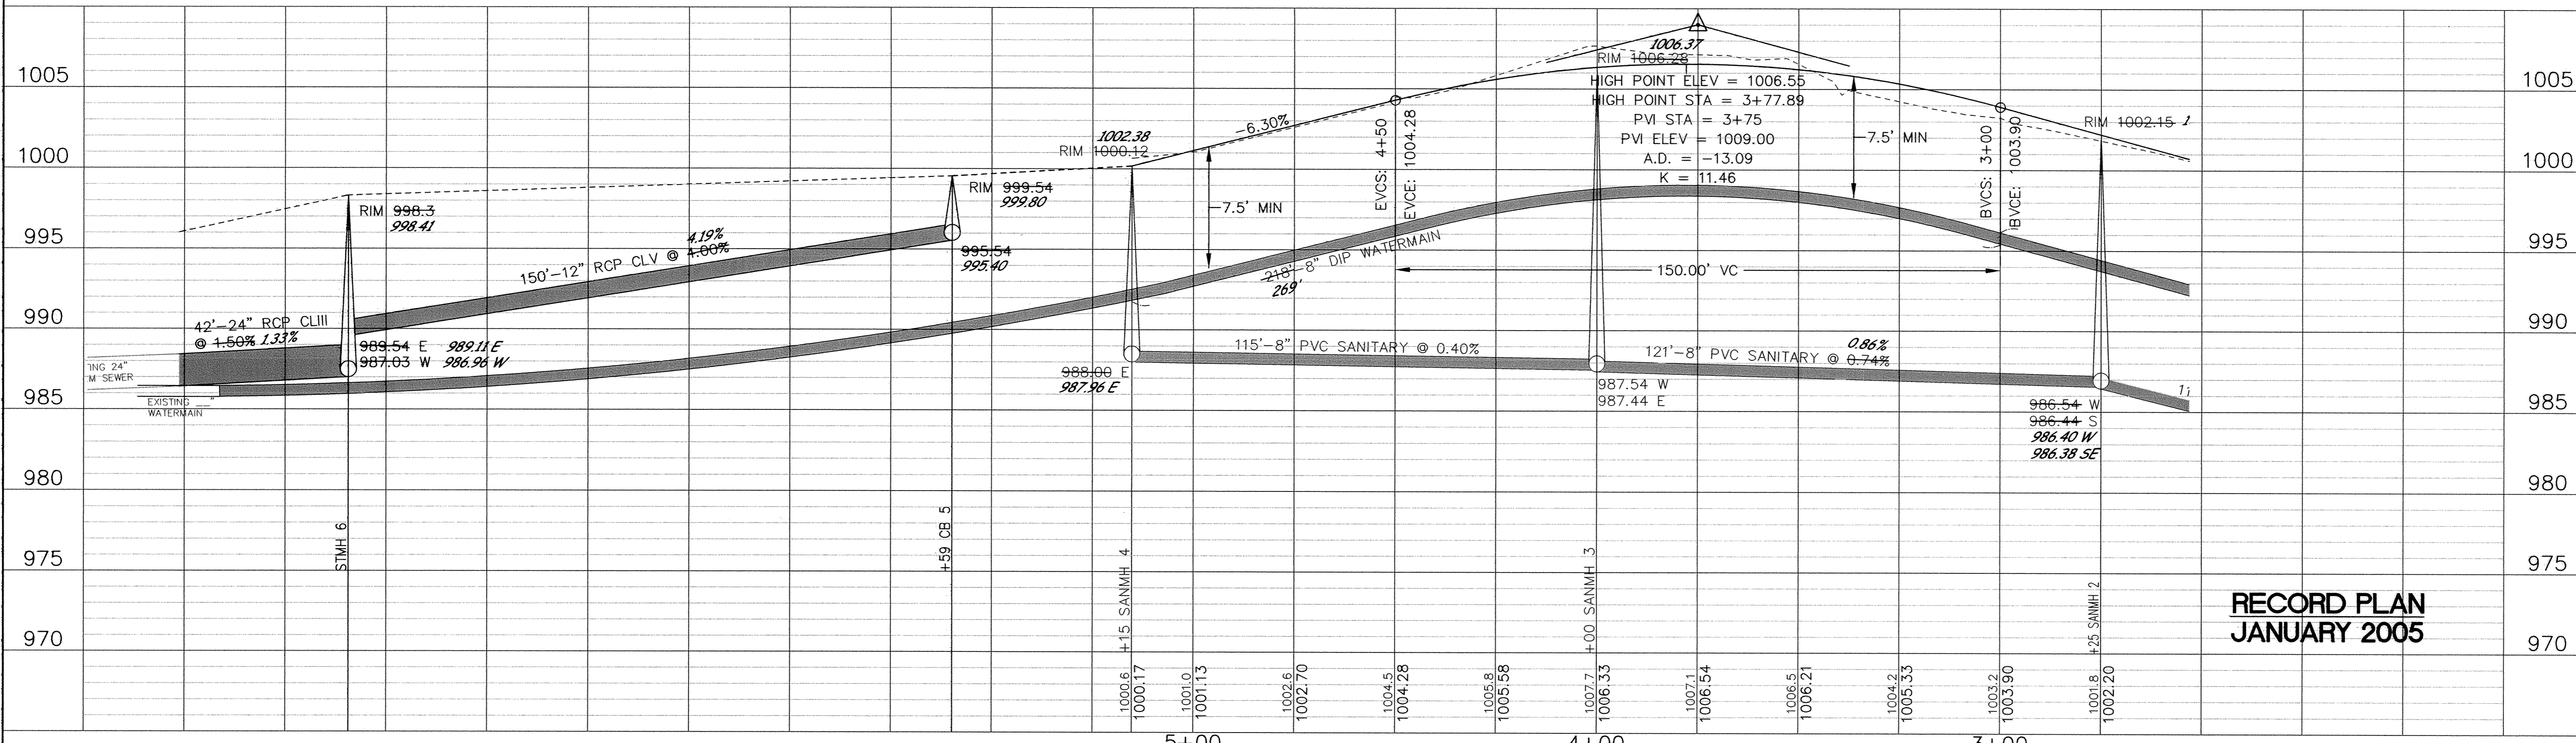
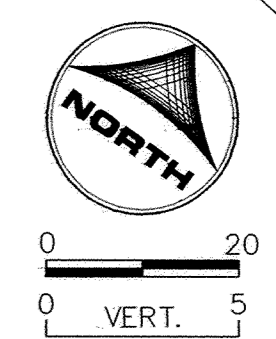


XAVIER COURT

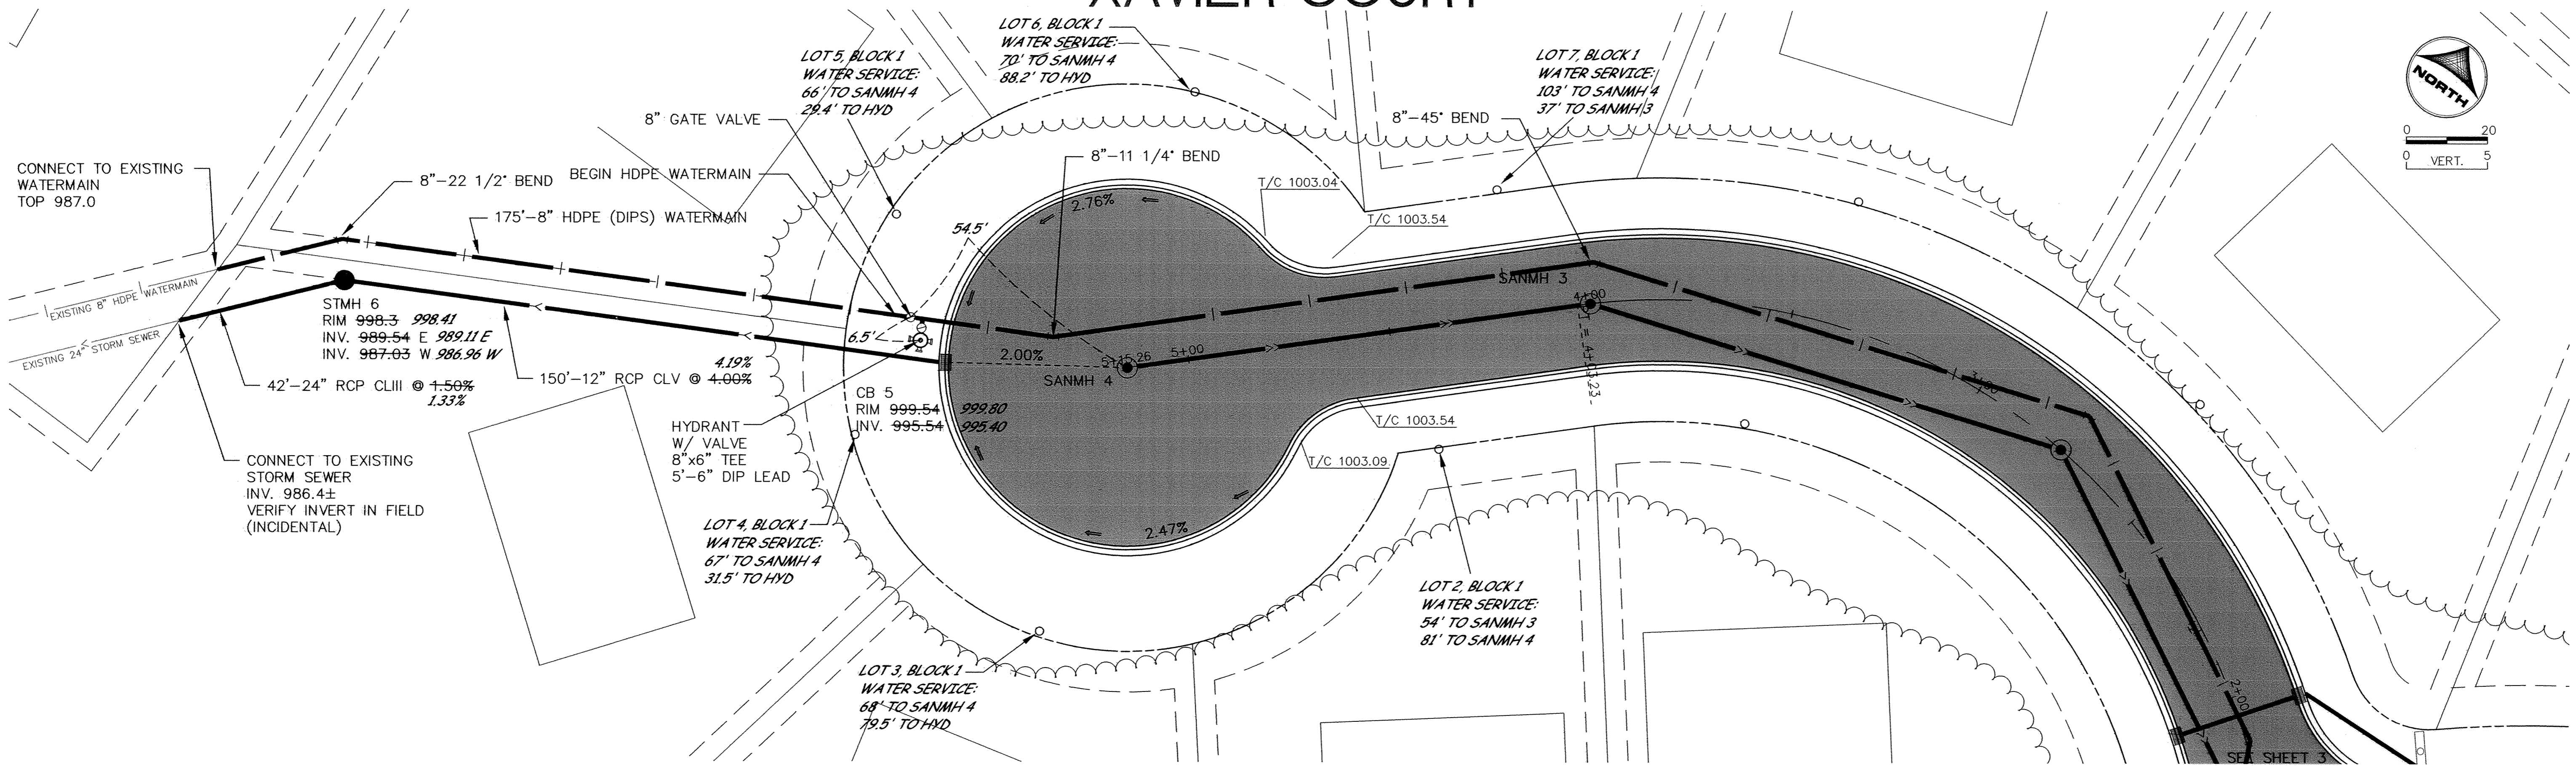

**RECORD PLAN
JANUARY 2005**

DESIGNED BY: DESIGNED BY: DRAWN BY: RKM
 APPROVED BY: APPROVED BY: JOB NUMBER: 811388J
 CAD DATE: January 12, 2005 3:18:06 p.m.
 CAD FILE: 811388J\As-Built\Drawings\CT-D02.DWG (JUN)

I HEREBY CERTIFY THAT THIS PLAN, SPECIFICATION, OR REPORT WAS PREPARED BY ME OR UNDER MY DIRECT SUPERVISION AND THAT I AM A DULY LICENSED PROFESSIONAL ENGINEER UNDER THE LAWS OF THE STATE OF MINNESOTA.
 SIGNATURE: *John M. Anderson* DATE: 2/2/05
 PRINTED NAME: JOHN M. ANDERSON LIC. NO.: 25889

NO.	DATE	BY	REVISION DESCRIPTION

1326 ENERGY PARK DRIVE
 ST. PAUL, MINNESOTA 55108
 (651) 644-4389

Howard R. Green Company

**THE WOODS OF HILLSIDE IV
 CITY OF ELK RIVER**

**PLAN AND PROFILE
 XAVIER COURT**
 3+00 TO 5+15.26

SHEET NO.
4

DRAWING NUMBER
 WOODS4.05
 4
 SACO PRODUCTS • NEW HOPE, MINNESOTA
 REPRODUCED BY PLAN NUMBER 8552
 PROVISIONAL DRAWING OF HILLSIDE IV