

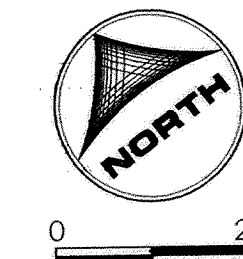


NOTE:
REFER TO SPECIFICATIONS
FOR POND RESHAPING AND
RESTORATION AND DETAILS.

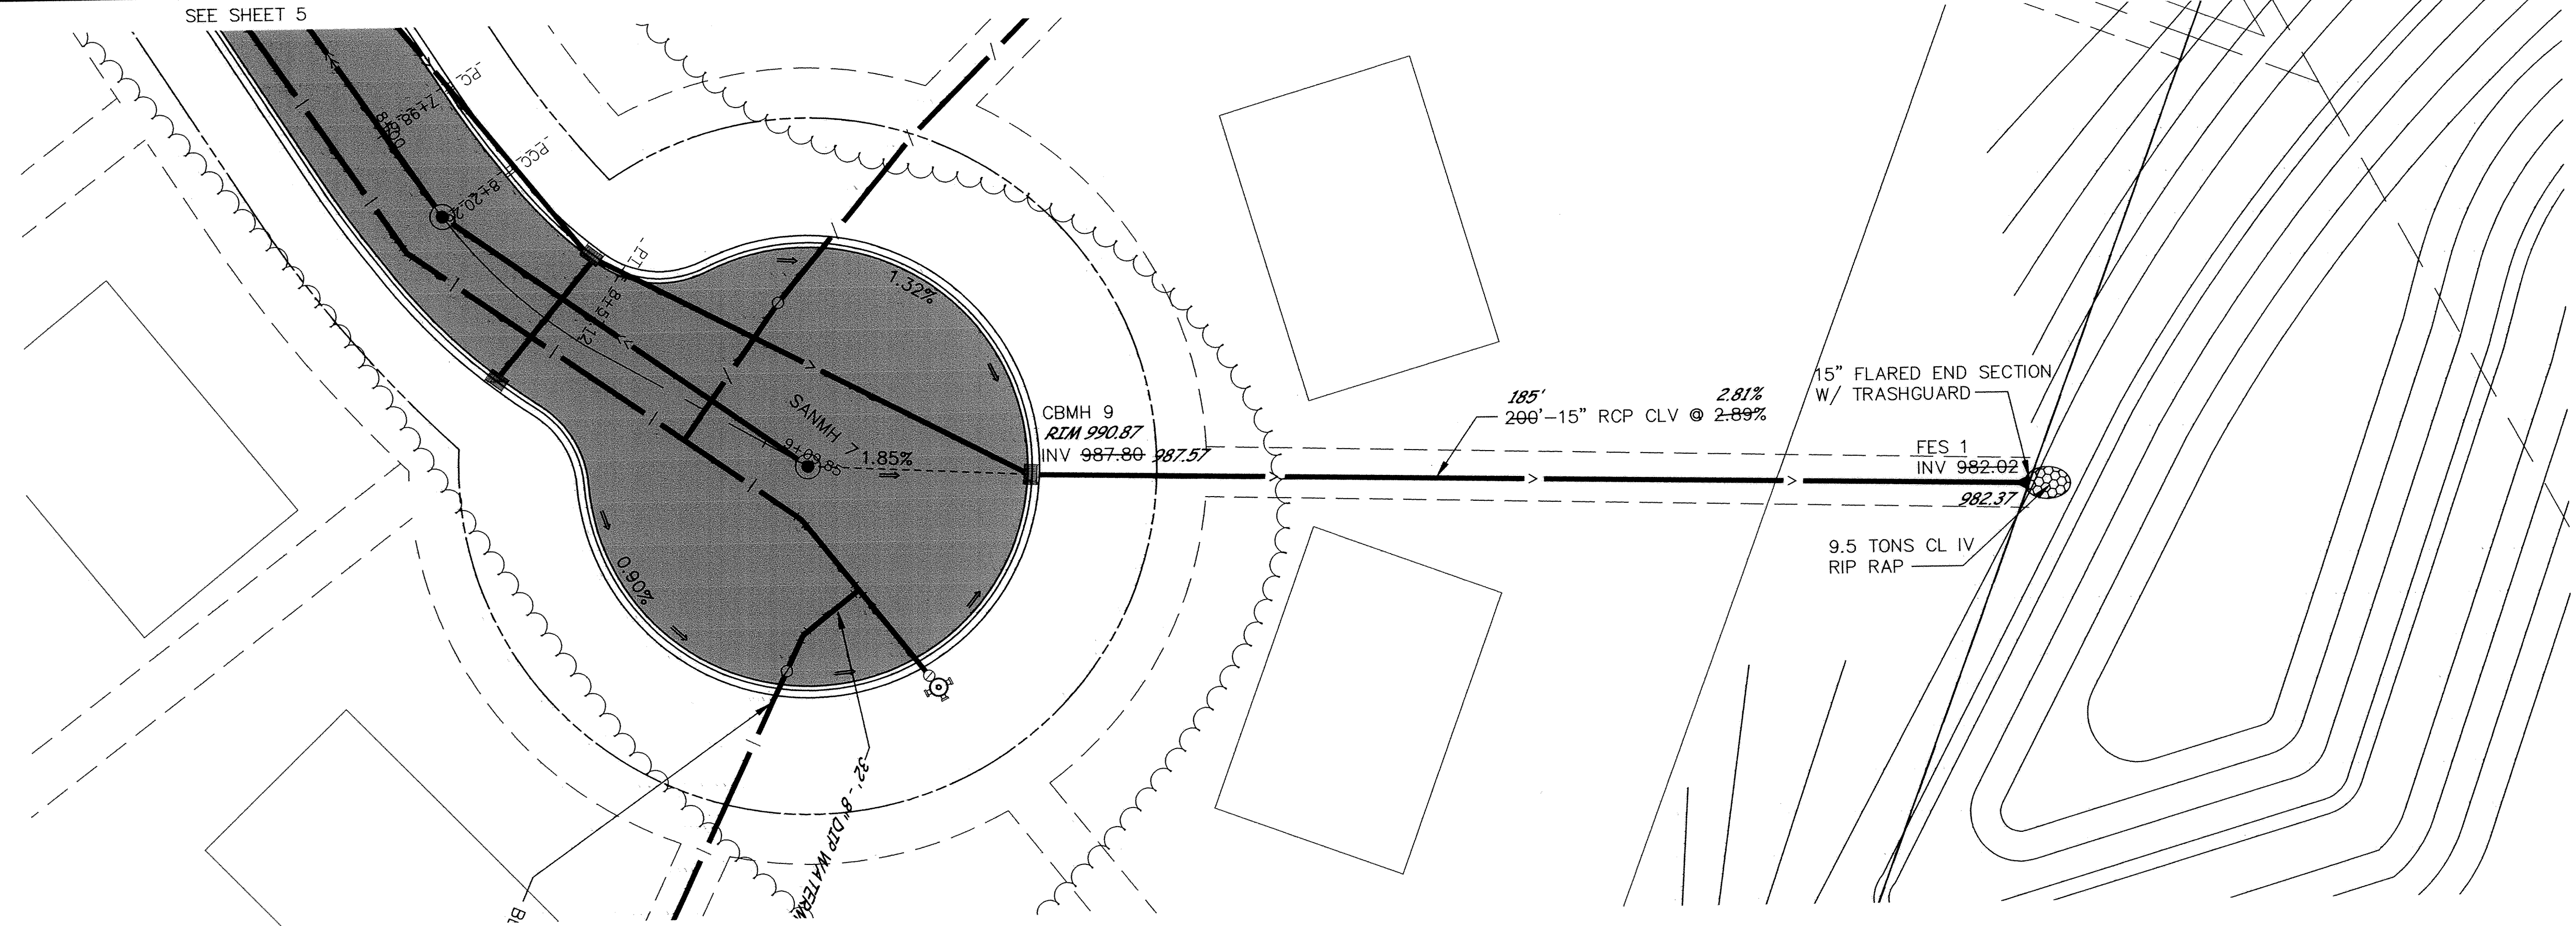


RECORD PLAN
JANUARY 2005

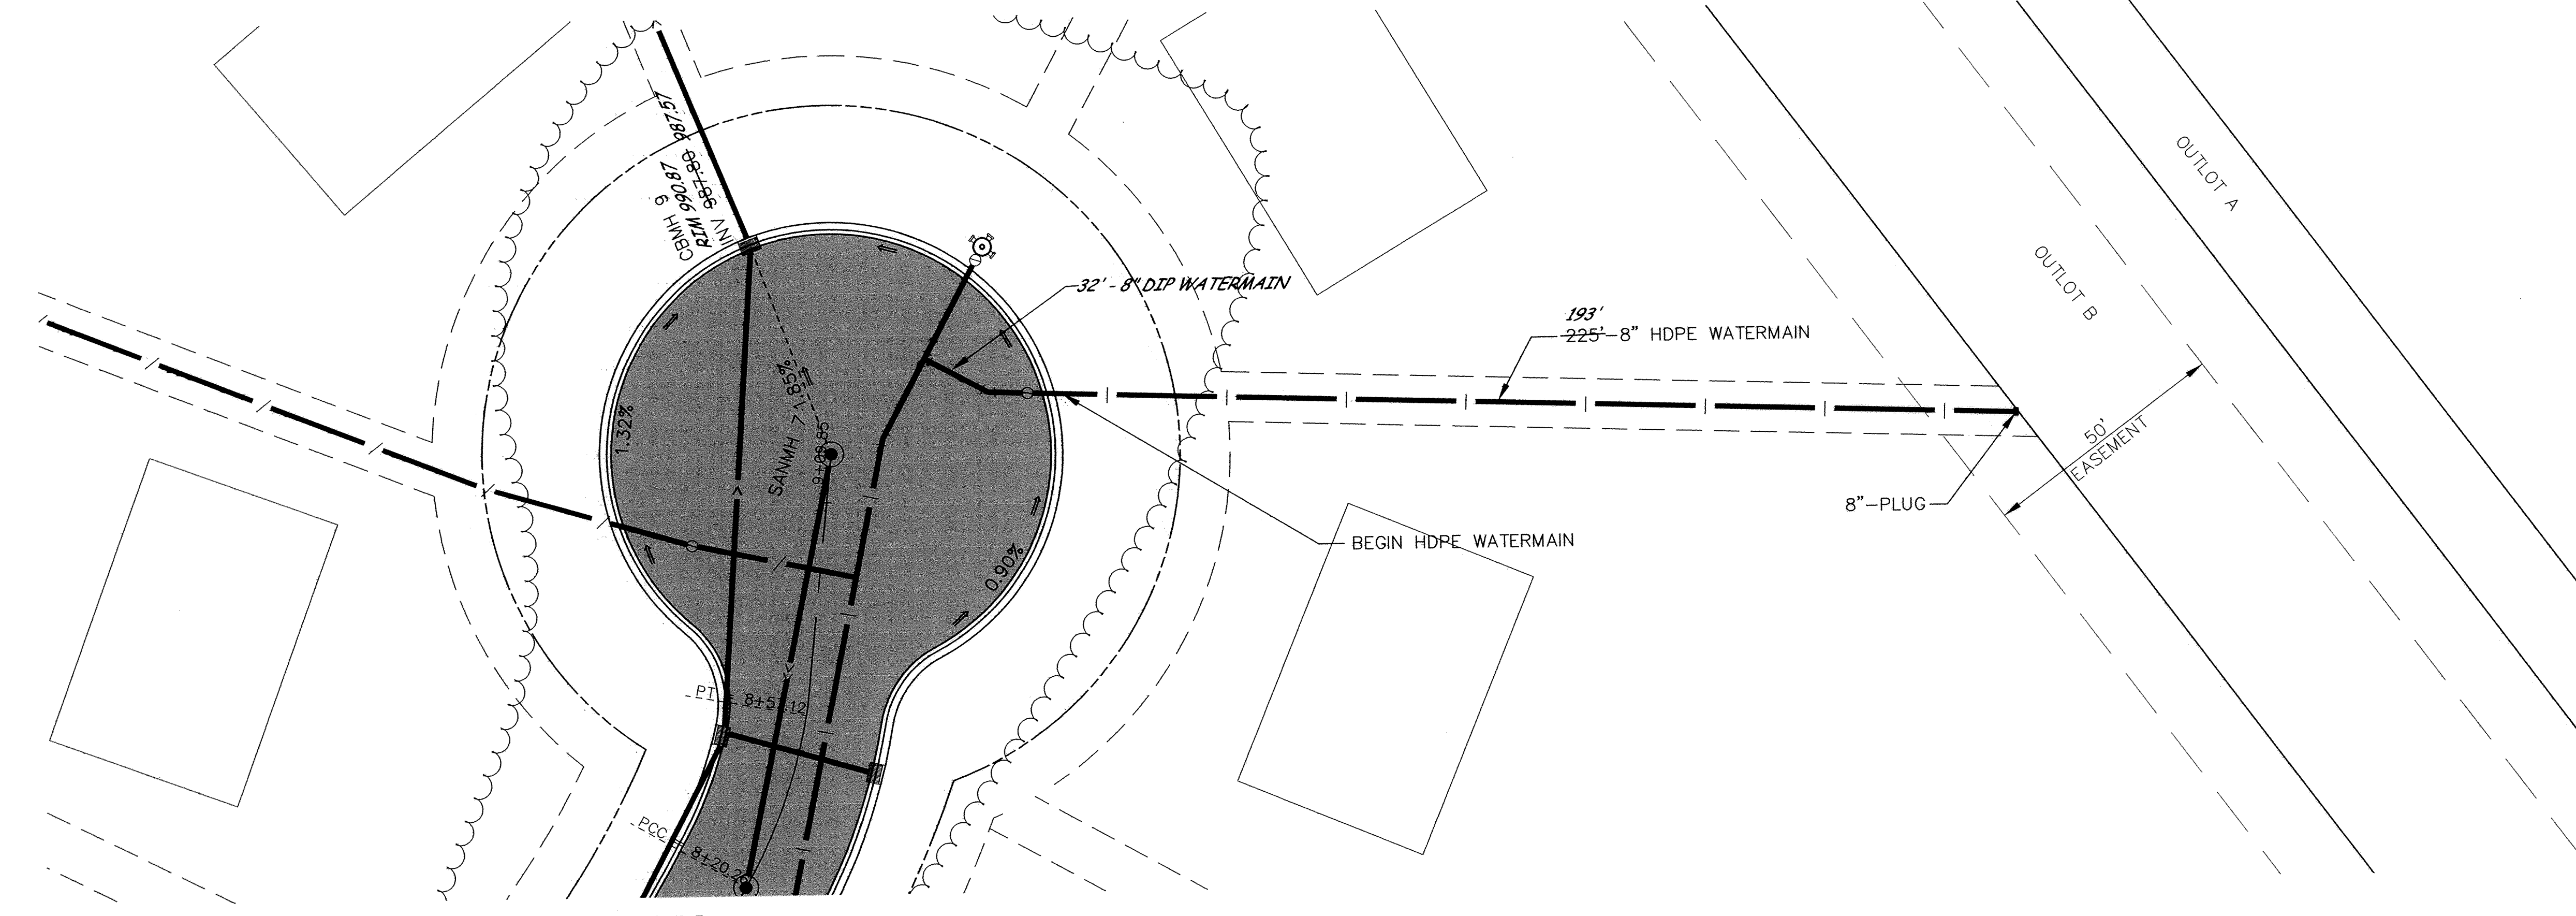

DESIGNED BY: DESIGNED BY DRAWN BY: RKM
 APPROVED BY: APPROVED BY JOB NUMBER 811388J
 CAD DATE: January 13, 2005 10:06:52 a.m.
 CAD FILE: 811388J\As-Built\Drawings\CT-D04.DWG (JCJ)

I HEREBY CERTIFY THAT THIS PLAN, SPECIFICATION, OR REPORT
 WAS PREPARED BY ME OR UNDER MY DIRECT SUPERVISION AND
 THAT I AM A DULY LICENSED PROFESSIONAL ENGINEER UNDER
 THE LAWS OF THE STATE OF MINNESOTA.
 SIGNATURE: [Signature] DATE: 2/2/05
 PRINTED NAME: JOHN M. ANDERSON LIC. NO.: 25889

NO.	DATE	BY	REVISION DESCRIPTION

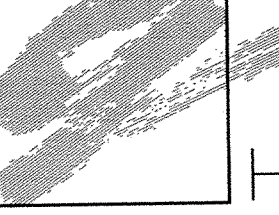
Howard R. Green Company
 1326 ENERGY PARK DRIVE
 ST. PAUL, MINNESOTA 55108
 (651) 644-4389

THE WOODS OF HILLSIDE IV
CITY OF ELK RIVER

UTILITY EXTENSIONS

SHEET NO.
6