




SACO PRODUCTS • NEW HOPE, MINNESOTA  
REORDER BY PART NUMBER 8552  
FURNISH TO ORDER OF OWNER OR TRAILER

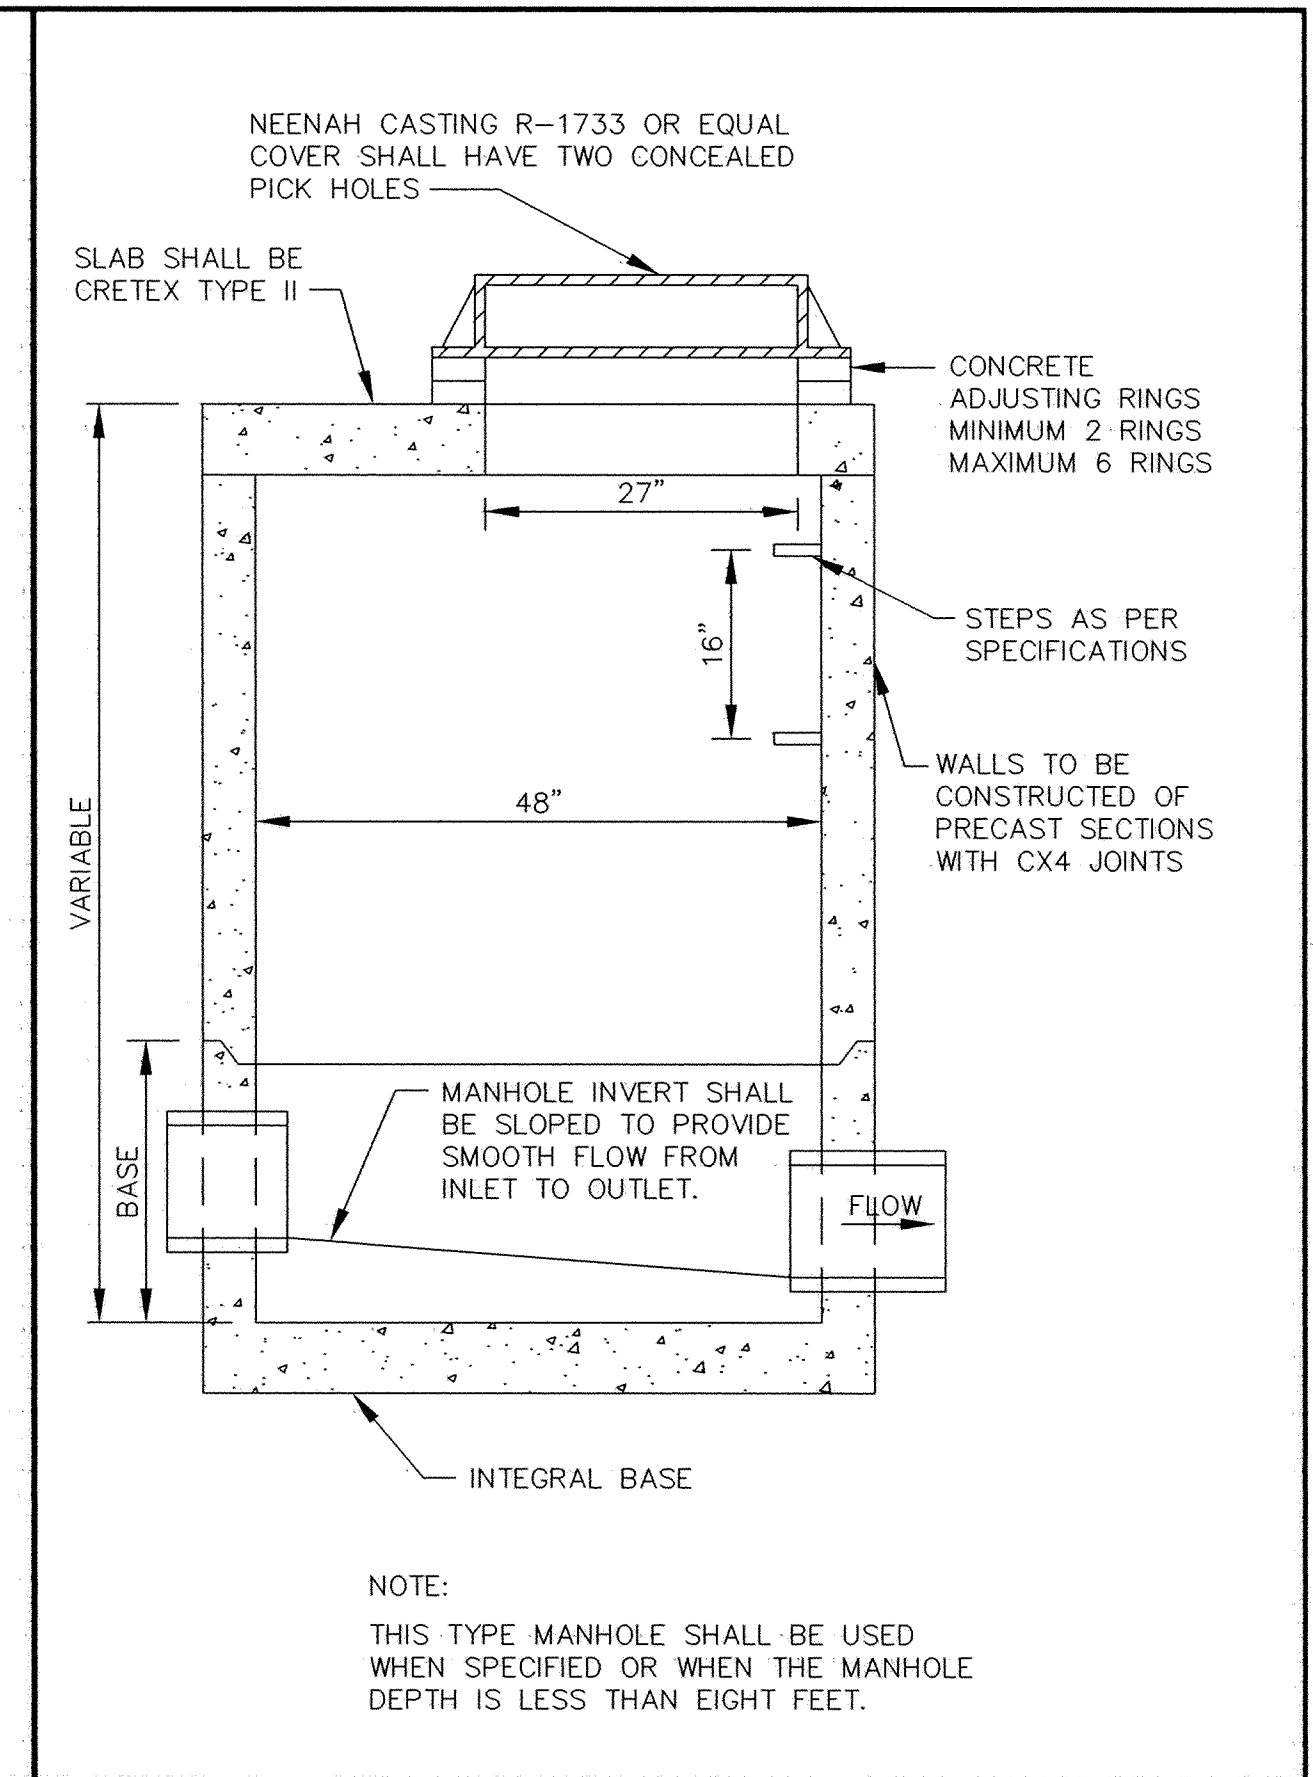


SLAB TOP MANHOLE

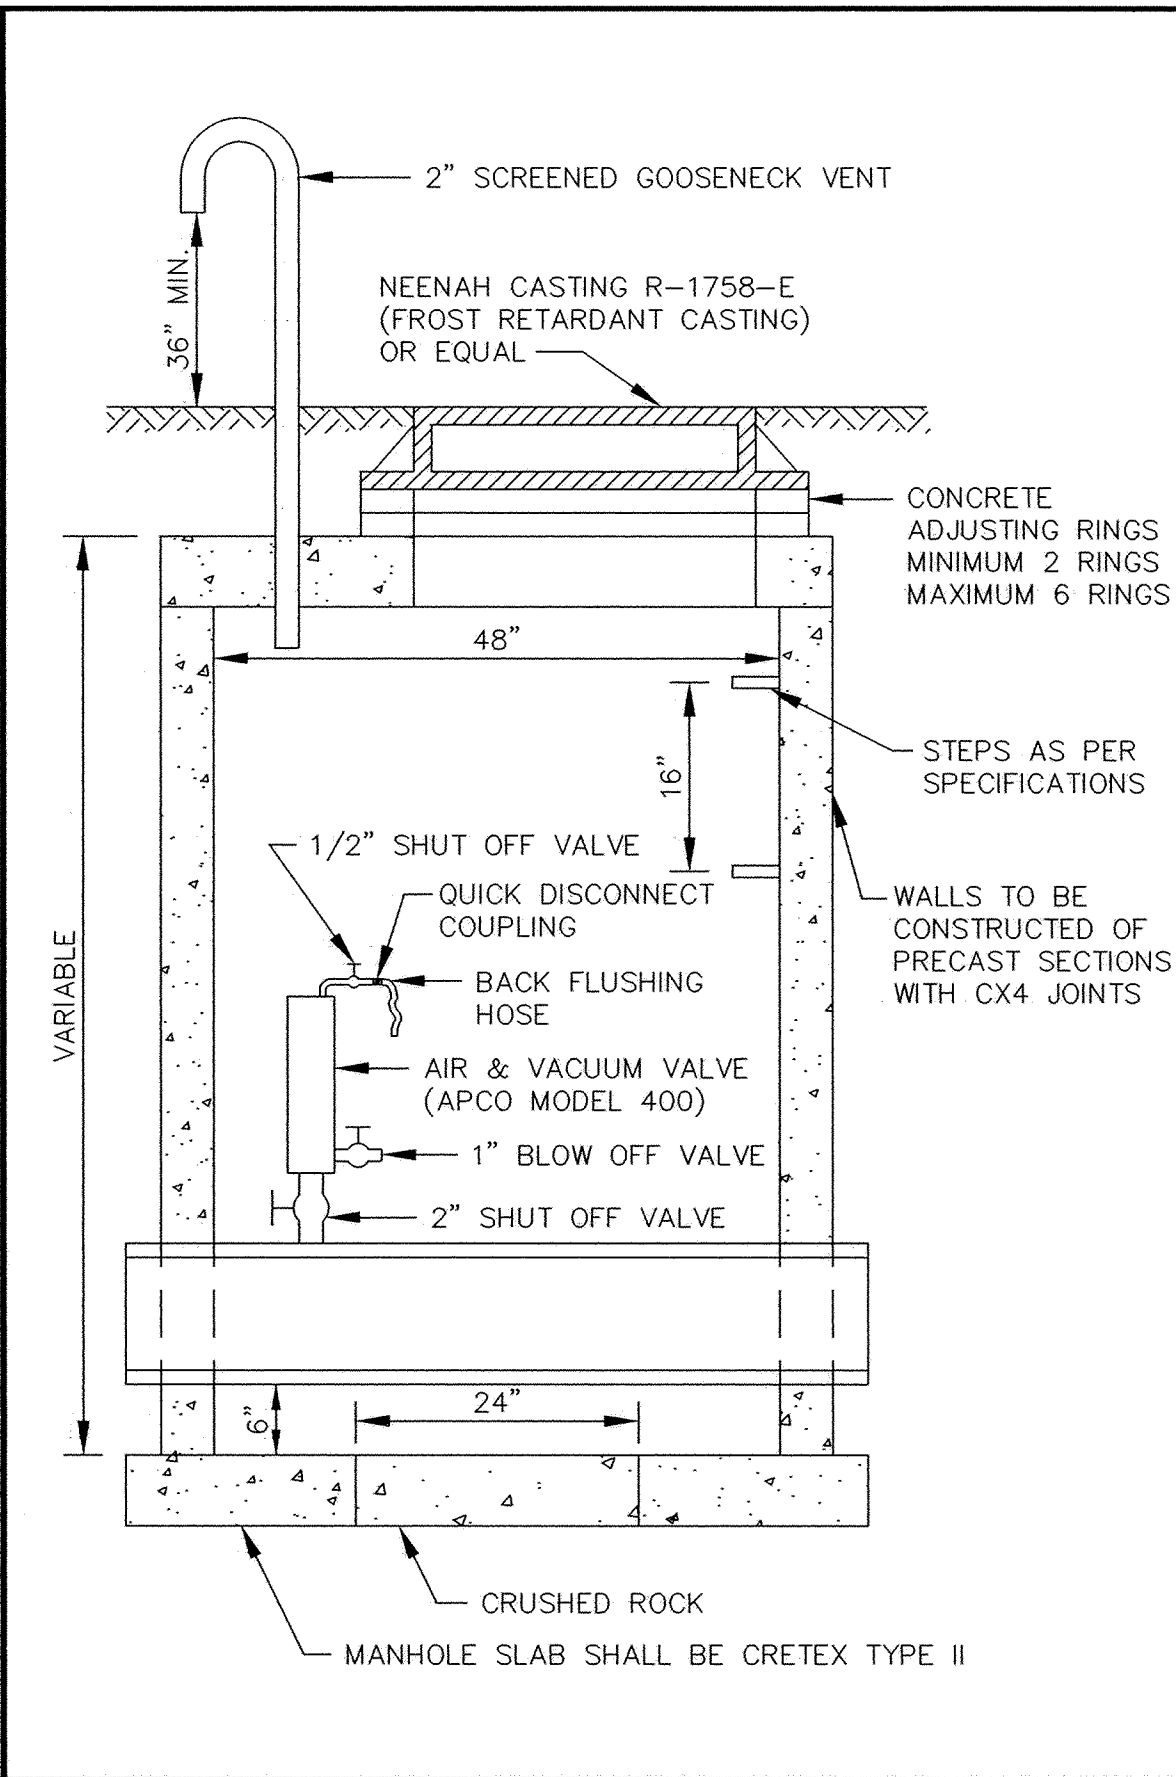


STANDARD AIR RELIEF MANHOLE

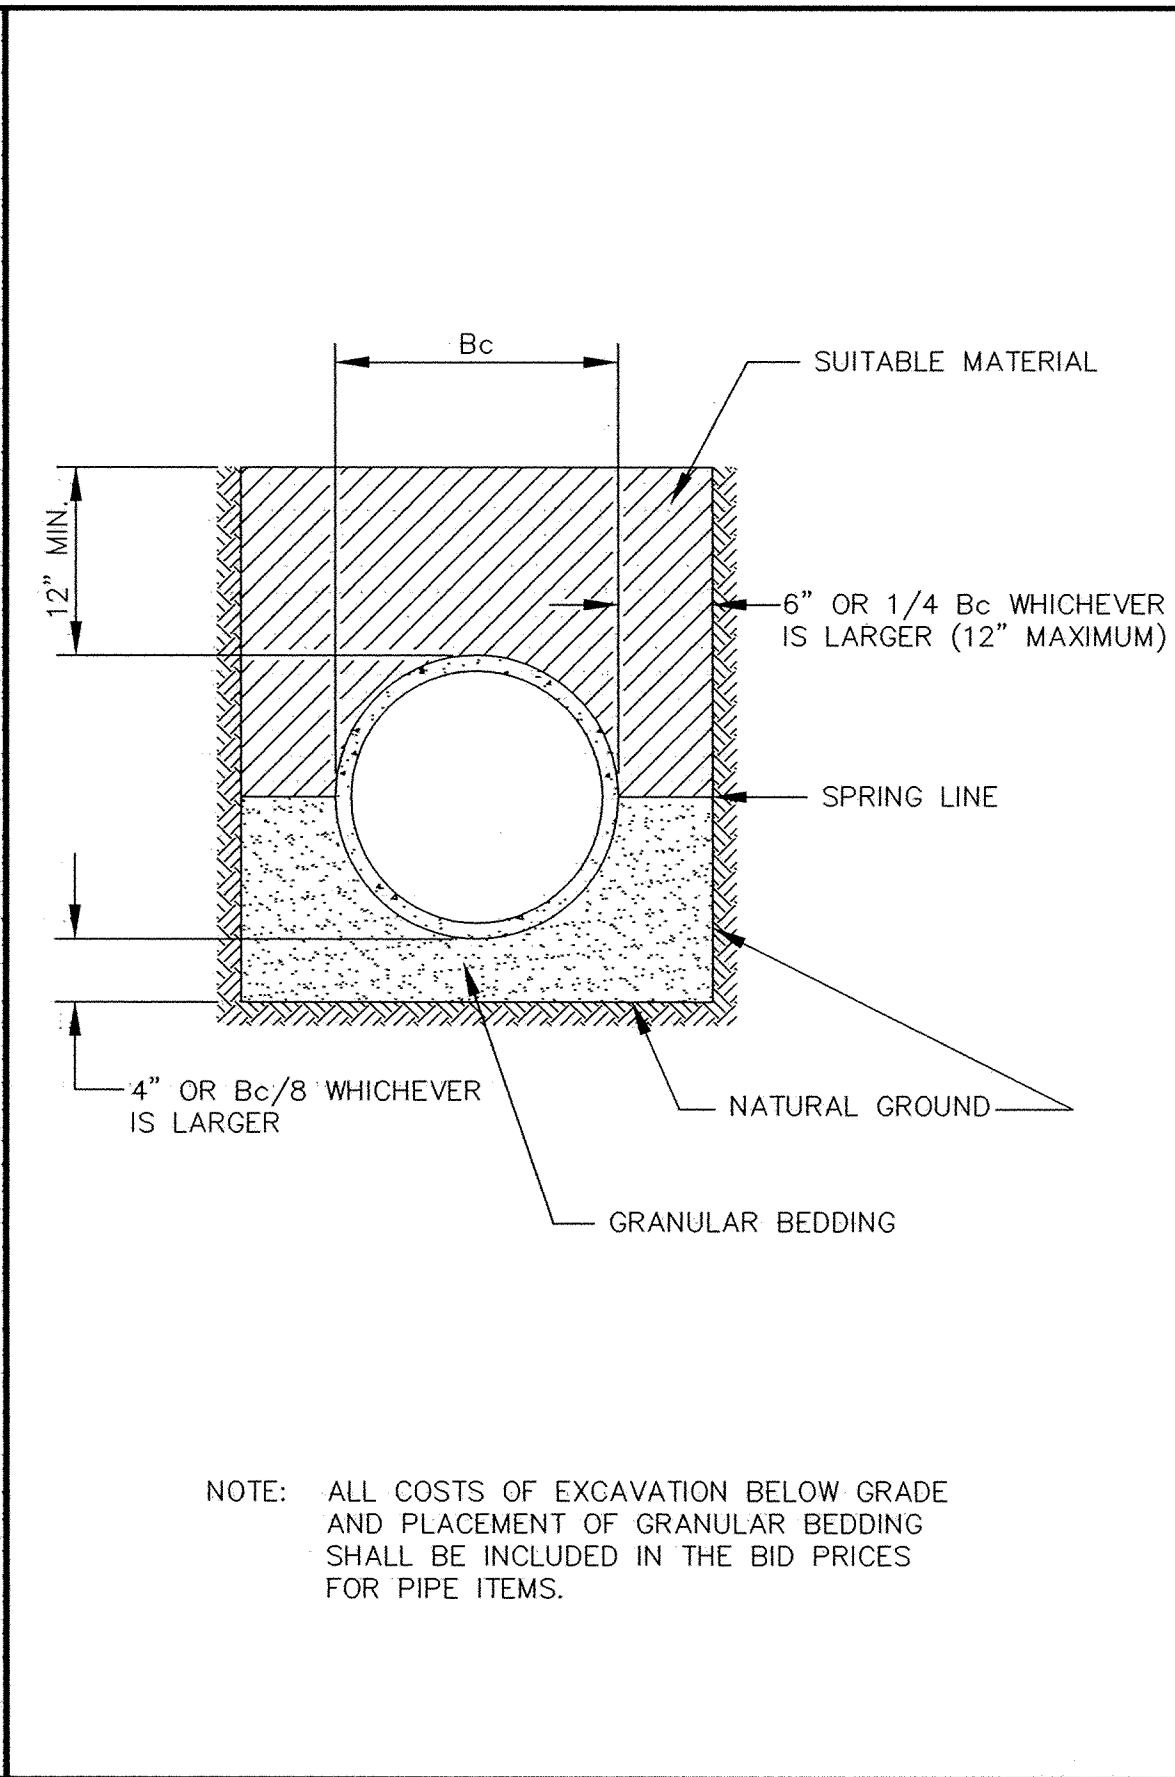


CLASS B PIPE BEDDING

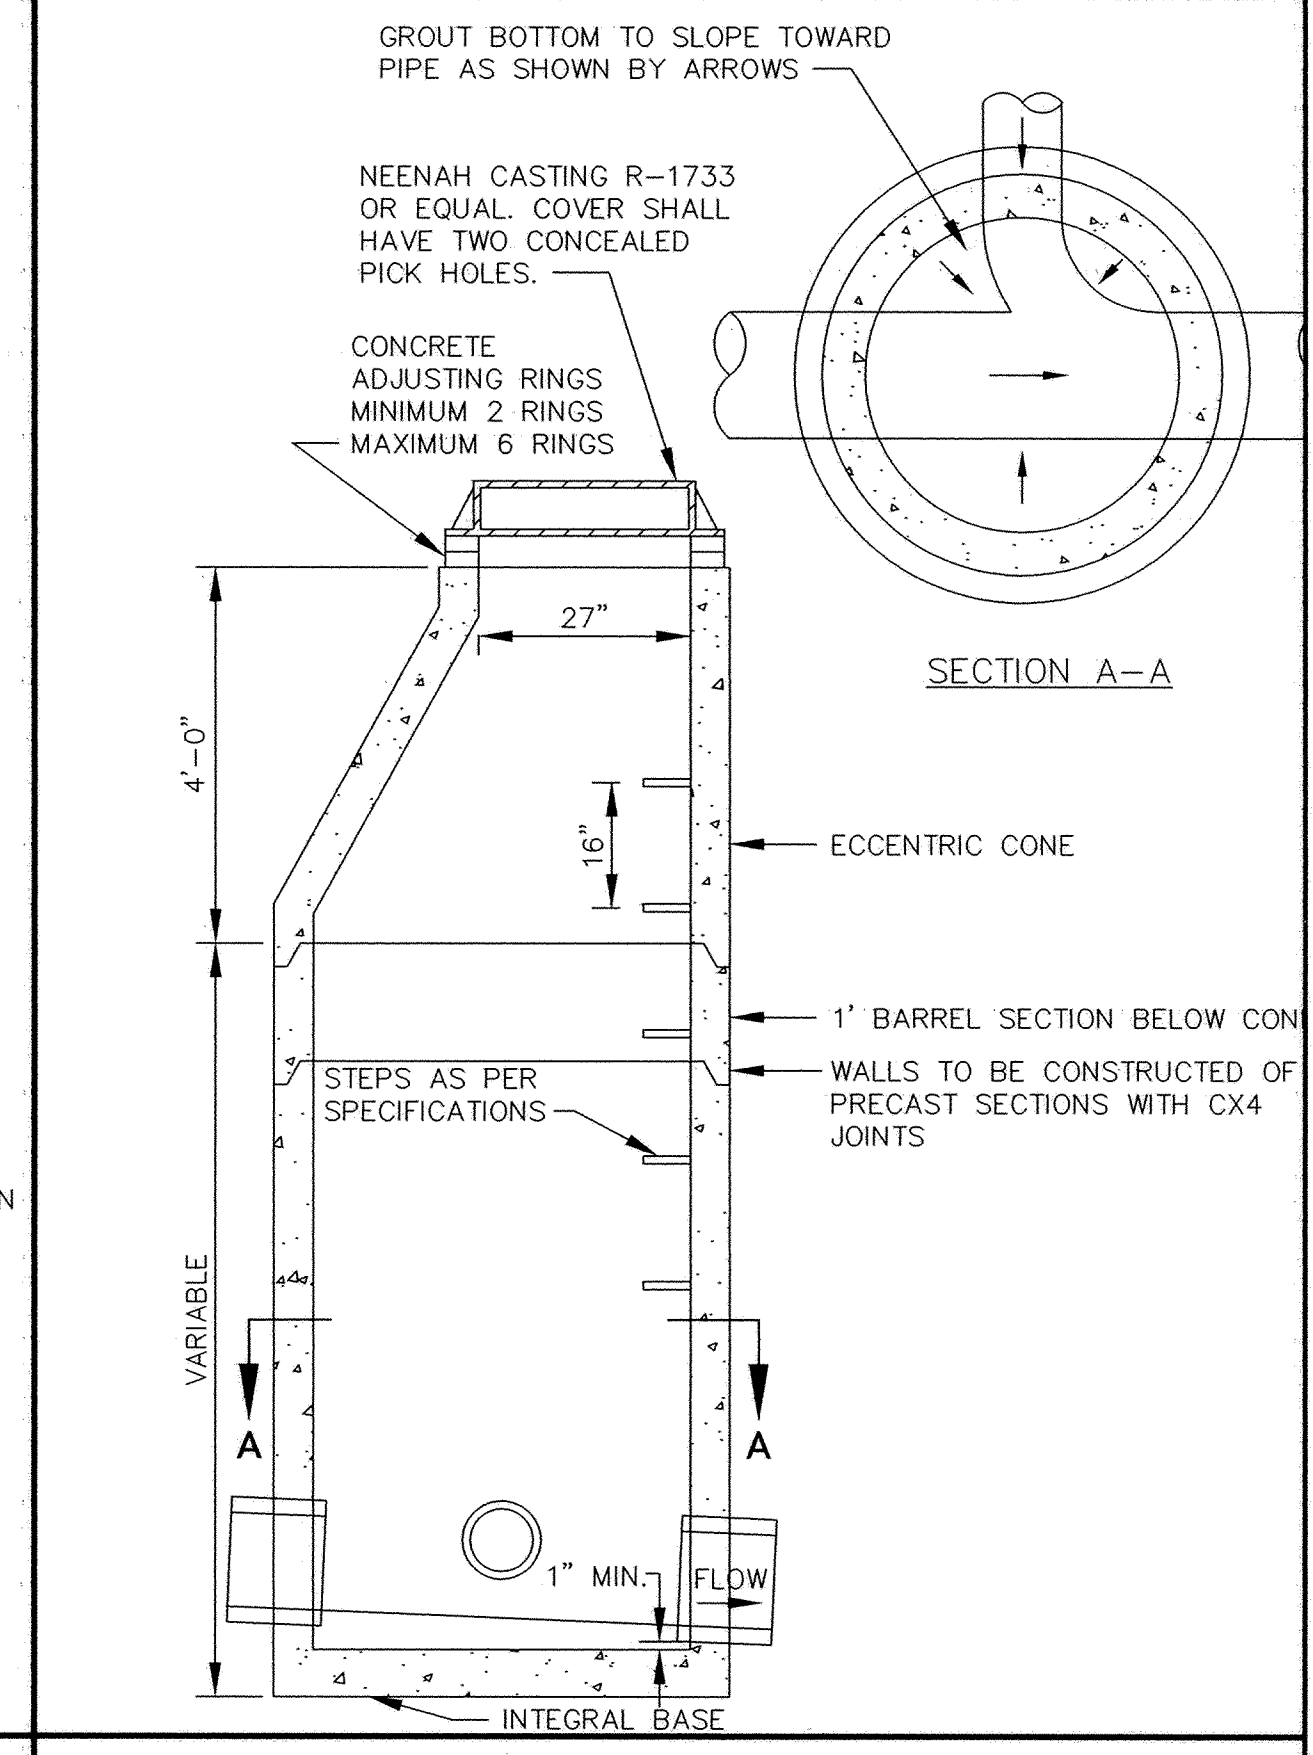

STANDARD MANHOLE

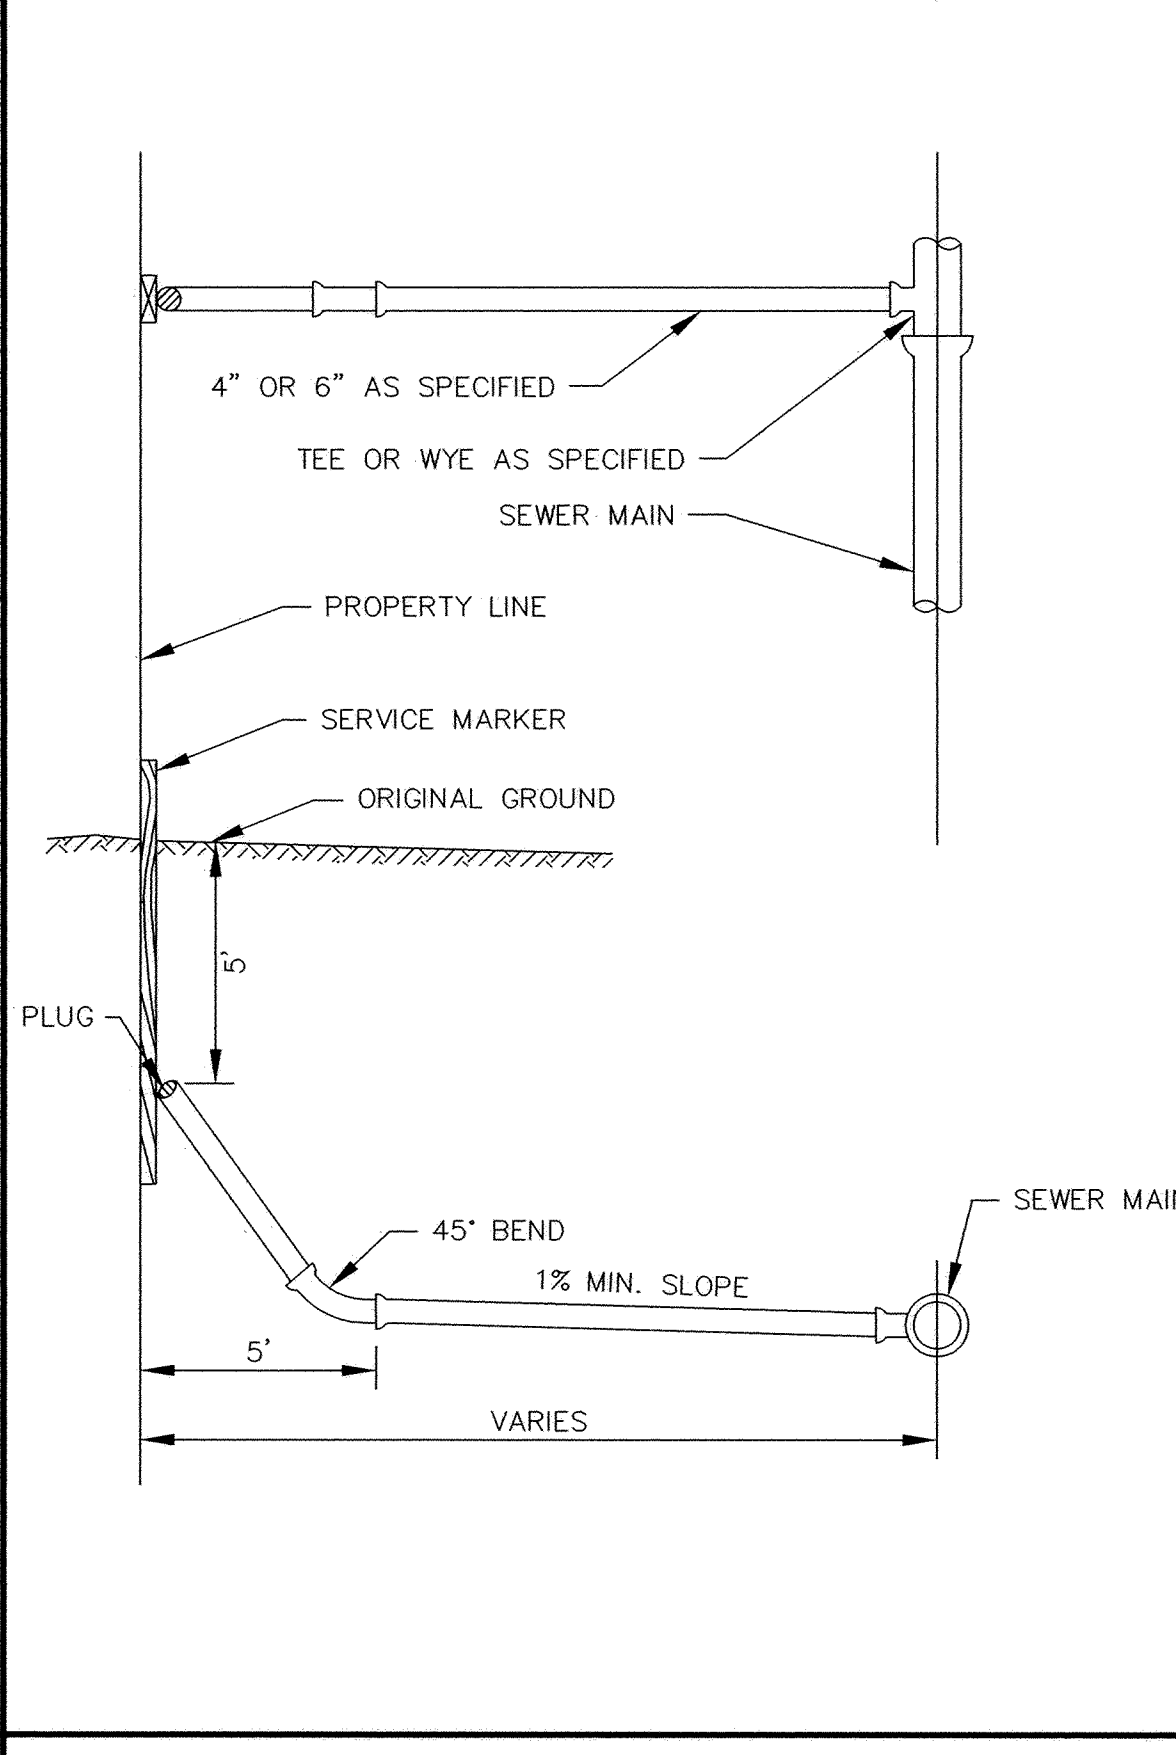

TYPICAL HOUSE SERVICE

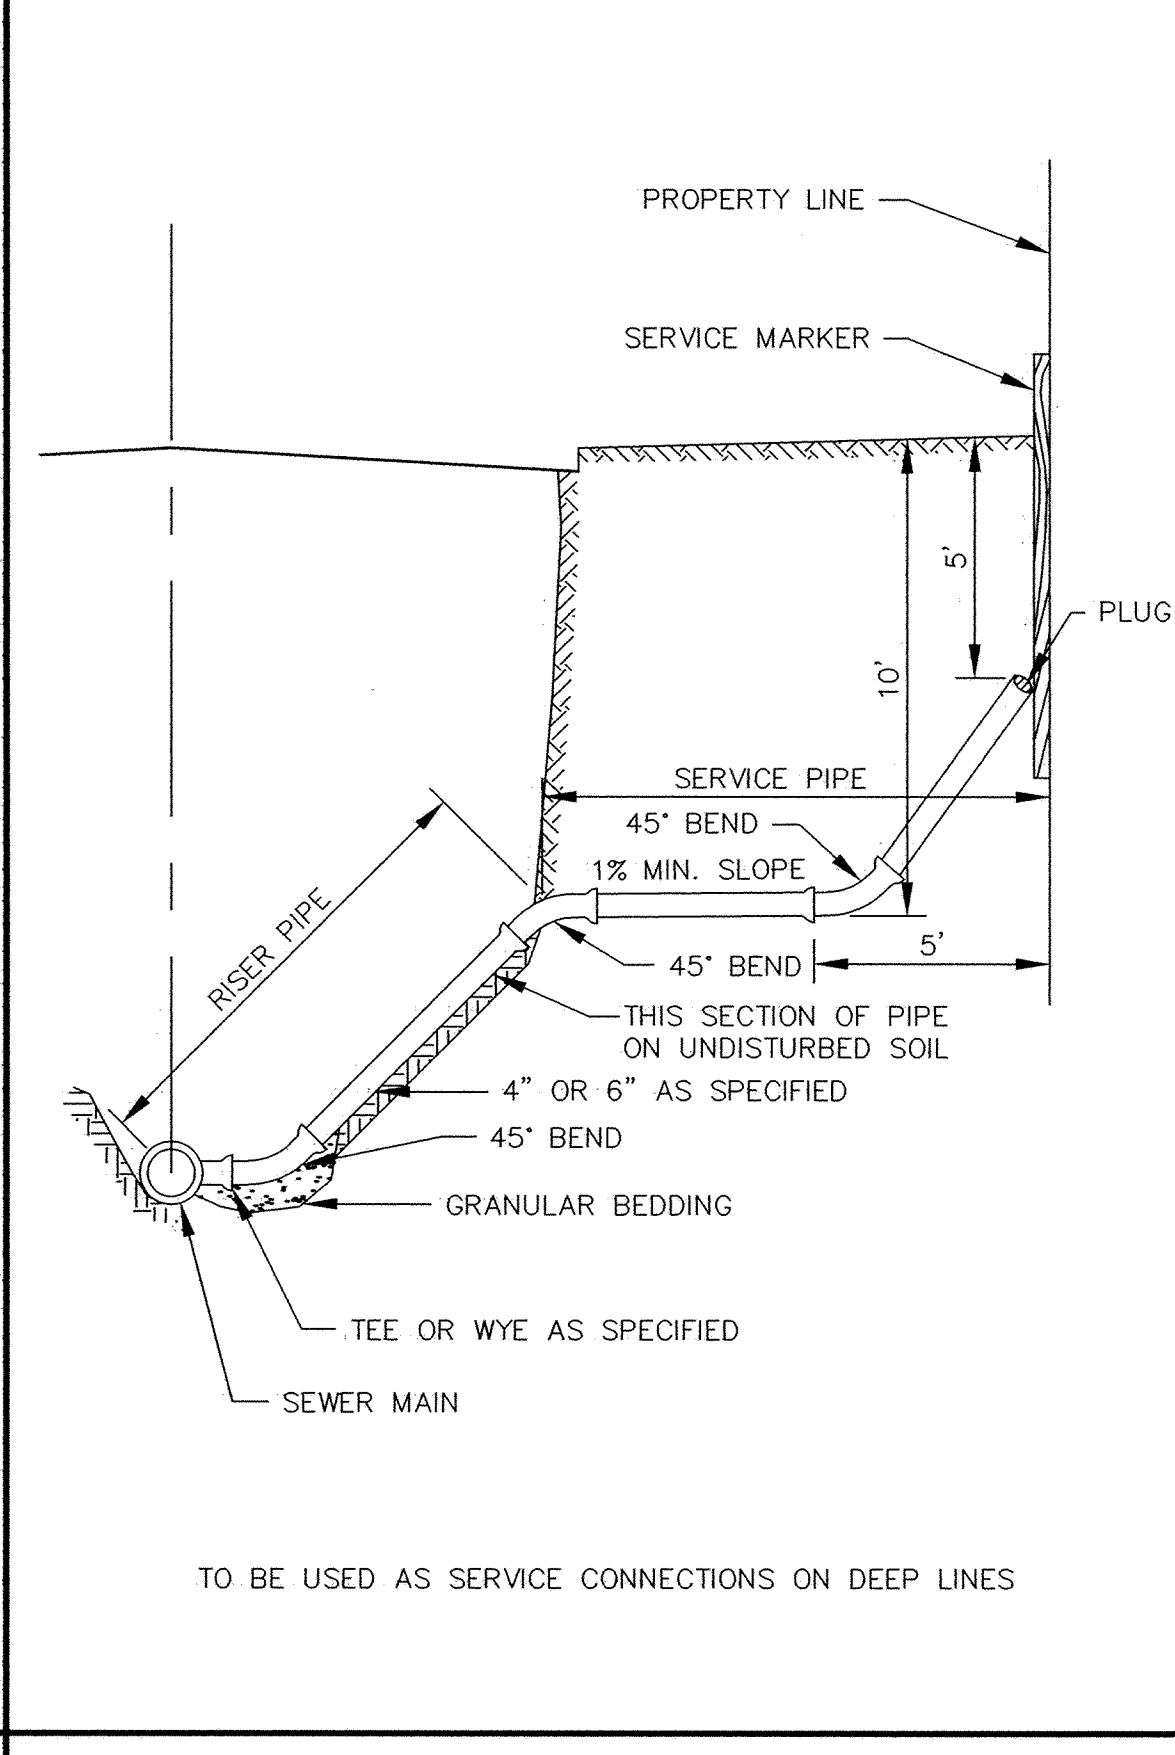

SERVICE RISER SECTION

DESIGNED BY: DESIGNED BY DRAWN BY: RKM  
APPROVED BY: APPROVED BY JOB NUMBER 811388J  
CAD DATE: January 13, 2005 10:58:07 a.m.  
CAD FILE: 811388J\As-Built\Dwgs\C\CT-U01.DWG (JCM)

I HEREBY CERTIFY THAT THIS PLAN, SPECIFICATION, OR REPORT WAS PREPARED BY ME OR UNDER MY DIRECT SUPERVISION AND THAT I AM A DULY LICENSED PROFESSIONAL ENGINEER UNDER THE LAWS OF THE STATE OF MINNESOTA.  
SIGNATURE \_\_\_\_\_ DATE \_\_\_\_\_  
PRINTED NAME JOHN M. ANDERSON LIC. NO. 25889

NO.	DATE	BY	REVISION DESCRIPTION

1326 ENERGY PARK DRIVE  
ST. PAUL, MINNESOTA 55108  
(651) 644-4389  
**Howard R. Green Company**

THE WOODS OF HILLSIDE IV  
CITY OF ELK RIVER

SANITARY SEWER DETAILS

SHEET NO.  
**7**