
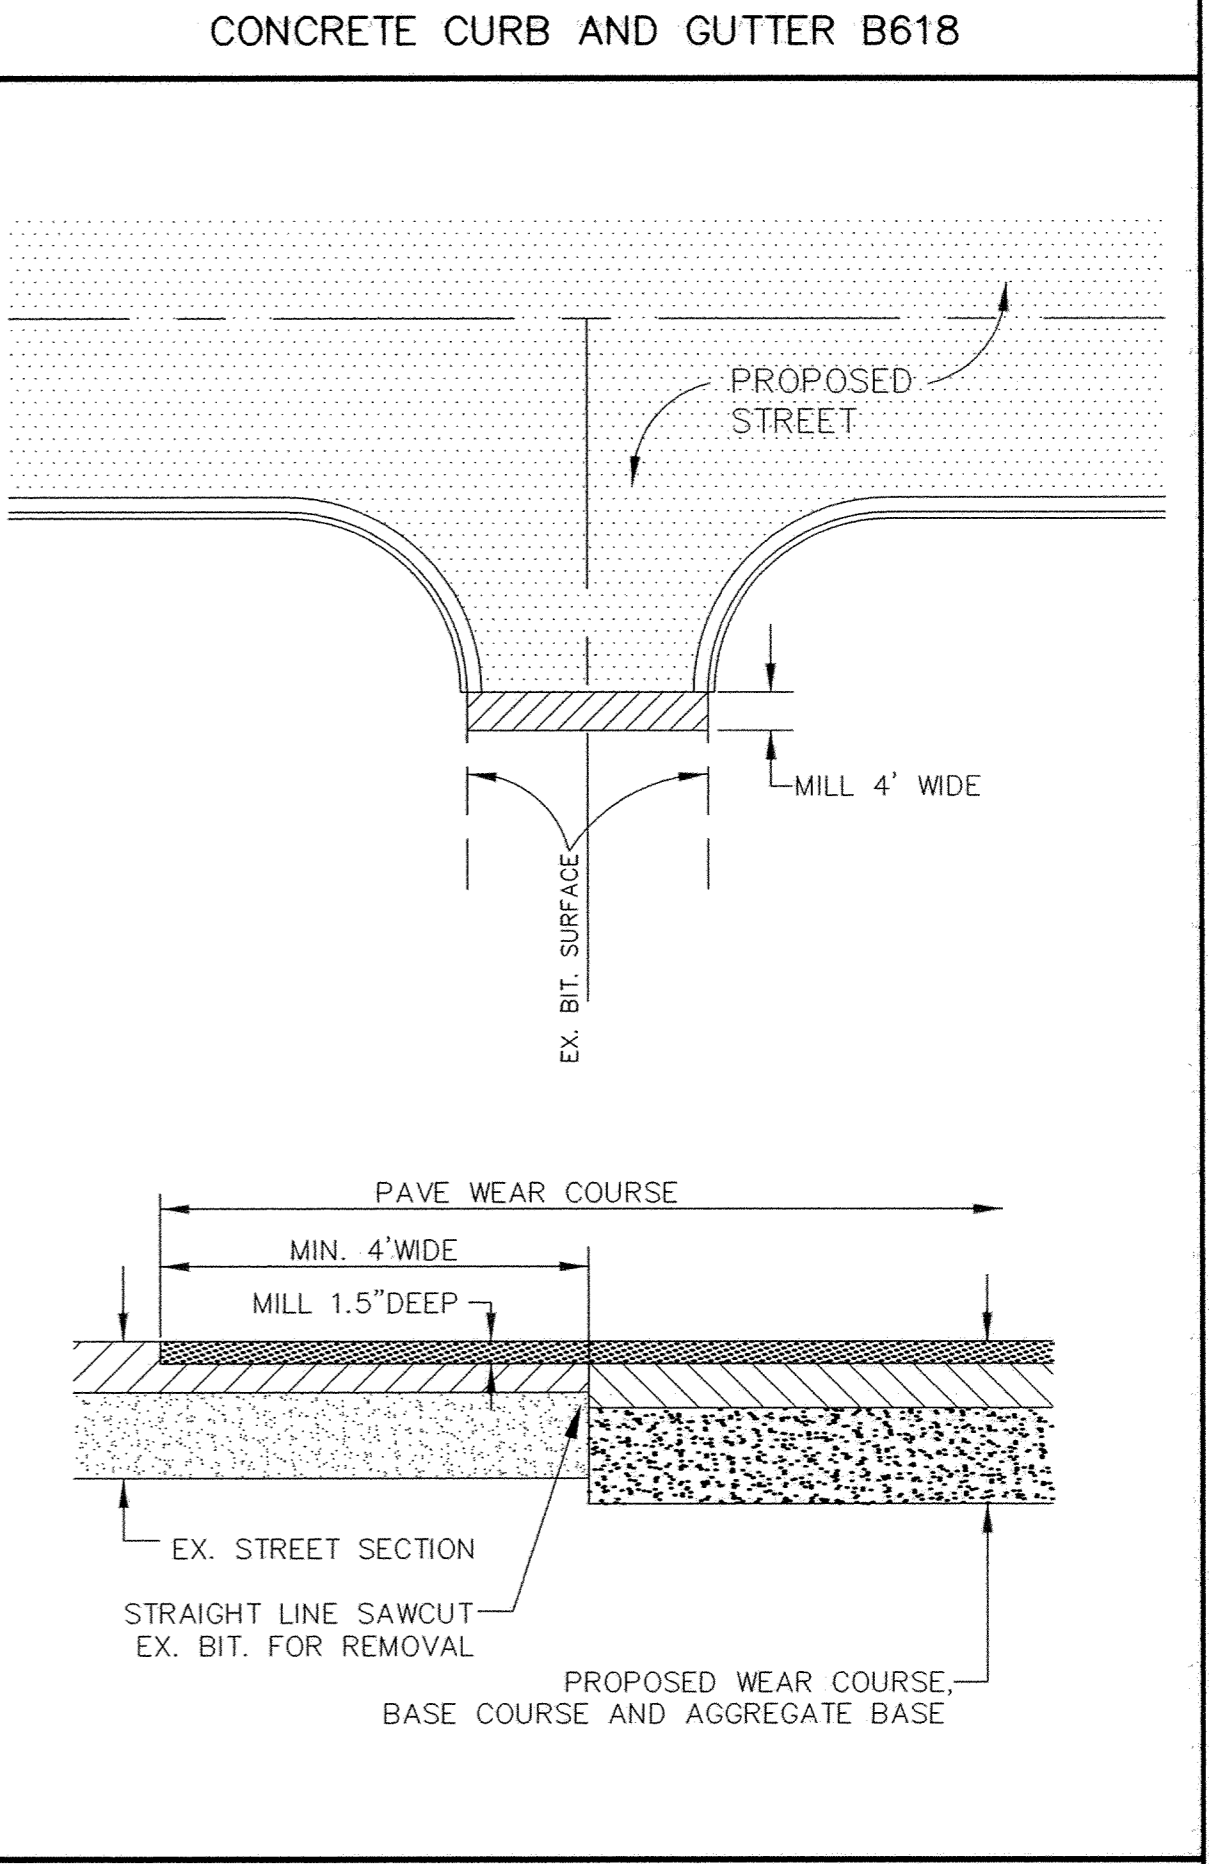
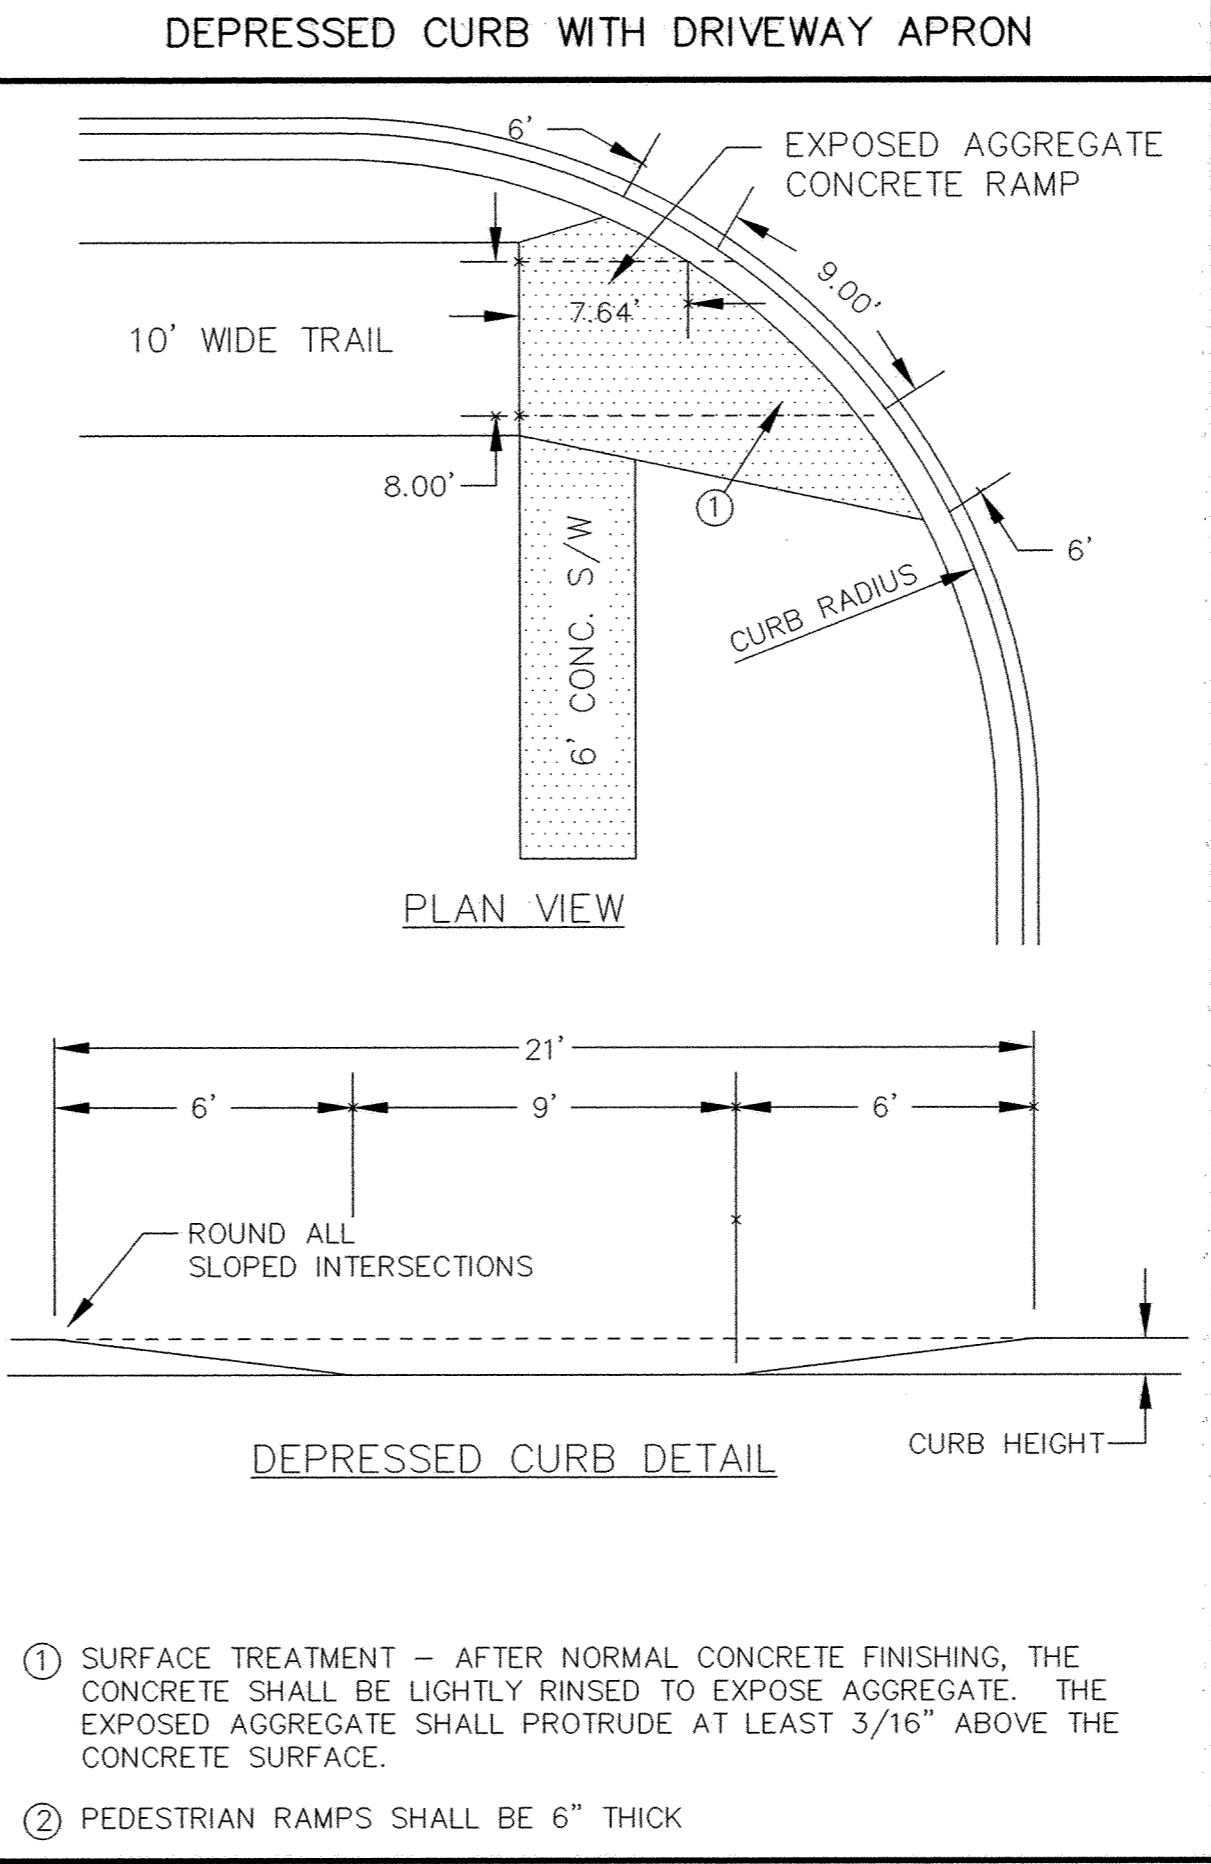
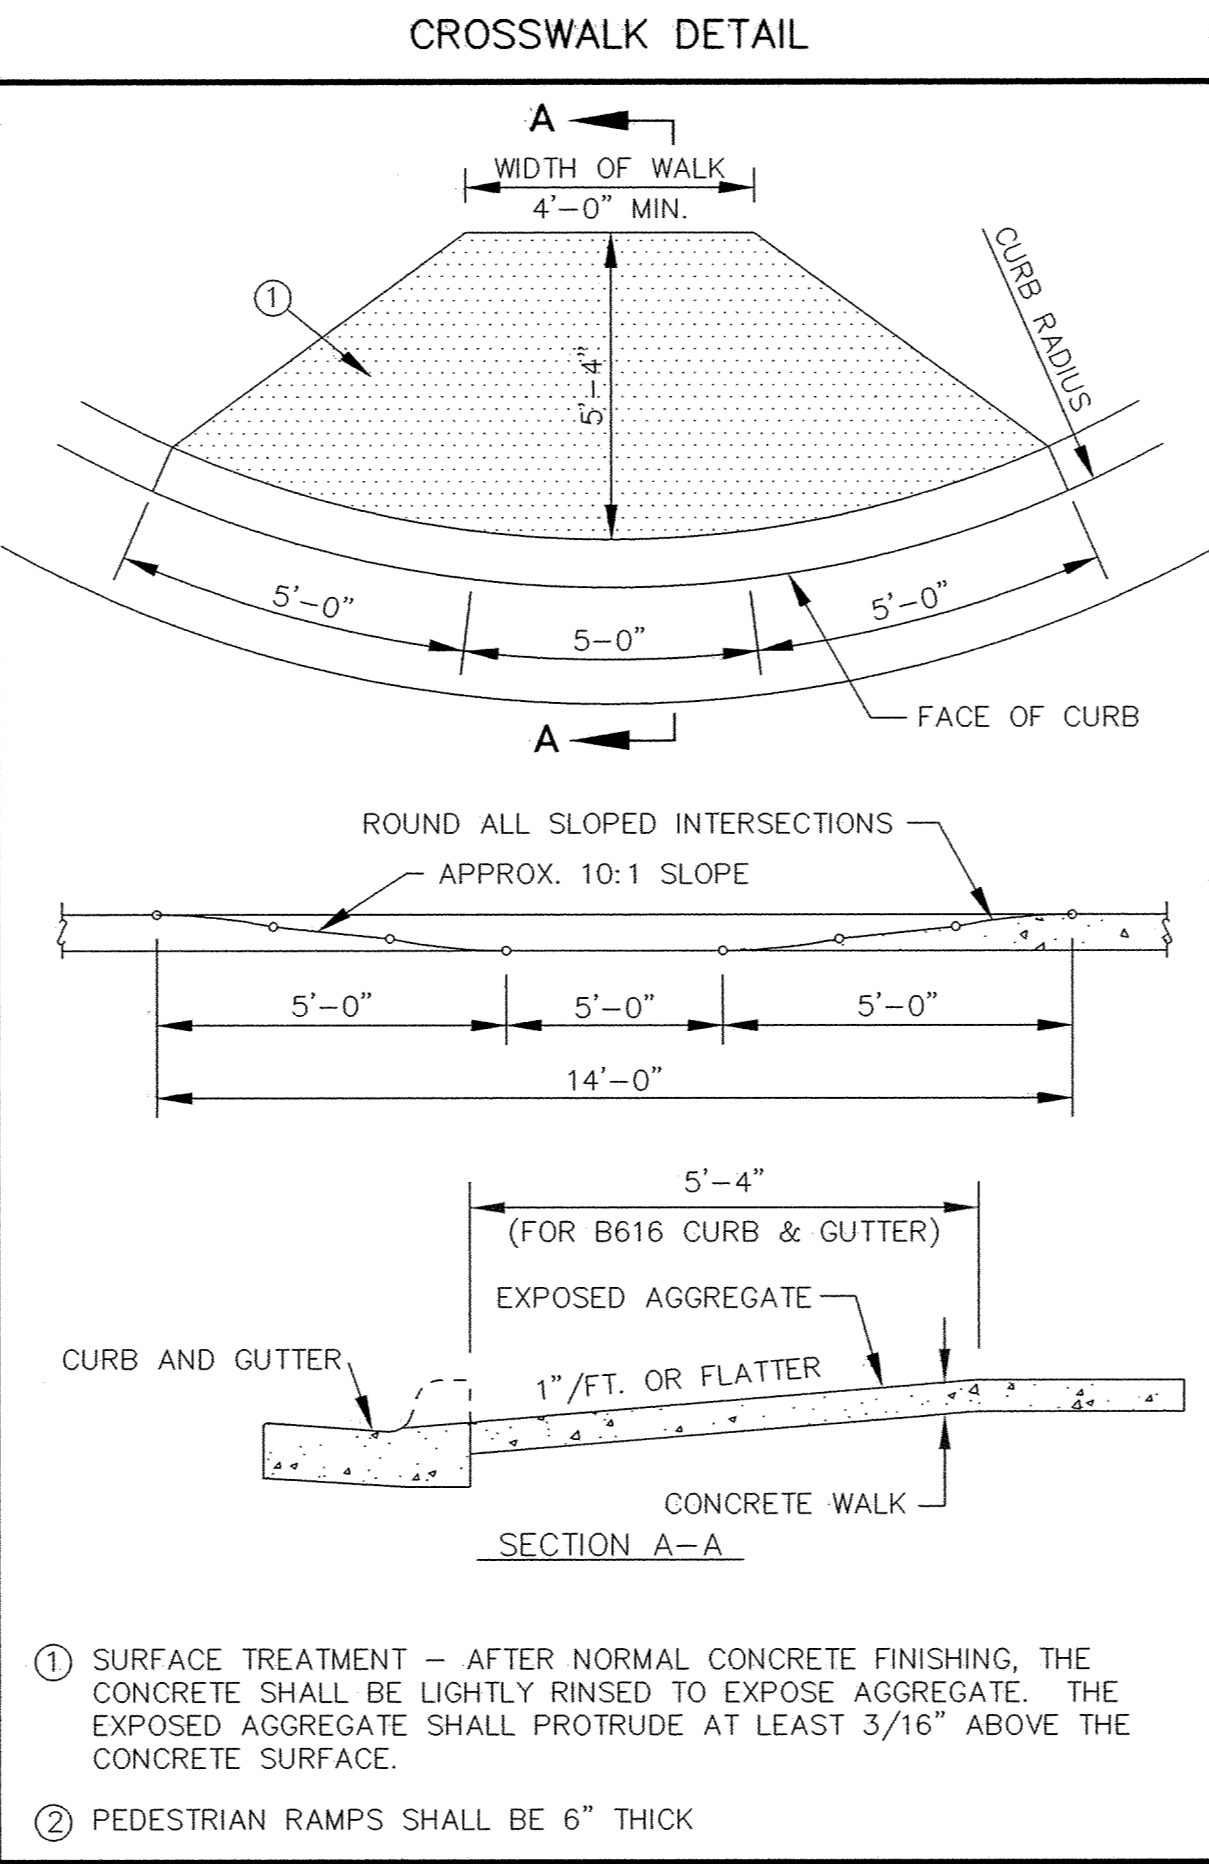
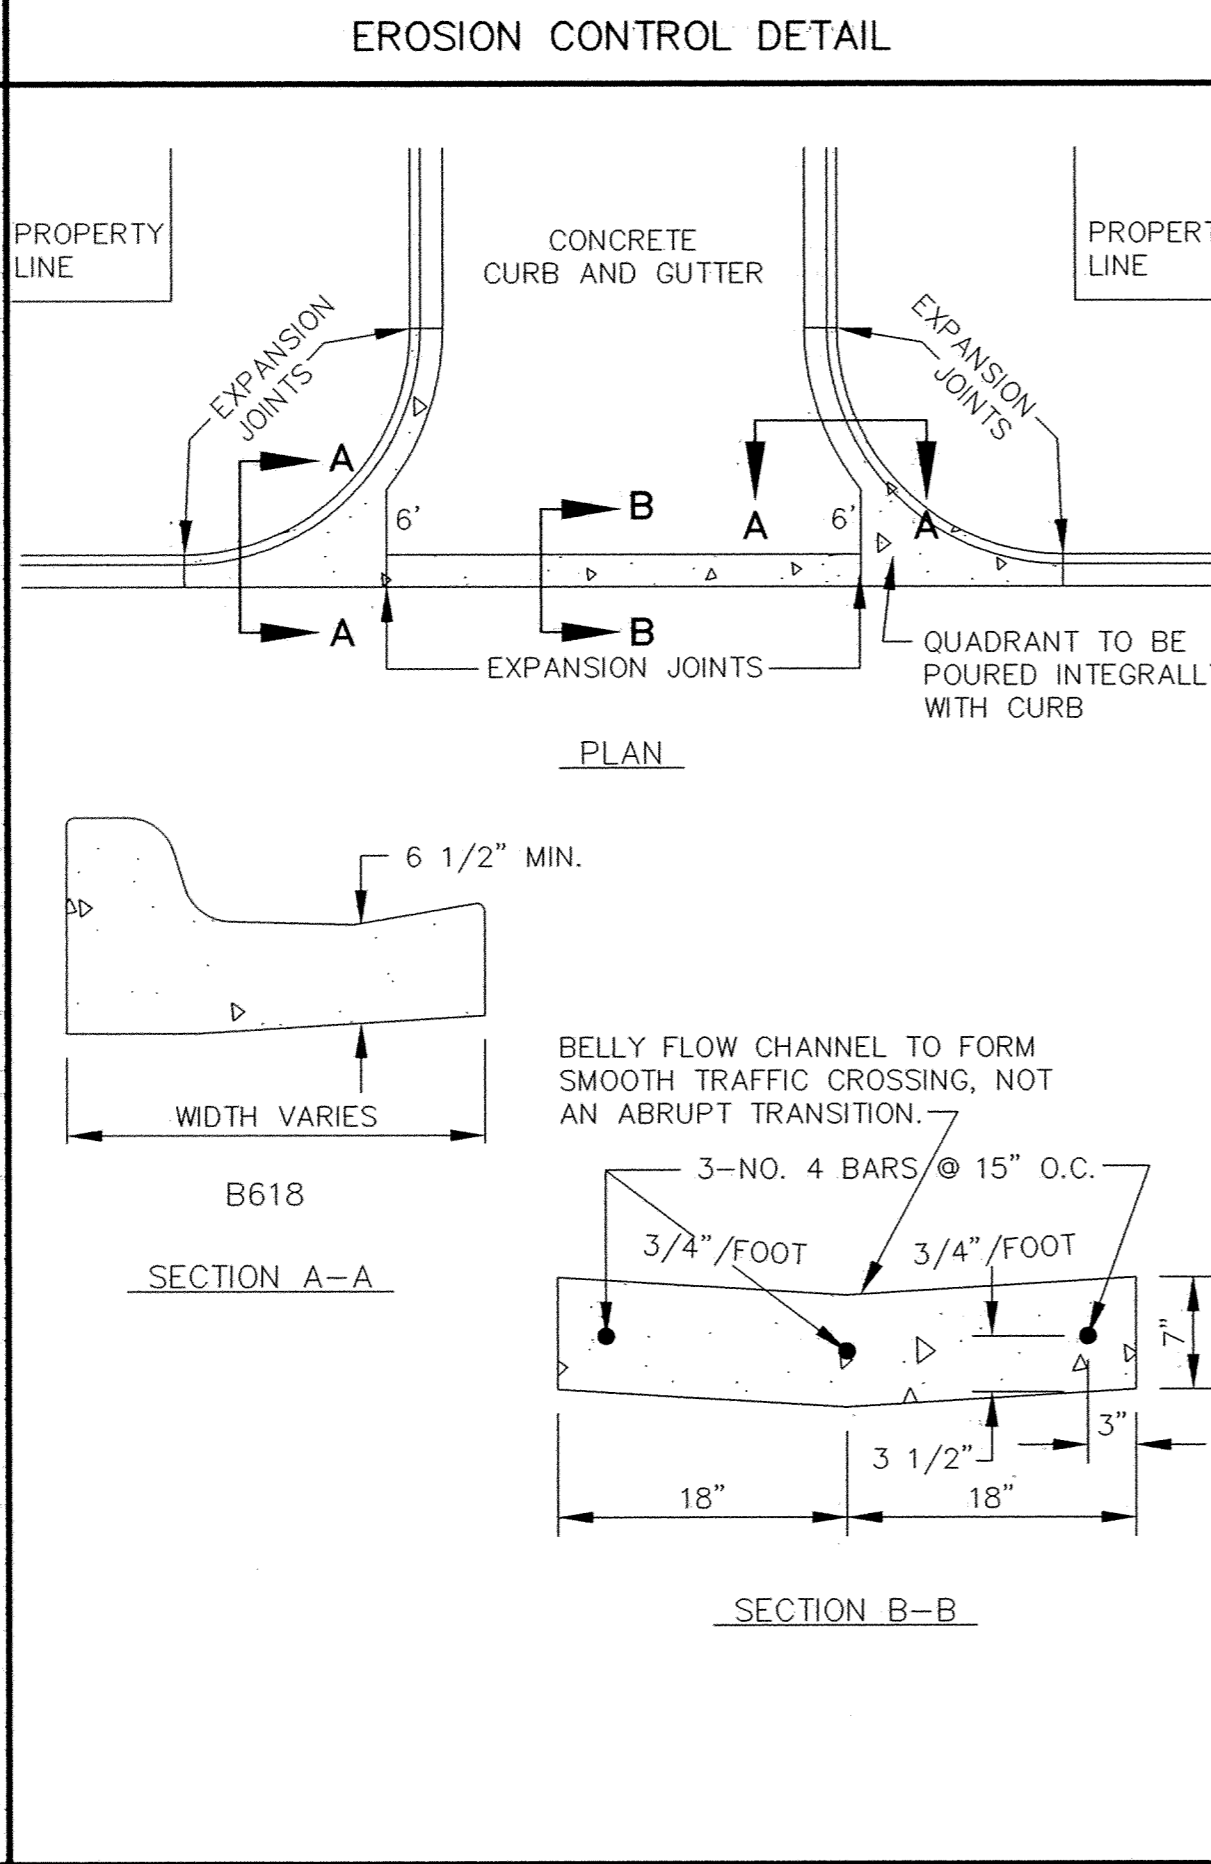
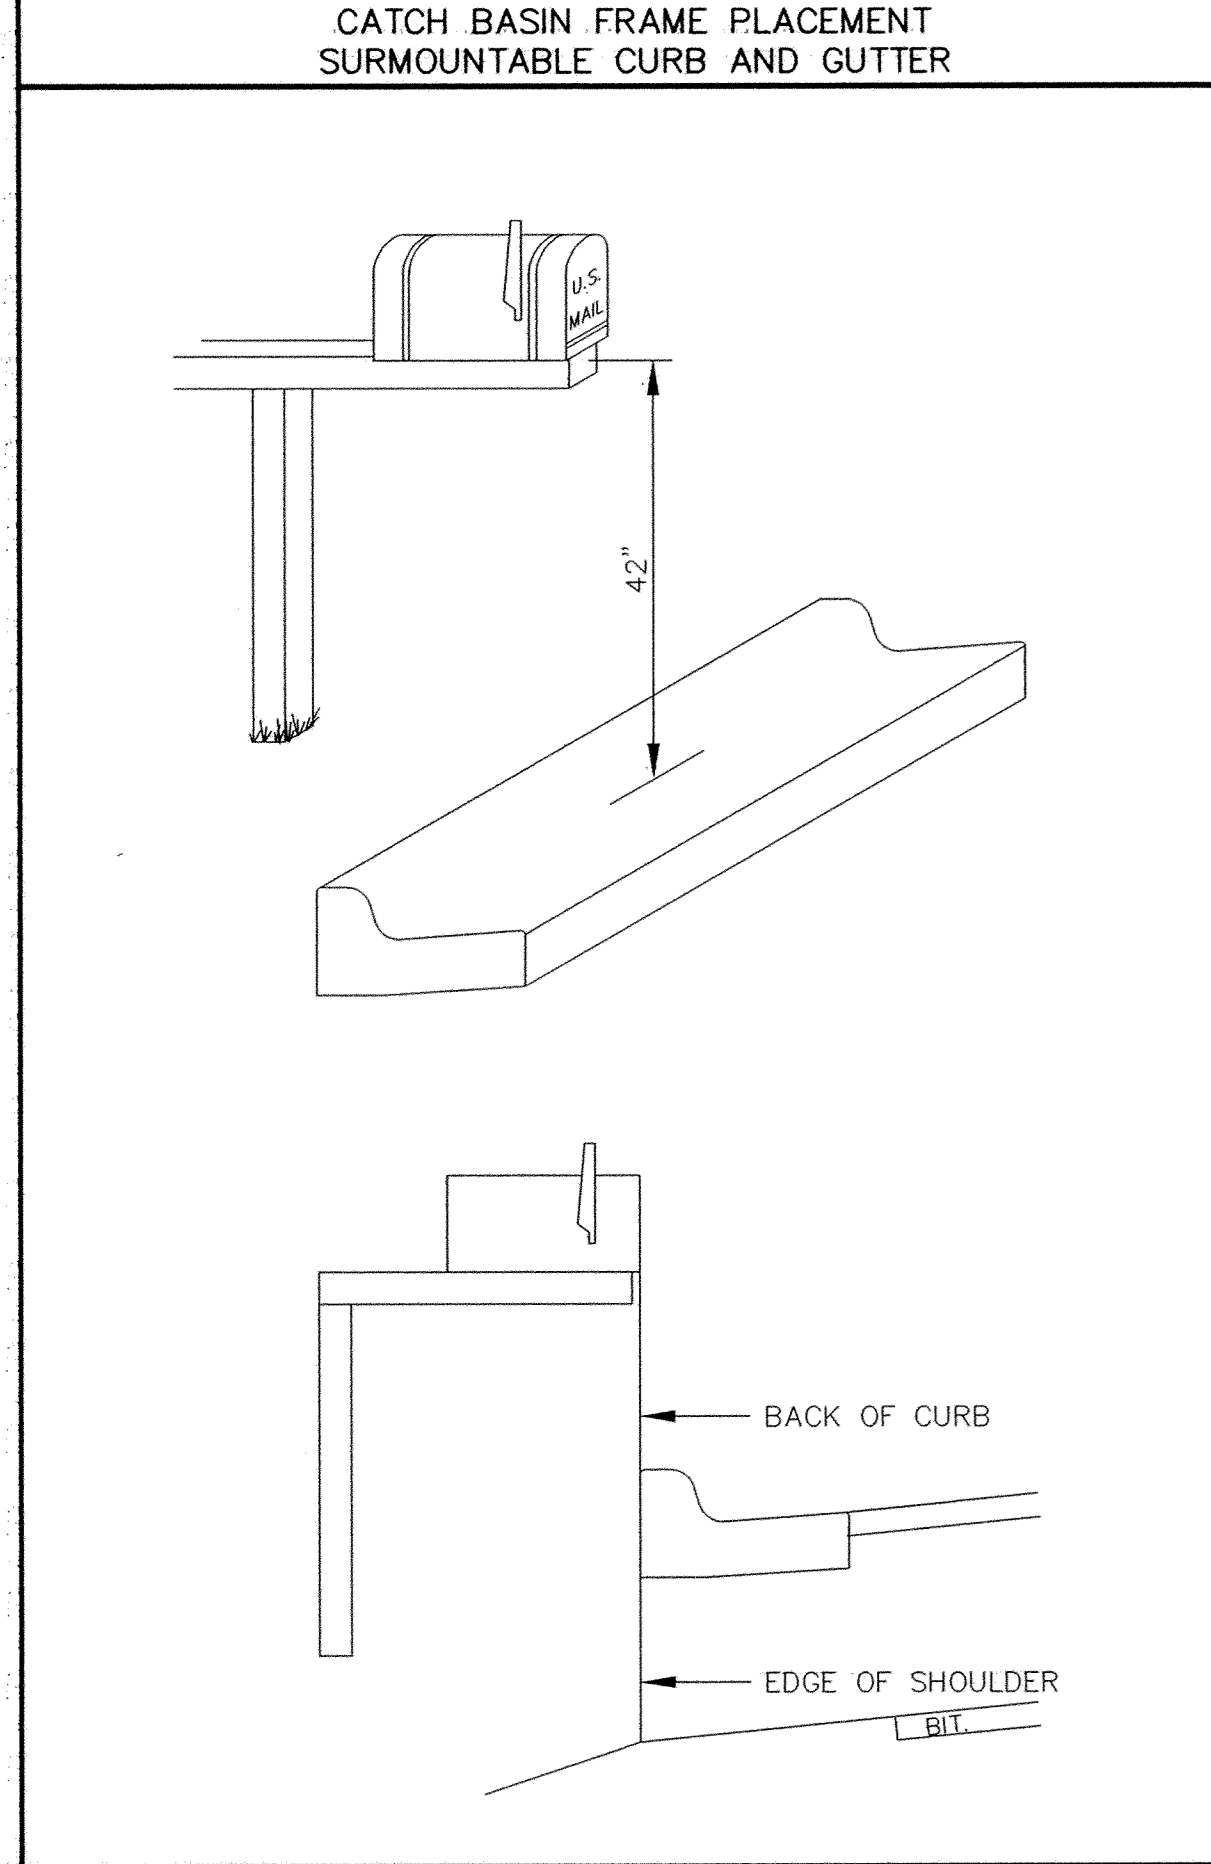
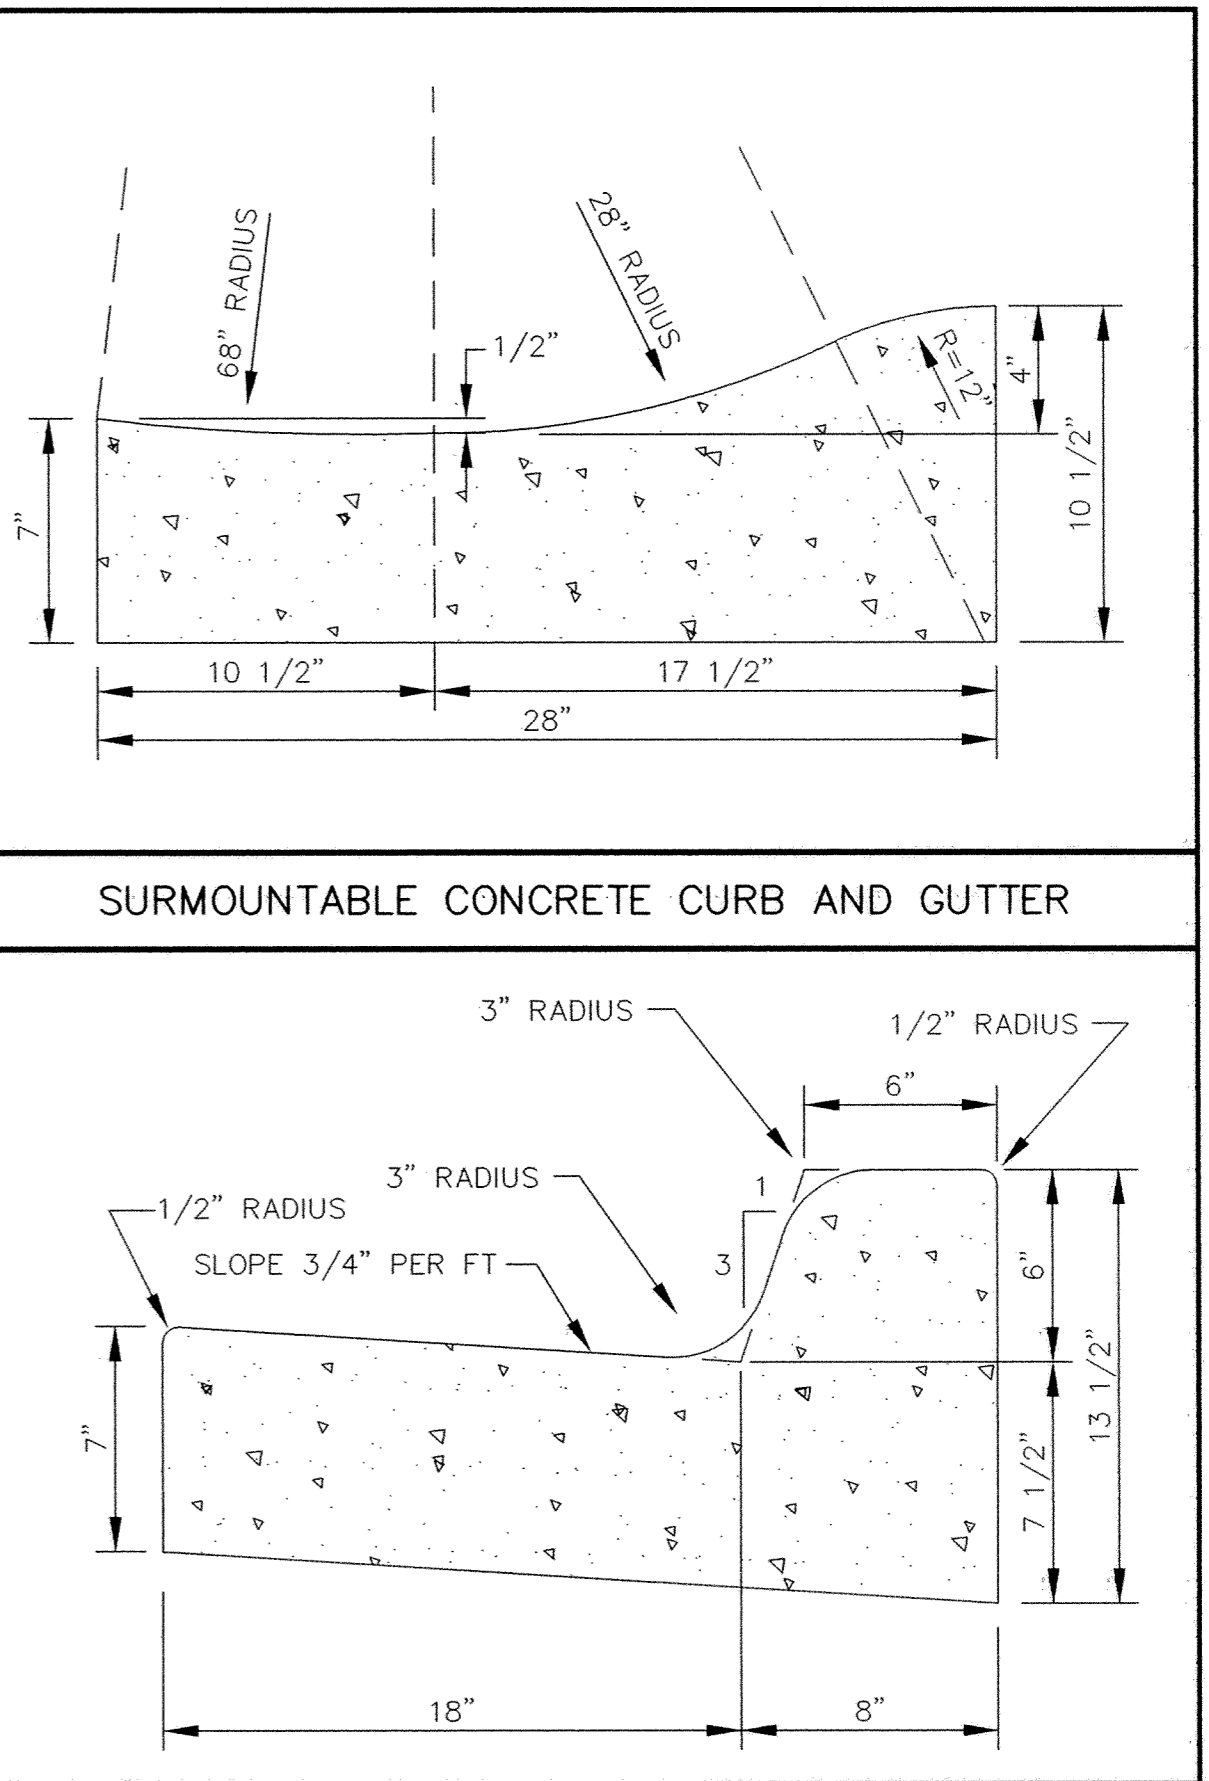
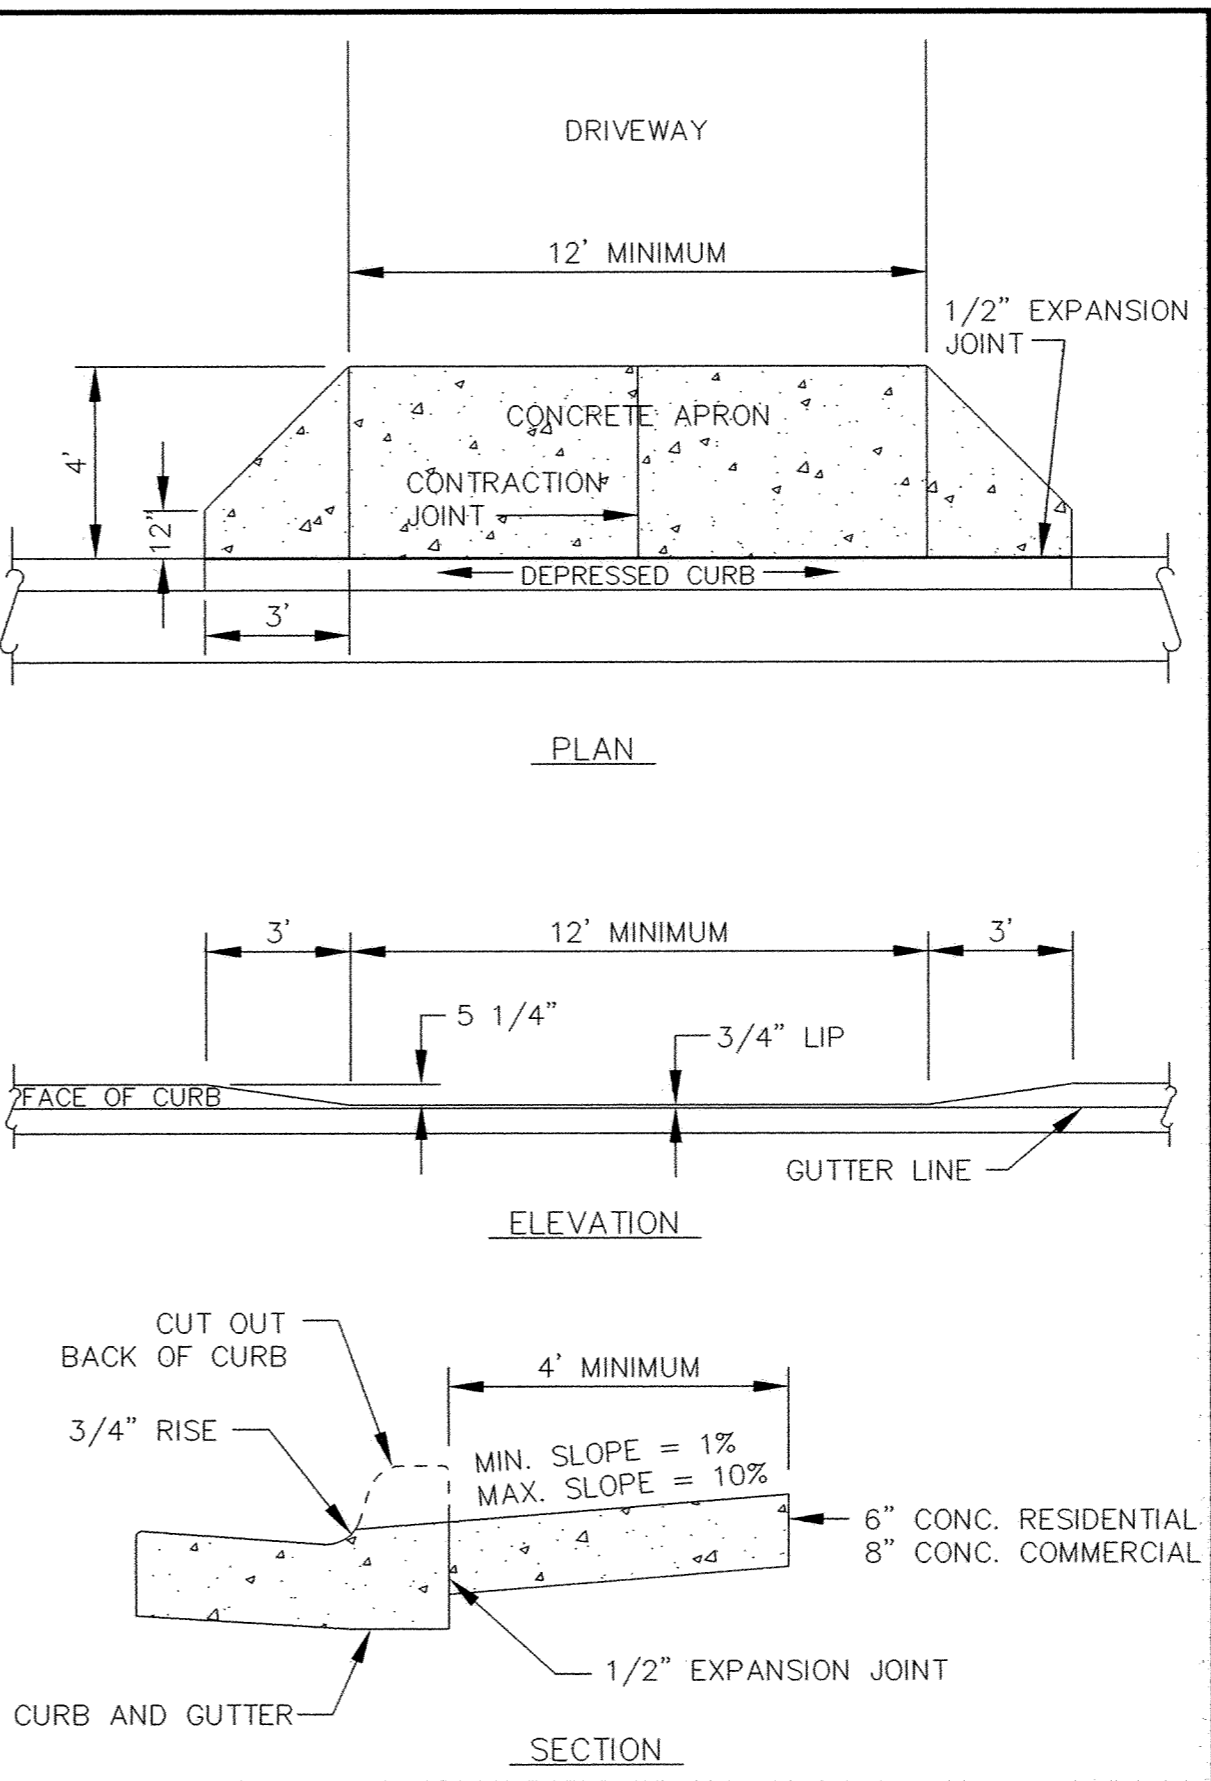
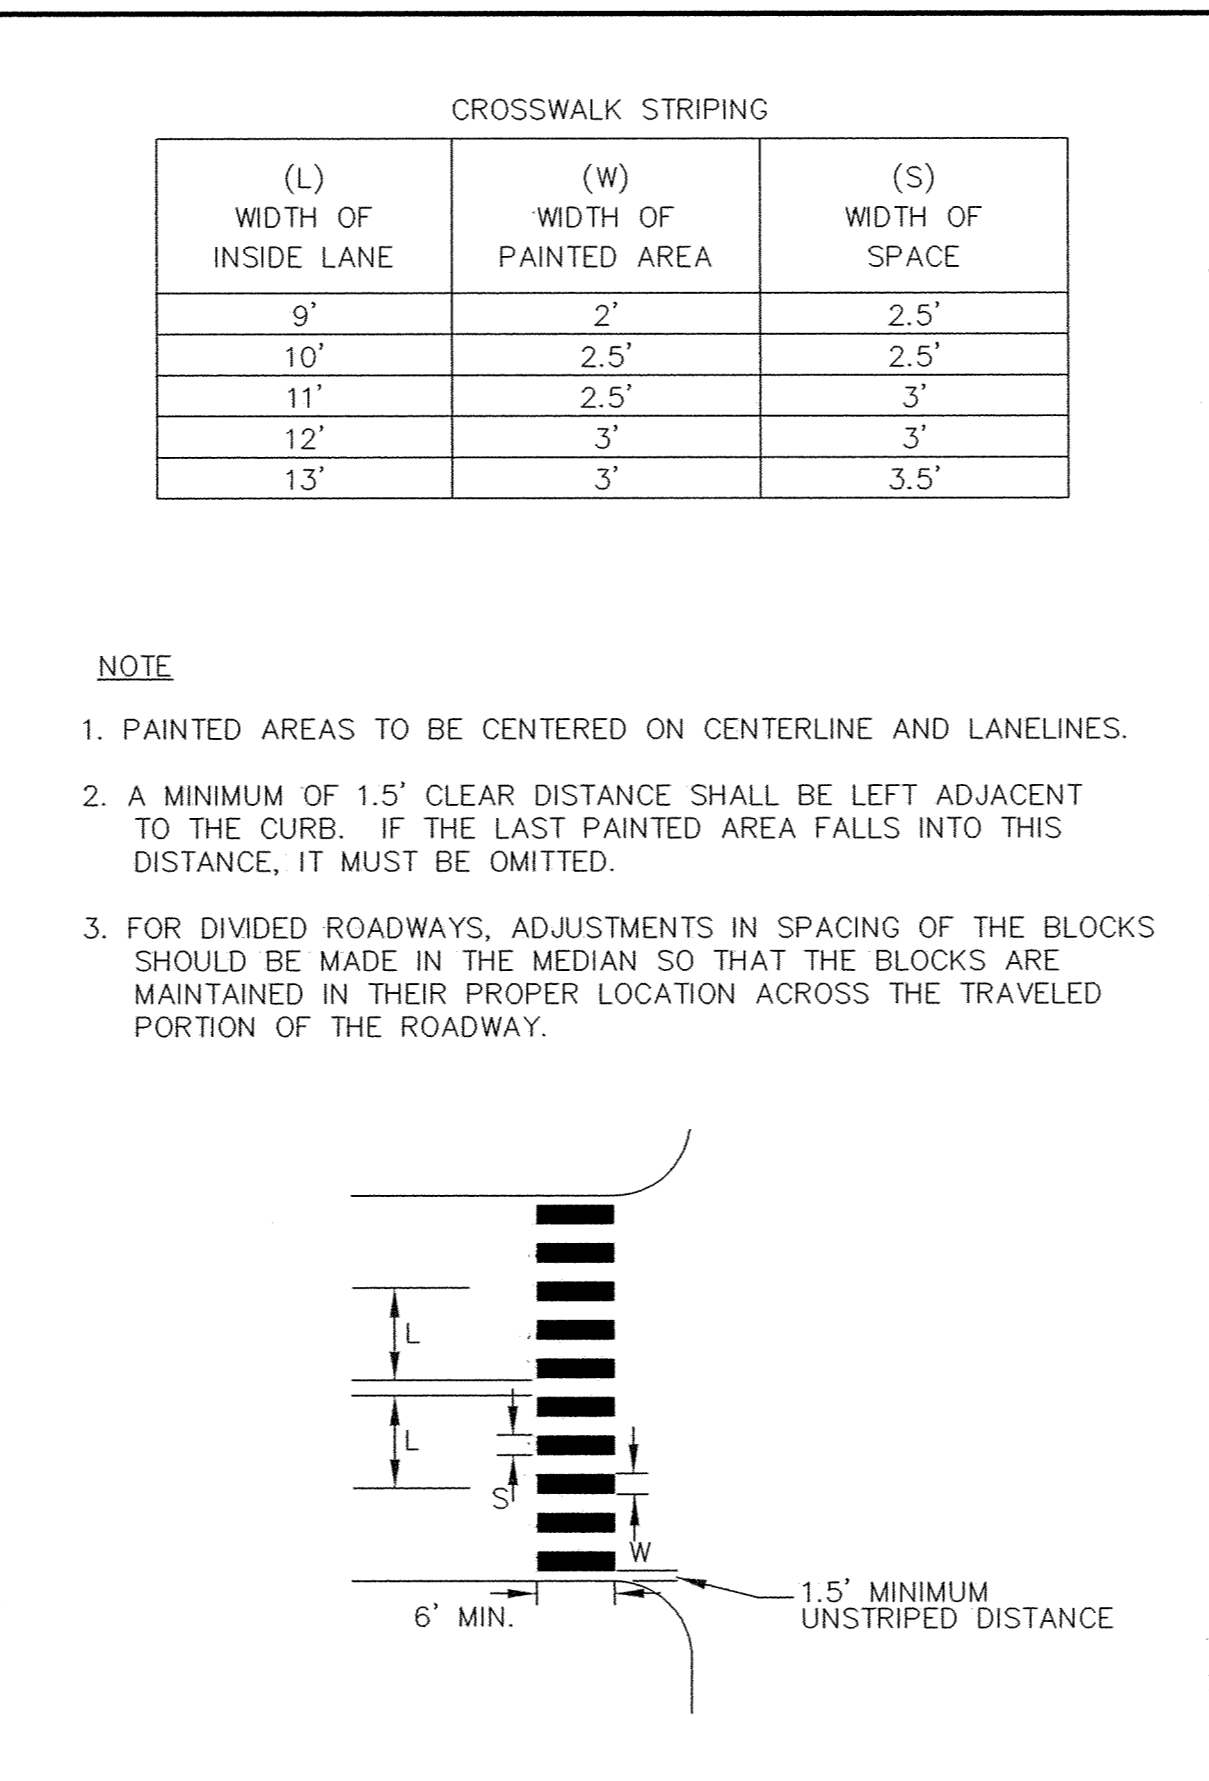
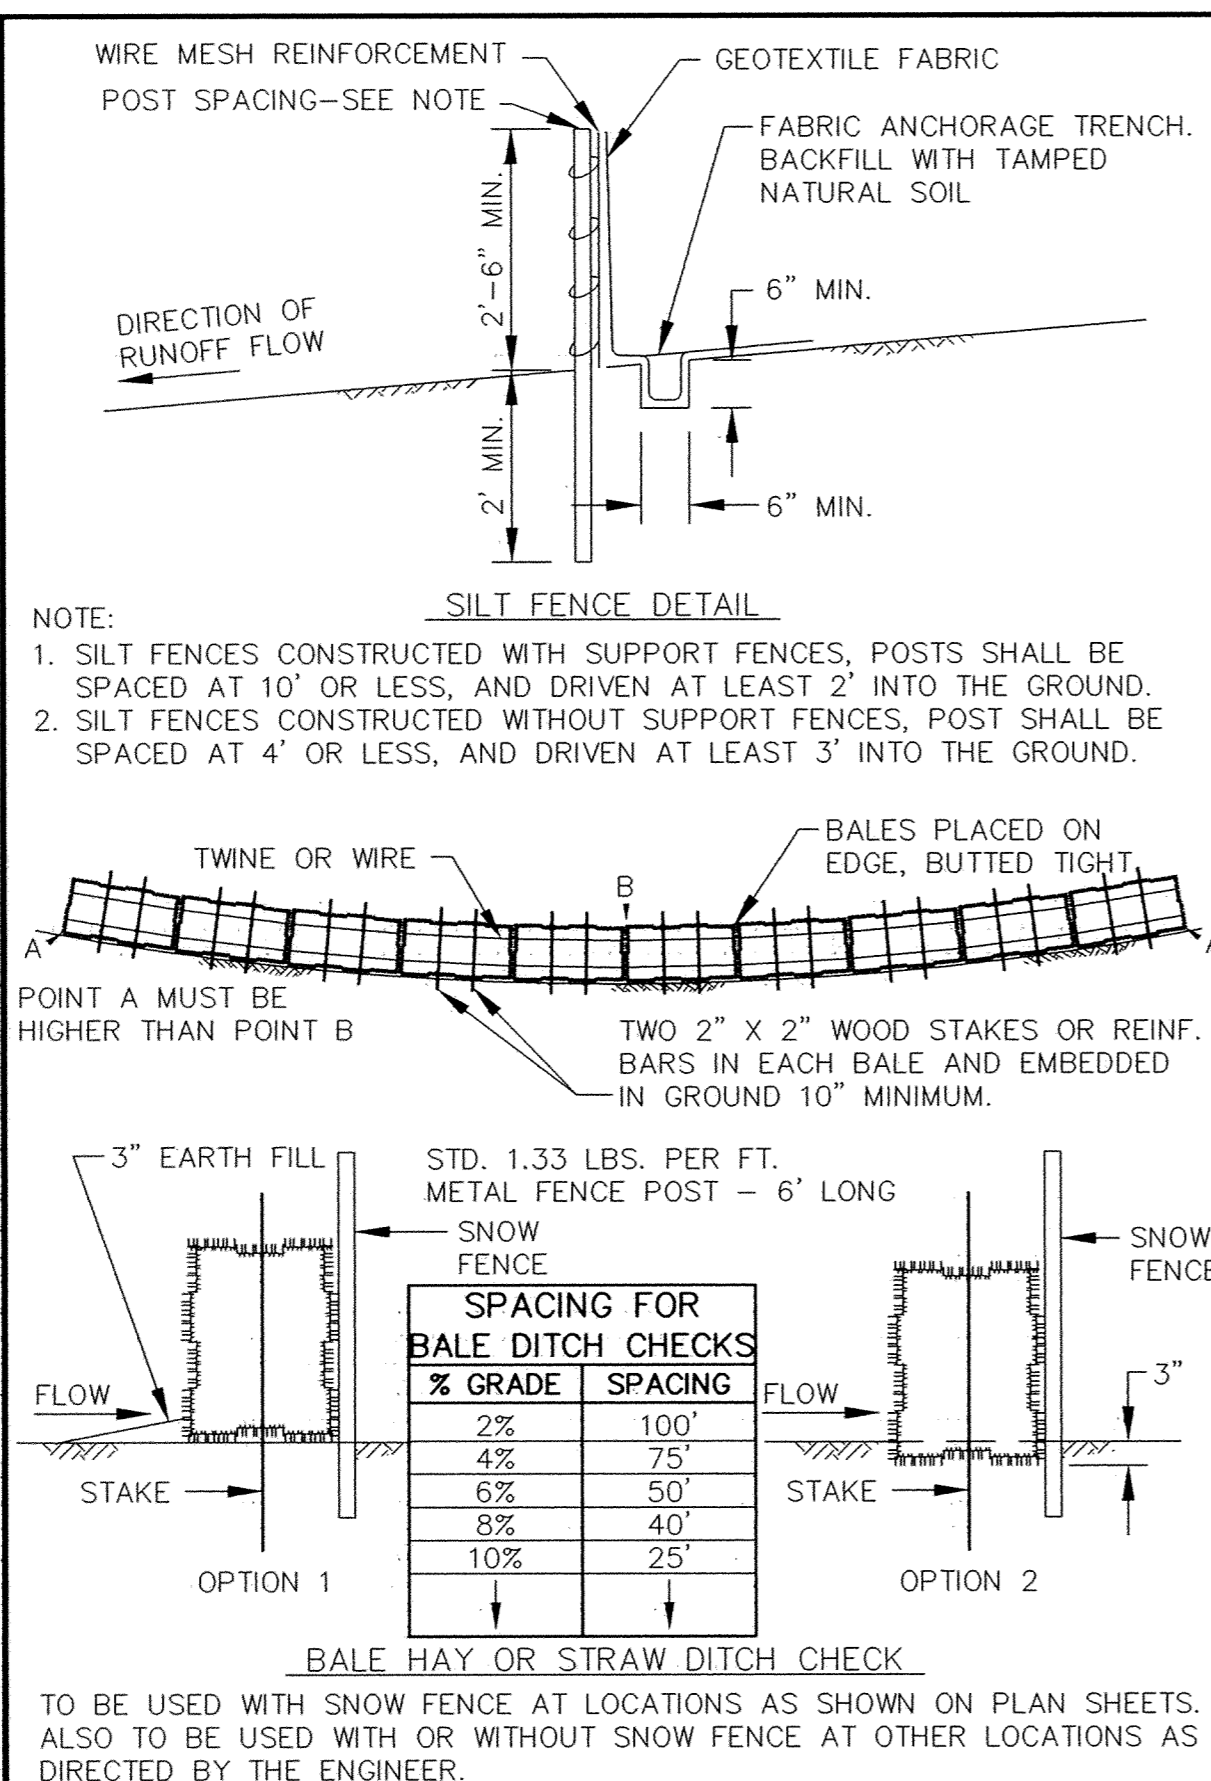


SARCO PRODUCTS • NEW HOPKINS, MINNESOTA
REPRODUCED BY PLAN NUMBER 8032
PROFESSIONAL ENGINEER OF MINNESOTA
SARCO PRODUCTS • NEW HOPKINS, MINNESOTA
REPRODUCED BY PLAN NUMBER 8032
PROFESSIONAL ENGINEER OF MINNESOTA
SARCO PRODUCTS • NEW HOPKINS, MINNESOTA
REPRODUCED BY PLAN NUMBER 8032
PROFESSIONAL ENGINEER OF MINNESOTA

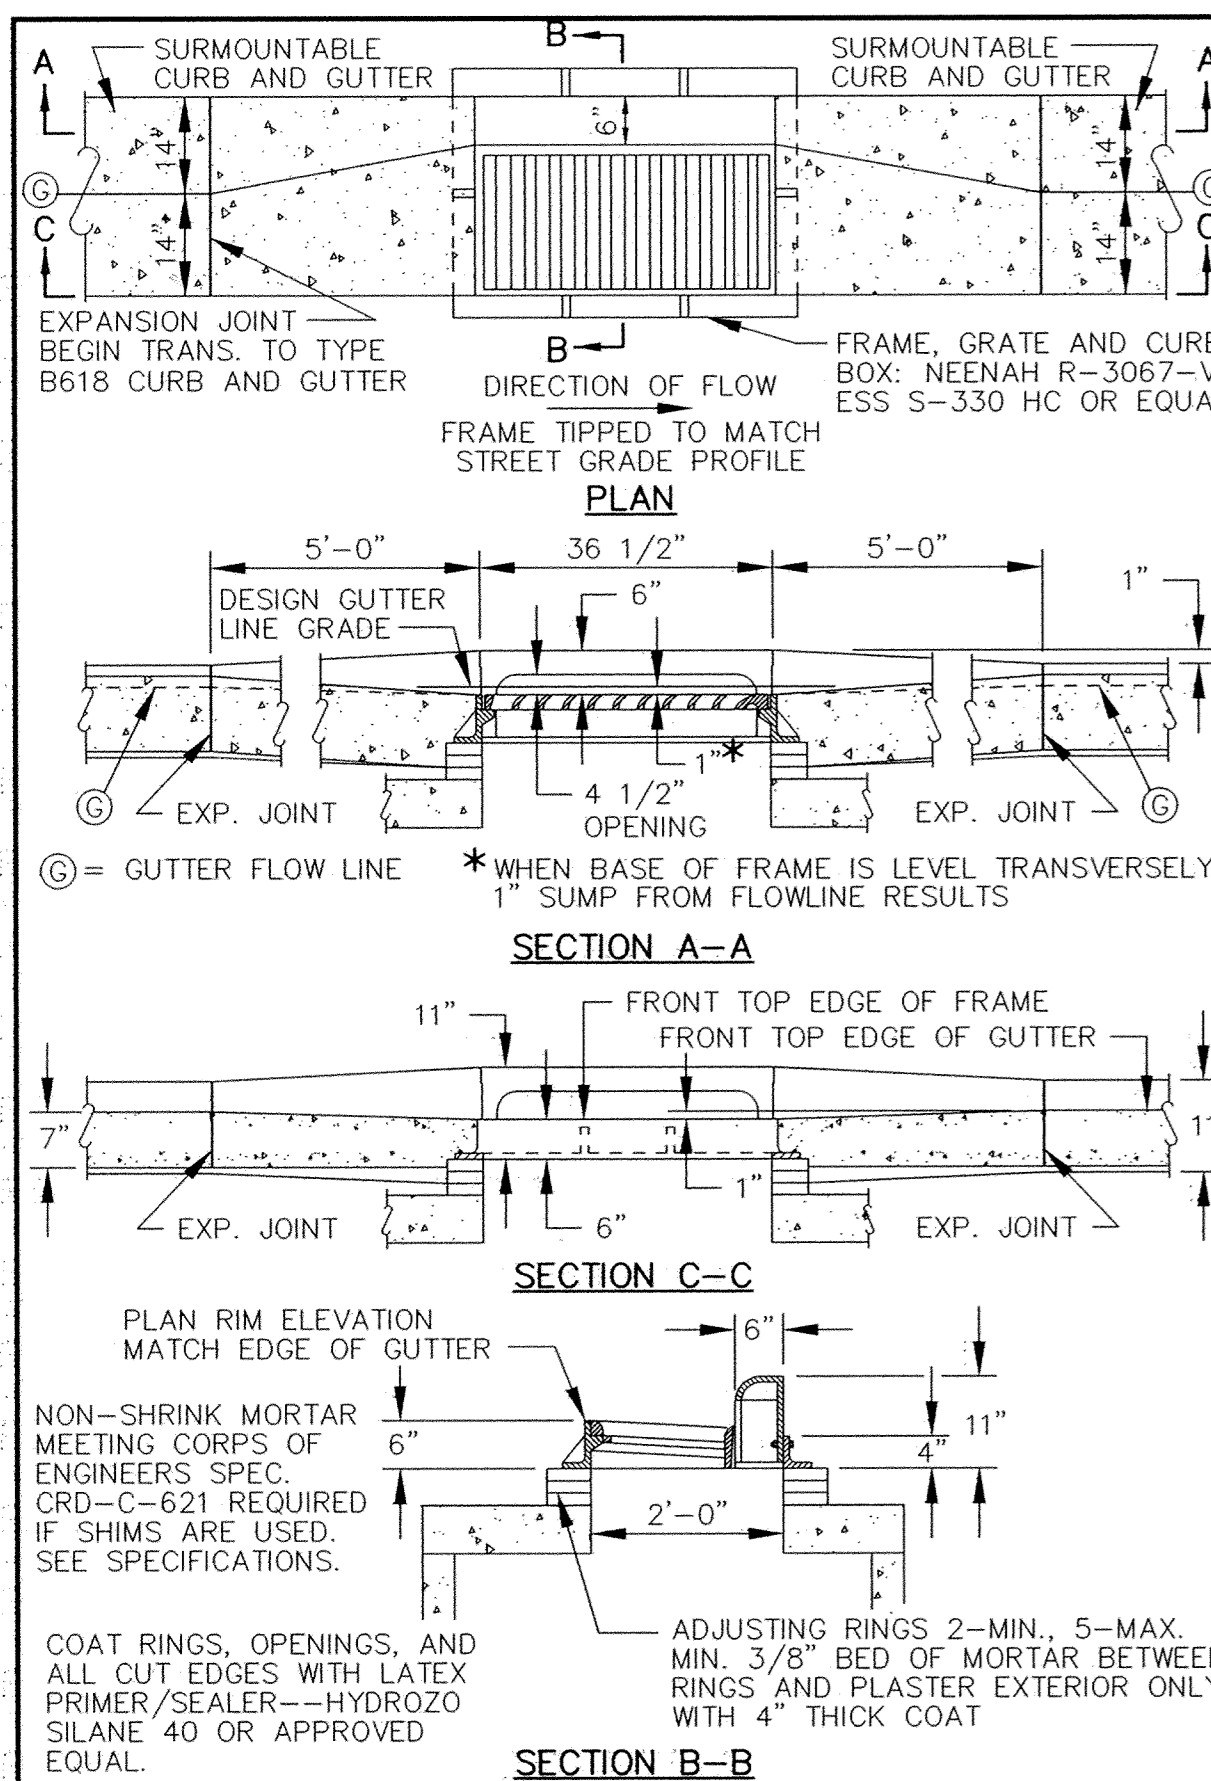

DESIGNED BY: DESIGNED BY DRAWN BY: RKM
 APPROVED BY: APPROVED BY JOB NUMBER 811388J
 CAD DATE: January 13, 2005 11:00:39 a.m.
 CAD FILE: 811388\As-Built\Drawings\CT-U03.DWG (JC)

I HEREBY CERTIFY THAT THIS PLAN, SPECIFICATION, OR REPORT WAS PREPARED BY ME OR UNDER MY DIRECT SUPERVISION AND THAT I AM A DULY LICENSED PROFESSIONAL ENGINEER UNDER THE LAWS OF THE STATE OF MINNESOTA.
 SIGNATURE _____ DATE _____
 PRINTED NAME JOHN M. ANDERSON LIC. NO. 25889

NO.	DATE	BY	REVISION DESCRIPTION

1326 ENERGY PARK DRIVE
 ST. PAUL, MINNESOTA 55108
 (651) 644-4389

Howard R. Green Company

THE WOODS OF HILLSIDE IV
 CITY OF ELK RIVER

STREET CONSTRUCTION DETAILS

SHEET NO.
10

DRAWING NUMBER
 WOODS4.05