
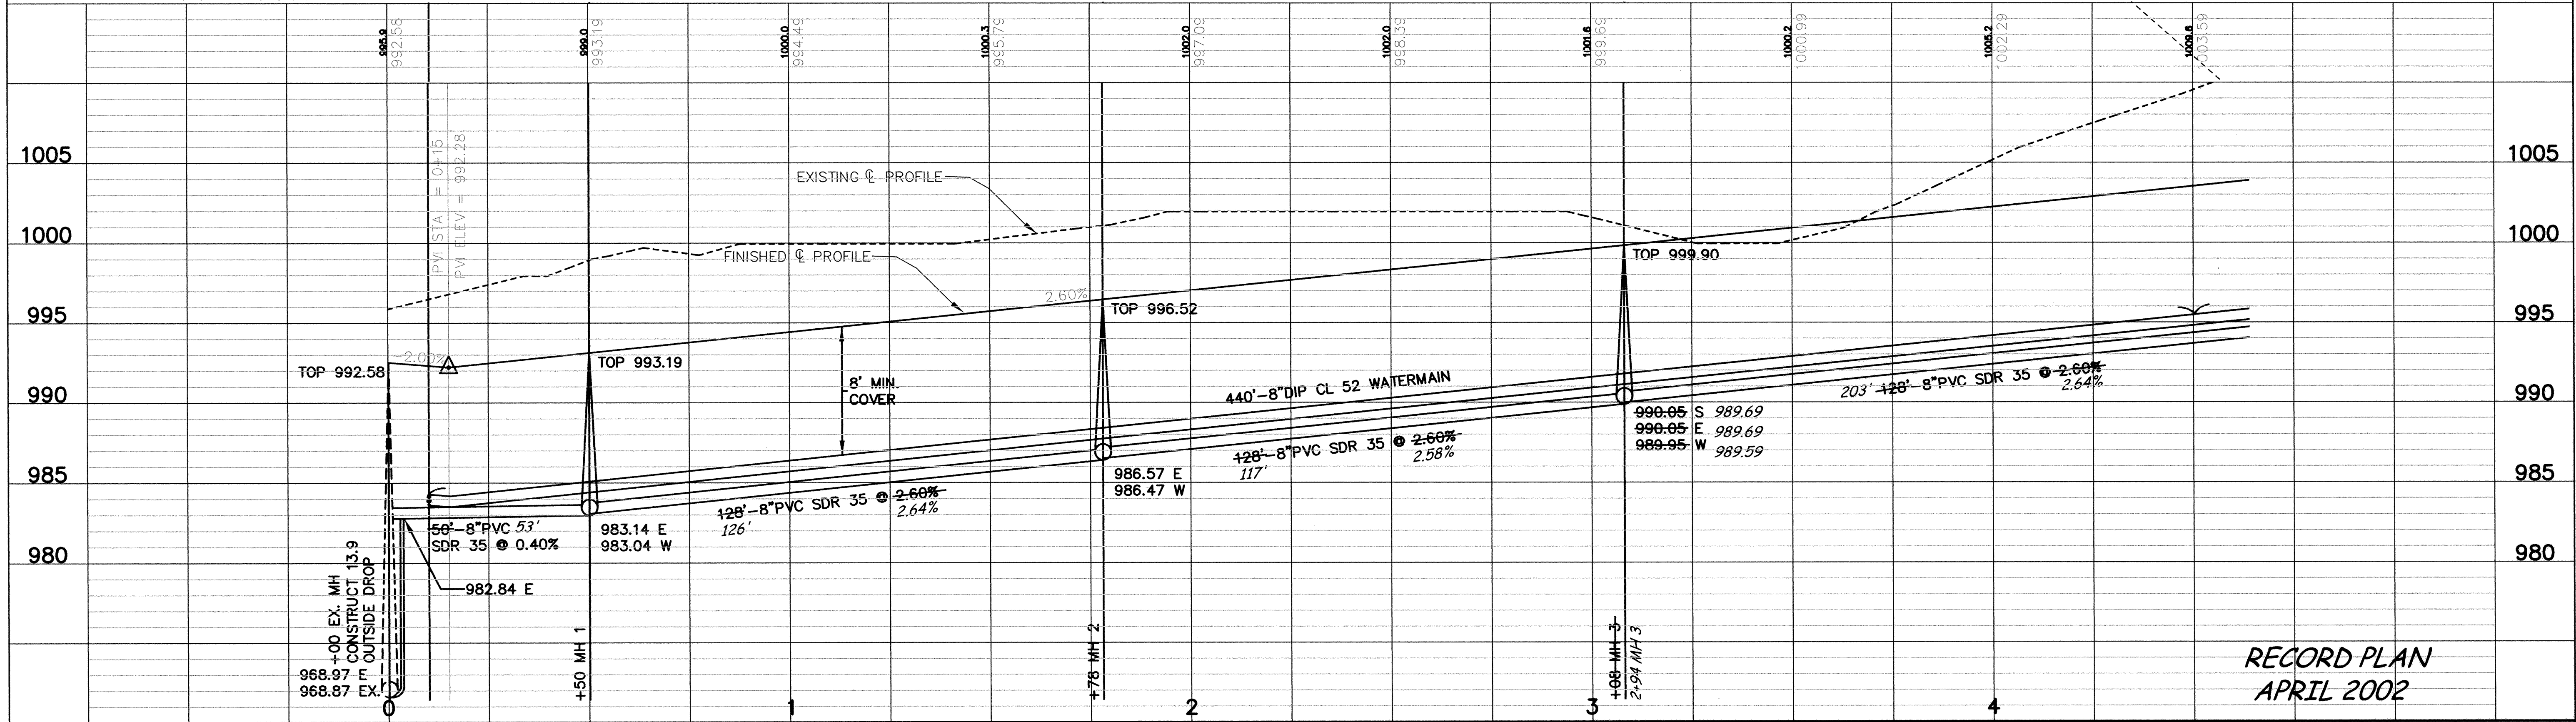
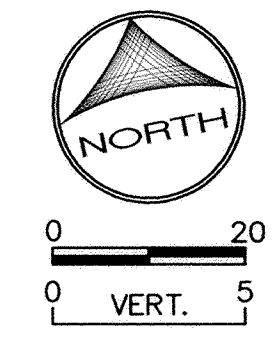


# 195TH STREET NW.

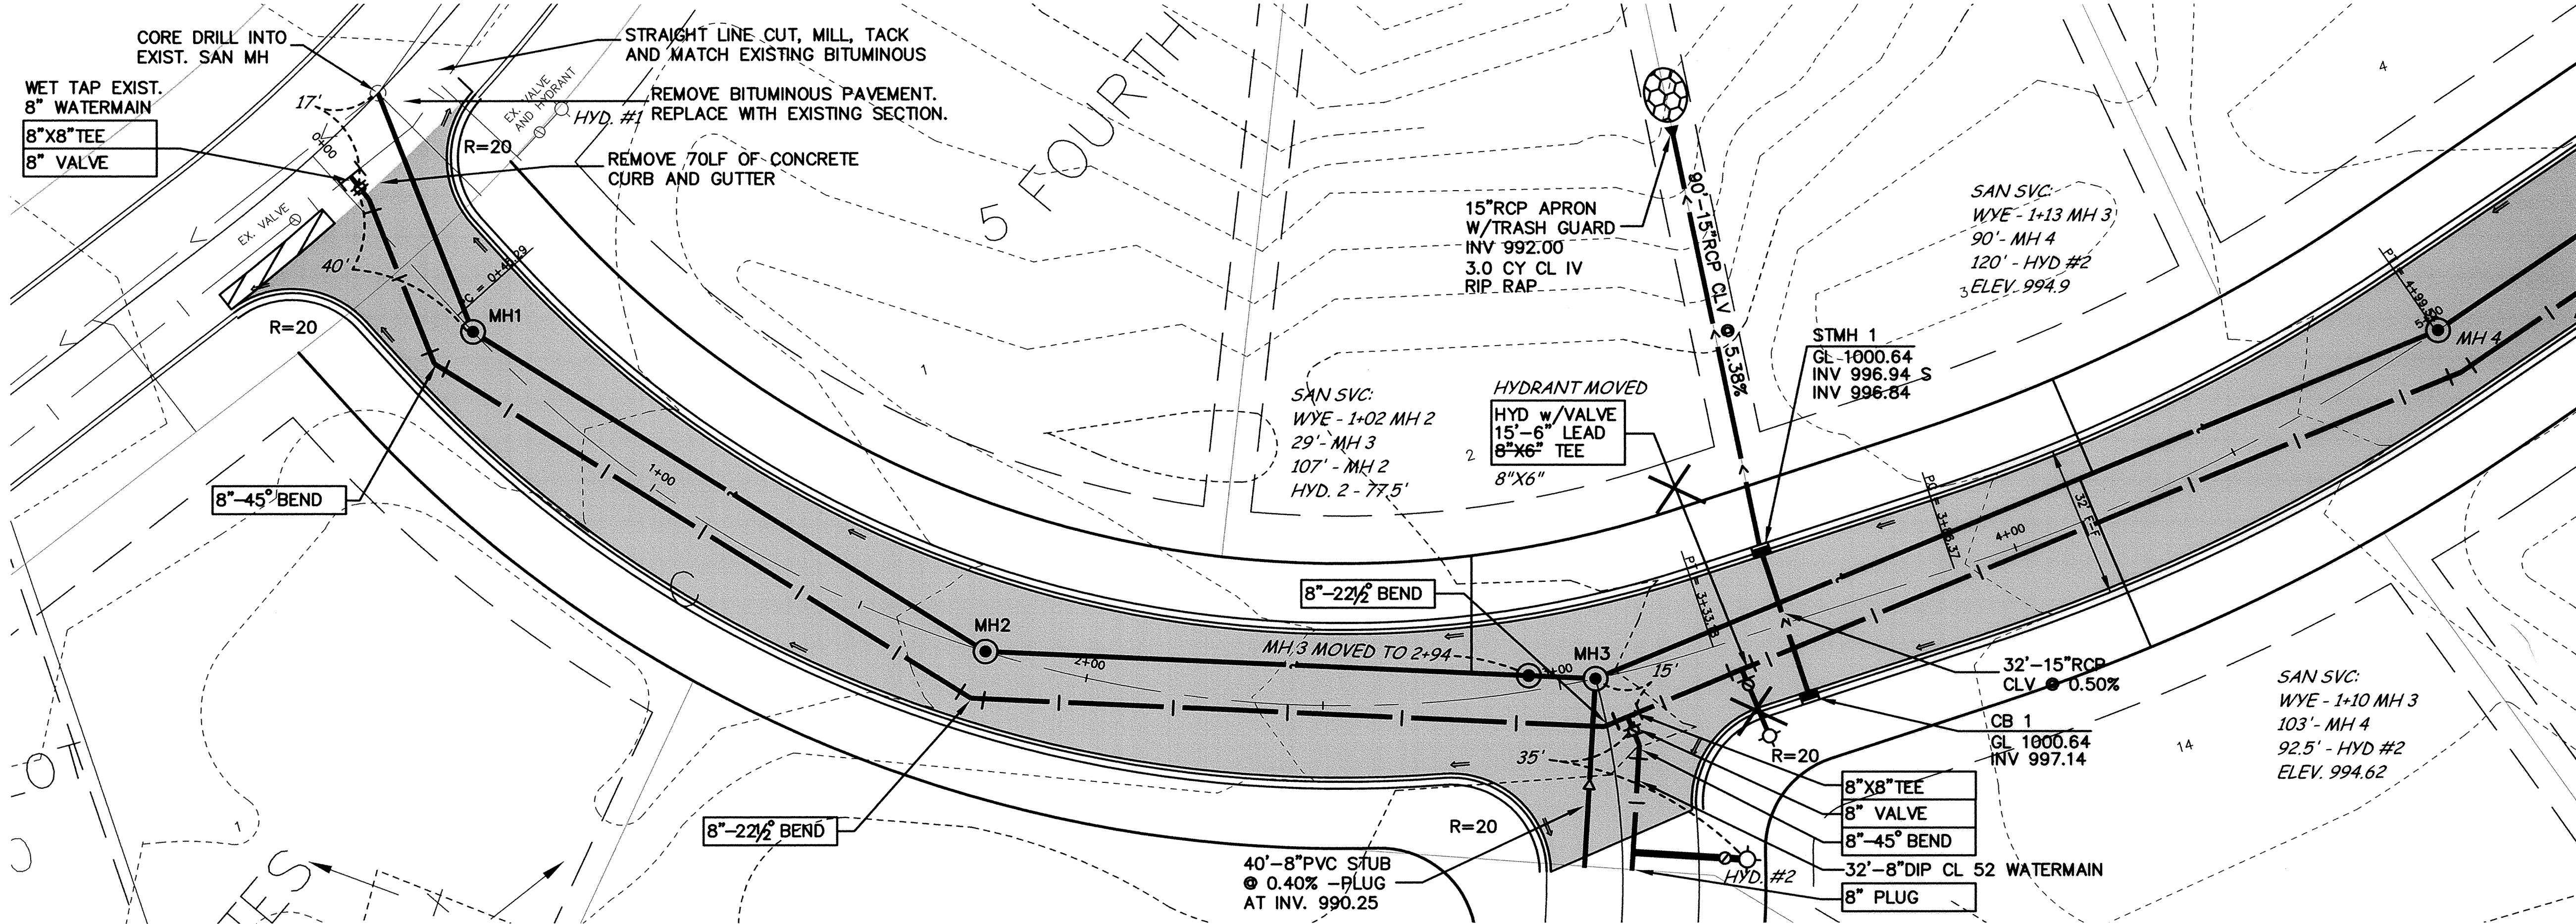

DESIGNED BY: \_\_\_\_\_ DRAWN BY: EY  
 APPROVED BY: \_\_\_\_\_ JOB NUMBER 804411J  
 CAD DATE: December 18, 2003 3:24:16 p.m.  
 CAD FILE: 804411j\asbuilt\_dwg\AB-804411-P1.DWG

I HEREBY CERTIFY THAT THIS PLAN, SPECIFICATION, OR REPORT WAS PREPARED BY ME OR UNDER MY DIRECT SUPERVISION AND THAT I AM A DULY REGISTERED PROFESSIONAL ENGINEER UNDER THE LAWS OF THE STATE OF MINNESOTA.

DATE \_\_\_\_\_ REG. NO. 15316

NO.	DATE	BY	REVISION DESCRIPTION

1326 ENERGY PARK DRIVE  
 ST. PAUL, MINNESOTA 55108  
 (651) 644-4389

**Howard R. Green Company**  
 CONSULTING ENGINEERS

CITY OF ELK RIVER  
 THE WOODS AT HILLSIDE  
 STREET AND UTILITY IMPROVEMENTS

PLAN AND PROFILE  
 195TH STREET NW.  
 STA. 0+00 TO STA. 4+50

SHEET NO.  
**3**  
 OF  
**9**

DRAWING NUMBER

DRAWING NUMBER

DRAWING NUMBER

DRAWING NUMBER  
 WOODS1.00