
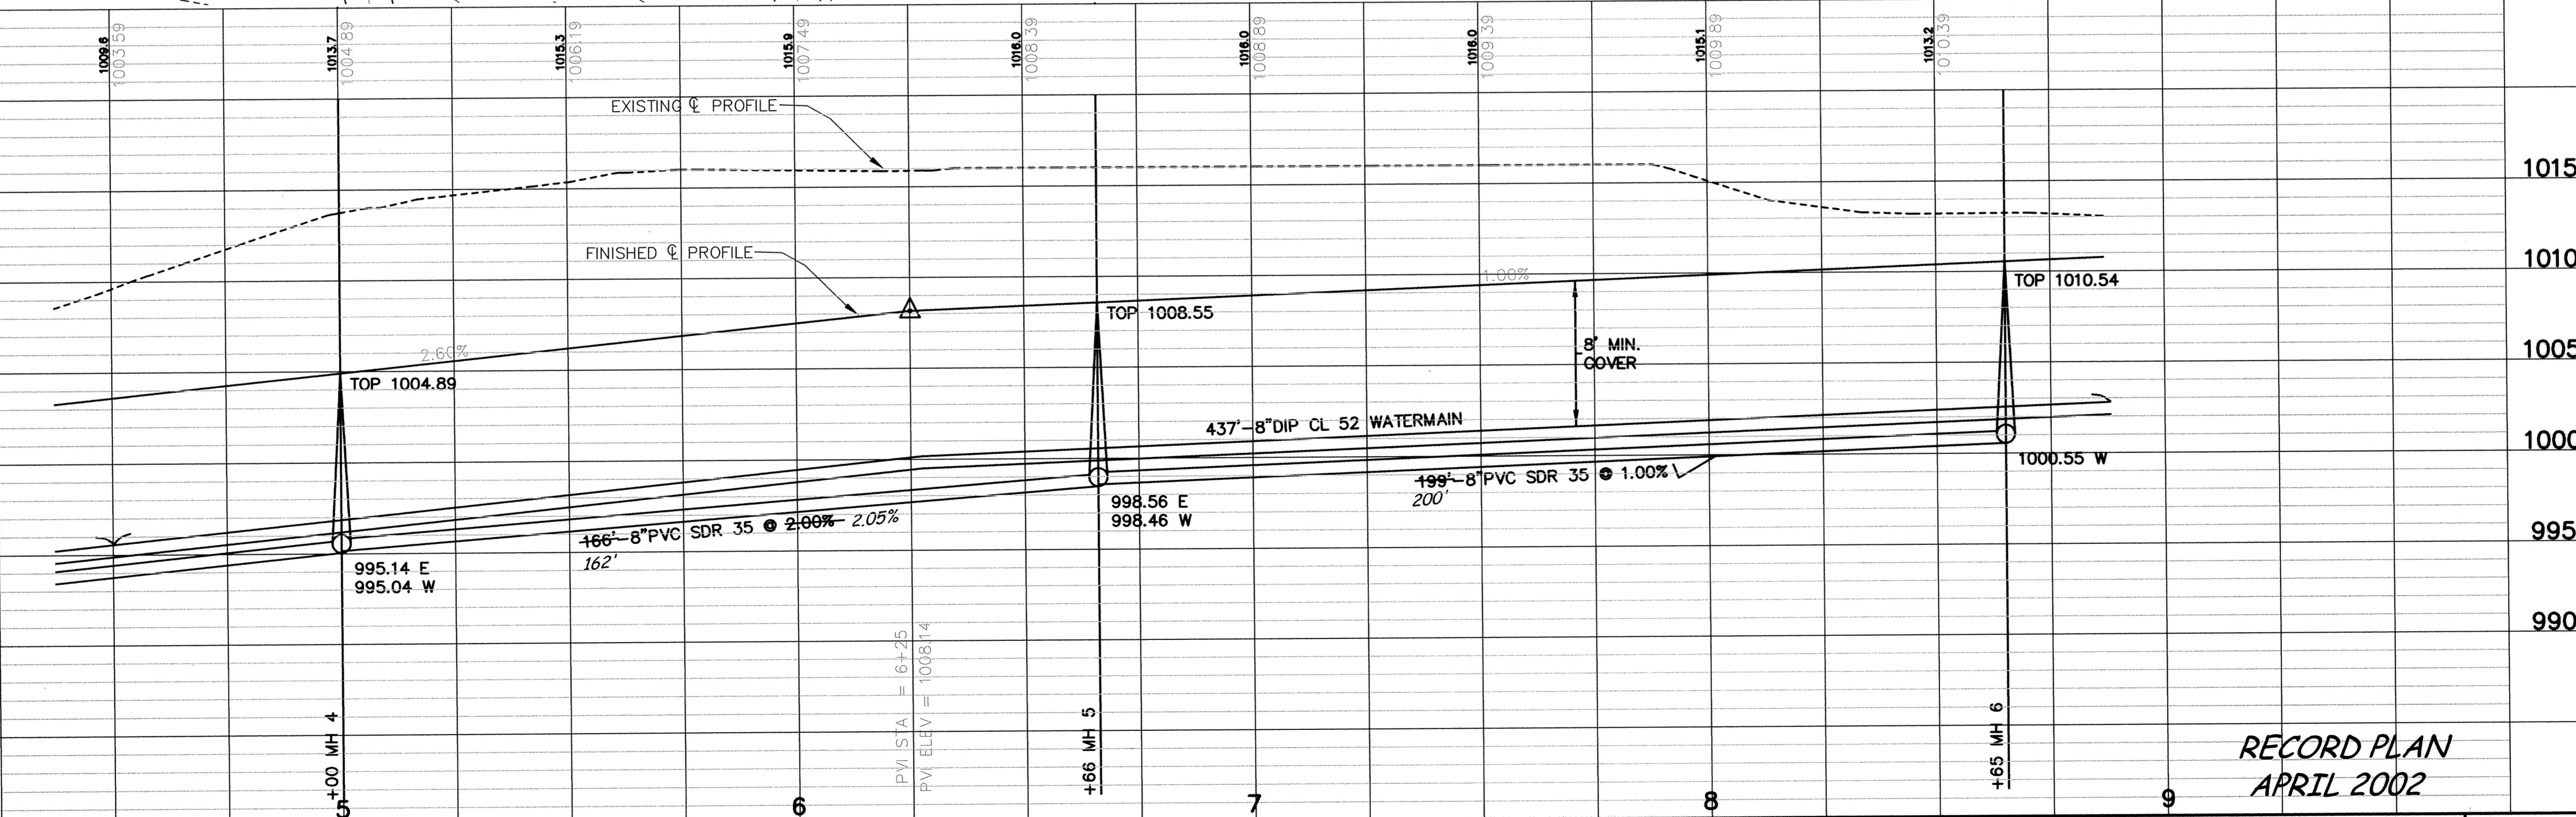


# 195TH COURT

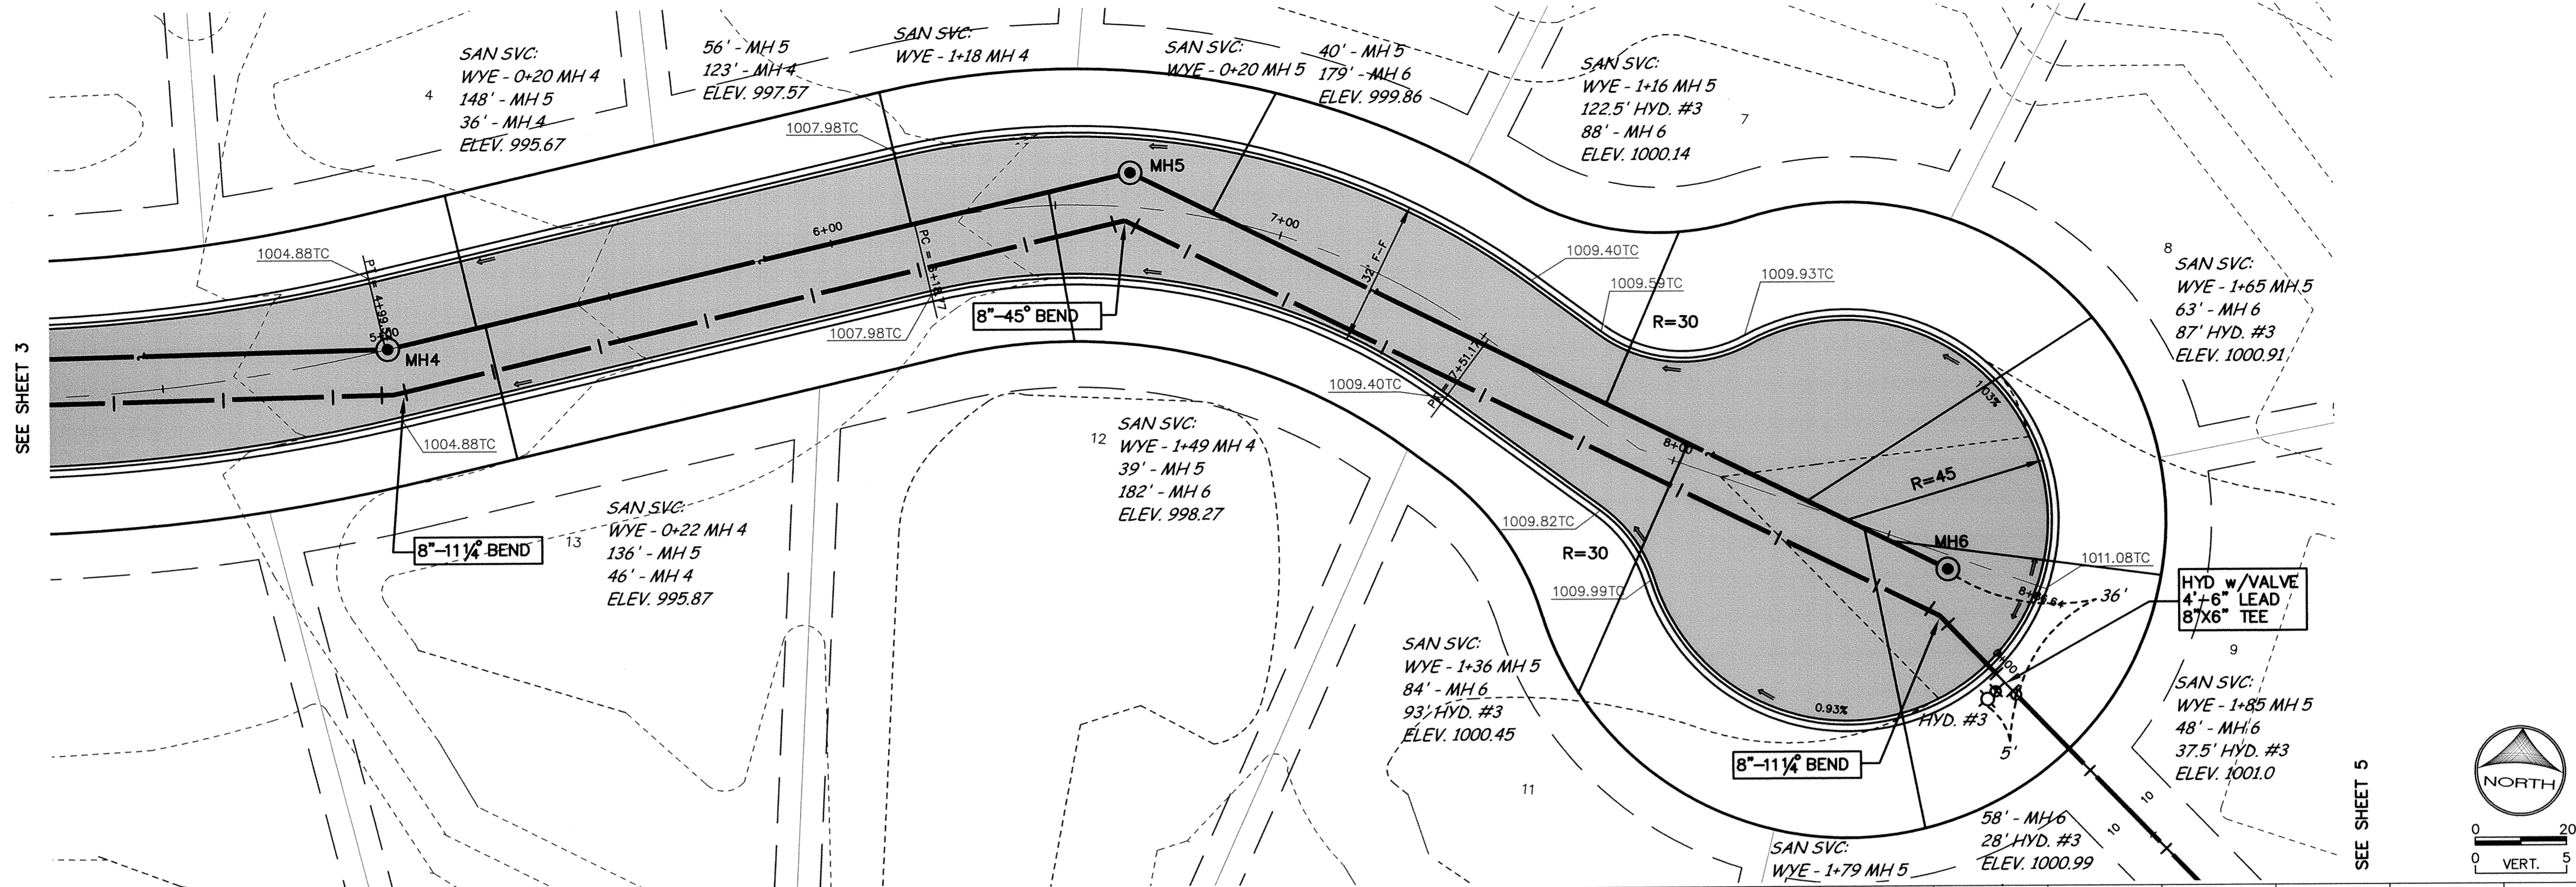

RECORD PLAN  
APRIL 2002

DESIGNED BY: \_\_\_\_\_ DRAWN BY: EY  
 APPROVED BY: \_\_\_\_\_ JOB NUMBER 804411J  
 CAD DATE: April 15, 2002 9:00:10 a.m.  
 CAD FILE: 804411j\asbuilt\_dwg\AB-804411-P2.DWG

I HEREBY CERTIFY THAT THIS PLAN, SPECIFICATION,  
 OR REPORT WAS PREPARED BY ME OR UNDER MY DIRECT  
 SUPERVISION AND THAT I AM A DULY REGISTERED  
 PROFESSIONAL ENGINEER UNDER THE LAWS OF THE  
 STATE OF MINNESOTA.  
 DATE \_\_\_\_\_ REG. NO. 15316

NO.	DATE	BY	REVISION DESCRIPTION

1326 ENERGY PARK DRIVE  
 ST. PAUL, MINNESOTA 55108  
 (651) 644-4389

**Howard R Green Company**  
 CONSULTING ENGINEERS

CITY OF ELK RIVER  
 THE WOODS AT HILLSIDE  
 STREET AND UTILITY IMPROVEMENTS

PLAN AND PROFILE  
 195TH STREET NW.  
 STA. 4+50 TO STA. 8+86.64

SHEET NO.  
**4**  
 OF  
**9**

DRAWING NUMBER

DRAWING NUMBER

DRAWING NUMBER

DRAWING NUMBER  
 WOODS1.00

SACO PRODUCTS • NEW HOPE, MINNESOTA  
 REGISTERED BY PLAN NUMBER 8552  
 MEMBER SOCIETY OF PROFESSIONAL ENGINEERS  
 SACO PRODUCTS • NEW HOPE, MINNESOTA  
 REGISTERED BY PLAN NUMBER 8552  
 MEMBER SOCIETY OF PROFESSIONAL ENGINEERS