


**THE WOODS AT HILLSIDE**  
195TH STREET NW.  
195TH COURT

**SANITARY SEWER,  
WATERMAIN, STORM SEWER  
AND STREET RECONSTRUCTION**

NOTE:  
THESE PLANS HAVE BEEN REDUCED TO  
APPROXIMATELY 1/2 THEIR ORIGINAL SIZE.  
THESE 1/2 SIZE PLANS ARE TO BE USED  
FOR BIDDING PURPOSES ONLY.


I HEREBY CERTIFY THAT THIS PLAN, SPECIFICATION,  
OR REPORT WAS PREPARED BY ME OR UNDER MY DIRECT  
SUPERVISION AND THAT I AM A DULY REGISTERED  
PROFESSIONAL ENGINEER UNDER THE LAWS OF THE  
STATE OF MINNESOTA.

DATE \_\_\_\_\_ REG. NO. 15316

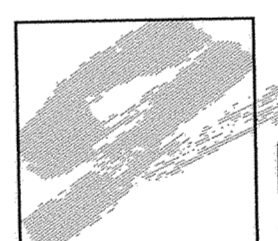 1326 ENERGY PARK DRIVE  
ST. PAUL, MINNESOTA 55108  
(651) 644-4389

**Howard R. Green Company**  
CONSULTING ENGINEERS


PREPARED FOR:

  
City of  
**Elk River**



MARCH 2000

SHEET 1 OF 9

**RECORD PLAN**  
**APRIL 2002**

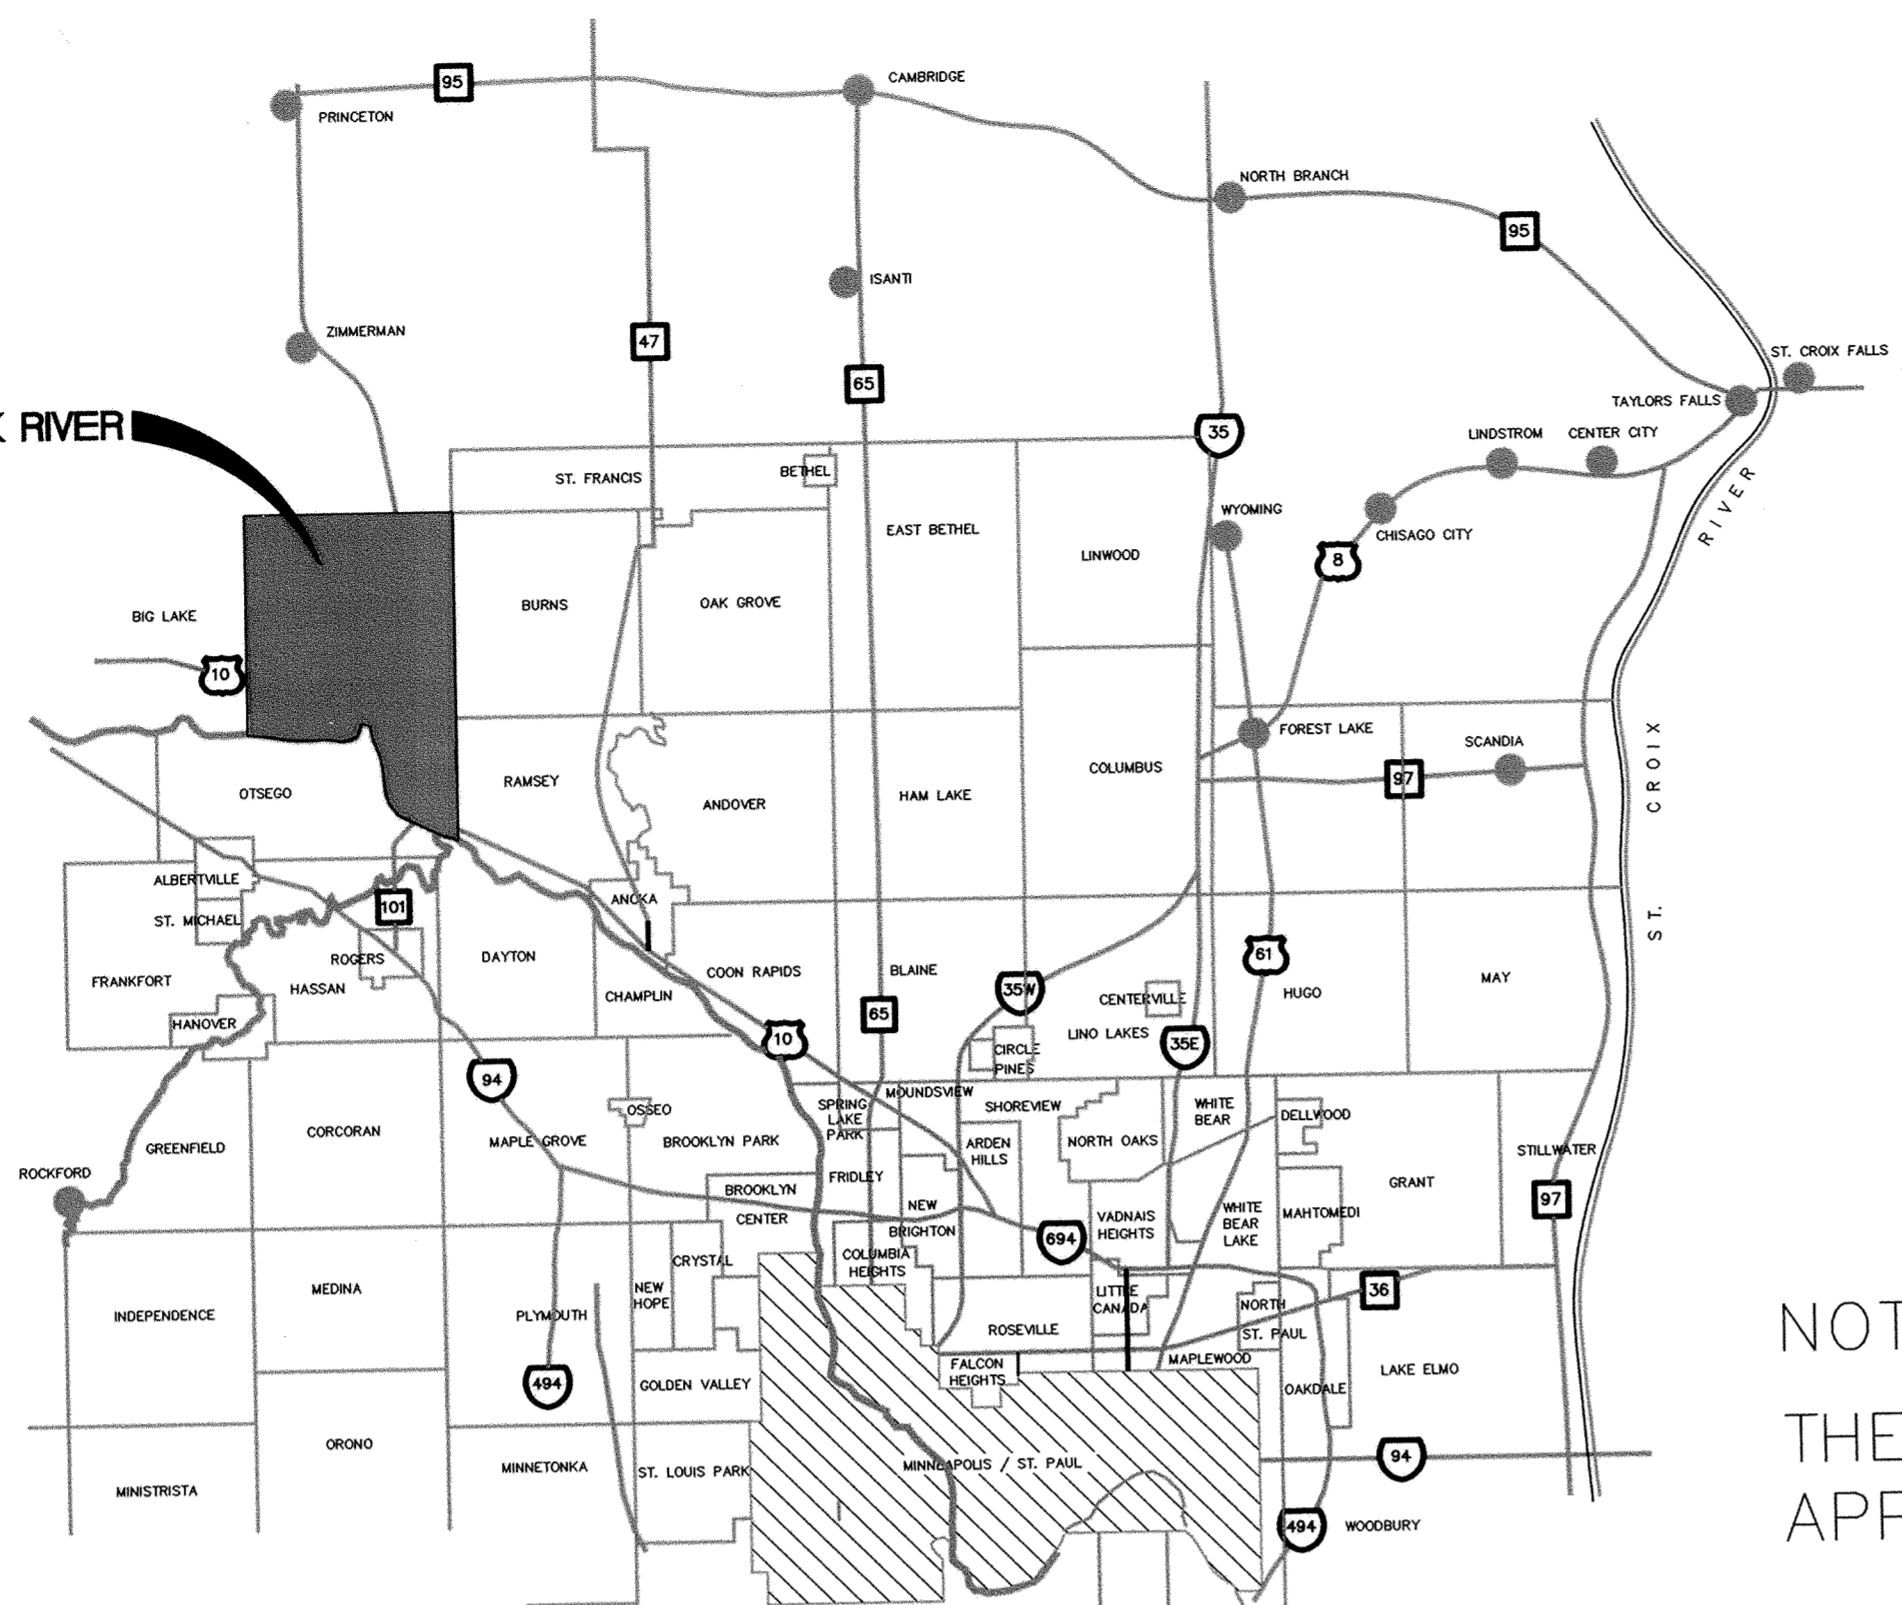

CITY OF ELK RIVER

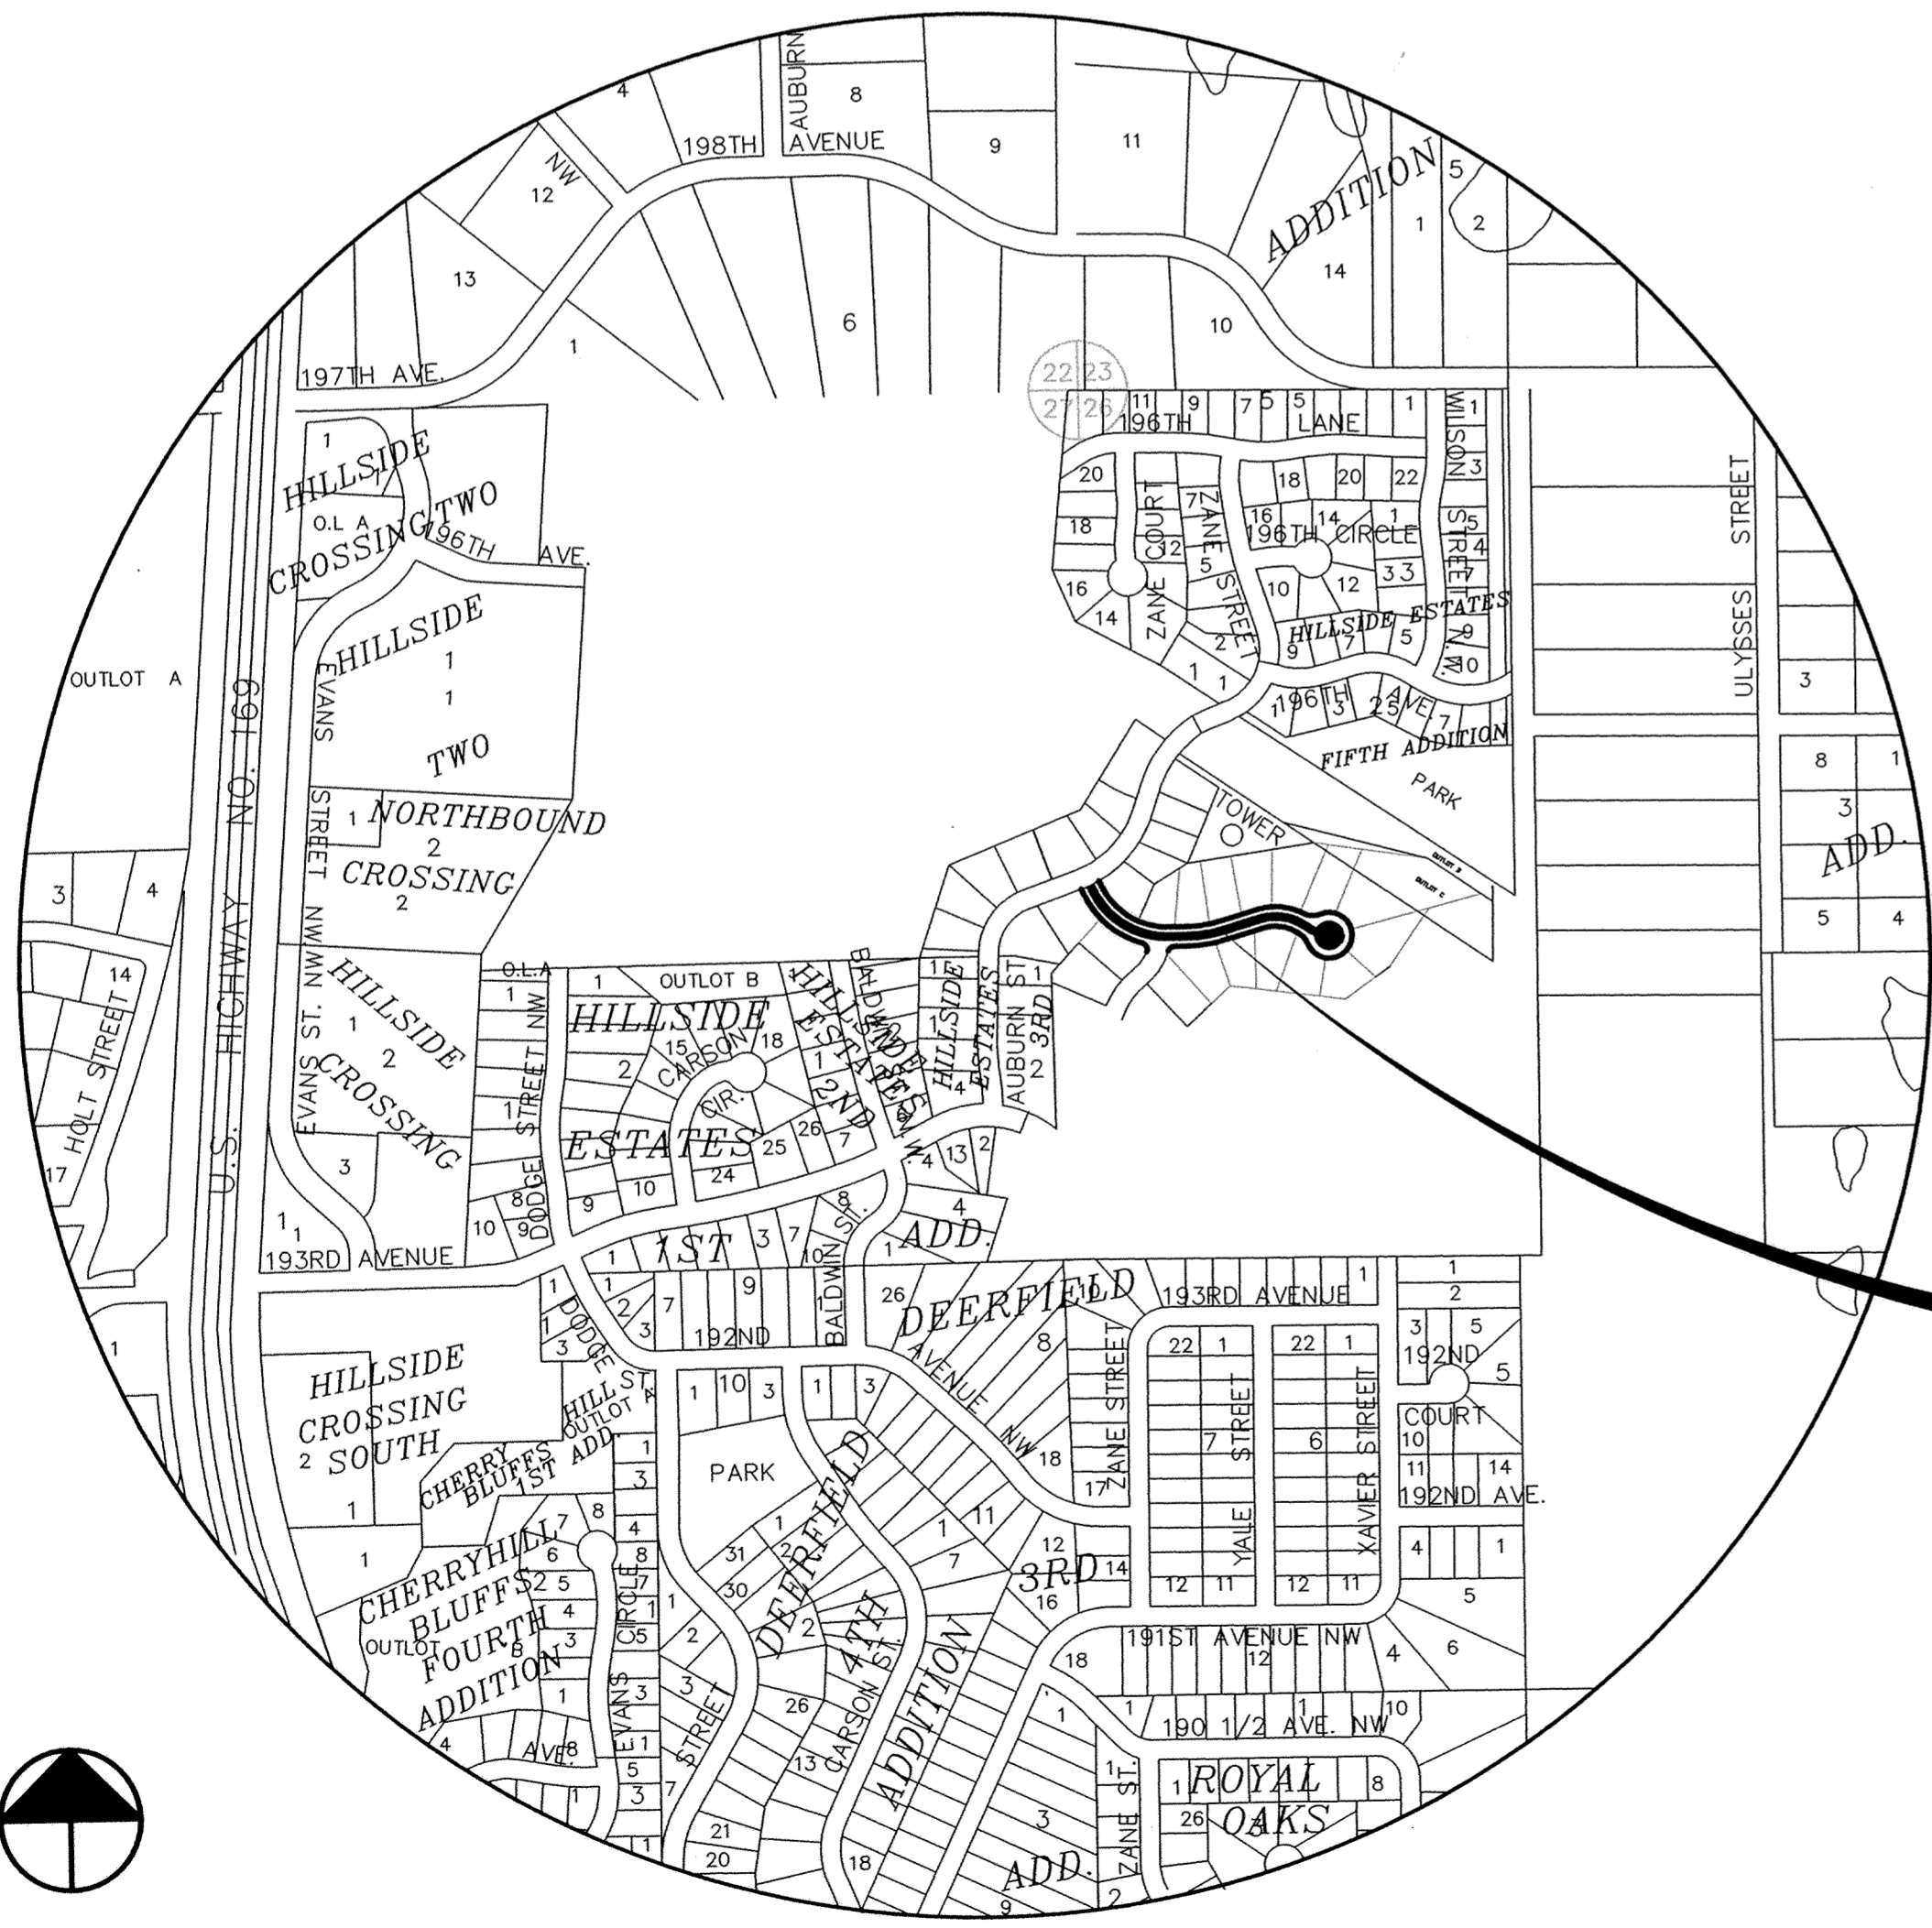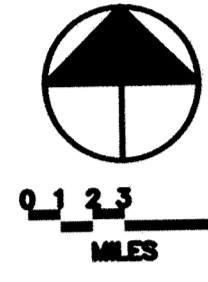

PROJECT LOCATION

195TH STREET NW./195TH COURT  
LOCATION MAP

