
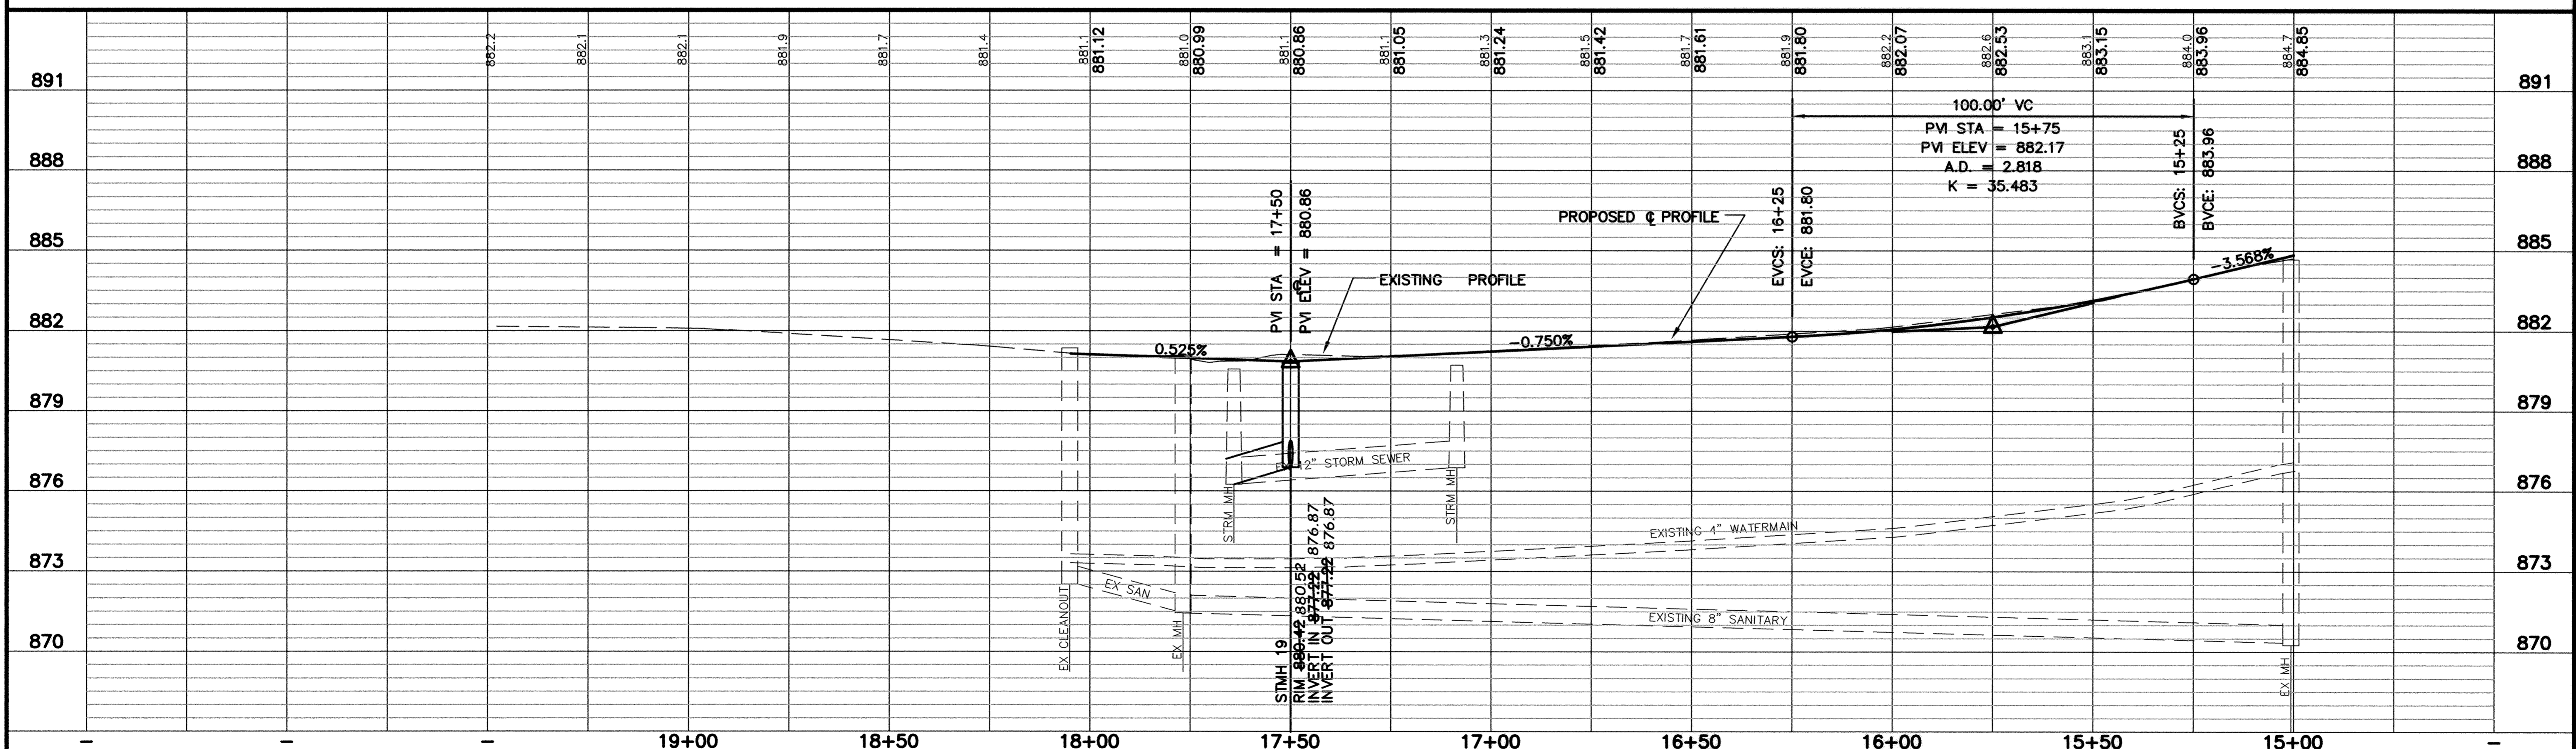


FIFTH STREET

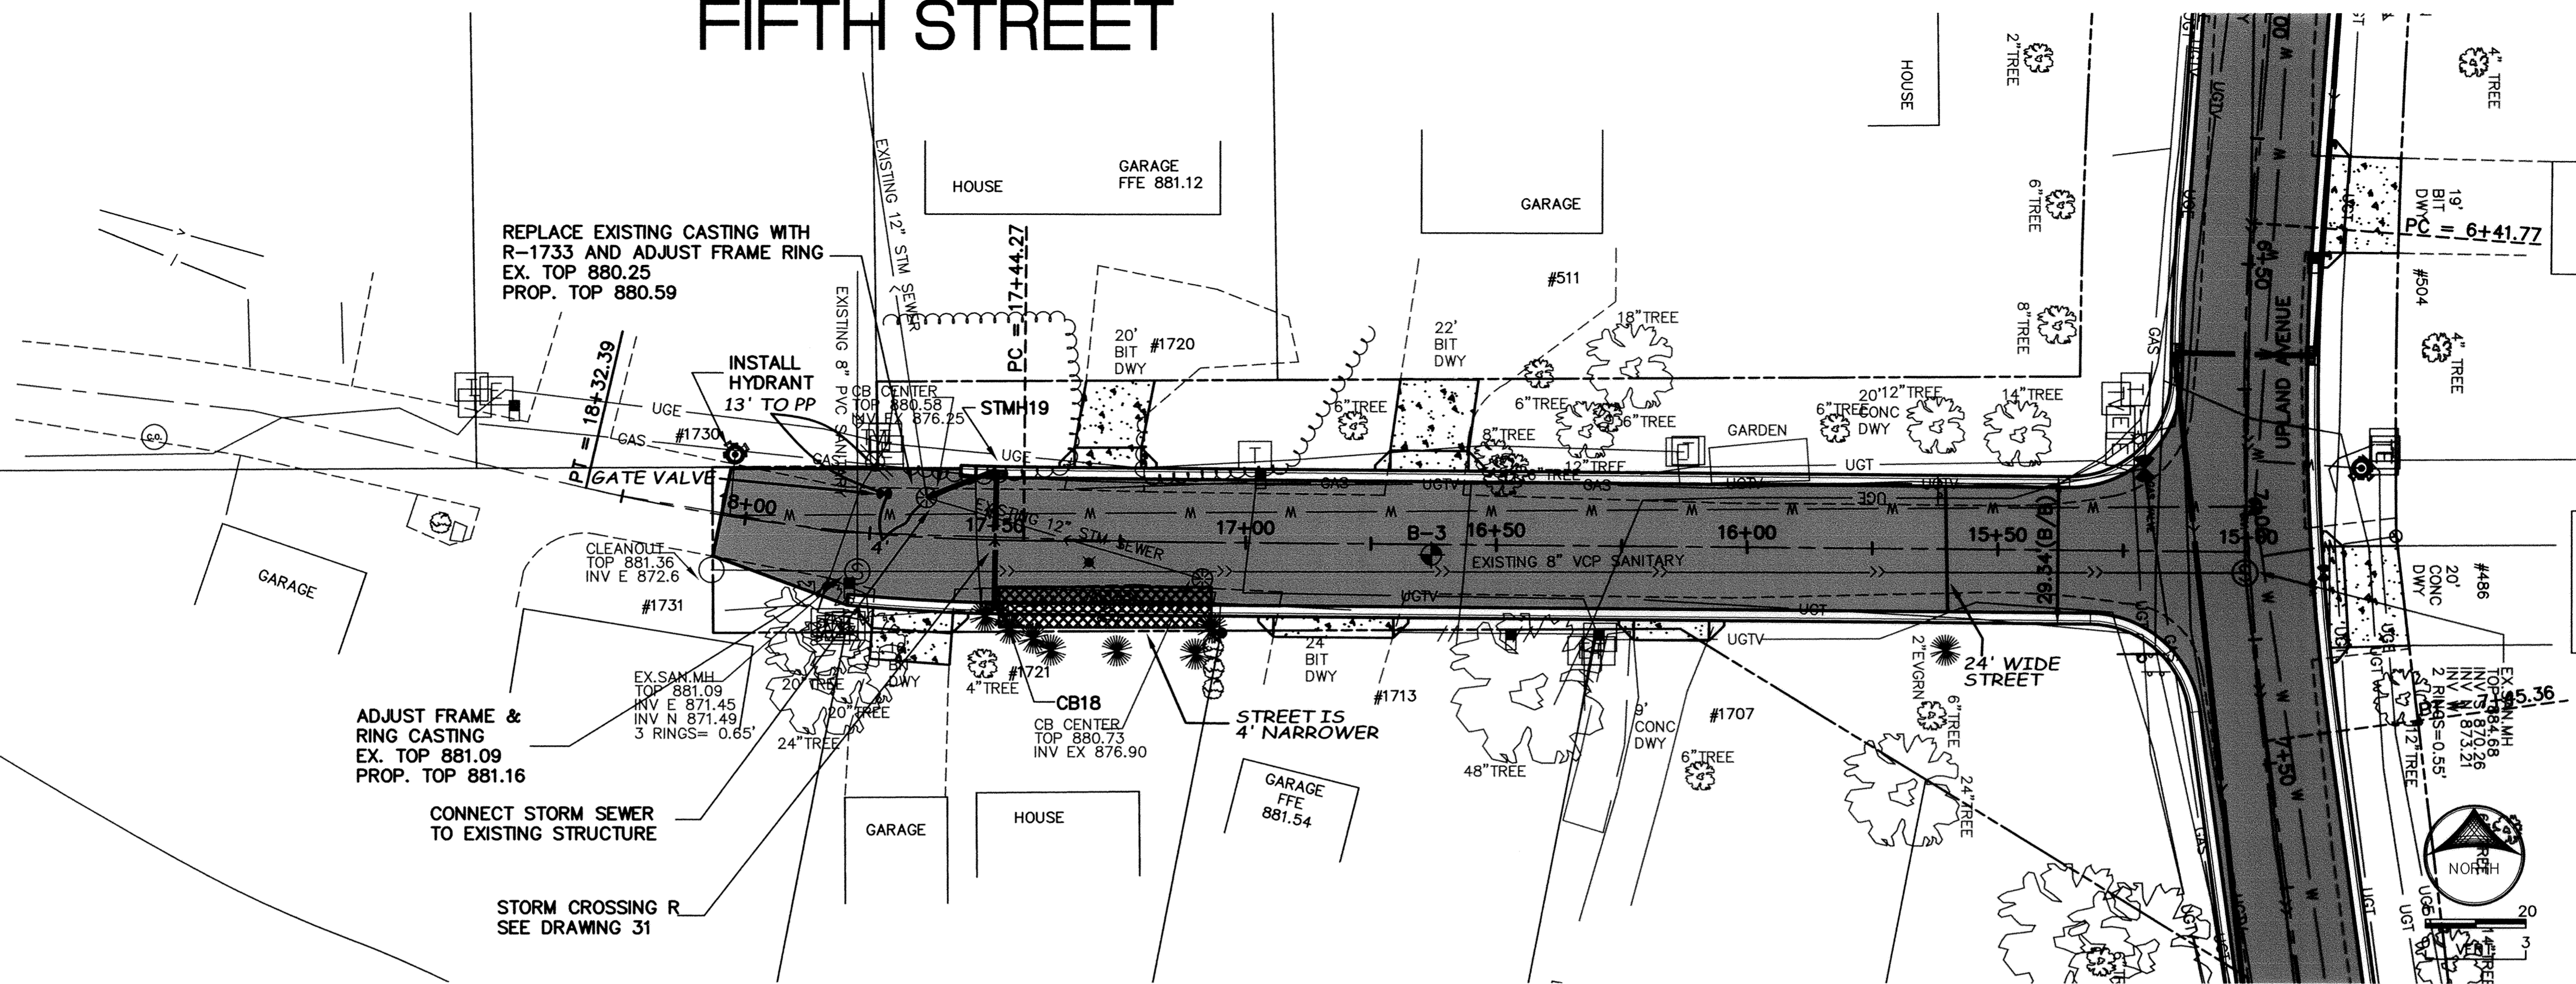

DESIGNED BY: JMA DRAWN BY: LAK
 APPROVED BY: JMA JOB NUMBER: 824180
 CAD DATE: April 01, 2005 2:23:19 p.m.
 CAD FILE: 824180j\Draws\C\CT-15.DWG (JANDERS)

I HEREBY CERTIFY THAT THIS PLAN, SPECIFICATION, OR REPORT WAS PREPARED BY ME OR UNDER MY DIRECT SUPERVISION AND THAT I AM A DULY LICENSED PROFESSIONAL ENGINEER UNDER THE LAWS OF THE STATE OF MINNESOTA.
 SIGNATURE: *John M. Anderson* DATE: 2/2/07
 PRINTED NAME: JOHN M. ANDERSON, P.E. LIC. NO.: 25889

NO.	DATE	BY	REVISION DESCRIPTION

2550 UNIVERSITY AVENUE W, SUITE 400N
 ST. PAUL, MINNESOTA 55114
 (651) 644-4389
 Howard R. Green Company

RECORD PLAN
 2005 STREET IMPROVEMENTS
 CITY OF ELK RIVER

STATION 15+00 TO STATION 18+
PLAN AND PROFILE
FIFTH STREET

SHEET NO.
 15

DRAWING NUMBER
 MAINS 05
 07
 SAECO PRODUCTS • NEW HARB, MINNESOTA
 PRODUCED BY PART NUMBER 824180