
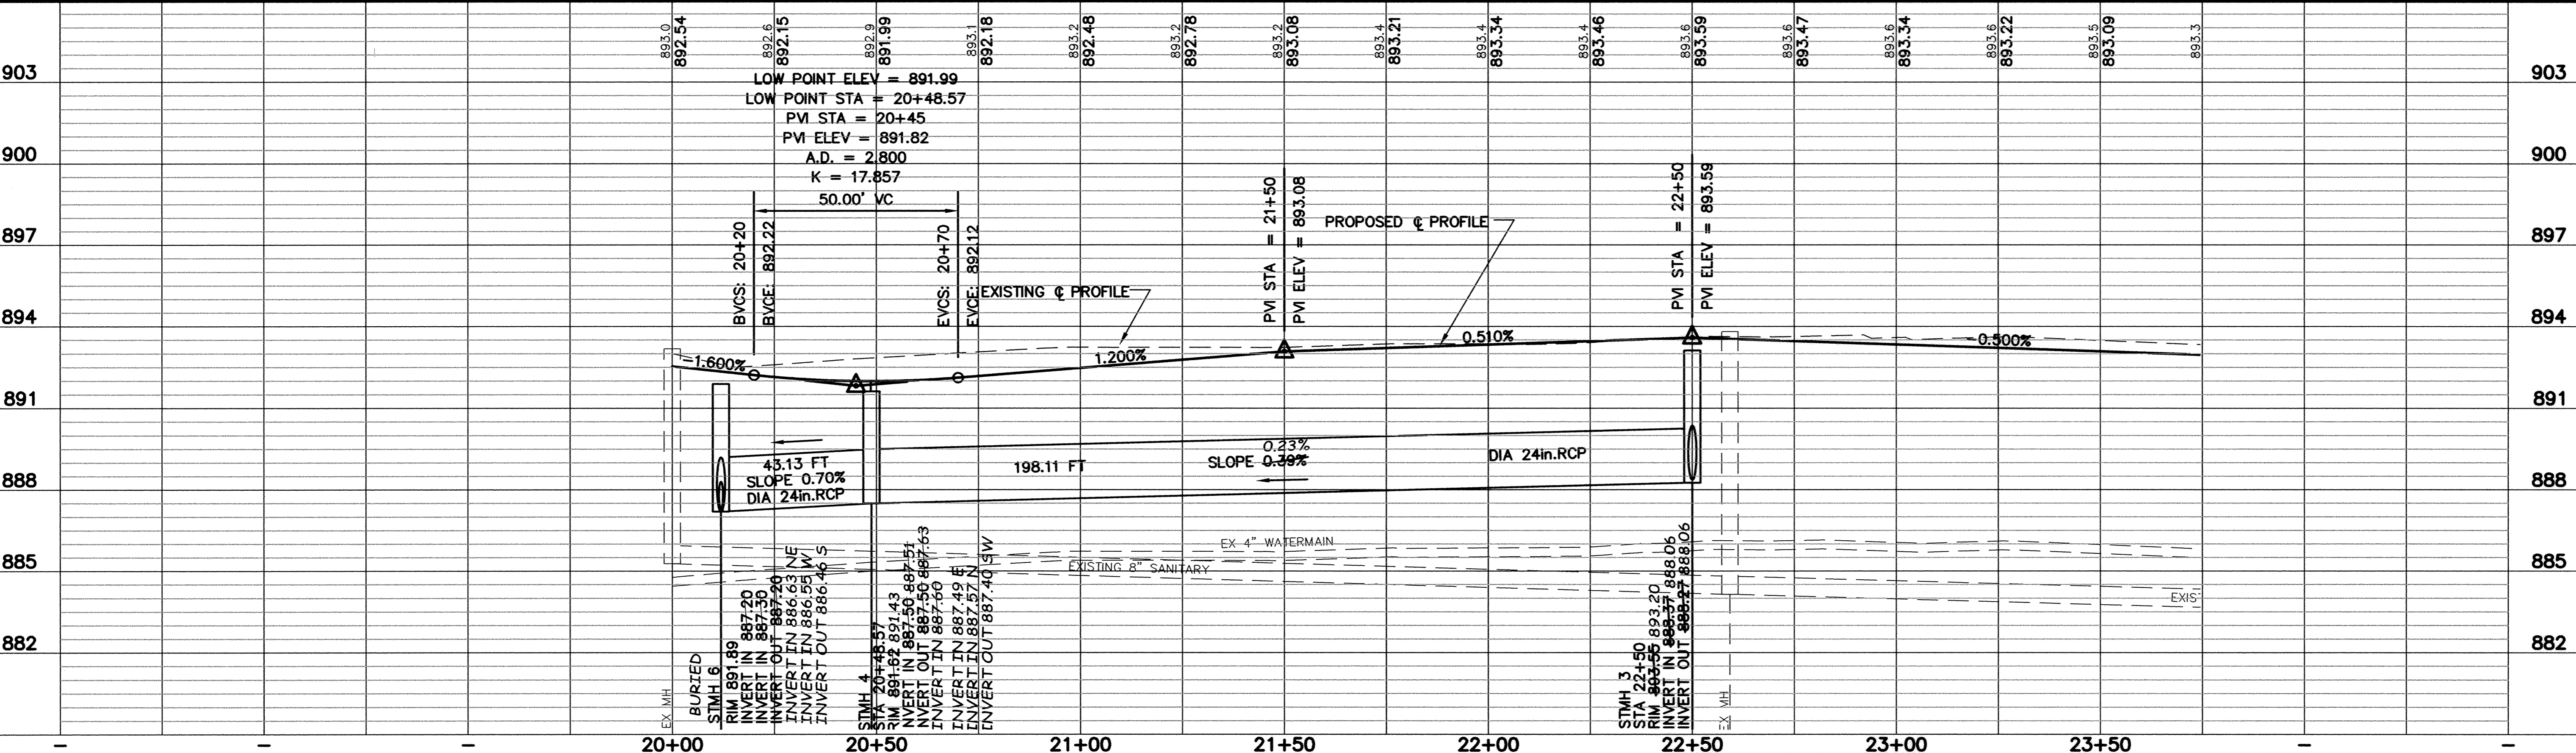
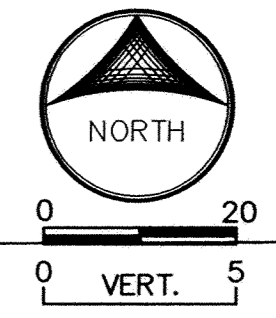


BARCO PRODUCTS • NEW HOPE, MINNESOTA
PROJECT BY PART NUMBER 8028
REVISIONS BY PART NUMBER 8028
BARCO PRODUCTS • NEW HOPE, MINNESOTA
PROJECT BY PART NUMBER 8028
REVISIONS BY PART NUMBER 8028
BARCO PRODUCTS • NEW HOPE, MINNESOTA
PROJECT BY PART NUMBER 8028
REVISIONS BY PART NUMBER 8028

TIPTON AVE

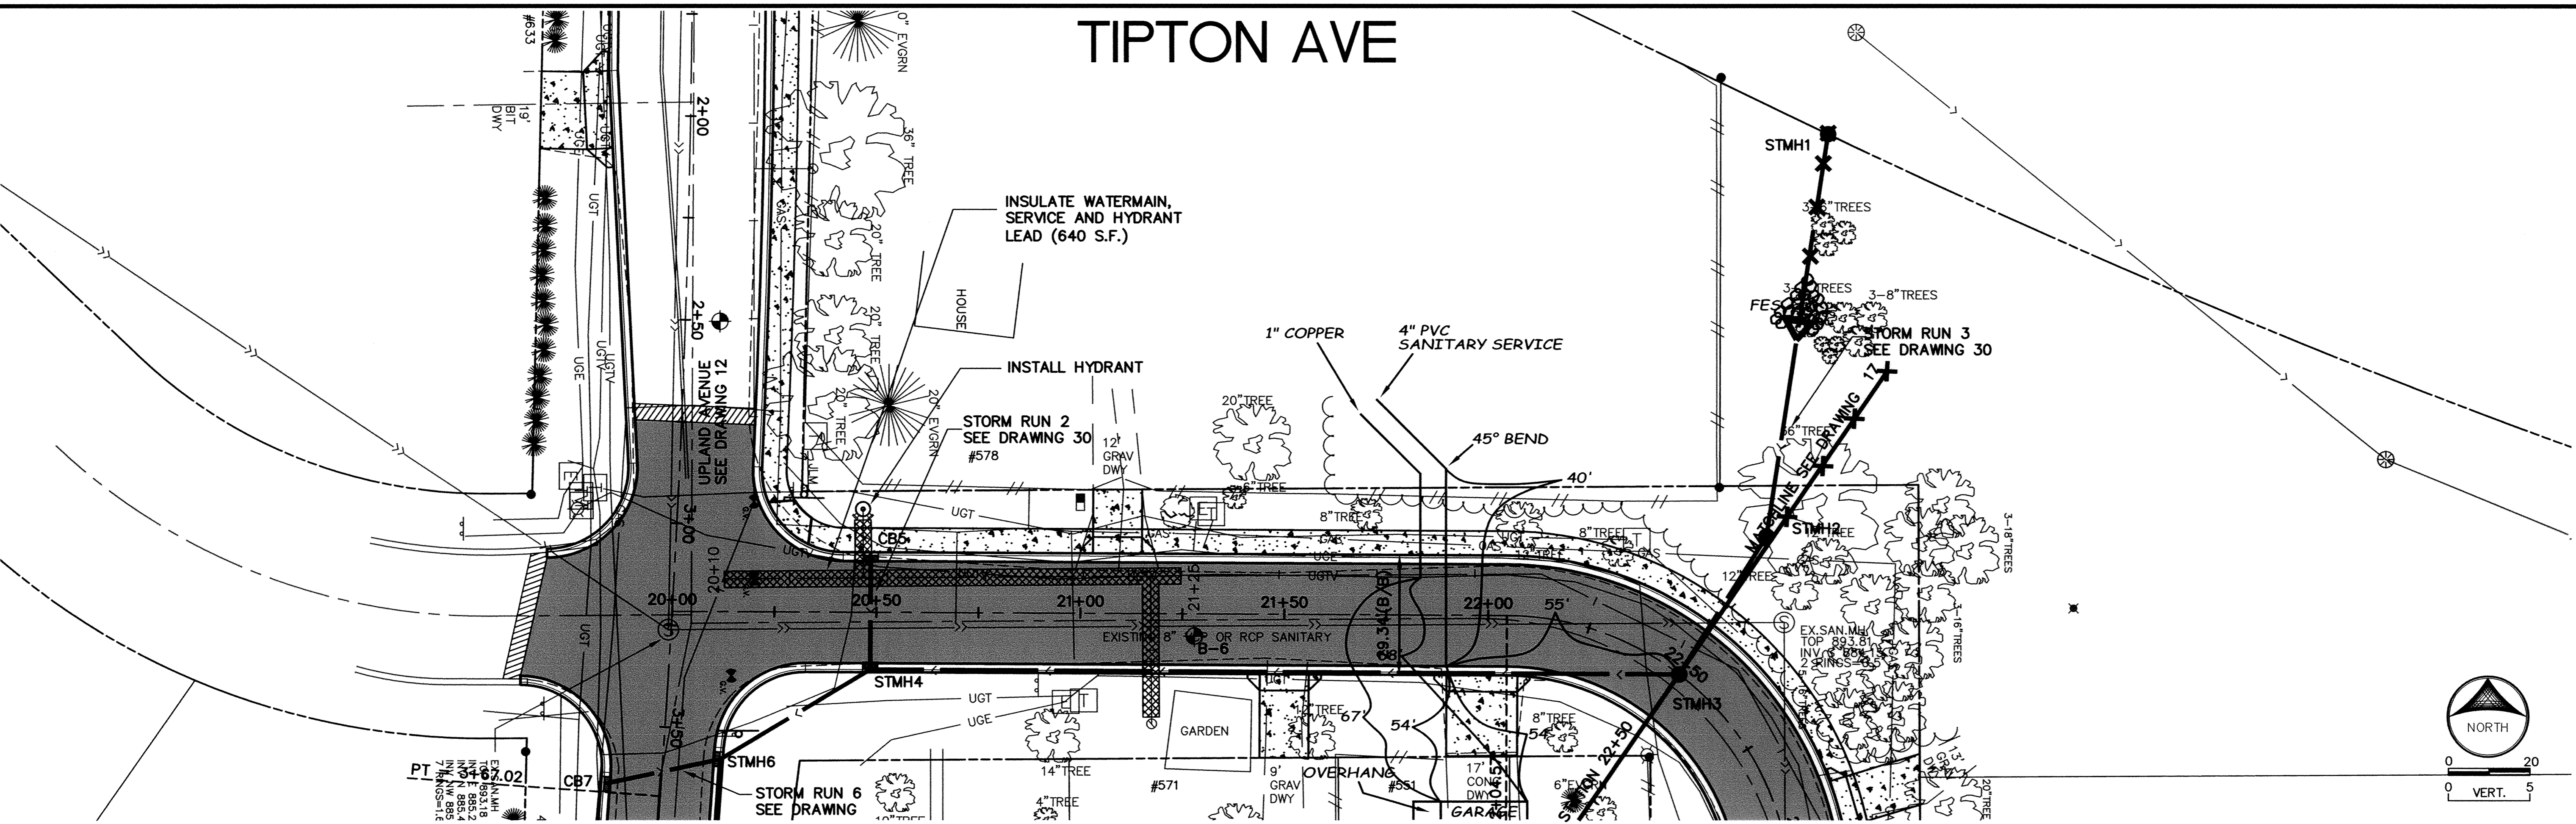

DESIGNED BY: JAM DRAWN BY: LAK
 APPROVED BY: JMA JOB NUMBER: 824180J
 CAD DATE: March 31, 2005 12:56:41 p.m.
 CAD FILE: 824180j\Draws\C\CT-16.DWG (TLAMKIN)

I HEREBY CERTIFY THAT THIS PLAN, SPECIFICATION, OR REPORT WAS PREPARED BY ME OR UNDER MY DIRECT SUPERVISION AND THAT I AM A DULY LICENSED PROFESSIONAL ENGINEER UNDER THE LAWS OF THE STATE OF MINNESOTA.

SIGNATURE: *John M. Anderson* DATE: 2/26/07
 PRINTED NAME: JOHN M. ANDERSON, P.E. LIC. NO.: 25889

NO.	DATE	BY	REVISION DESCRIPTION

2550 UNIVERSITY AVENUE W, SUITE 400N
 ST. PAUL, MINNESOTA 55114
 (651) 644-4389

RECORD PLAN
 2005 STREET IMPROVEMENTS
 CITY OF ELK RIVER

Howard R. Green Company

STATION 20+00 TO STATION 22+50
PLAN AND PROFILE
 TIPTON AVENUE

SHEET NO.
 16