
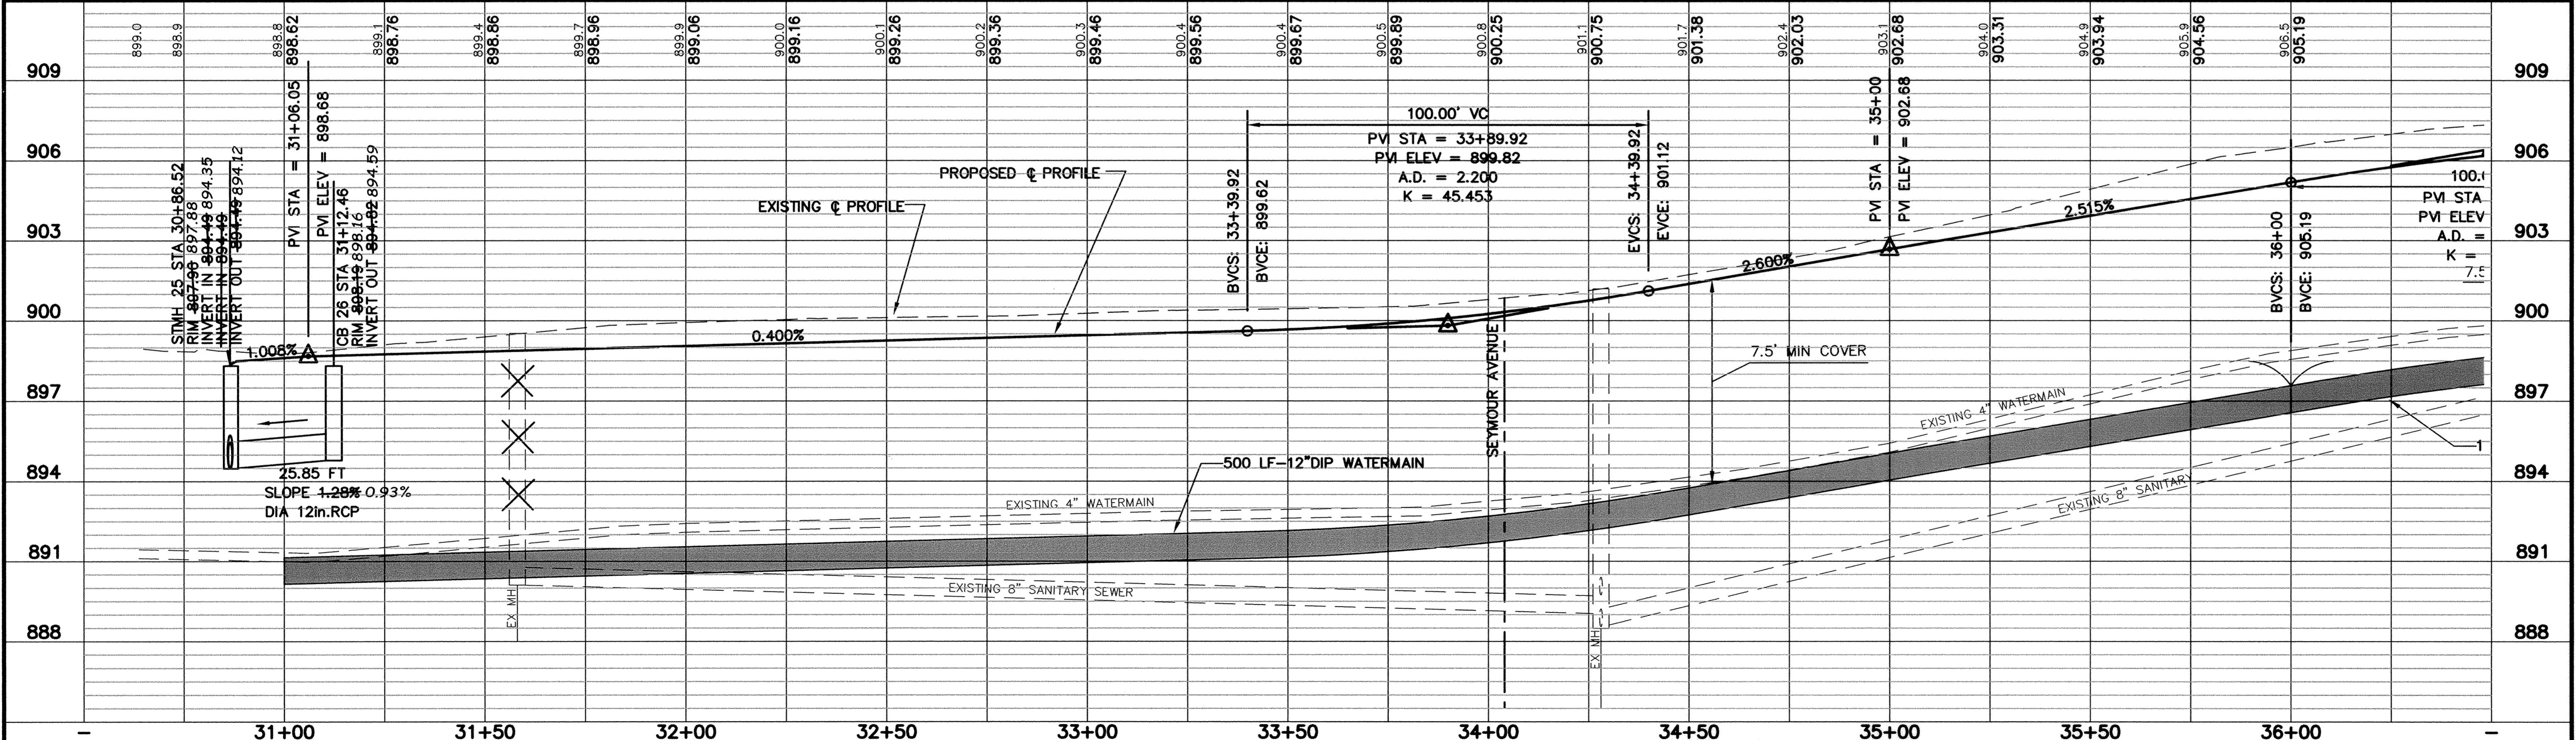
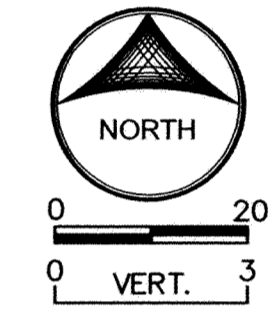


# FIFTH STREET

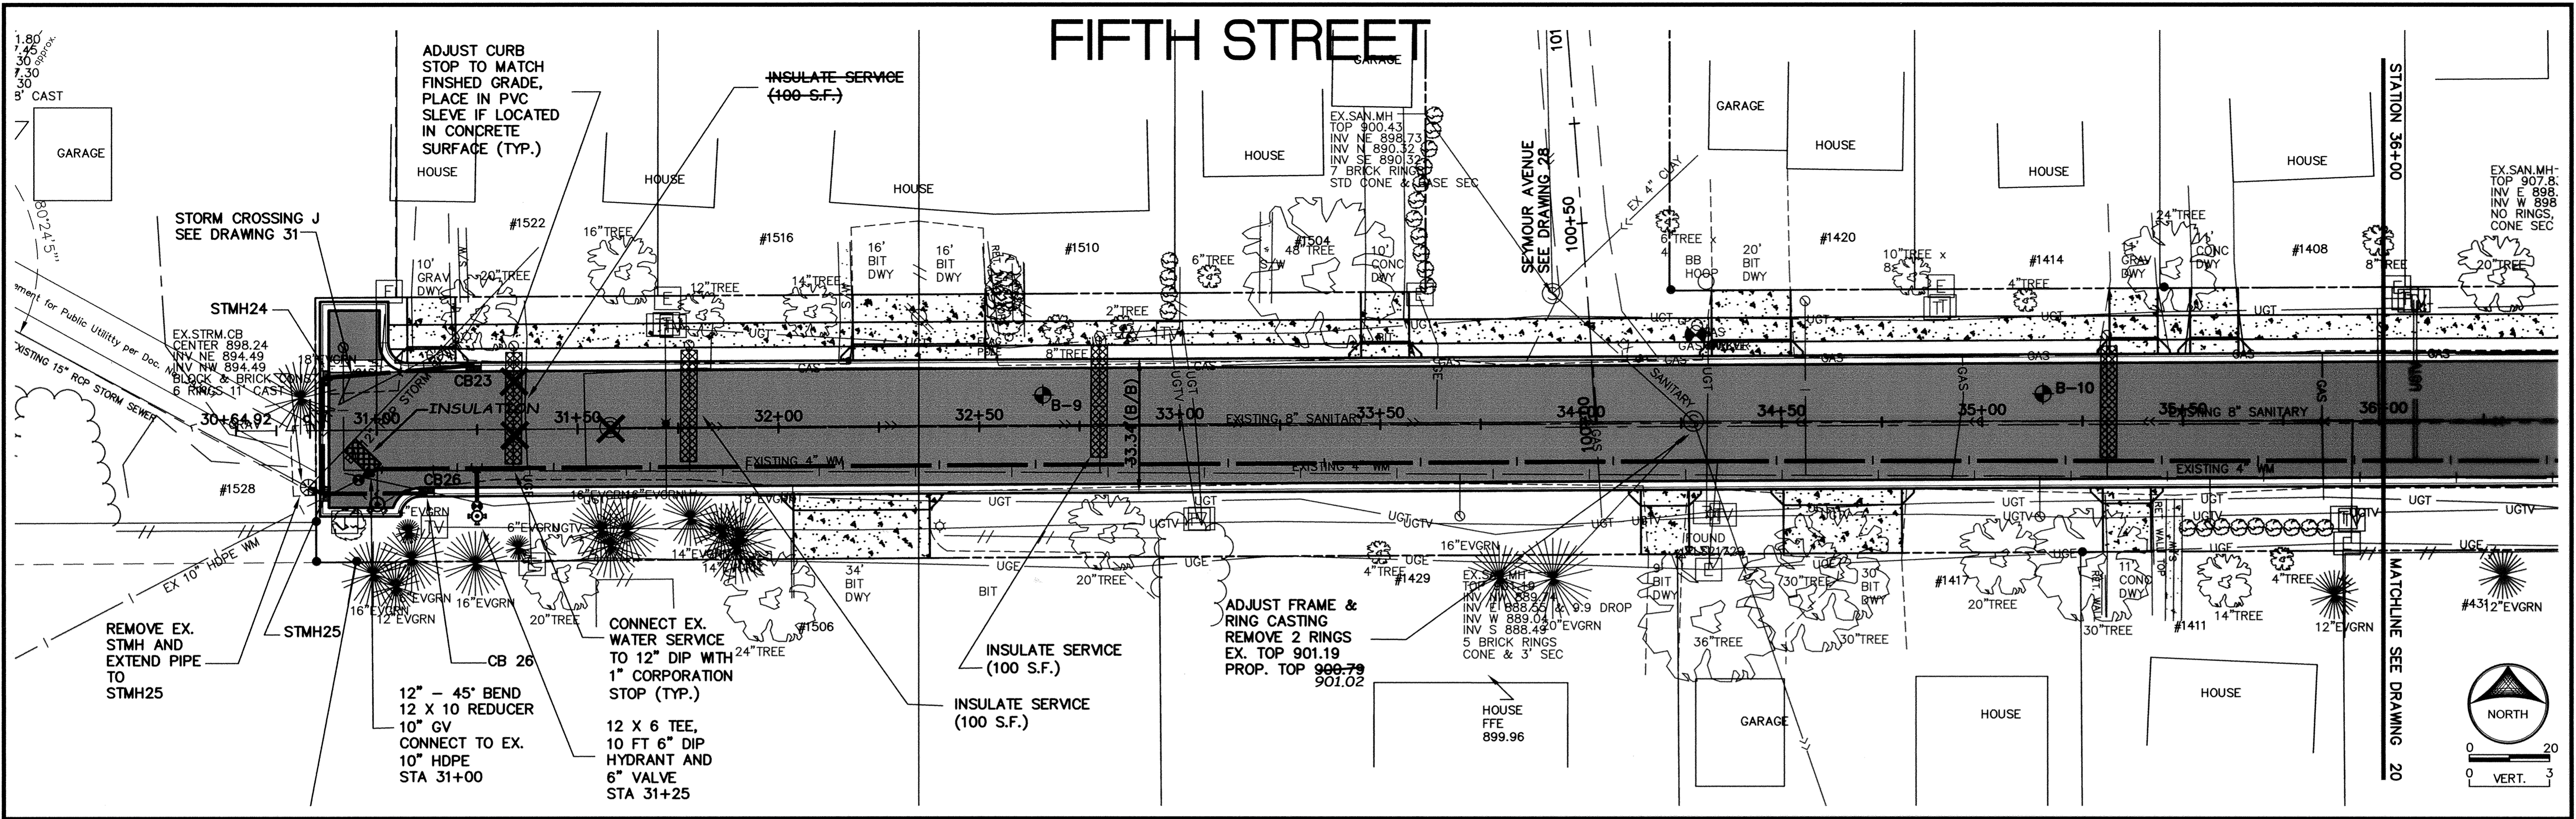

DESIGNED BY: JMA      DRAWN BY: LAK  
 APPROVED BY: JMA      JOB NUMBER: 824180J  
 CAD DATE: April 01, 2005 8:04:53 a.m.  
 CAD FILE: 824180J\Drawings\CT-19.DWG (TLAMKIN)

I HEREBY CERTIFY THAT THIS PLAN, SPECIFICATION, OR REPORT WAS PREPARED BY ME OR UNDER MY DIRECT SUPERVISION AND THAT I AM A DULY LICENSED PROFESSIONAL ENGINEER UNDER THE LAWS OF THE STATE OF MINNESOTA.  
 SIGNATURE: *John M. Anderson*      DATE: 2/2/07  
 PRINTED NAME: JOHN M. ANDERSON      LIC. NO.: 25889

NO.	DATE	BY	REVISION DESCRIPTION

2550 UNIVERSITY AVENUE W, SUITE 400N  
 ST. PAUL, MINNESOTA 55114  
 (651) 644-4389  

 Howard R. Green Company

**RECORD PLAN**  
 2005 STREET IMPROVEMENTS  
 CITY OF ELK RIVER

STATION 30+75 TO STATION 36+00  
**PLAN AND PROFILE**  
**FIFTH STREET**

SHEET NO.  
 19