
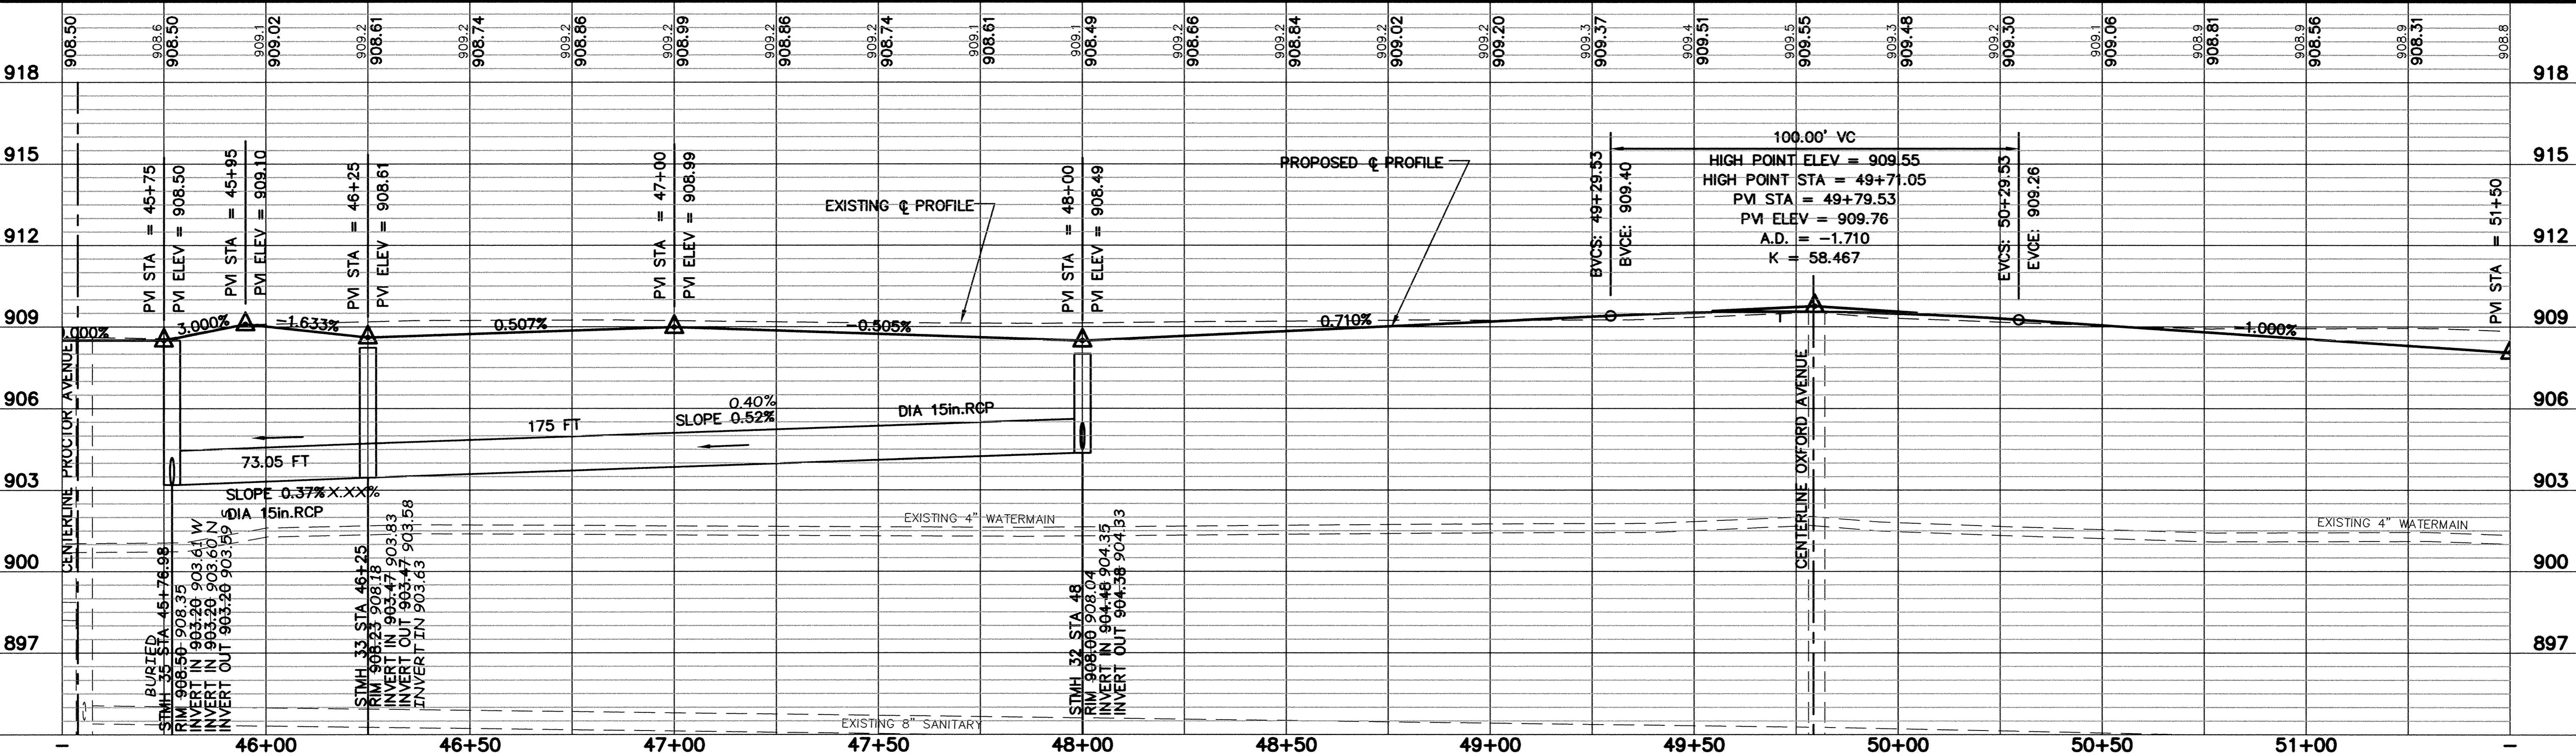


# FIFTH STREET

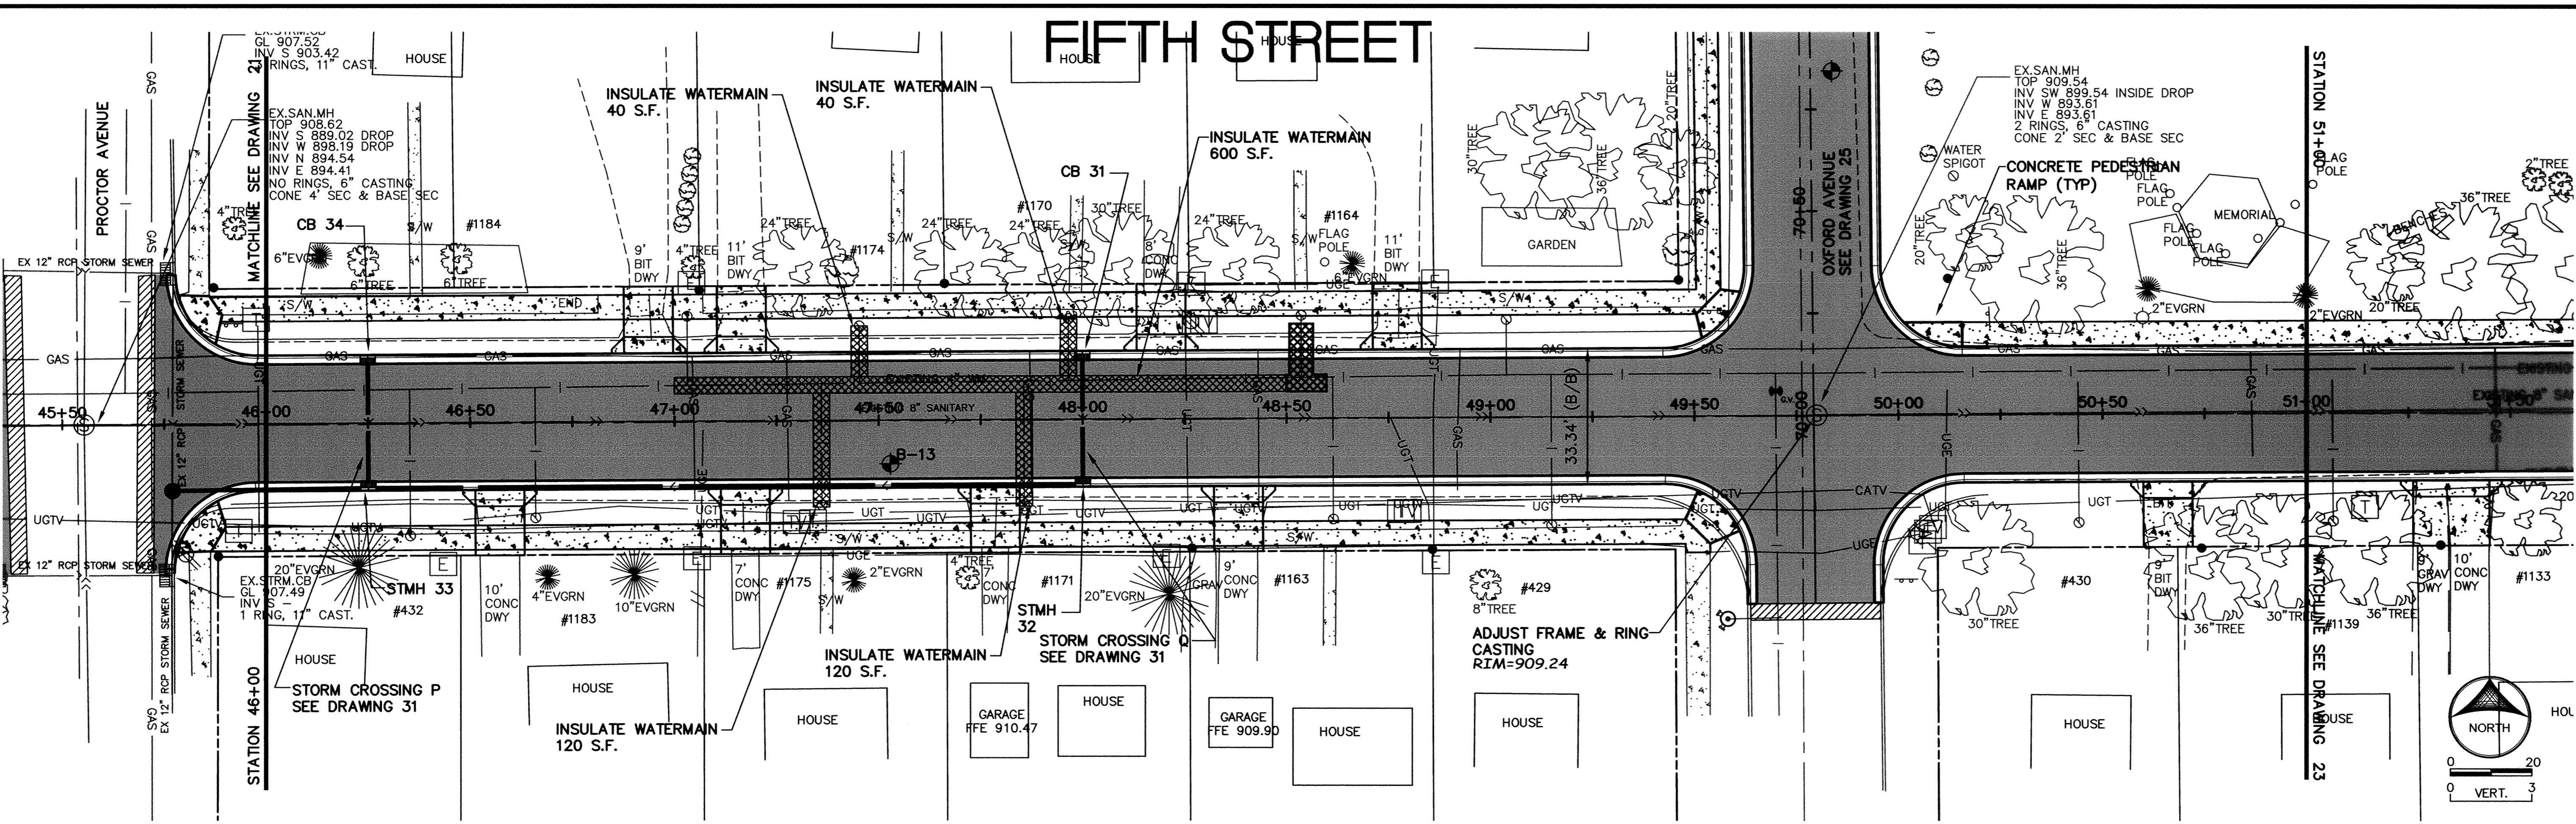

DESIGNED BY: JMA  
 DRAWN BY: LAK  
 APPROVED BY: JMA  
 JOB NUMBER 824180J  
 CAD DATE: April 01, 2005 1:23:55 p.m.  
 CAD FILE: 824180J\Draws\CT-22.DWG (LKIEWEL)

I HEREBY CERTIFY THAT THIS PLAN, SPECIFICATION, OR REPORT WAS PREPARED BY ME OR UNDER MY DIRECT SUPERVISION AND THAT I AM A DULY LICENSED PROFESSIONAL ENGINEER UNDER THE LAWS OF THE STATE OF MINNESOTA.  
 SIGNATURE: *John M. Anderson* DATE: 2/2/07  
 PRINTED NAME: JOHN M. ANDERSON P.E. LIC. NO. 25889

NO.	DATE	BY	REVISION DESCRIPTION

2550 UNIVERSITY AVENUE W, SUITE 400N  
 ST. PAUL, MINNESOTA 55114  
 (651) 644-4389  
  
 Howard R. Green Company

**RECORD PLAN**  
 2005 STREET IMPROVEMENTS  
 CITY OF ELK RIVER

STATION 46+00 TO STATION 51+00  
**PLAN AND PROFILE**  
 FIFTH STREET

SHEET NO.  
 22