
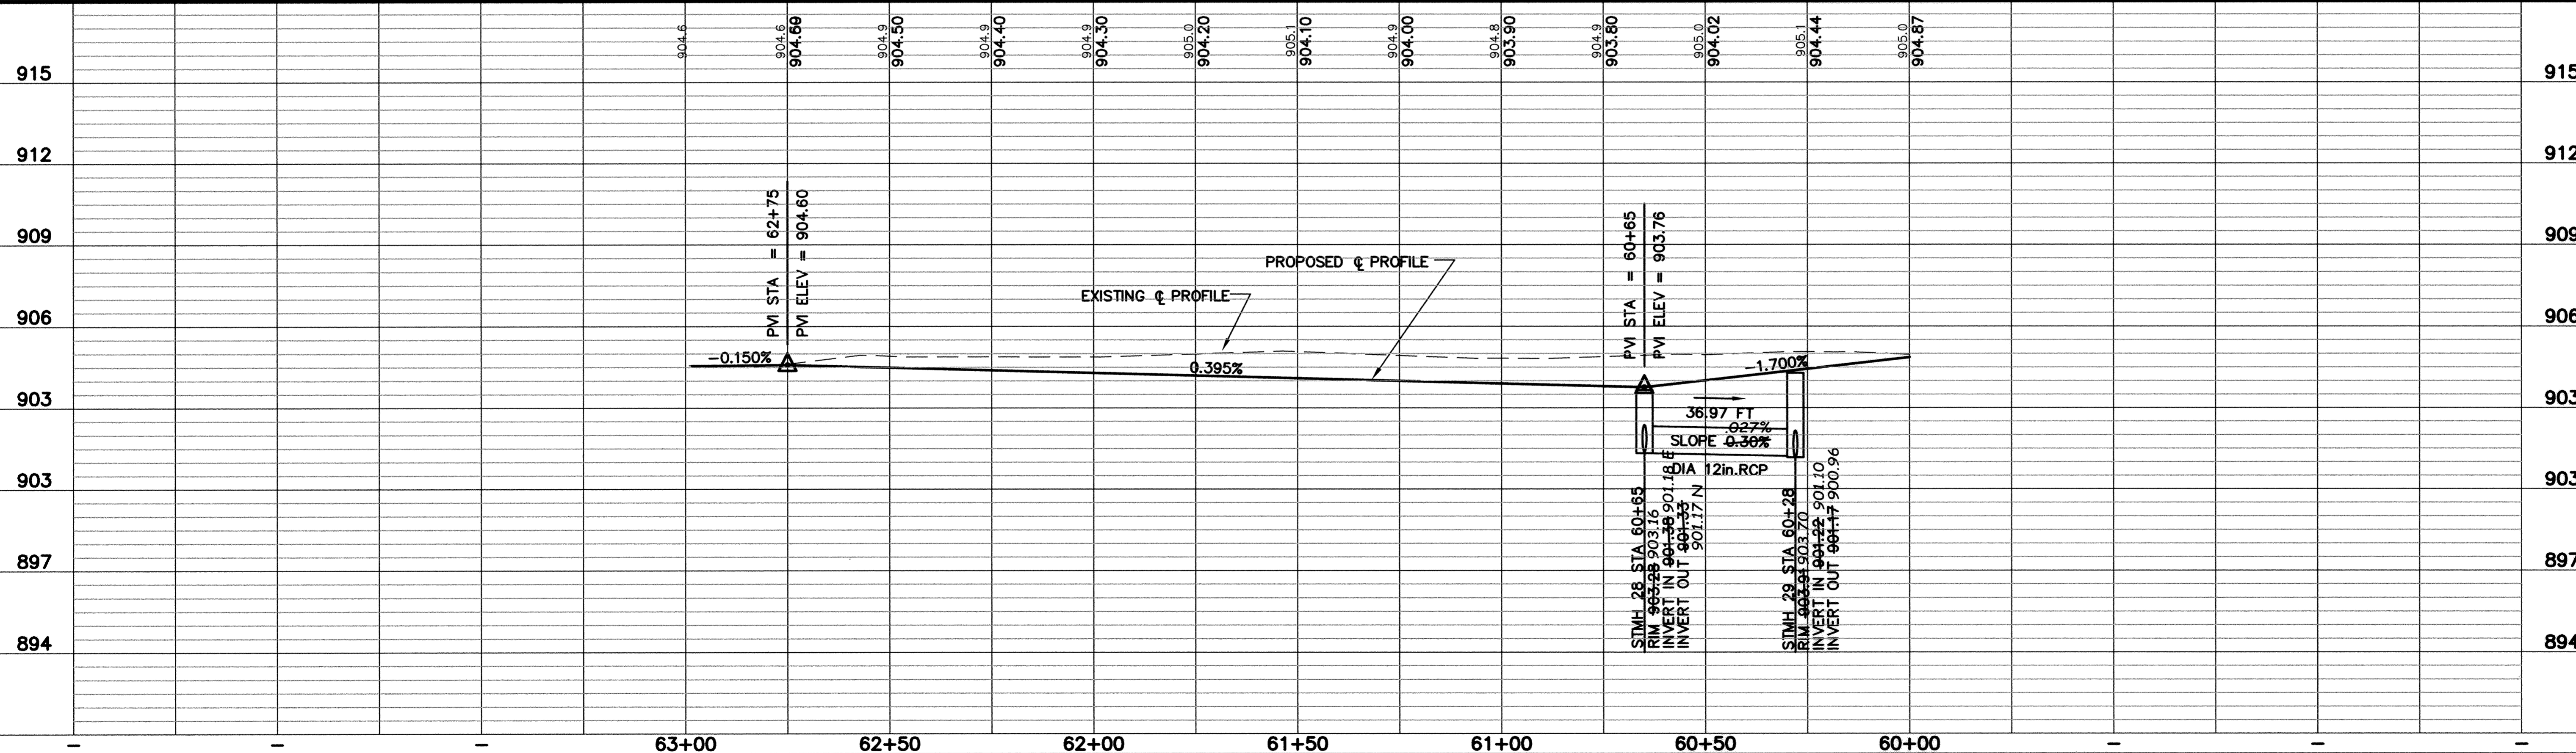
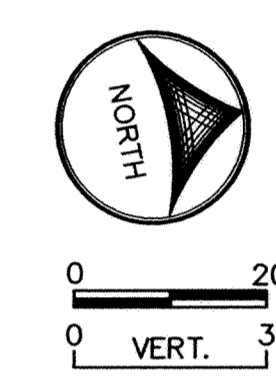


NORFOLK AVE

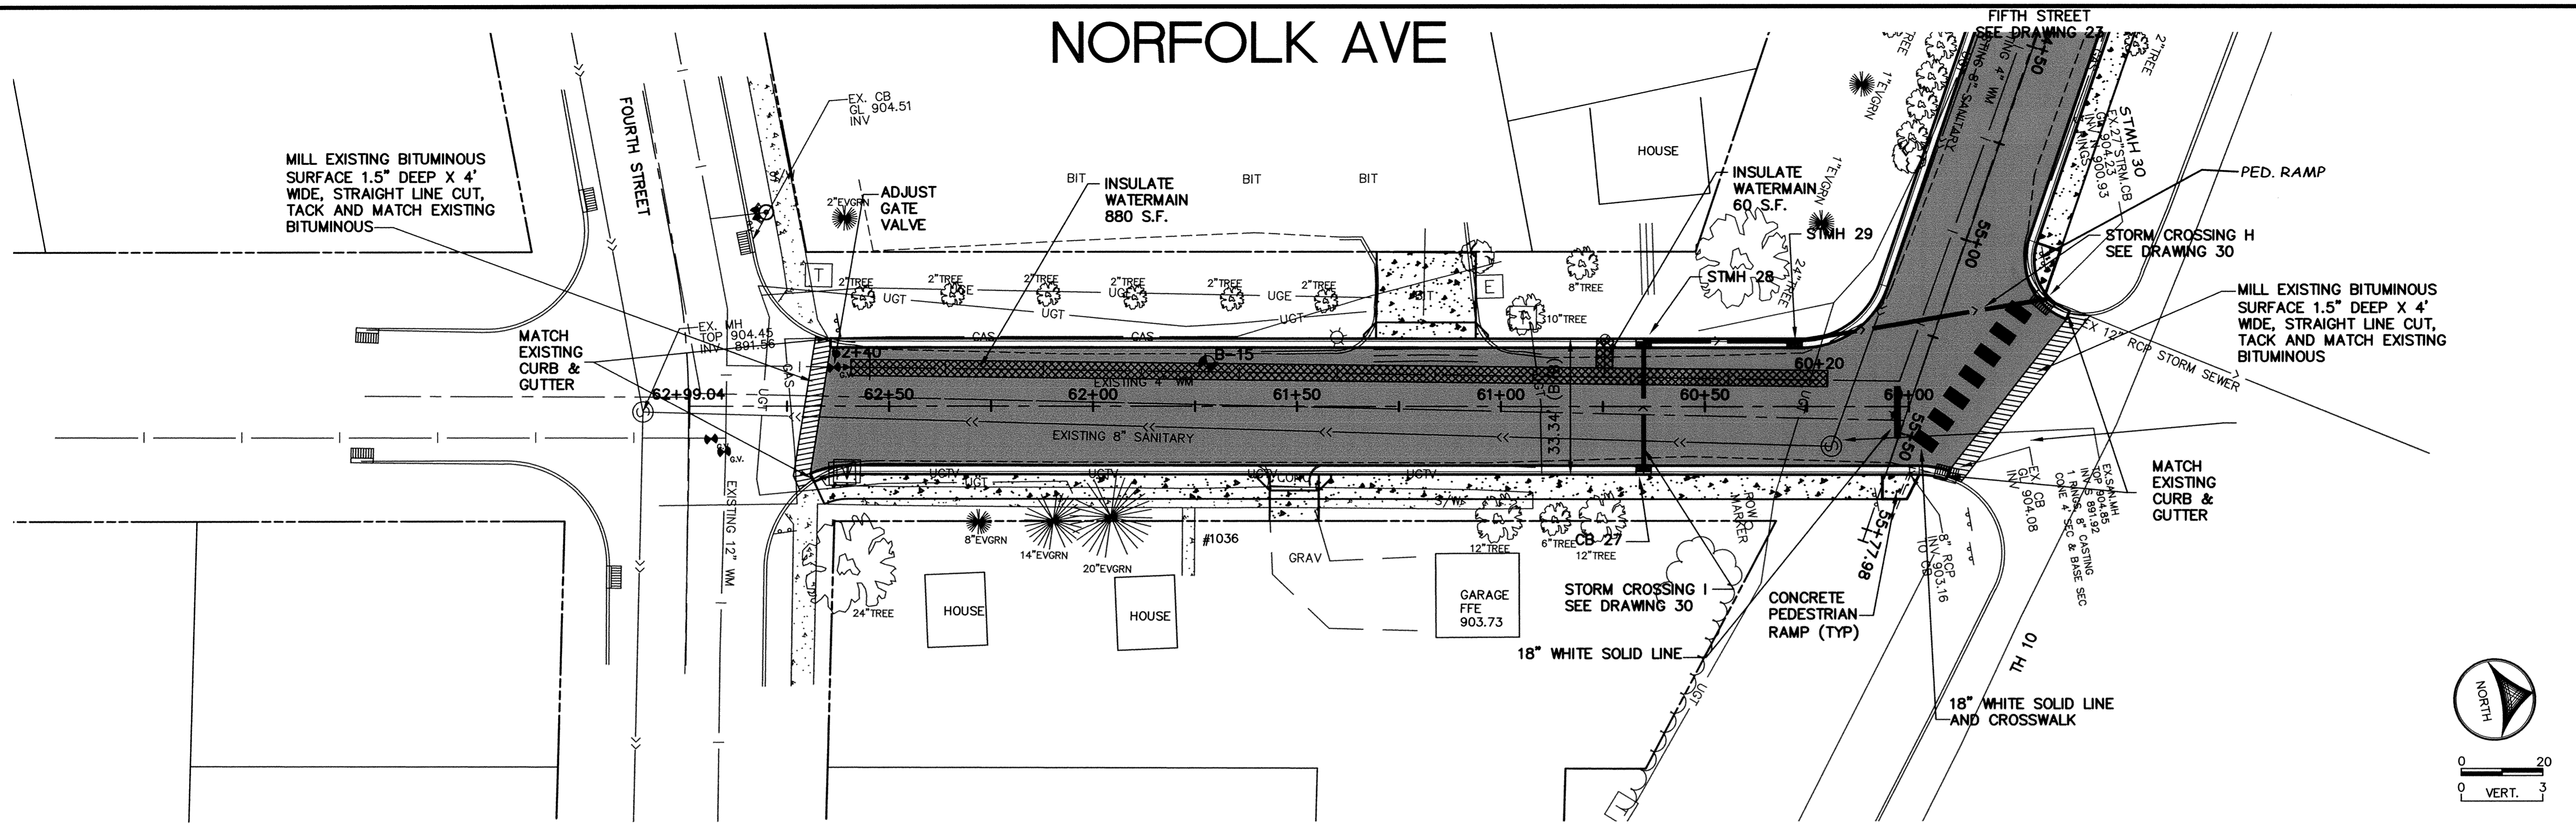

DESIGNED BY: JMA DRAWN BY: LAK
 APPROVED BY: JMA JOB NUMBER: 824180J
 CAD DATE: March 31, 2005 11:40:00 a.m.
 CAD FILE: 824180j\Drawgs\C\CT-24.DWG (LKIEWEL)

I HEREBY CERTIFY THAT THIS PLAN, SPECIFICATION, OR REPORT WAS PREPARED BY ME OR UNDER MY DIRECT SUPERVISION AND THAT I AM A DULY LICENSED PROFESSIONAL ENGINEER UNDER THE LAWS OF THE STATE OF MINNESOTA.
 SIGNATURE: *John M. Anderson* DATE: 7/2/07
 PRINTED NAME: JOHN M. ANDERSON P.E. LIC. NO. 25889

NO.	DATE	BY	REVISION DESCRIPTION

2550 UNIVERSITY AVENUE W, SUITE 400N
 ST. PAUL, MINNESOTA 55114
 (651) 644-4389

 Howard R. Green Company

RECORD PLAN
 2005 STREET IMPROVEMENTS
 CITY OF ELK RIVER

STATION 60+00 TO STATION 62+99
PLAN AND PROFILE
NORFOLK AVENUE

SHEET NO.
 24

DRAWING NUMBER: 824180J
 SHEET NO.: 24
 PROJECT: 2005 STREET IMPROVEMENTS
 CITY OF ELK RIVER
 DATE: 7/2/07
 DRAWN BY: LAK
 CHECKED BY: JMA
 DESIGNED BY: JMA
 APPROVED BY: JMA
 CAD DATE: March 31, 2005 11:40:00 a.m.
 CAD FILE: 824180j\Drawgs\C\CT-24.DWG (LKIEWEL)