
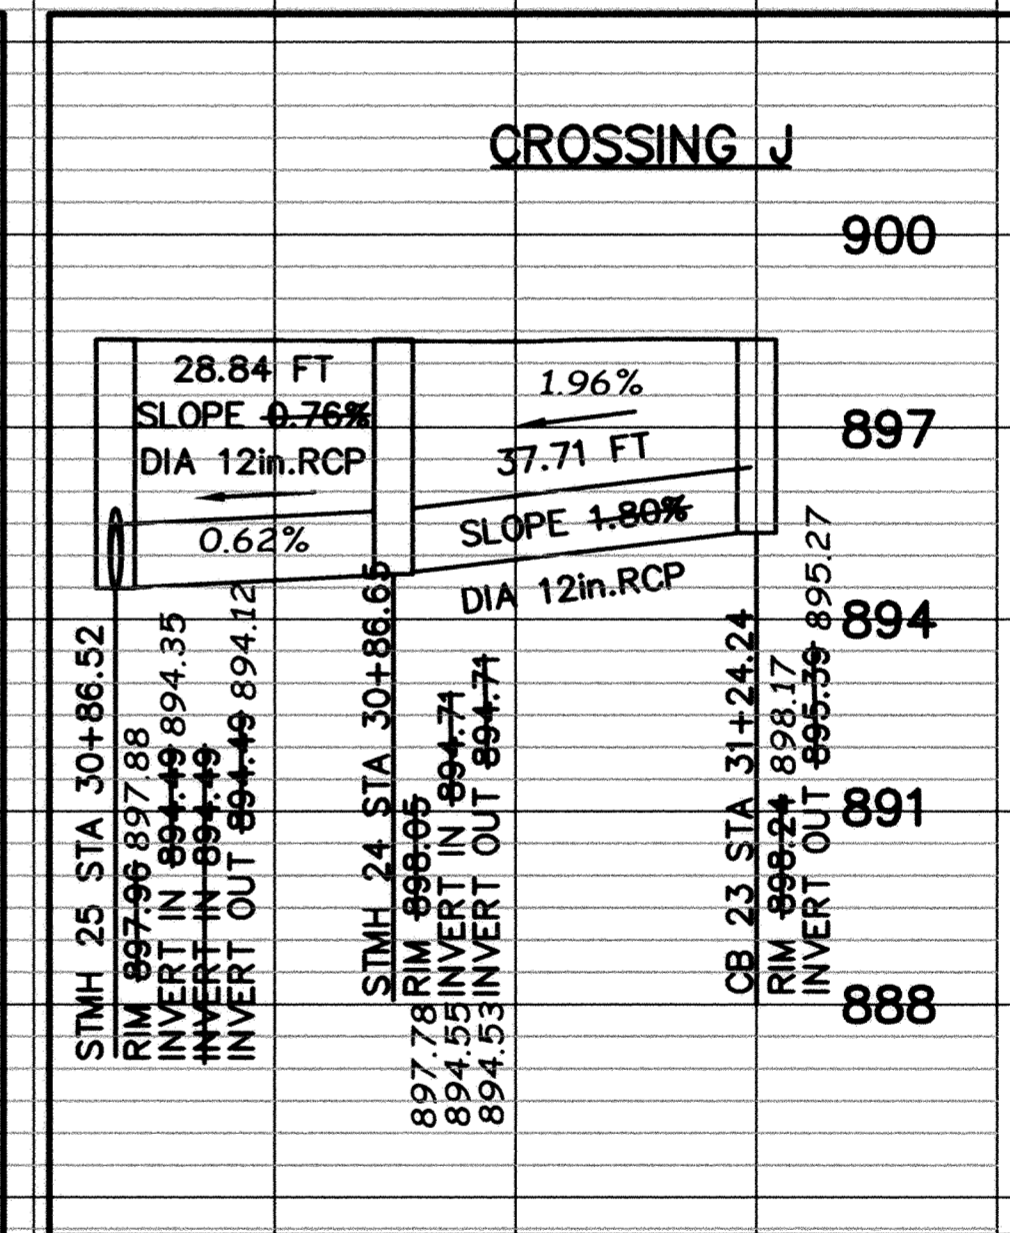
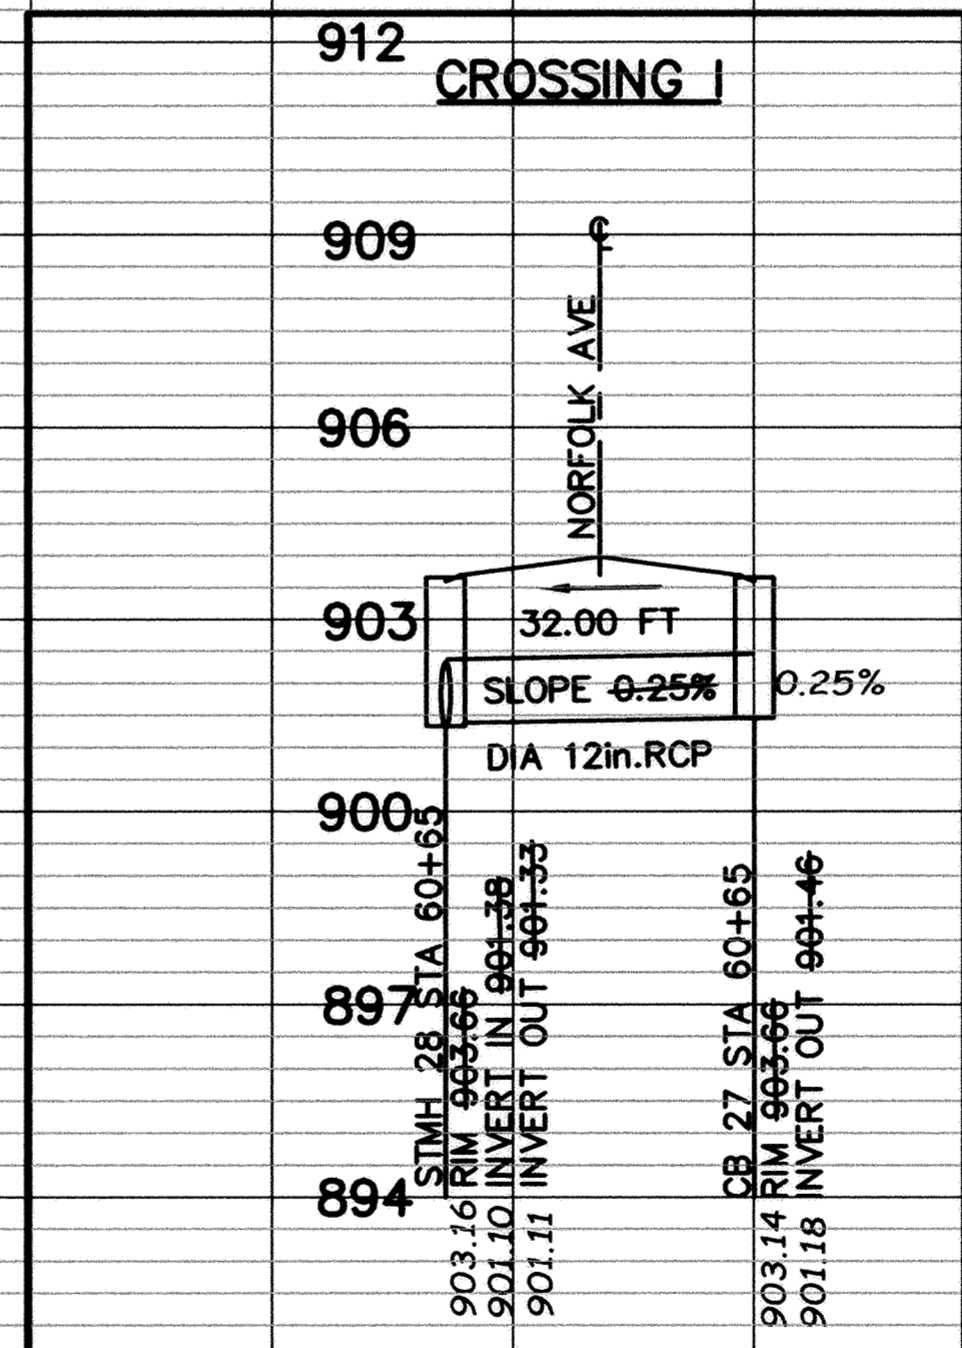
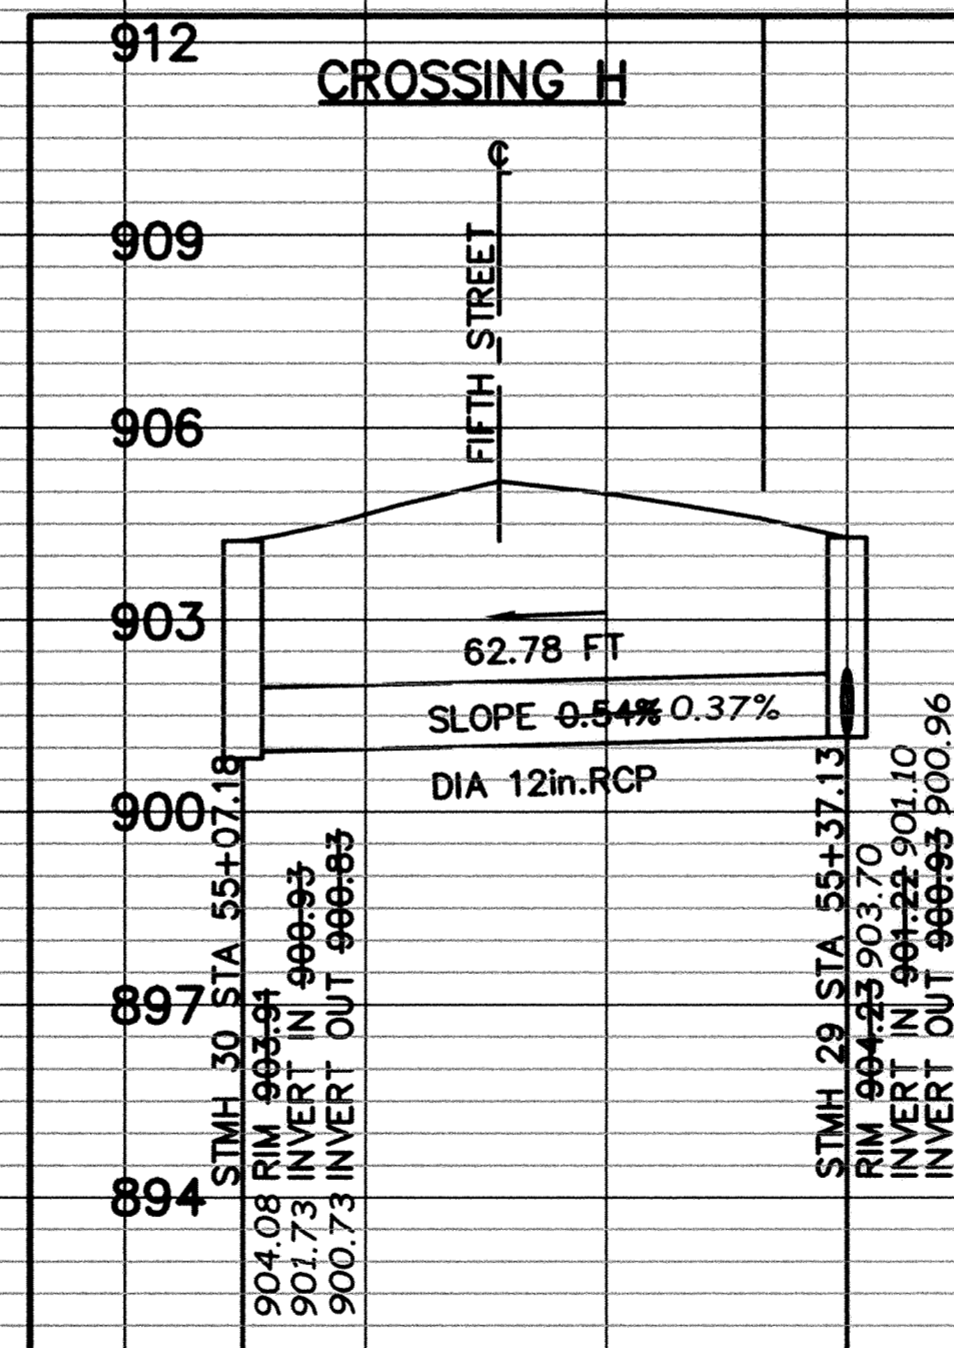
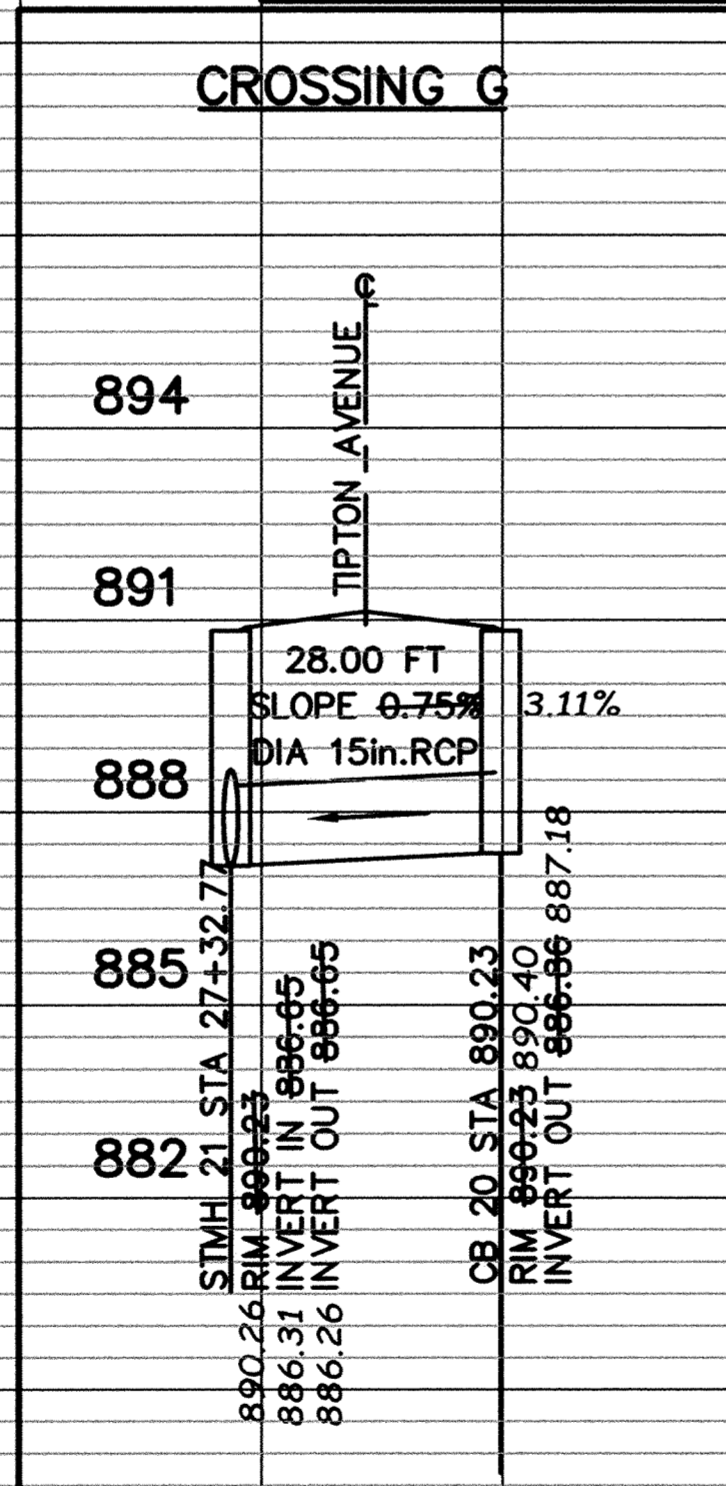
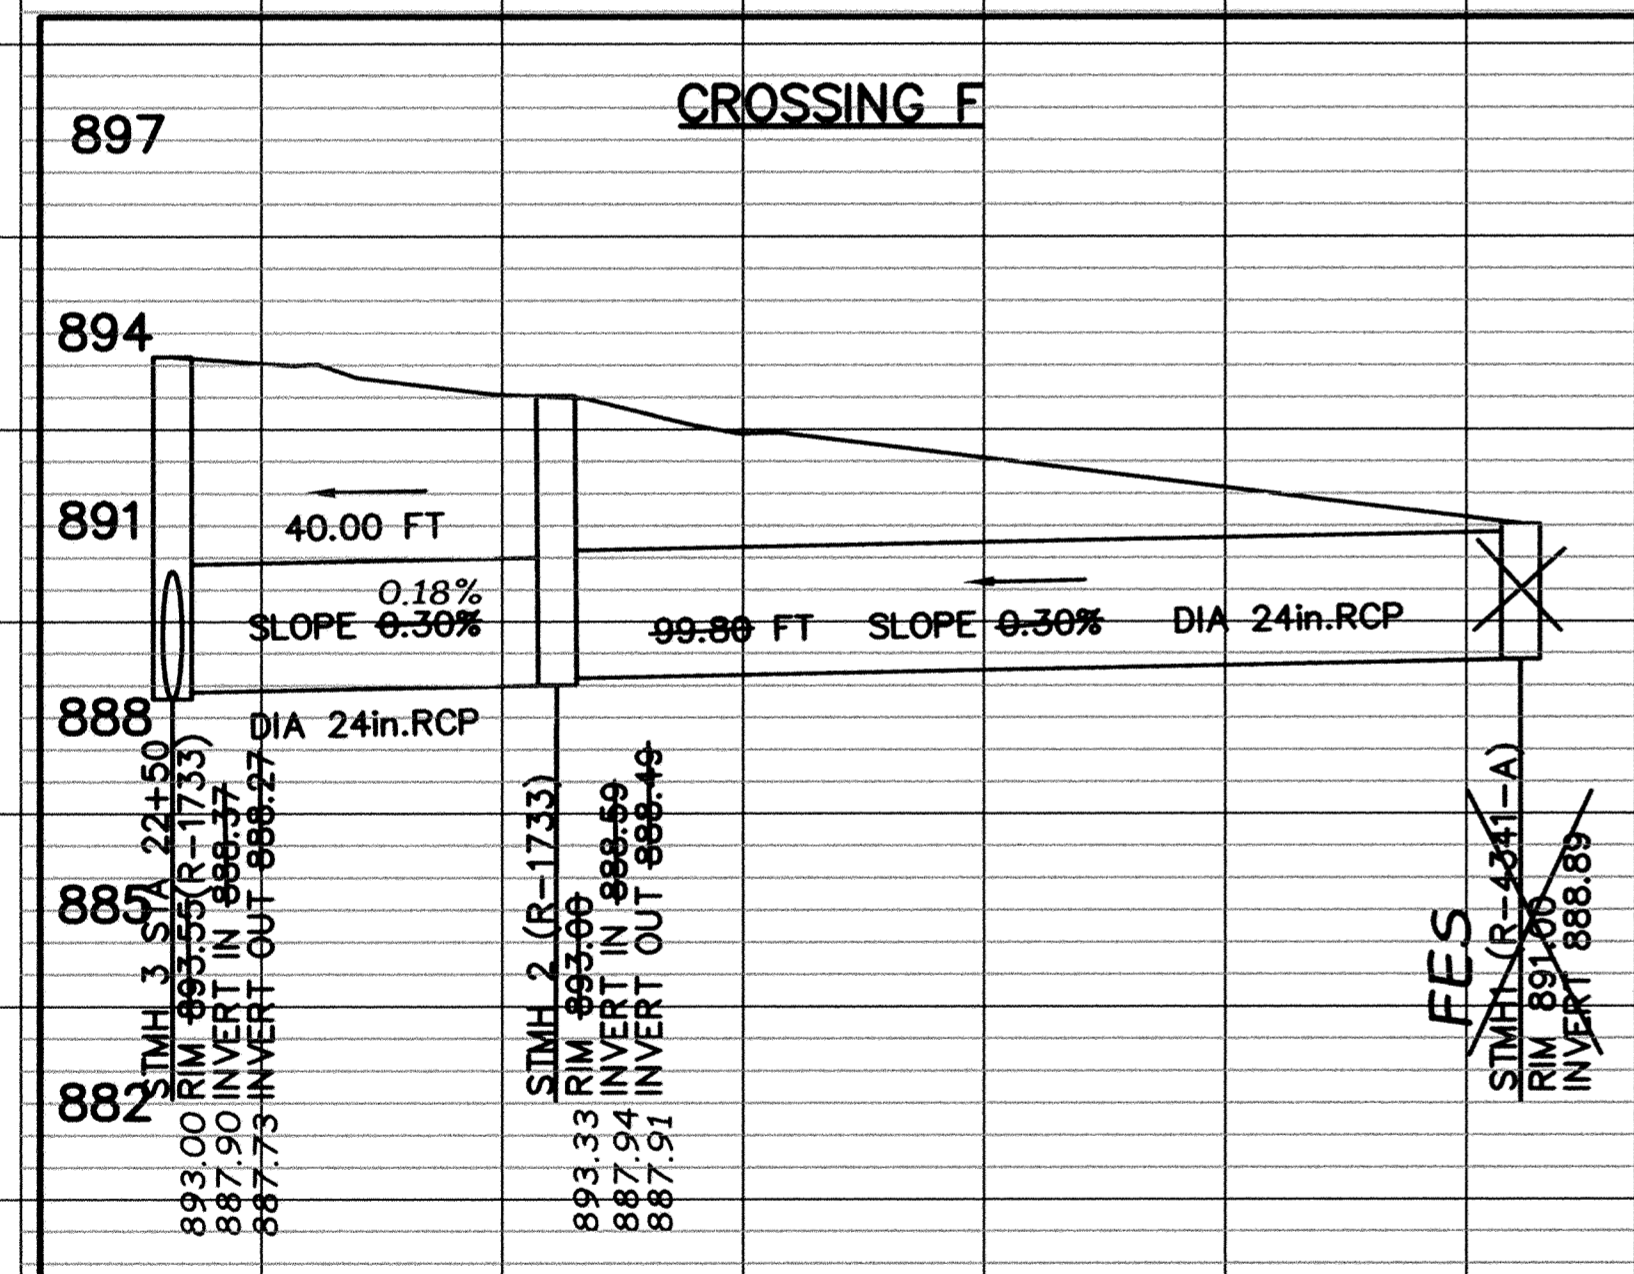
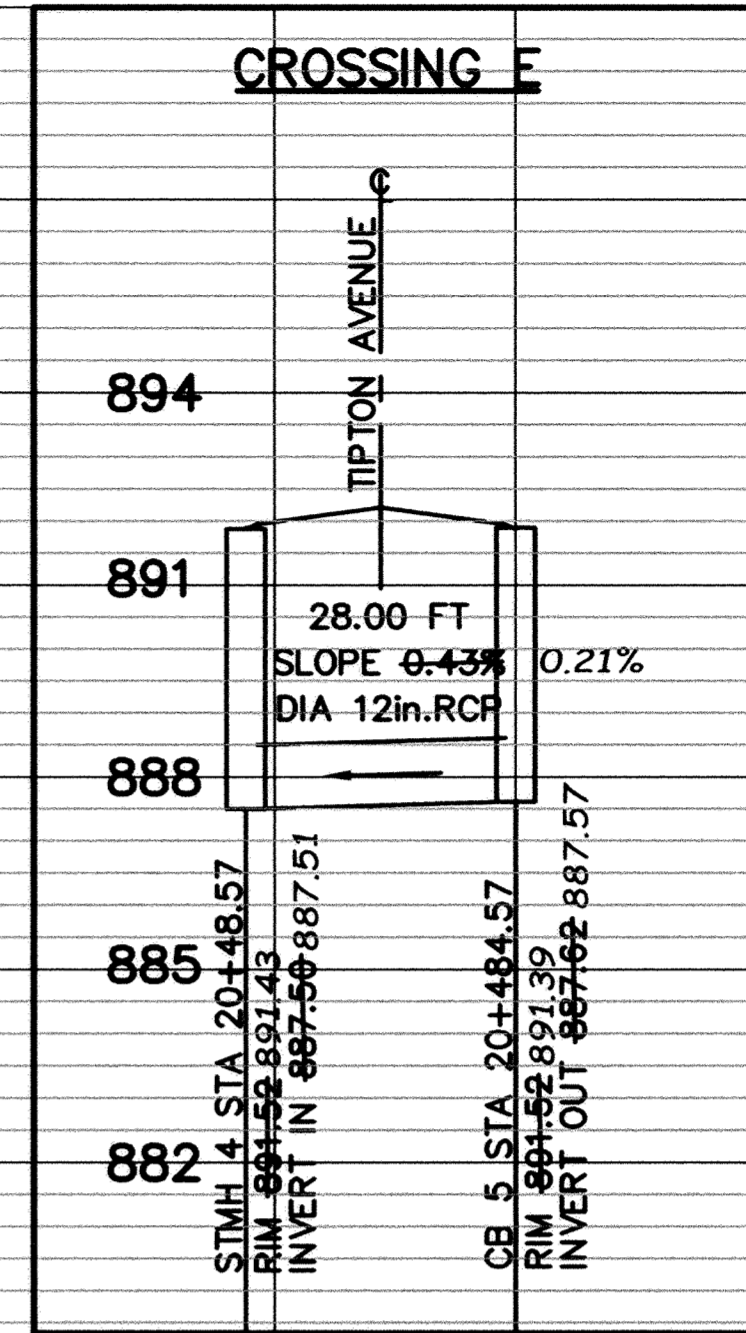
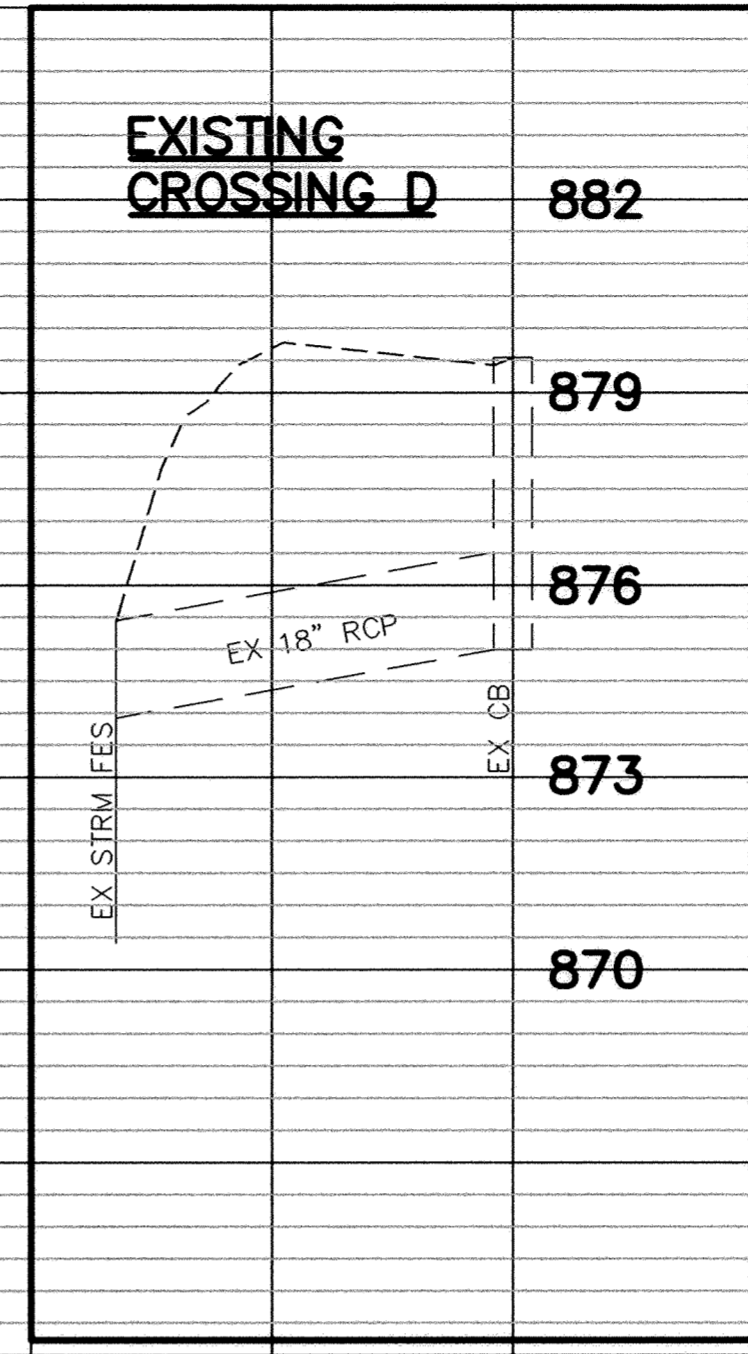
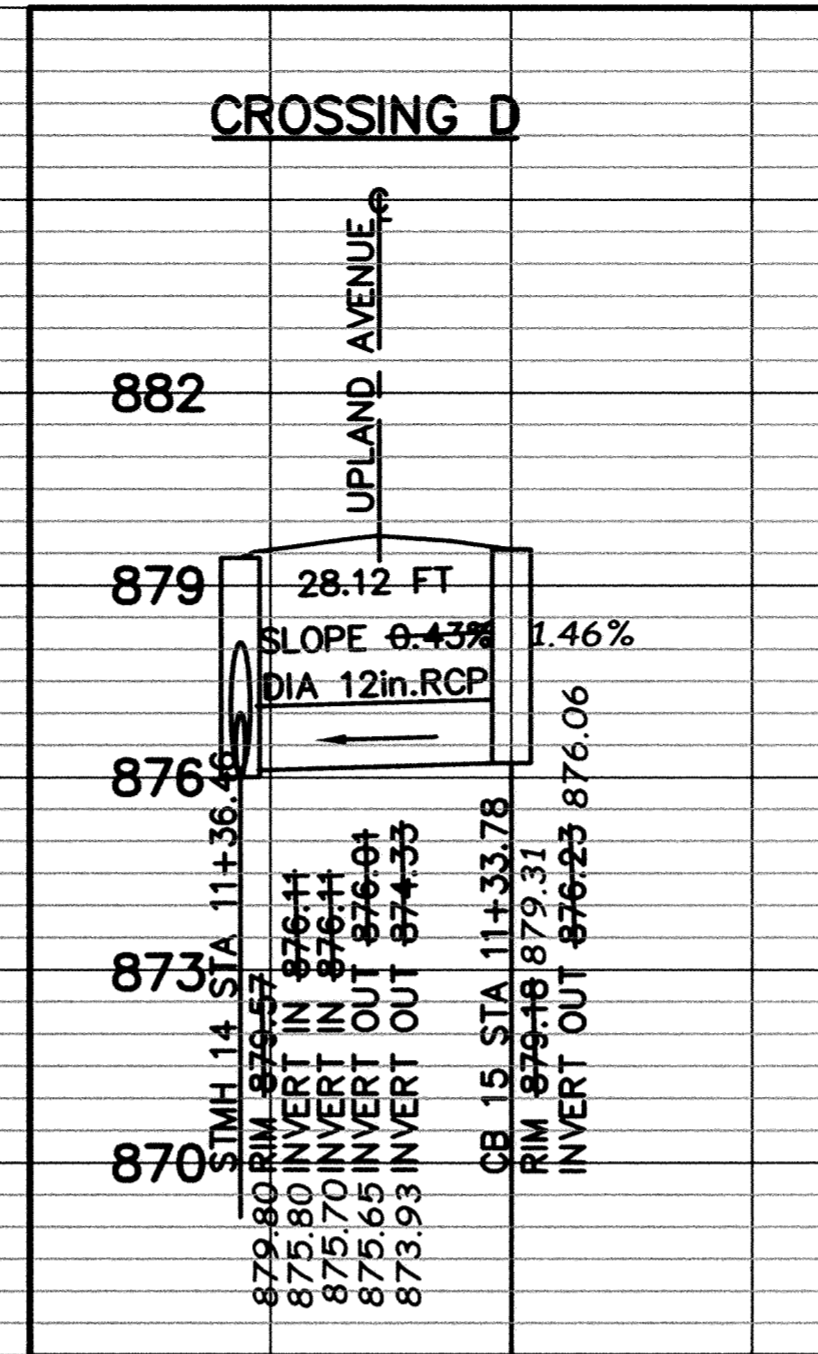
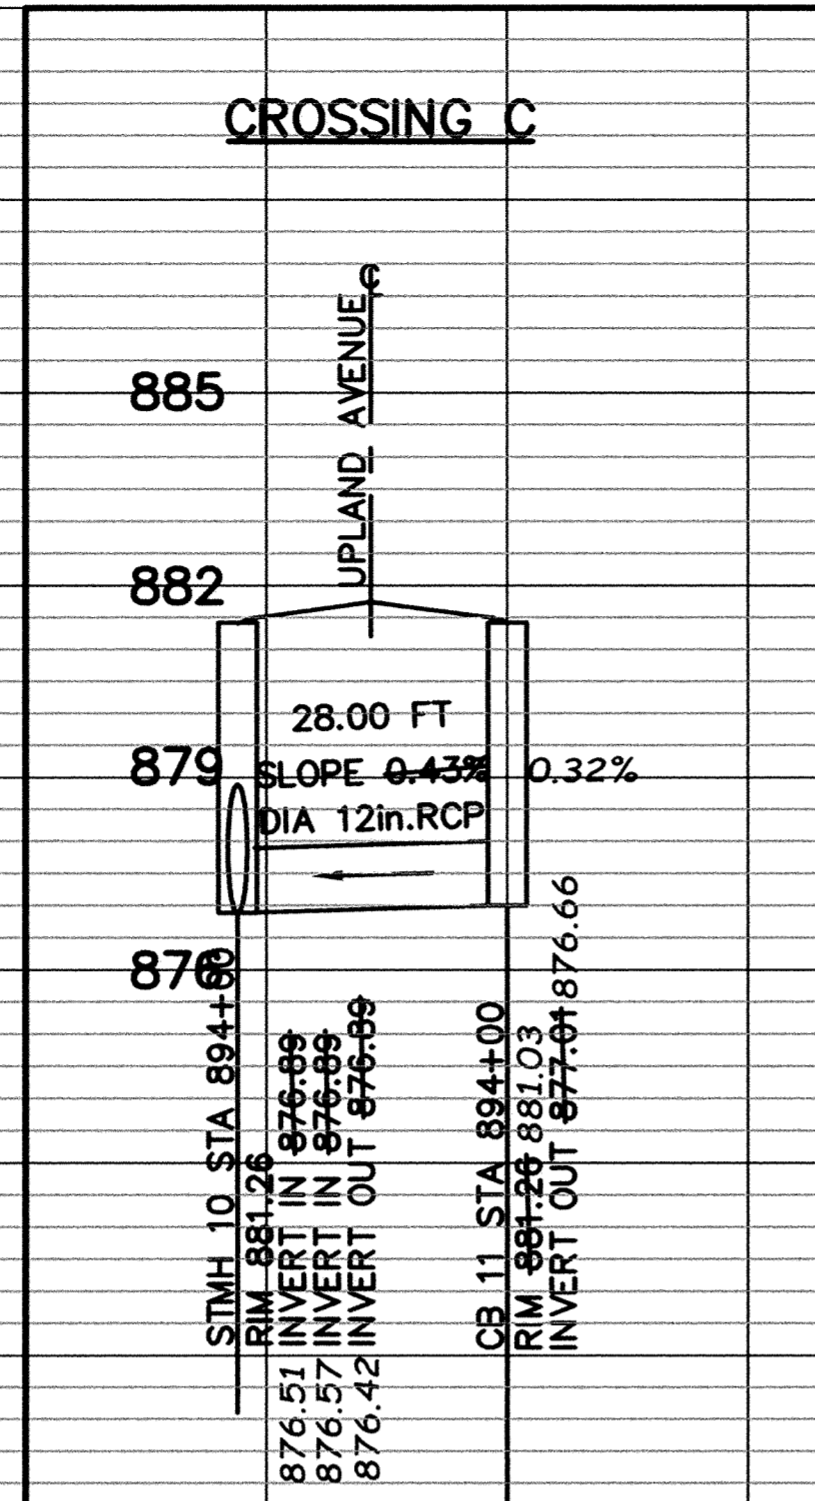
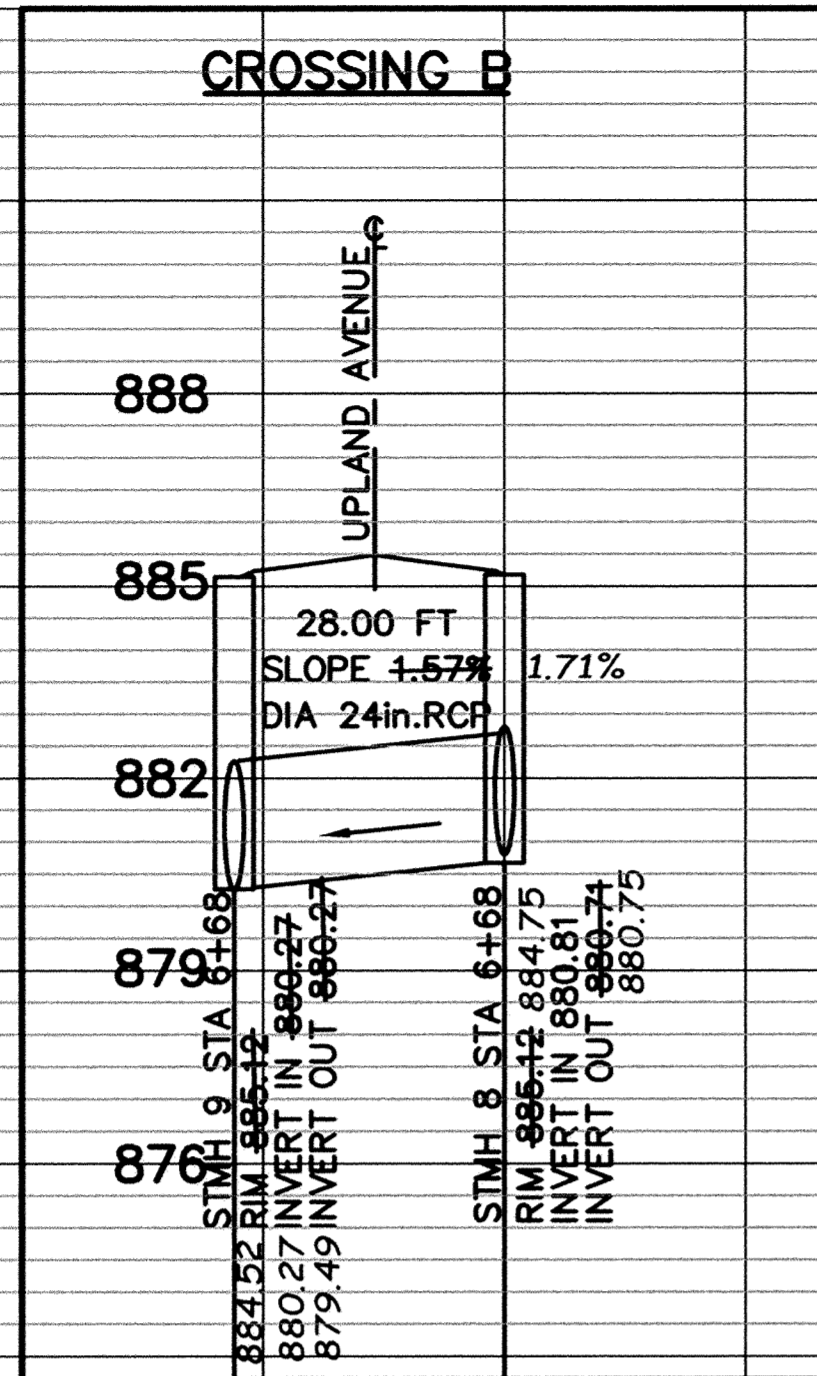


STORM SEWER CROSSINGS

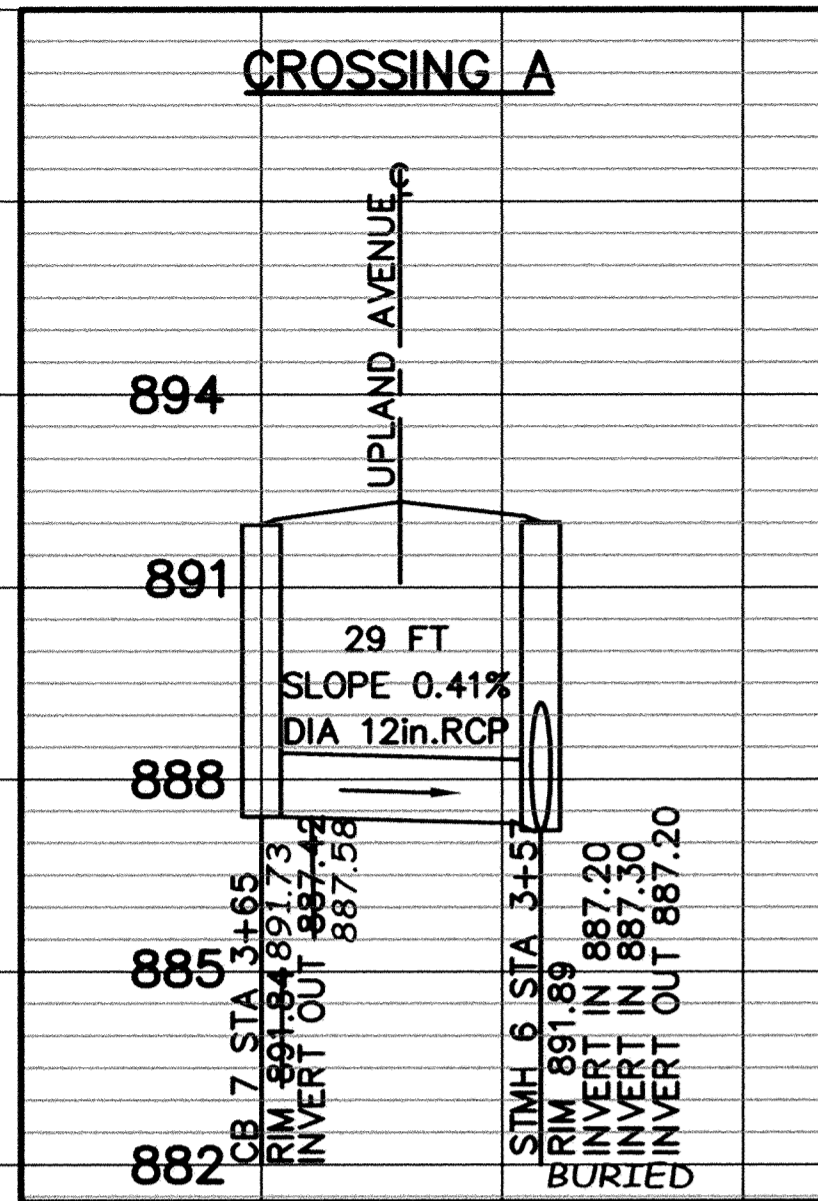

DESIGNED BY: JAM DRAWN BY: LAK
 APPROVED BY: JMA JOB NUMBER 824180J
 CAD DATE: April 01, 2005 8:14:28 a.m.
 CAD FILE: 824180J\Drawings\CT-30.DWG (TLAMKIN)

I HEREBY CERTIFY THAT THIS PLAN, SPECIFICATION, OR REPORT WAS PREPARED BY ME OR UNDER MY DIRECT SUPERVISION AND THAT I AM A DULY LICENSED PROFESSIONAL ENGINEER UNDER THE LAWS OF THE STATE OF MINNESOTA.

SIGNATURE: *John M. Anderson* DATE: 2/2/07
 PRINTED NAME: JOHN M. ANDERSON, P.E. LIC. NO. 25889

NO.	DATE	BY	REVISION DESCRIPTION

2550 UNIVERSITY AVENUE W, SUITE 400N
 ST. PAUL, MINNESOTA 55114
 (651) 644-4389

Howard R. Green Company

RECORD PLAN
 2005 STREET IMPROVEMENTS
 CITY OF ELK RIVER

PROFILE
 STORM SEWER CROSSINGS

SHEET NO.
 30

DRAWING NUMBER
 MAINS 05
 22