


SECTION 1
Scale: 3/8" = 1'-0" P4

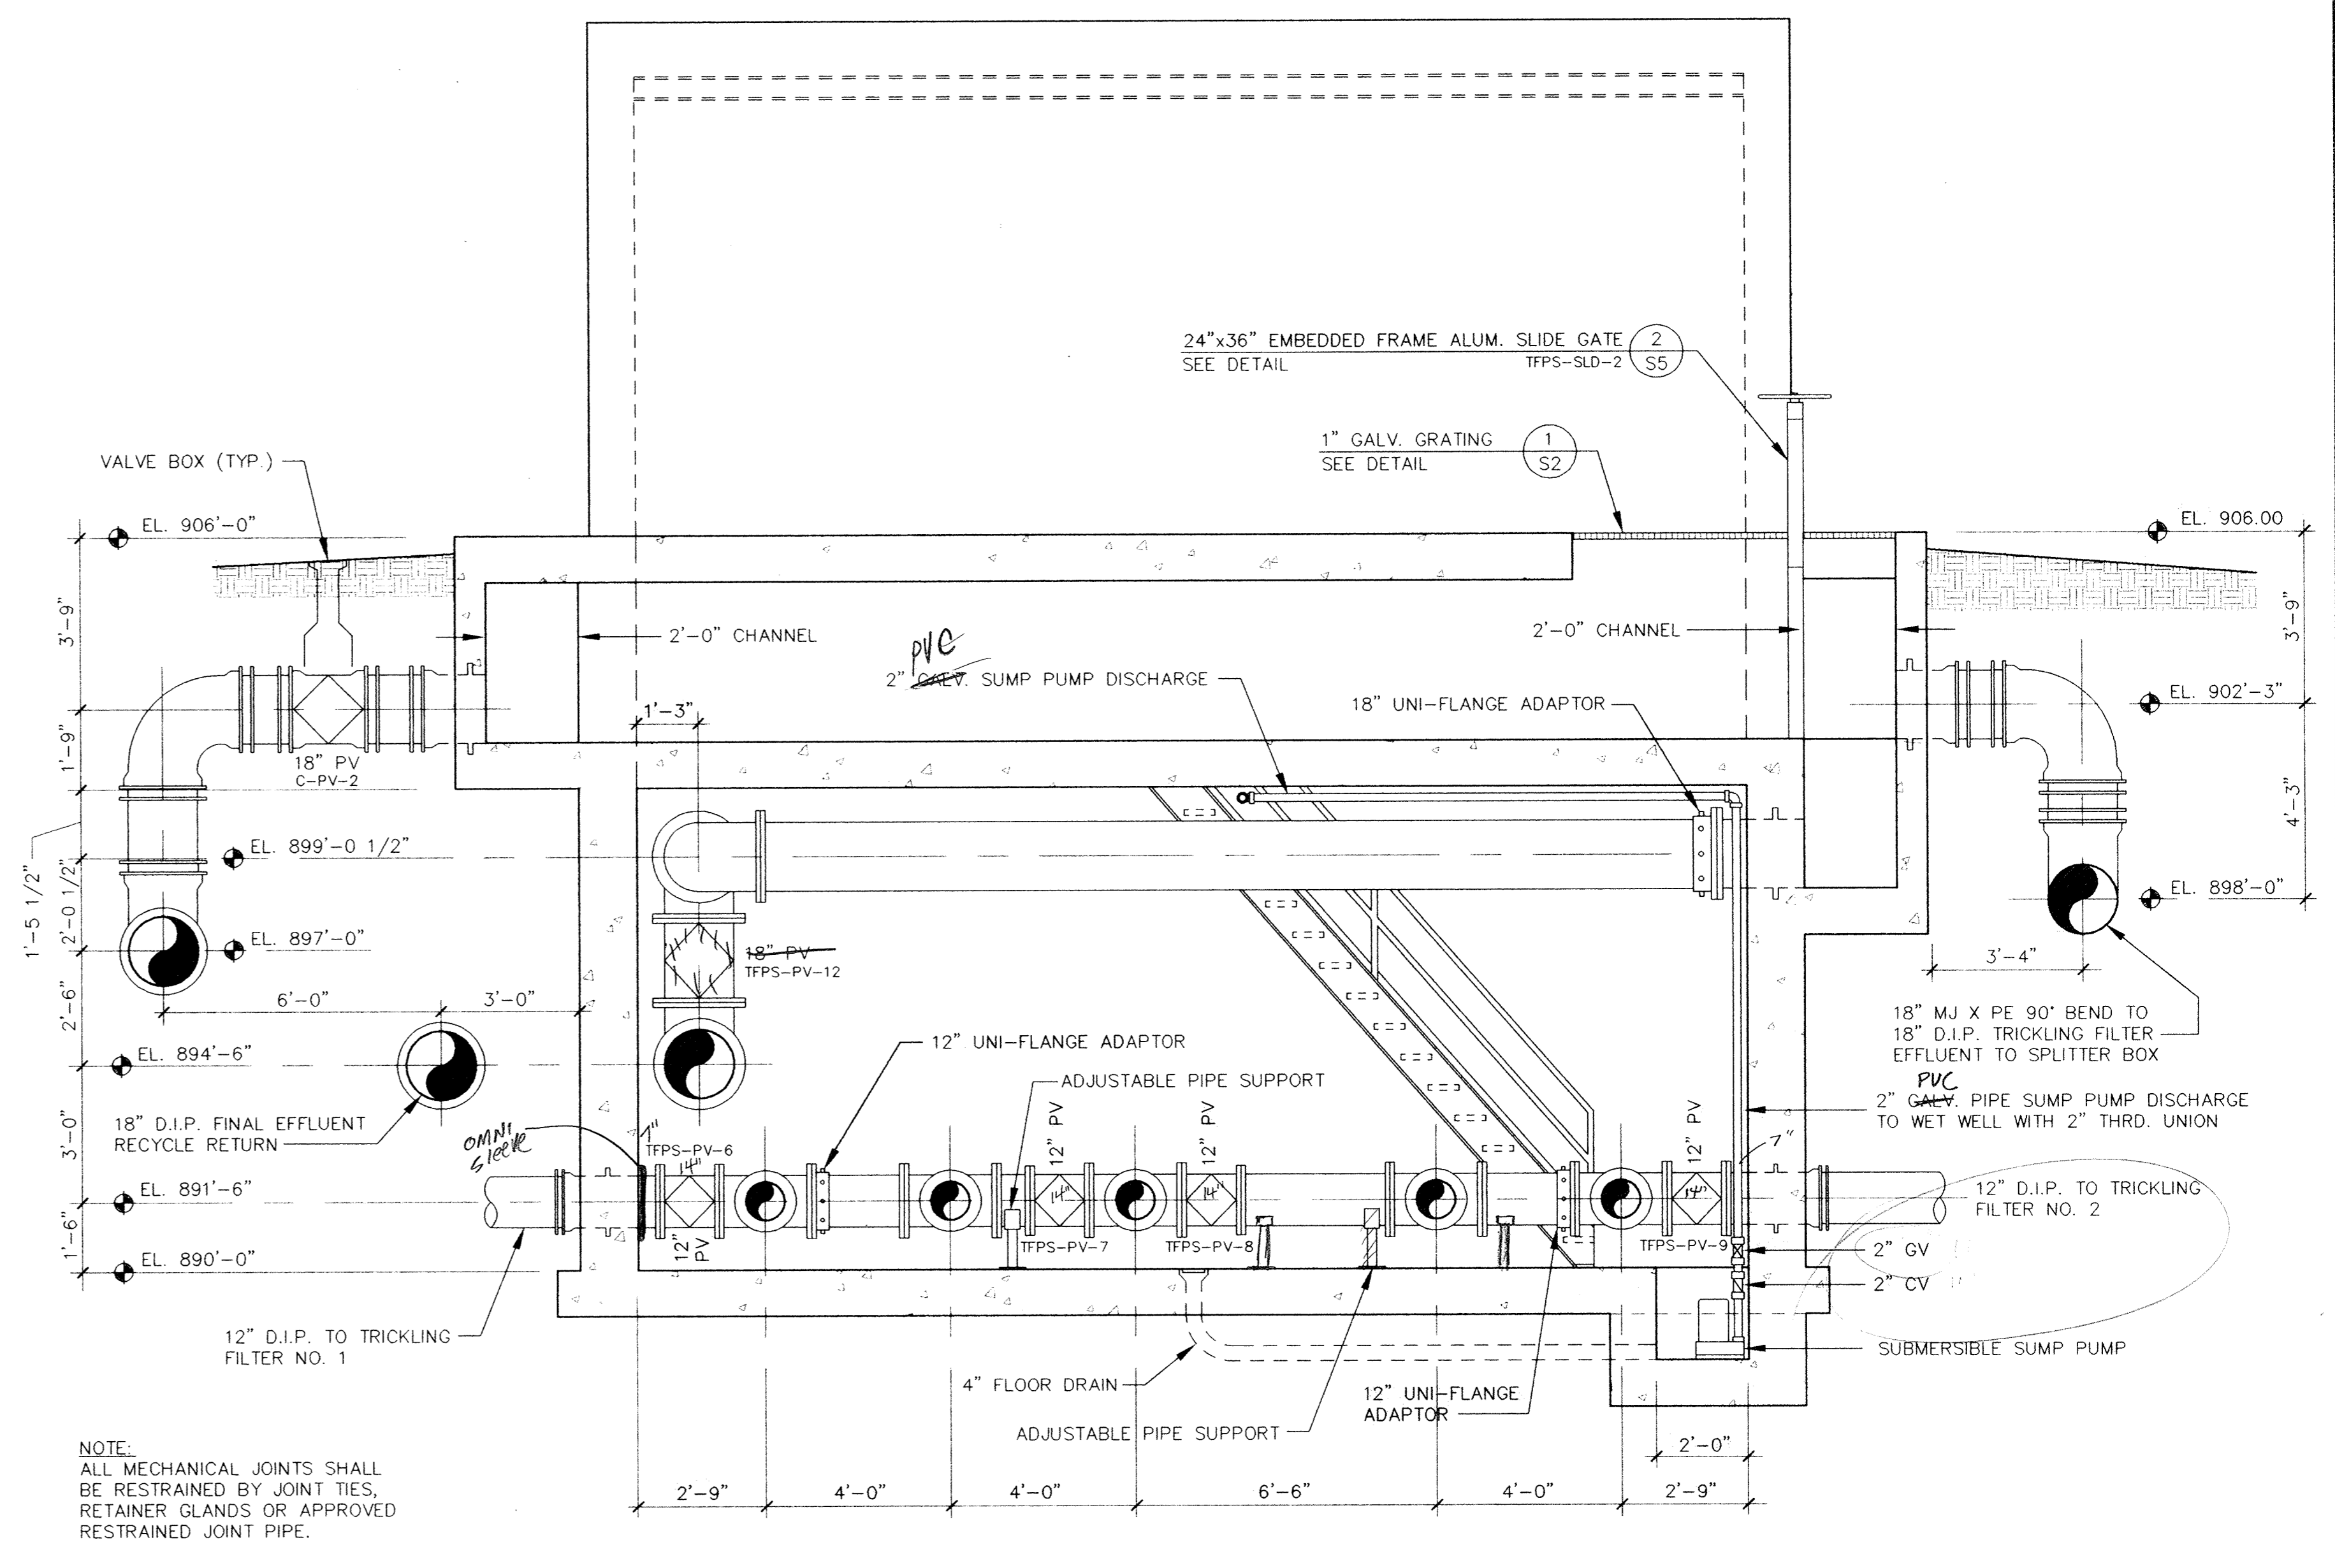

SECTION 2
Scale: 3/8" = 1'-0" P4

NOTE:
SLIDE GATE TO SOUTH SHALL BE CLOSED UNTIL FINAL CONSTRUCTION AND TEMPORARILY SEALED WITH SILICONE SEALANT.

NOTE:
SLUICE GATE TO EAST WET WELL SHALL BE CLOSED UNTIL FINAL CONSTRUCTION AND TEMPORARILY SEALED WITH SILICONE SEALANT.

NOTE:
ALL MECHANICAL JOINTS SHALL BE RESTRAINED BY JOINT TIES, RETAINER GLANDS OR APPROVED RESTRAINED JOINT PIPE.

I HEREBY CERTIFY THAT THIS PLAN, SPECIFICATION, OR REPORT WAS PREPARED BY ME OR UNDER MY DIRECT SUPERVISION AND THAT I AM A DULY REGISTERED PROFESSIONAL ENGINEER UNDER THE LAWS OF THE STATE OF MINNESOTA. <i>Bill Claus</i> DATE: 3/2/94 REG. NO. 22610		1326 ENERGY PARK DRIVE ST. PAUL, MINNESOTA 55108 (612) 644-4389 9800 SHELARD PARKWAY MINNEAPOLIS, MINNESOTA 55441 (612) 546-0432	DESIGNED BC_GG CHECKED TAR DRAWN GG	CITY OF ELK RIVER WASTEWATER TREATMENT FACILITIES TRICKLING FILTER PUMP STATION PIPING SECTIONS	P4
			REVISIONS DATE DESCRIPTION 0 HORIZ. 2.67 0 VERT. 2.67		
DATE DEC. 1993			SHEET 24 OF 41 SHEETS	PROJECT NO. 230-151	

Sat. Feb. 26. 13. 20. 53. 1994

ER151-9